

REV	DRAWING NUMBER	DRAWING TITLE
1.1-1.2		LEGEND
2.1-2.10		COMMUNICATIONS BUS
3.1		PNEUMATIC RISER
4.1-4.5, NC-11 PS-36		HOT WATER SYSTEM
5.1-5.7, NC-11 PS-37,38		CHILLED WATER SYSTEM
6.1-6.2, NC-11 PS-1-3		AH-S01 TYPICAL FOR AH-S02,AH-S03
7.1-7.3, NC-11 PS-4		AH-S04
8.1-8.3, NC-11 PS-5		AH-S05
9.1-9.2, NC-11 PS-6, 11-13		AH-S08 TYPICAL FOR AH-S14,AH-S15,AH-S16
10.1-10.3, NC-11 PS-7		AH-S10
11.1-11.3, NC-11 PS-8,9		AH-S11 TYPICAL FOR AH-S12
12.1-12.3, NC-11 PS-10		AH-S13
13.1-13.2, NC-11 PS-14		AH-S17
14.1-14.2, NC-11 PS-15-19		AH-S19 TYPICAL FOR AH-S20,AH-S21,AH-S22,AH-S23
15.1-15.2, NC-11 PS-20, NC-12 PS-9		AH-S24 TYPICAL FOR AH-T09
16.1-16.3, NC-12 PS-1		AH-F01
17.1-17.3, NC-12 PS-2, NC-13 PS-1		AH-F02 TYPICAL FOR AH-F04
18.1-18.3, NC-12 PS-3, NC-13 PS-2		AH-F03 TYPICAL FOR AH-F05
19.1-19.3, NC-13 PS-3		AH-F06
20.1-20.2, NC-13 PS-4, 28 NC-12 PS-4,27		AH-F11 TYPICAL FOR AH-F12
21.1-21.2, NC-13 PS-5,10		AH-F13 TYPICAL FOR AH-T05
22.1-22.2, NC-13 PS-6, NC-12 PS-33		AH-F14 TYPICAL FOR AH-T08
23.1-23.2, NC-13 PS-7		AH-L01
24.1-24.2, NC-12 PS-5		AH-L04
25.1-25.2, NC-12 PS-6		AH-C01
26.1-26.2, NC-13 PS-8,11		AH-C02 TYPICAL FOR AH-T07
27.1-27.3, NC-12 PS-7,12 NC-13 PS-9,14		AH-T01 TYPICAL FOR AH-T02,AH-TB05,AH-TB06
28.1-28.3, NC-12 PS-8		AH-T06
29.1-29.3, NC-13 PS-12		AH-T10
30.1-30.3, NC-12 PS-10, NC-13 PS-13		AH-TB01 TYPICAL FOR AH-TB04
31.1-31.3, NC-12 PS-11,34		AH-TB02 TYPICAL FOR AH-TB03
32.1-32.3, NC-11 PS-35		SF-S06
33.1-33.3, NC-12 PS-32		AH-BA1
33.4		SCOREBOARD ACU
34.1-34.7		FAN DETAILS
35.1-35.9		ROOM SCHEDULE DETAILS
35.1, NC-12 PS-13-26, NC-13 PS-15-27		DETAIL A - HEAT REMOVAL EXHAUST FANS DETAIL B - FAN COIL UNITS (CHILLED WATER & ELECTRIC HEAT)
35.2		DETAIL C - COMMUNICATION ROOM UNITS (GENERAL ALARM) DETAIL D - DX COIL UNITS & CONDENSING UNITS

REV	DRAWING NUMBER	DRAWING TITLE
35.3		DETAIL E - DX FAN COIL UNITS AND CONDENSING UNITS DETAIL F - ROOM AIR CONDITIONERS DETAIL G - VAV BOXES WITH REHEAT
35.4, NC-11 PS-23, NC-12 PS-31		DETAIL H - REHEAT COILS
35.5 - 35.6, NC-11 PS-24-32, NC-12 PS-28, NC-13 PS-29		DETAIL I - REHEAT COILS AND CONVECTORS
35.7-35.9, NC-13 PS-32		DETAIL J - REHEAT COILS
36.1-36.10		MISCELLANEOUS DETAILS
36.1		DETAIL A - FROST PROTECTION DETAIL B - SUMP PUMPS
36.2 - 36.3, NC-11 PS-21,22		DETAIL C - SMOKE EXHAUST SYSTEM
36.4		DETAIL D - SEWAGE EJECTOR PUMPS DETAIL E - FIRE PUMP
36.5		DETAIL F - SUMP PUMP FOR DRAINAGE DETAIL G - STANDBY EMERGENCY GENERATOR
36.6		DETAIL H - ROOF MECHANISM/ HIGH BOWL DAMPERS DETAIL I - ROOF SNOW MELT
36.7		DETAIL J - IN-FIELD HEATING SYSTEM DETAIL K - TC AIR COMPRESSOR
36.8		DETAIL L - ELECTRIC HEATING SYSTEMS
36.9		DETAIL M - ELECTRIC HEATING SYSTEMS DETAIL N - METHANE DETECTION SYSTEM INTERFACE
36.10, NC-13 PS-30,31, NC-12 PS-29,30, NC-11 PS-33,34		DETAIL O - MULTIPLEX PANELS
36.11		WIRE SUPPRESSION / EMER GENERATOR
36.12		CATERPILLAR CH INTEGRATION
PAGE 1-7		DAMPER SCHEDULE
D1		DAMPER SCHEDULE DETAILS
PAGE 1-2		PANEL SCHEDULE
PAGE 1-10		ROOM SCHEDULE
PAGE 1-2		VALVE SCHEDULE
PAGE 1		WELL/TAP/METER SCHEDULE
D2		WELL/TAP/METER SCHEDULE DETAILS

# JOHNSON CONTROLS

Creating a better climate for business.

- Environmental Control System
- Facility Management System
- Air and Water System Balancing
- Fire Management System
- Security System
- Lighting Services
- Instrumentation System Installation
- Building Operations Management
- Energy Conservation Control
- Training Programs
- Performance Contracting
- Planned Service Agreements

Air Conditioning  
Heating  
Diagnostic Services  
Coil Cleaning  
Refrigeration  
Automatic Temperature Controls  
Facility Management Systems  
Fire Management  
Security Management  
Building Operations and Management  
Water Treatment  
Electrical Equipment  
Emergency Generator / Lighting Equipment  
Industrial Controls / Recording / Indication Equipment

PROJECT TITLE  
**MILLER PARK  
ONE BREWERS WAY  
MILWAUKEE, WI 53214**

ARCHITECT	ENGINEER
HKS / NBBJ / EPPSTEIN-UHEN	OVE ARUP and PARTNERS / PSJ ENGINEERING, INC / THE WILSON FIRM
MECHANICAL CONTRACTOR	ELECTRICAL CONTRACTOR
F.E.MORAN / SUPERIOR AIR HANDLING CORP	PIEPER ELECTRIC

2	JCI CONTRACT 4933-0011	8/28/2004	MLR
1	RECORD DRAWING	4/5/2001	MLR
REFERENCE DRAWING	NO.	REVISION-LOCATION	EGN DATE BY

JOHNSON CONTROLS  
Systems & Services Division

Branch Information  
Wisconsin Area Office  
529 N. Jackson Street  
Milwaukee  
WI 53202  
Phone: 414-524-7500  
Fax: 414-524-7575

SALES ENGINEER	PROJECT MANAGER	APPLICATION ENGINEER	DATE	CONTRACT NUMBER
PJS	TP	KJK	02/07/01	9 8075-0508

REVISION INFORMATION

NUMBER


DATE 08/26/04

TIME 11:02 AM

FILE NAME Title.vsd

IN CONSIDERATION OF THE RECEIPT OF THIS DOCUMENT, THE RECIPIENT AGREES NOT TO REPRODUCE, COPY, USE OR TRANSMIT THIS DOCUMENT AND/OR THE INFORMATION THEREIN CONTAINED, IN WHOLE OR IN PART, OR TO SUFFER SUCH ACTION BY OTHERS, FOR ANY PURPOSE, EXCEPT WITH THE WRITTEN PERMISSION OF JOHNSON CONTROLS, INC. AND FURTHER AGREES TO SURRENDER SAME TO JOHNSON CONTROLS, INC. UPON DEMAND.

COPYRIGHT JOHNSON CONTROLS, INC. 1999

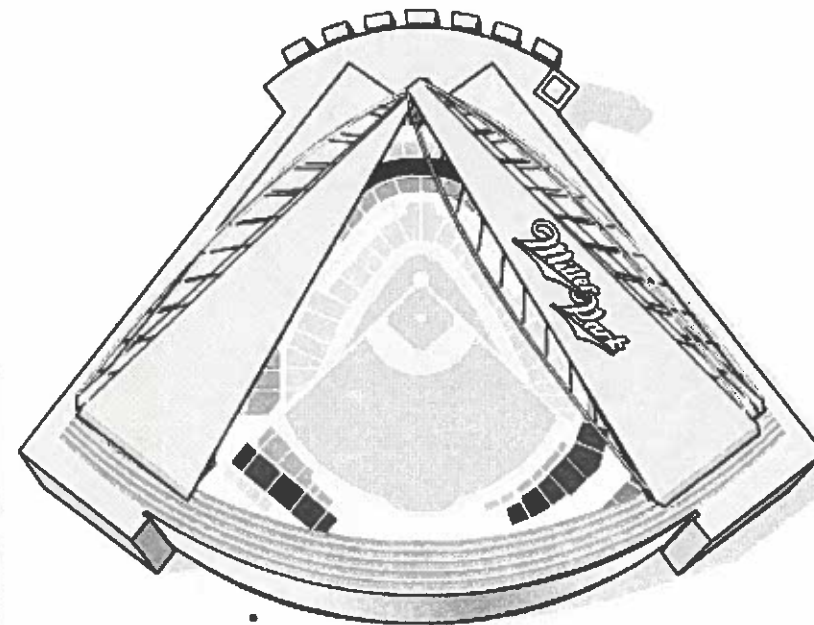

WIRE USAGE	CABLE / WIRE SPECIFICATION		DESCRIPTION	TERMINALS PER CONDUCTOR COLOR					COMMENTS
	PLENUM PART NUMBER			BLACK	WHITE	JACKET COLOR	RED	DRAIN	
	SOUTHWEST WIRE	WINDY CITY WIRE							
AI	CBL-18/2YEL-SW	CBL-18/2YEL-WC	18/2 Shld Yellow	AI Com	-----	AI	-----	TABLE 5	
AI	CBL-18/3YEL-SW	CBL-18/3YEL-WC	18/3 Shld Yellow	AI Com	Power	AI	-----	TABLE 5	
AO	CBL-18/2TAN-SW	CBL-18/2TAN-WC	18/2 Shld Tan	AO Com	-----	AO	-----	TABLE 5	
AO	CBL-18/3TAN-SW	CBL-18/3TAN-WC	18/3 Shld Tan	AO Com	Power	AO	-----	TABLE 5	
BI	CBL-18/2ORG-SW	CBL-18/2ORG-WC	18/2 Shld Orange	BI 24V	-----	BI	-----	TABLE 5	
BO	CBL-18/2VLT-SW	CBL-18/2VLT-WC	18/2 Shld Violet	BO Com	-----	BO	-----	TABLE 5	
BO	CBL-18/3VLT-SW	CBL-18/3VLT-WC	18/3 Shld Violet	BO Com	BO	BO	-----	TABLE 5	
24VAC	CBL-18/2GRY-SW	CBL-18/2GRY-WC	18/2 Shld Grey	24 V Com	-----	24 VAC	-----	-----	
GENERAL PURPOSE	CBL-18/2NAT-SW	CBL-18/2NAT-WC	18/2 Shld Natural	Common	-----	-----	Power	-----	
GENERAL PURPOSE	CBL-18/3NAT-SW	CBL-18/3NAT-WC	18/3 Shld Natural	Common	-----	Signal	Power	-----	
N2 BUS	CBL-18/3BLU-SW	CBL-18/3BLU-WC	18/3 Shld Blue	N2+	N2-	REF	-----	TABLE 6	
XT BUS	CBL-18/3BLU-SW	CBL-18/3BLU-WC	18/3 Shld Blue	XT+	XT-	REF	-----	-----	
N1 BUS-ARCNET	CBL-RG62PUR-SW	CBL-RG62PUR-WC	RG62 Purple	-----	-----	-----	-----	-----	
N1 BUS-ETHERNET	130208-07	555600-PURPLE	24/8 Purple	-----	-----	-----	-----	-----	SEE TABLES 7 & 8
BACNET BUS	130208-07	555600-PURPLE	24/8 Purple	-----	-----	-----	-----	-----	SEE TABLES 7 & 8
METASTAT	CBL-24/8NAT-SW	CBL-24/8NAT-WC	24/8 Natural	-----	-----	-----	-----	-----	SEE TABLES 2, 3, & 4
NT BUS	110205-SW	4380-WC	22/4 Natural	-----	-----	-----	-----	-----	
600 V	CBL-18/2600-SW	CBL-18/2600-WC	18/2	-----	-----	-----	-----	-----	
600 V	CBL-18/3600-SW	CBL-18/3600-WC	18/3	-----	-----	-----	-----	-----	
	<b>CONNECT-AIR INTERNATIONAL</b>	<b>ANIXTER</b>							
LON BUS	W221P-2002	9J2201544	22/2 Shld	-----	-----	-----	-----	-----	

NOTE #1: REFERENCE DETAILS OVERRIDE ABOVE COLOR CHART.

NOTE #2: EXISTING JOB STANDARDS OVERRIDE ALL OTHER DETAILS.

**TE-6700 SERIES**

TABLE 2	PHONE JACK PIN DESIGNATIONS	
PHONE JACK PIN NO.	SIGNAL DESIGNATION	COLOR
1	HEATING SETPOINT OR LED AND MANUAL OVERRIDE	WHT / GRN
2	SETPOINT (COOLING)	WHT / BLU
3	TEMPERATURE SENSOR	WHT / BRN
4	TEMPERATURE SENSOR COMMON	ORN / WHT
5	24 VAC OR 15 VDC POWER	BLU / WHT
6	POWER COMMON OR ZONE BUS COMMON	GRN / WHT
7	SETPOINT COMMON	BRN / WHT
8	ZONE BUS	WHT / ORN


TABLE 3	TERMINAL BLOCK WIRING	
TERMINAL NO.	SIGNAL DESIGNATION	COLOR
1	TEMPERATURE SENSOR AND MANUAL OVERRIDE	WHT / BLU
2	TEMPERATURE SENSOR COMMON	BLU / WHT
3	SETPOINT COMMON	WHT / ORN
4	SETPOINT	ORN / WHT
5	24 VAC OR 15 VDC POWER	WHT / GRN
6	COMMON FOR POWER, ZONE BUS, OR MANUAL OVERRIDE AND LED	GRN / WHT
7	ZONE BUS	WHT / BRN
8	LED AND MANUAL OVERRIDE	BRN / WHT

NOTE: MANUAL OVERRIDE IS SELECTED FOR EITHER TERMINALS 1 AND 2 OR 6 AND 8 WITH THE LED ENABLED. TERMINAL 6 IS COMMON FOR TERMINAL 7. A DUAL (HEATING/COOLING SETPOINT IS NOT AVAILABLE WITH A TERMINAL BLOCK.

**HE-6700 SERIES**

TABLE 4	TERMINAL BLOCK WIRING	
TERMINAL NO.	SIGNAL DESIGNATION	COLOR
1	TEMPERATURE SENSOR COMMON	WHT / BLU
2	TEMPERATURE SENSOR AND MANUAL OVERRIDE	BLU / WHT
3	SETPOINT (WARMER/COOLER)	WHT / ORN
4	SETPOINT COMMON	ORN / WHT
5	COMMON (FOR POWER, ZONE BUS, OR MANUAL OVERRIDE AND LED)	WHT / GRN
6	24 VAC OR 15 VDC POWER	GRN / WHT
7	RH OUTPUT	WHT / BRN
8	ZONE BUS	BRN / WHT
9	LED AND MANUAL OVERRIDE	

NOTE: MANUAL OVERRIDE IS SELECTED FOR EITHER TERMINALS 1 AND 2 OR 5 AND 9 WITH THE LED ENABLED. TERMINAL 5 IS COMMON FOR TERMINAL 7.

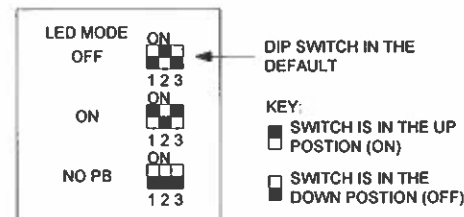


NOTE: SEE TABLES 2 & 3 FOR PHONE JACK, PREWIRED-CABLE CONFIGURATIONS.

**ETHERNET PATCH CABLE**

TABLE 7	STANDARD EIA/TIA T568B	
PIN NO.	COLOR	
1	WHT / ORN	
2	ORN / WHT	
3	WHT / GRN	
4	BLU / WHT	
5	WHT / BLU	
6	GRN / WHT	
7	WHT / BRN	
8	BRN / WHT	

**ETHERNET CROSSOVER CABLE**

TABLE 8	STANDARD EIA/TIA T568B	
PIN NO.	COLOR	
1	WHT / GRN	
2	GRN / WHT	
3	WHT / ORN	
4	BLU / WHT	
5	WHT / BLU	
6	ORN / WHT	
7	WHT / BRN	
8	BRN / WHT	

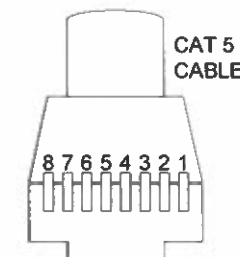

<b>SYMBOL LEGEND</b> ○ PNEUMATIC TUBING □ LOW VOLTAGE ○ CABLE ○ HIGH VOLTAGE	REVISION INFORMATION NUMBER DATE 04/16/01 TIME 11:00 AM FILE NAME Legend-a.vsd	Drawing Title <b>LEGEND</b> Project Title <b>MILLER PARK          ONE BREWERS WAY          MILWAUKEE, WI 53214</b>	REFERENCE DRAWING Sales Engineer: PJS Project Manager: TP Application Engineer: KJK	NO REVISION-LOCATION ECH DATE BY DATE APPROVED	Branch Information <b>JOHNSON          CONTROLS</b> Systems & Services Division Wisconsin Area Office 529 N. Jackson Street Milwaukee WI 53202 Phone: 414-524-7500 Fax: 414-524-7575	CONTRACT NUMBER <b>9 8075-0508</b> DRAWING NUMBER <b>1.1</b>
--	---	---	--	--	--	---


**BILL OF MATERIALS**

Designation	Qty	Part Number	Description
Field Devices:			
CAP-1	1	PD-101-10	CAPACITOR, 560PF
FILTER-1	1	81F4523	CORCOM 3VB1 LINE FILTER - NEWARK
MOV-1	1	AS-MOVKIT-0	KIT, TRANSIENT NOISE SUPPRESSOR, PK OF 12


TABLE 5	DRAIN CABLE		
	TERMINALS	I/O GROUNDING	
	ENCLOSURE	NO ENCLOSURE	
I/O	HARD GROUND @ EACH PANEL. TAPE BACK @ EACH DEVICE	TAPE BACK @ EACH END	SEE FIGURE A
BO (NOISY INDUCTIVE LOADS)	TAPE BACK @ EACH END	TAPE BACK @ EACH END	ADD MOV-1 @ CONTROLLER TERMINALS ADD FILTER-1 @ CONTROLLER TERMINALS. HARD GROUND CASE
BO (GAS IGNITION)	TAPE BACK @ EACH END	TAPE BACK @ EACH END	

TABLE 6	DRAIN CABLE		
	TERMINALS	N2 GROUNDING	
	ENCLOSURE	NO ENCLOSURE	
NCM	HARD GROUND TO BACK PLANE	NA	
ASC	STRAIGHT THROUGH TO NEXT DEVICE	STRAIGHT THROUGH TO NEXT DEVICE	SEE FIGURE B
ASC (EOL)	TAPE BACK @ ASC	TAPE BACK @ ASC	
ASC (NOISY)	SOFT GROUND ONCE PER ENCLOSURE	TAPE BACK @ ASC	ADD CAP-1 @ ENCLOSURE

**FIGURE A**

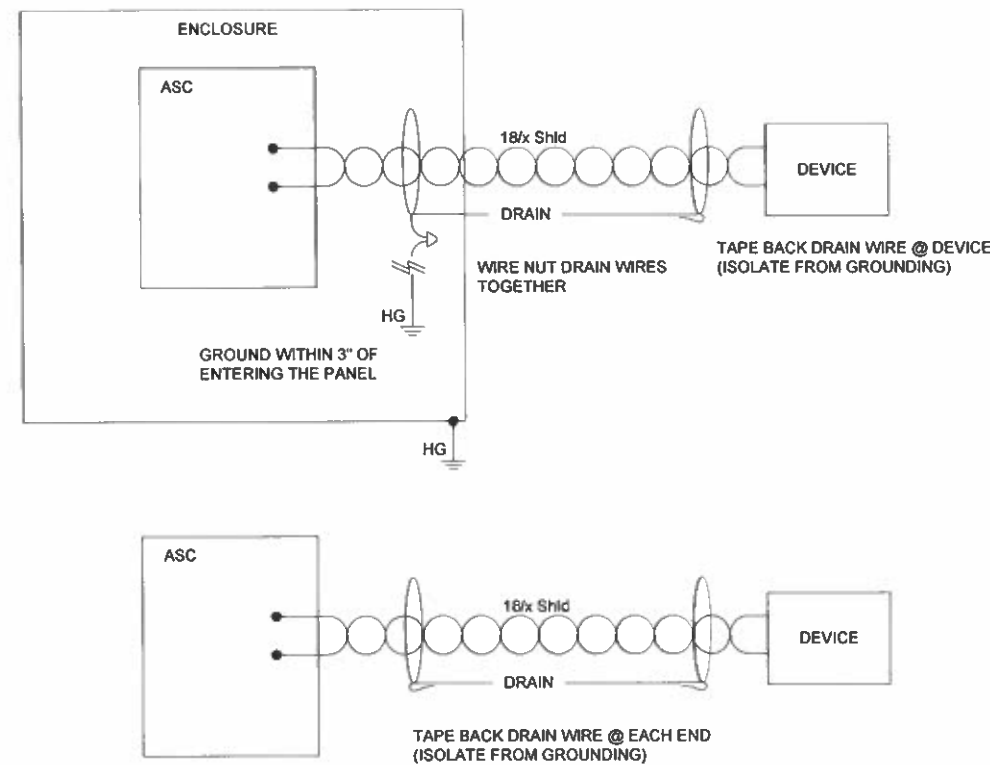

**FIGURE B**

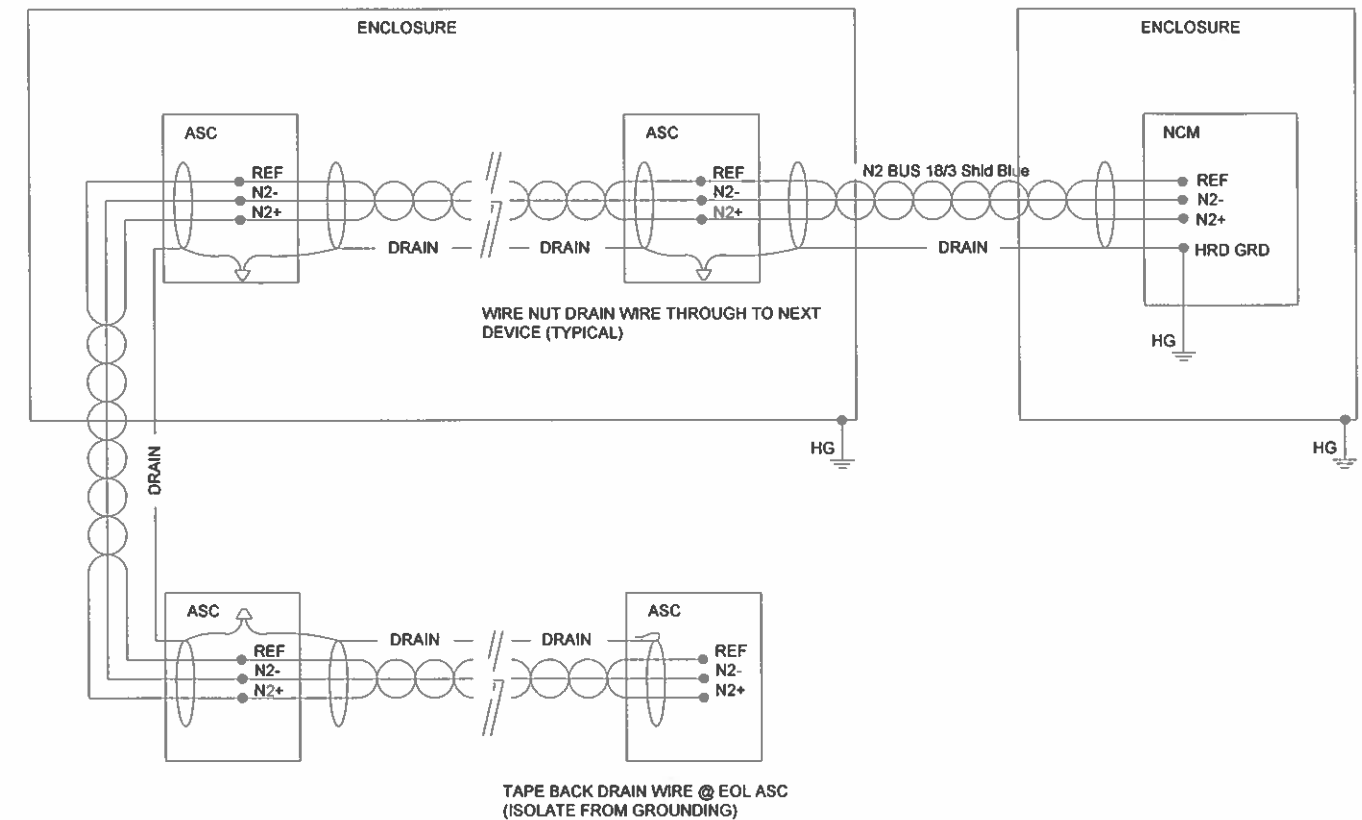

SYMBOL LEGEND		REVISION INFORMATION		Drawing Title		NO		REVISION-LOCATION		ECH		DATE		BY	
○	PNEUMATIC TUBING	NUMBER		LEGEND											
□	LOW VOLTAGE	DATE	04/11/01												
○	CABLE	TIME	10:14 AM	Project Title											
○	HIGH VOLTAGE	FILE NAME	Legend-b.vsd	MILLER PARK ONE BREWERS WAY MILWAUKEE, WI 53214		JOHNSON CONTROLS		Branch Information		CONTRACT NUMBER		DATE		APPROVED	
						Systems & Services Division		Wisconsin Area Office 529 N. Jackson Street Milwaukee WI 53202 Phone: 414-524-7500 Fax: 414-524-7575		9 8075-0508					
										DRAWING NUMBER				1.2	


**TRUNK SCHEMATIC LEGEND**

- HUB** ACTIVE HUB
- OWS** OPERATOR WORKSTATION
- NTU** NETWORK TERMINAL UNIT
- P** PRINTER
- M** MODEM
- ①** N1 DEVICE-NUMBER = ADDRESS
- 1** N2 DEVICE-NUMBER = ADDRESS
- R** N2 BUS REPEATER
- N1-A** N1 ARCNET BUS
- N1-E** N1 ETHERNET BUS
- N1-F** N1 FIBER BUS
- N2** N2 BUS
- NT** NT BUS
- N2/NT** N2 AND NT BUS
- R** RS232 CABLE
- M** MODEM CABLE - RS232
- P** PARALLEL PRINTER CABLE
- XT** XT BUS
- \*** N2 BUS END OF LINE
- +** N1 BUS END OF LINE
- NT JACK ID-NTU115

N1 ADDRESS	N2 ADDRESS	IP ADDRESS	DEVICE TYPE	PANEL & SYSTEM LOCATED	PRIMARY MECH SYSTEM	SERVICE
100	n/a	192.168.55.55	NIE	SL1 - Security Room 1101	n/a	N1 Ethernet
101	n/a	192.168.55.50	OWS	SL8 - Electronics Room 1805	n/a	N1 Ethernet
102	n/a	192.168.55.56	OWS	SL1 - Security Room 1101	n/a	N1 Ethernet
11	n/a	192.168.55.51	NCM-350	SL1 - Security Room 1101	n/a	N2 Devices - Service Level
12	n/a	192.168.55.52	NCM-350	TL8 - Mechanical Room 5804	n/a	N2 Devices
13	n/a	192.168.55.53	NCM-350	SL4 - Mechanical Room 1403	n/a	N2 Devices
14	n/a	192.168.55.54	NCM-350	SL8 - Warehouse Room 1811	n/a	N2 Devices
n/a	n/a		CMMS	SL1 - Security Room 1101	n/a	Maintainance Management


**BILL OF MATERIALS**

Designation	Qty	Part Number	Description
<b>Field Devices:</b>			
CMMS-1	1	22523	APC SURGE SUPPRESSOR POWER STRIP
	1	263047	ZOOM 56K INTERNAL MODEM
	1	319861	NEC 15" MULTISYNC A500+ MONITOR
	1	461832	OPTIPLEX GX1 P3/500, 6.4GB/64MB/CD
	1	462757	64 MB RAM UPGRADE
NTU-x	2	10-BAG101-0	CASE FOR NETWORK TERMINAL
	2	10-NTU102-0	NETWORK TERMINAL W/LIGHT
OWS-101	1	086849	SURGE SUPPRESSOR POWER STRIP - APC
	1	F70648	DELL 17" LCD MONITOR
	1	E63313	P4/2.6GHZ/40GB/512MB/48XCDRW/MN2K-NTFS
	1	C84692	512 MB RAM UPGRADE - KTD4550/512
OWS-102	1	MS-SCTSWO-0	SYSTEM CONFIGURATION TOOL SAW, NEW
	1	117082	SURGE SUPPRESSOR POWER STRIP
	1	263047	ZOOM 56K INTERNAL MODEM
	1	26911-00	NEC 15" MULTISYNC A500+ MONITOR
	1	26981639	OPTIPLEX G1 C/400, 4.3GB/32MB, MB VRAM
	1	331-0555	32 MB RAM UPGRADE
	1	331-0558	64 MB RAM UPGRADE
	1	HPC-F-46850	HP SURESTORE 8200I INTERNAL R/W CD-ROM
	1	NU-NET101-0	NCU,N1 CARD FOR NCM300,ARCNET
	1	WS-SWOPMI-0	WORKSTATION PMI, NEW ON CD
P-1, P-2	2	29006	PRINTE CABLE 6' DB25M/C
	2	51980	EPSON LQ-570, 24-PIN, 8K, 269/90CPS
R-x	2	4683-TTM-1	RS-485 TO RS-485 REPEATER 115VAC@ACRO
<b>Panel Devices:</b>			
NC-x	4	EN-EWC22-0	DUAL ENCLOSURE WITH POWER ENTRY BOX
	4	NU-NCM350-1	NETWORK CTRL MOD
	4	NU-NET101-0	N1 CARD FOR NCM300
S1-NIE01	1	MS-NIE5511-0	NIE EXIST NCM, MODEM, 24VAC, 50VA
	1	EN-EWC25-0	DUAL ENCLOSURE WITH 50 VA POWER

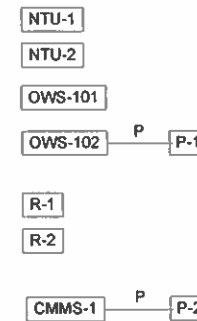

NOTE: DEDICATED PHONE LINE BY OWNER.

REVISION INFORMATION	Drawing Title							
NUMBER	COMMUNICATIONS BUS		1		JCI CONTRACT 4933-0011		8/26/2004 MLR	
DATE	08/26/04		NO		REVISION-LOCATION		ECH DATE BY	
TIME	10:22 AM		Sales Engineer		Project Manager		Application Engineer	
FILE NAME	trunk.vsd		PJS		TP		KJK	
	Project Title		BY		MLR		DATE	
	MILLER PARK ONE BREWERS WAY MILWAUKEE, WI 53214		BY		MLR		DATE	
	JOHNSON CONTROLS Systems & Services Division		Branch Information		Wisconsin Area Office 529 N. Jackson Street Milwaukee WI 53202 Phone: 414-524-7500 Fax: 414-524-7575		CONTRACT NUMBER	
							9 8075-0508	
							DRAWING NUMBER	
							2.1	

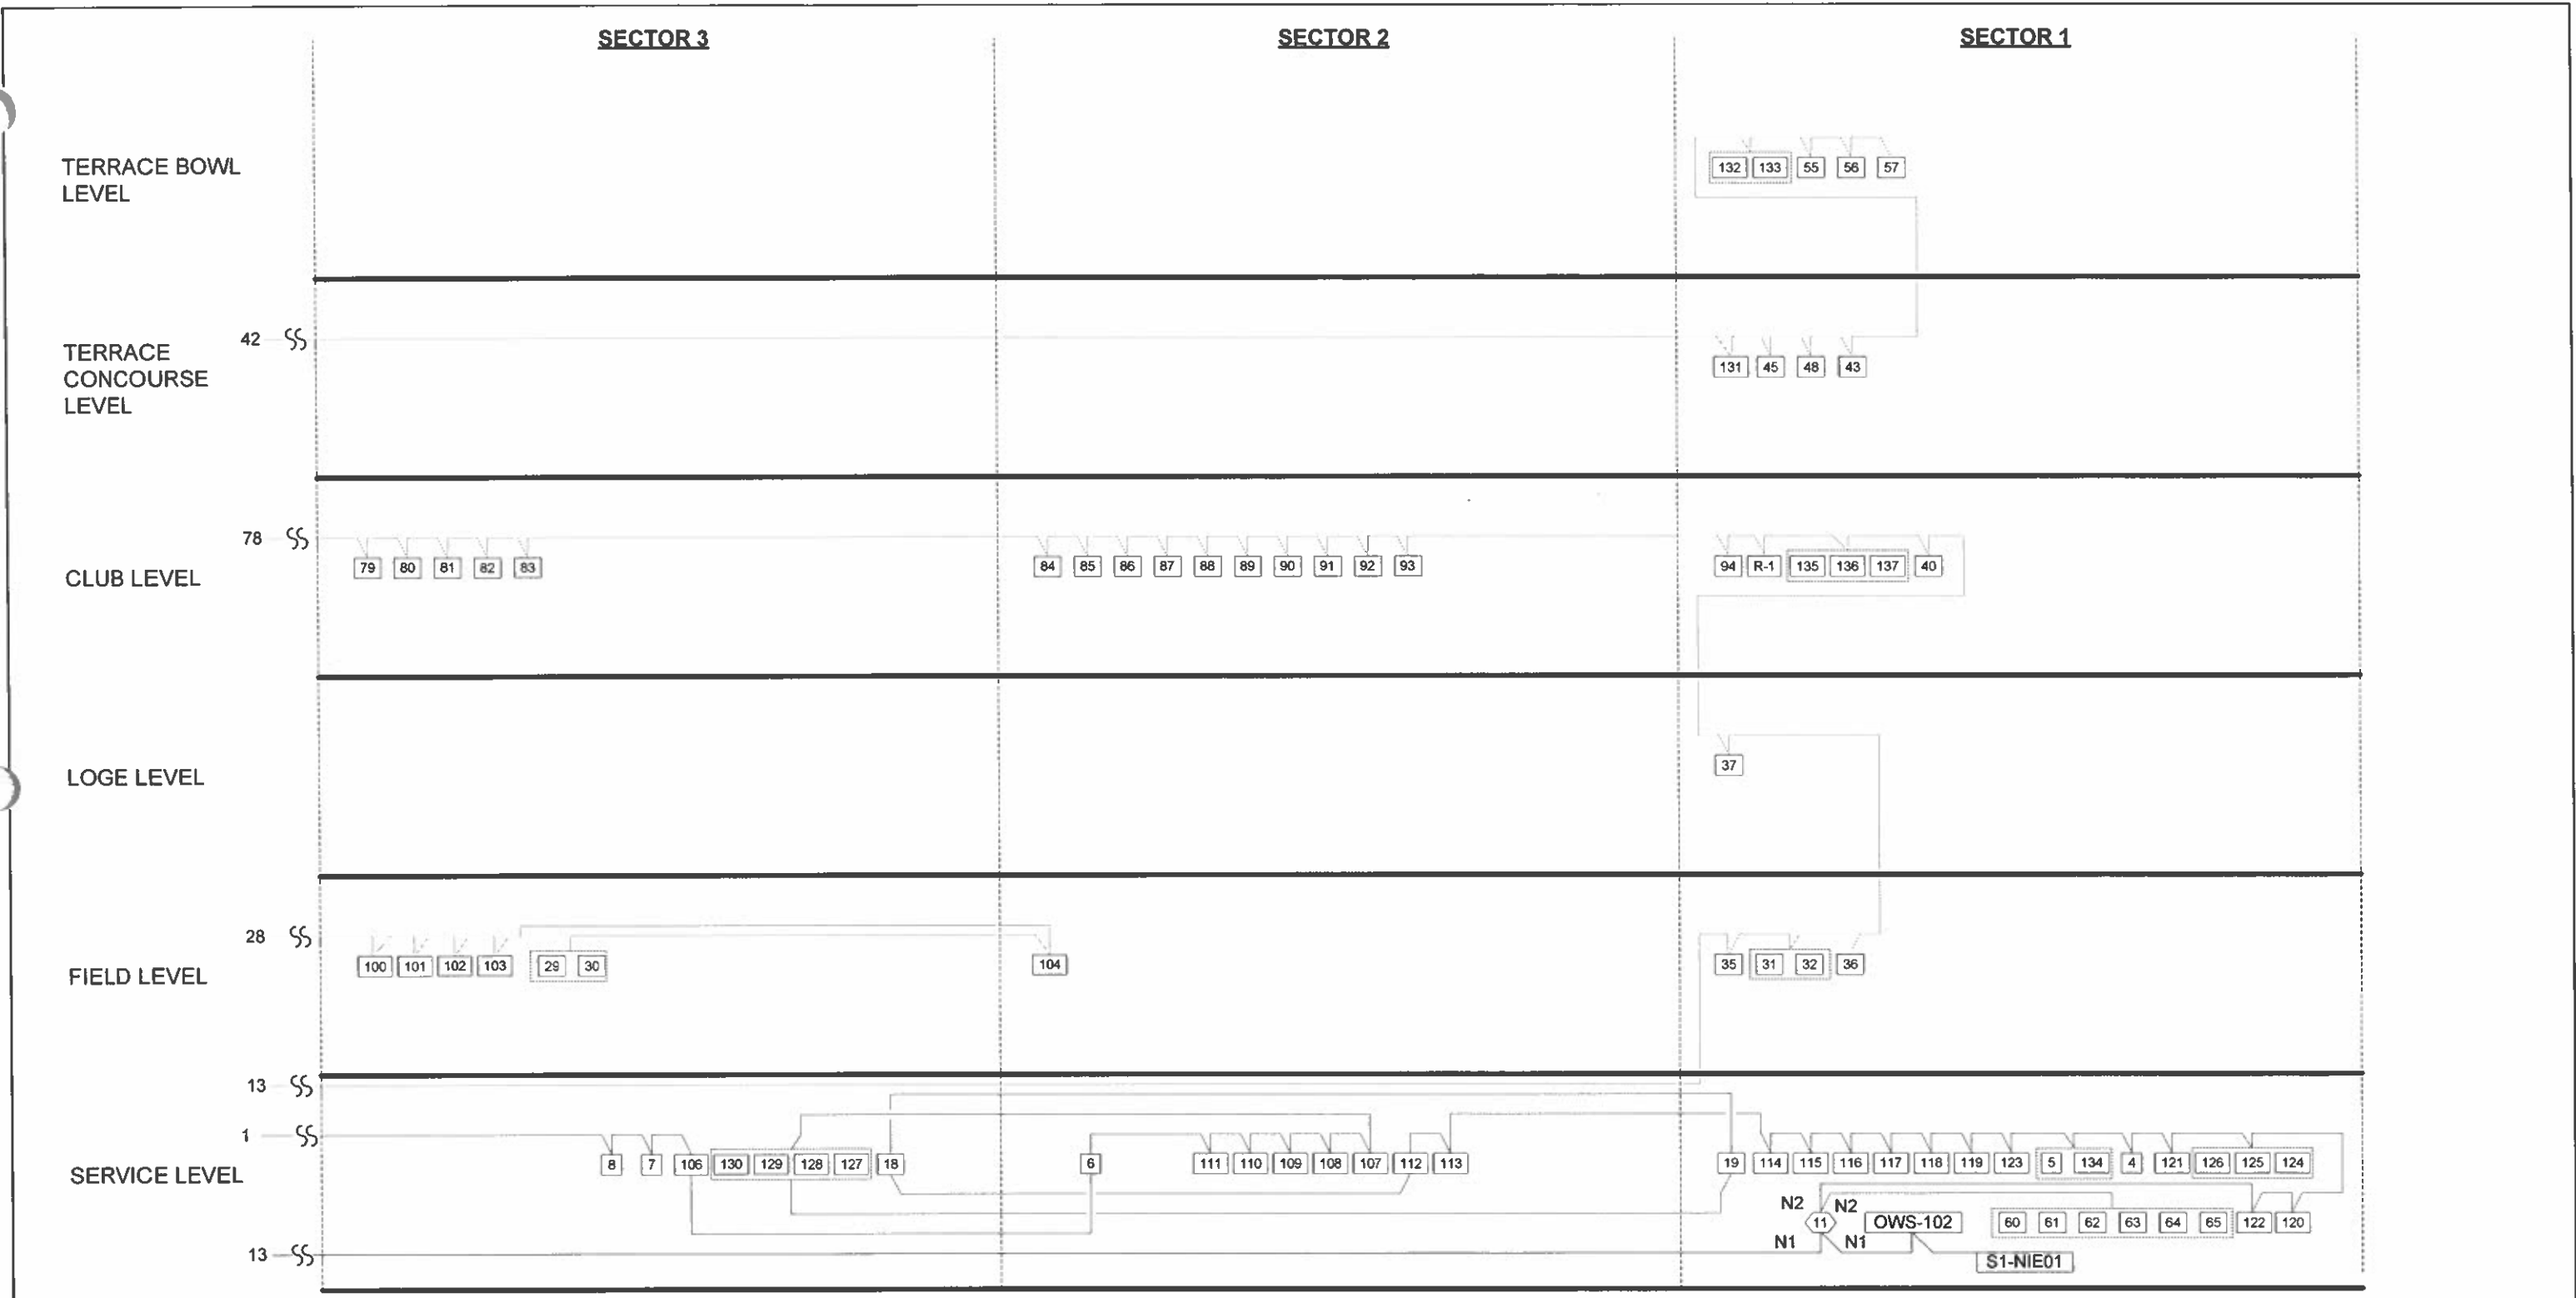



**SECTOR 6**

**SECTOR 5**

**SECTOR 4**

TERRACE BOWL LEVEL


TERRACE CONCOURSE LEVEL

CLUB LEVEL



LOGE LEVEL

FIELD LEVEL

SERVICE LEVEL

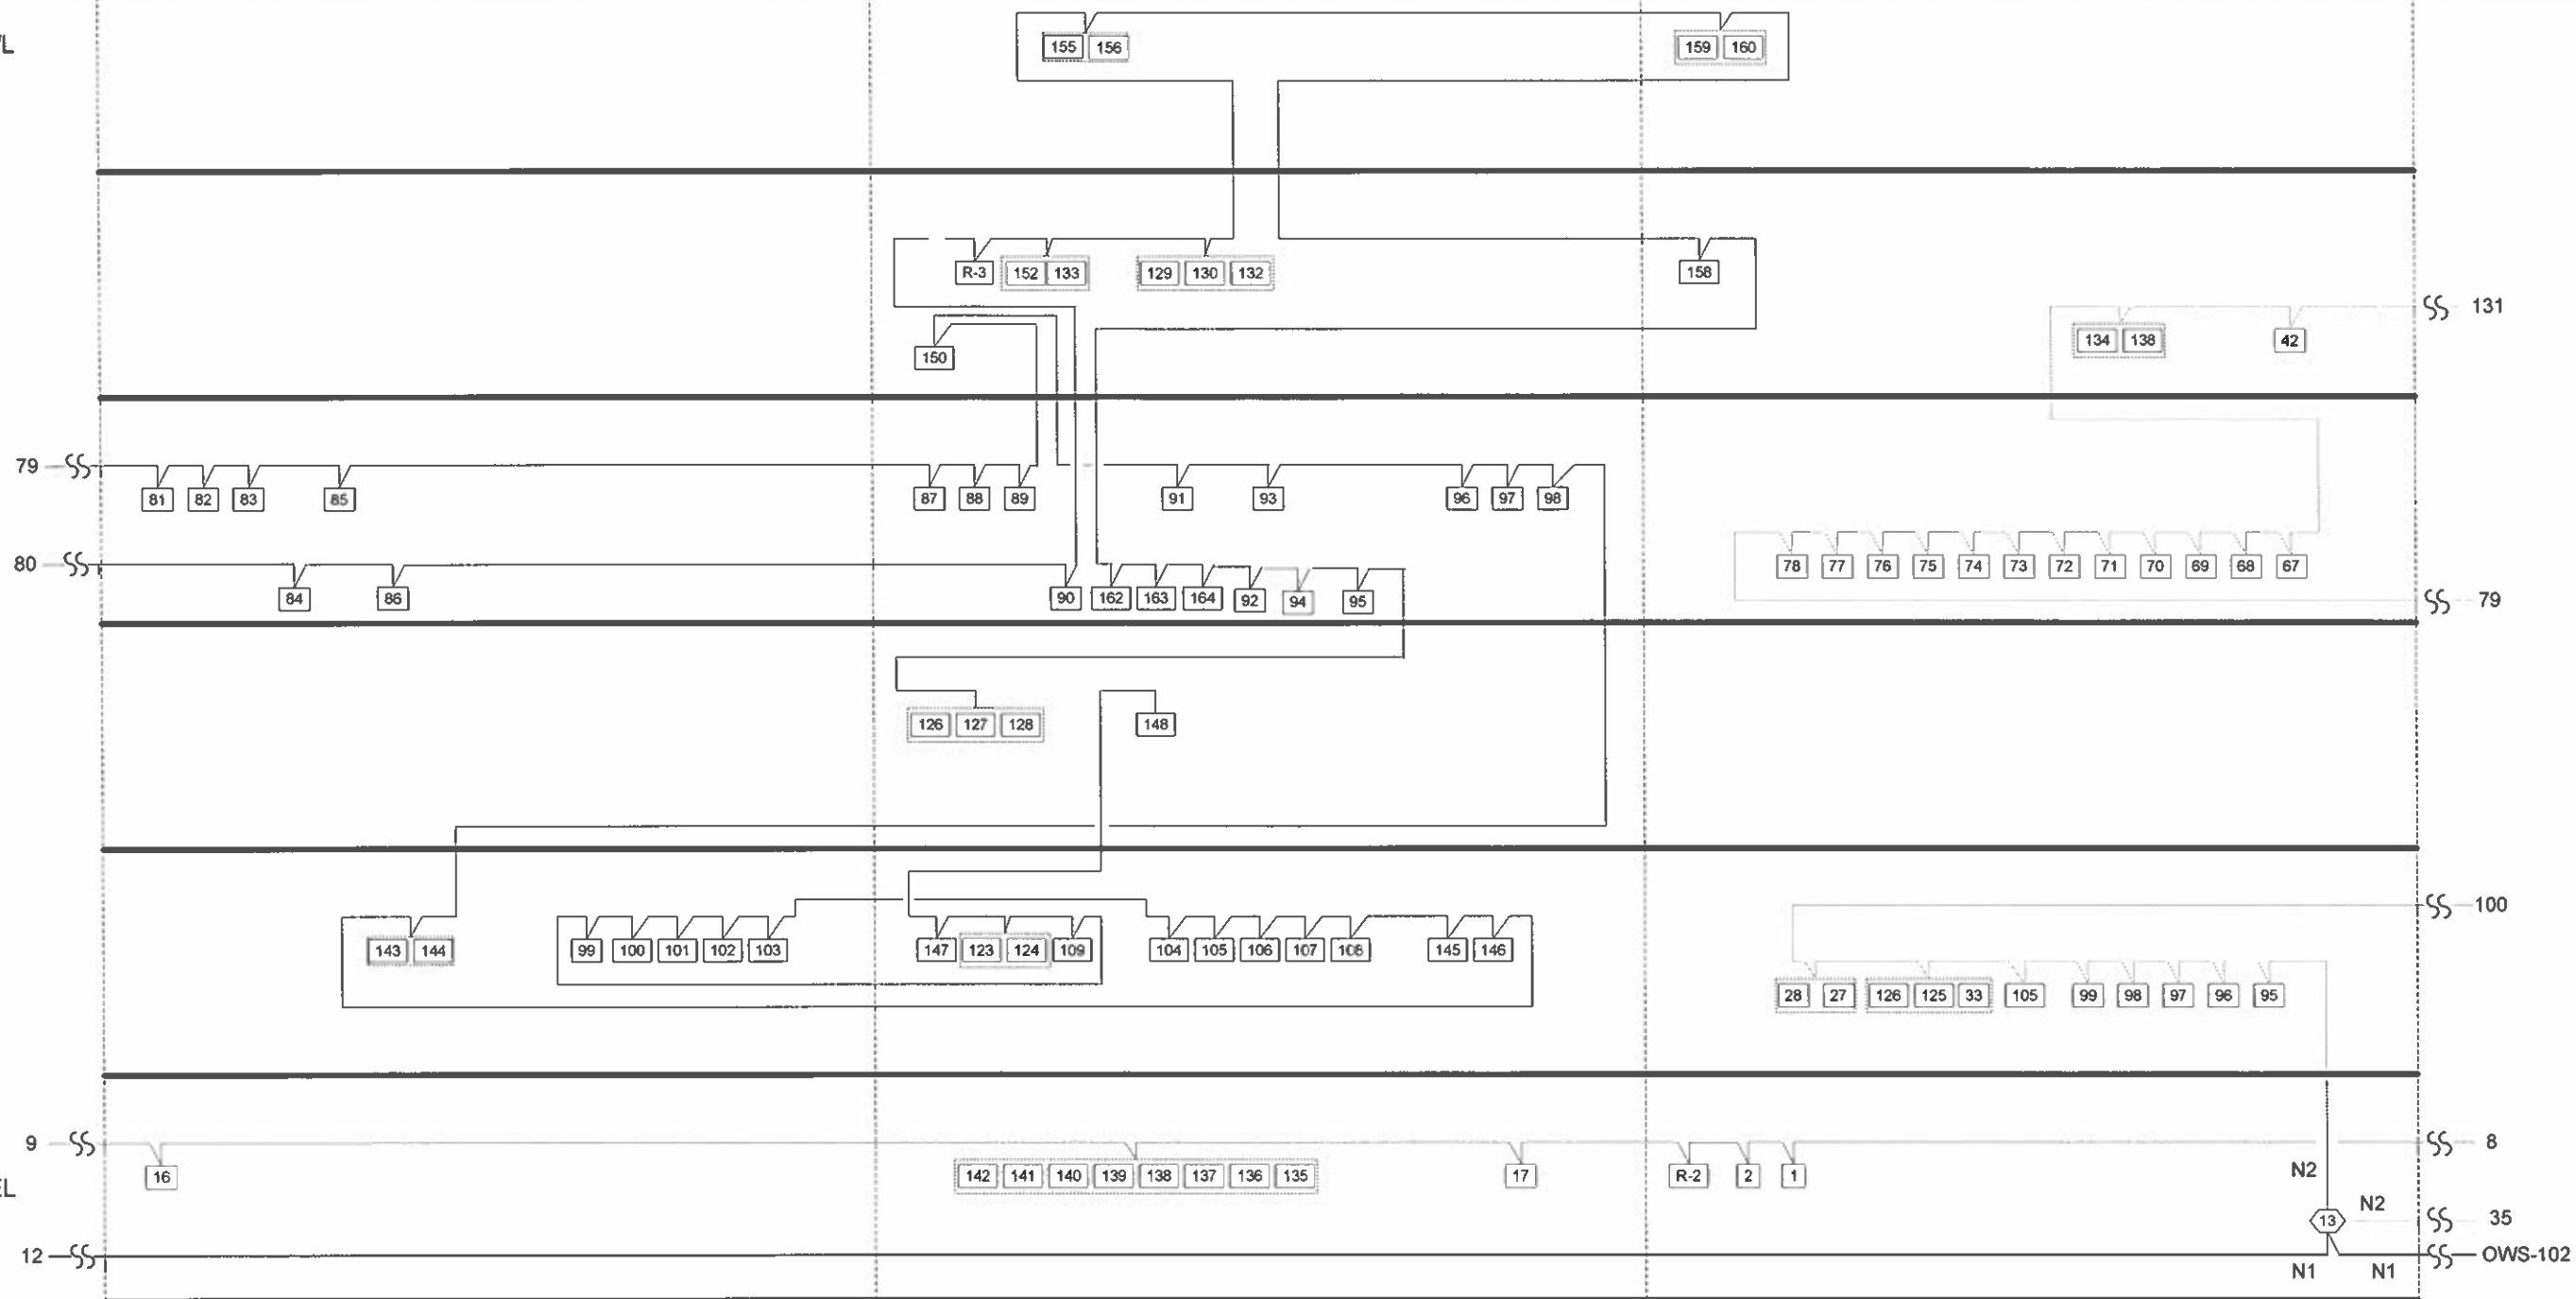

<b>REVISION INFORMATION</b>		Drawing Title									
NUMBER		<b>COMMUNICATIONS BUS</b>		1		JCI CONTRACT 4933-0011		8/26/2004		MLR	
DATE		08/26/04		NO.		REVISION LOCATION		ECN		DATE	
TIME		10:07 AM		Sales Engineer		Project Manager		Application Engineer		APPROVED	
FILE NAME		trunk13a.vsd		PJS		TP		KJK		BY	
		Project Title		MLR		DATE		BY		DATE	
		<b>MILLER PARK ONE BREWERS WAY MILWAUKEE, WI 53214</b>		BY		DATE		BY		DATE	
				Branch Information		CONTRACT NUMBER		9 8075-0508		DRAWING NUMBER	
				<b>JOHNSON CONTROLS</b>		Wisconsin Area Office 529 N. Jackson Street Milwaukee WI 53202 Phone: 414-524-7500 Fax: 414-524-7575				<b>2.3</b>	
				Systems & Services Division							

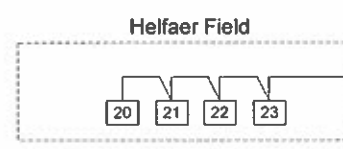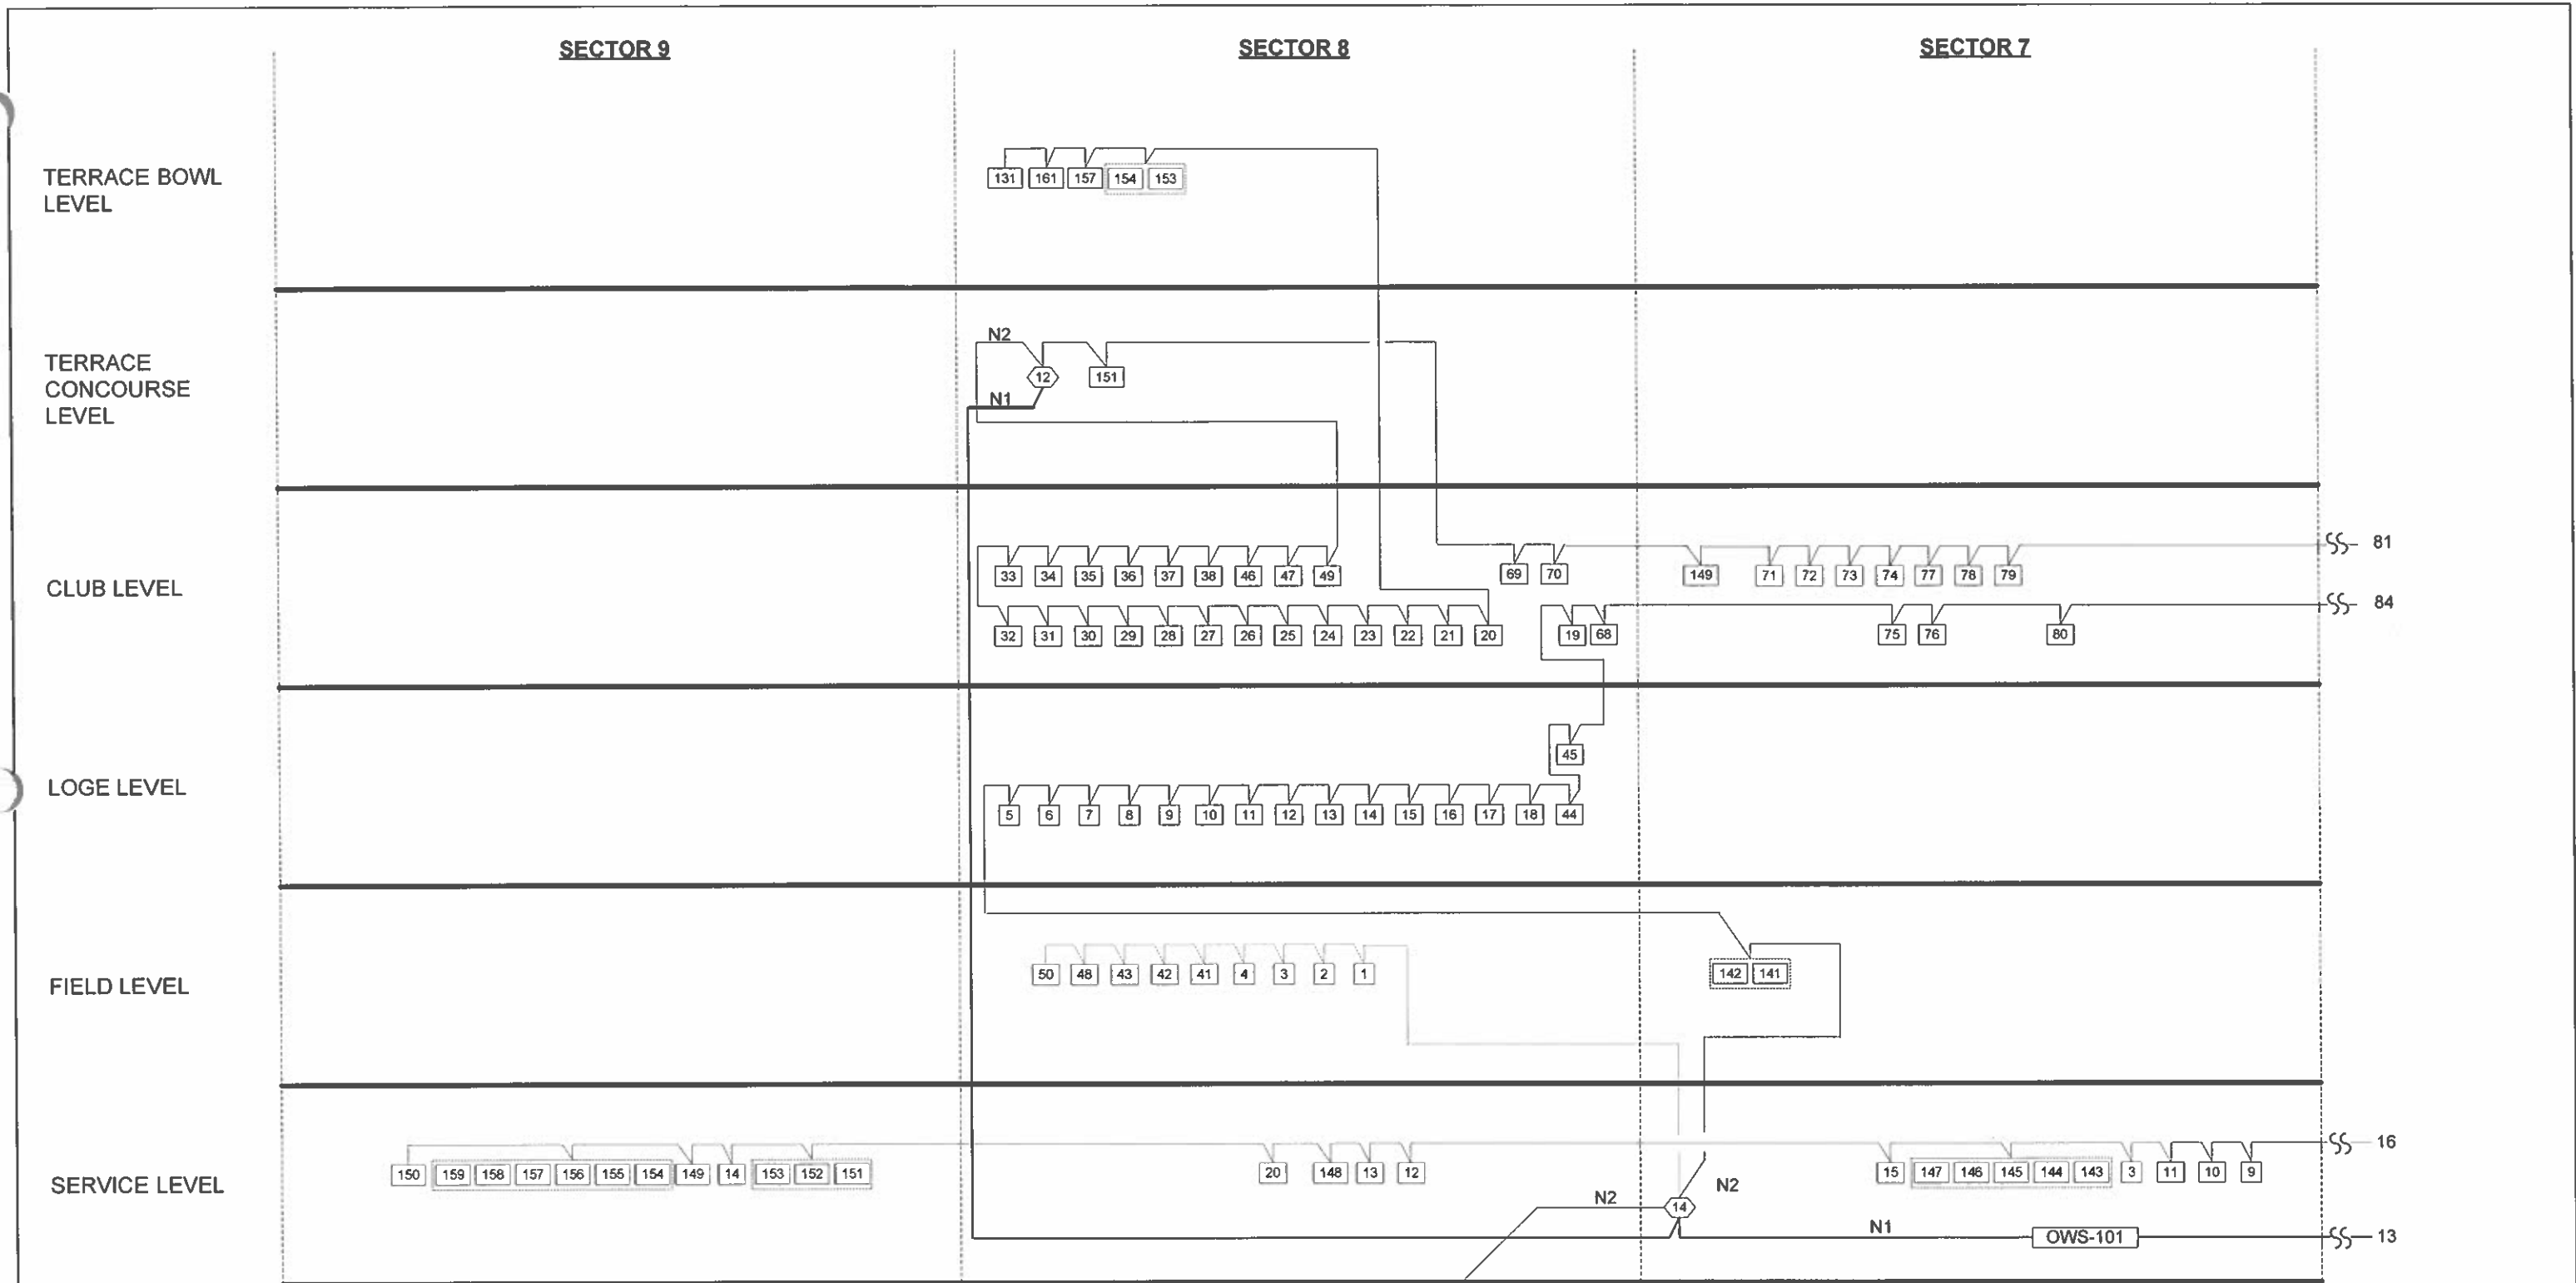

REVISION INFORMATION	Drawing Title								
NUMBER	COMMUNICATIONS BUS								
DATE	08/26/04	NO	1	REVISION-LOCATION	JCI CONTRACT 4933-0011	ECH	8/26/2004	DATE	MLR
TIME	10:06 AM	Sales Engineer	PJS	Project Manager	TP	Application Engineer	KJK	BY	MLR
FILE NAME	trunk12a.vsd	Project Title		MILLER PARK ONE BREWERS WAY MILWAUKEE, WI 53214		Branch Information		CONTRACT NUMBER	
		JOHNSON CONTROLS		Systems & Services Division		Wisconsin Area Office 529 N. Jackson Street Milwaukee WI 53202 Phone: 414-524-7500 Fax: 414-524-7575		9 8075-0508	
								DRAWING NUMBER	
								2.4	

N1 ADDRESS	N2 TRUNK	N2 ADDRESS	DEVICE TYPE	PANEL & SYSTEM LOCATED	PRIMARY MECHANICAL SYSTEM	SERVICE
11	1	1	AHU	SL4	AH-S01	VISITORS CLUBHOUSE
11	1	2	AHU	SL4	AH-S02	BREWERS CLUBHOUSE
11	1	3	AHU	SL7	AH-S03	LOCKER ROOMS
11	1	4	AHU	SL1	AH-S04	FINE DINE FOOD SERV.
11	1	5	AHU	SL1	AH-S05	COMMISSARY
11	1	6	UNT	SL2	AH-S08	NOVELTY WAREHOUSE
11	1	7	UNT	SL3	AH-S10	EQUIP CORRAL 1225
11	1	8	UNT	SL3	AH-S11	SERV TUNNEL LEFT FIELD
11	1	9	UNT	SL7	AH-S12	SERV TUNNEL RIGHT FIELD
11	1	10	UNT	SL7	AH-S13	WORK SHOPS
11	1	11	UNT	SL7	AH-S14	BREWERS BATTING
11	1	12	UNT	SL8	AH-S15	WAREHOUSE 1811 SOUTH
11	1	13	UNT	SL8	AH-S16	WAREHOUSE 1811 NORTH
11	1	14	AHU	SL9	AH-S17	CHILLER ROOM
11	1	15	UNT	SL7	AH-S19	RT FIELD PLENUM
11	1	16	UNT	SL6	AH-S20	1ST BASE PLENUM
11	1	17	UNT	SL5	AH-S21	HOME PLATE PLENUM
11	1	18	UNT	SL3	AH-S22	3RD BASE PLENUM
11	1	19	UNT	SL1	AH-S23	LFT FIELD PLENUM
11	1	20	UNT	SL8	AH-S24	BROADCAST DOCK OFF.
11	1	21	UNT	SL8	ELEC SUBSTATION 5	ELEC RM 1822
11	1	22	UNT	SL8	ELEC SUBSTATION 1	ELEC RM 1809
11	1	23	UNT	SL6	ELEC SUBSTATION 2	ELEC RM 1806
11	1	24	UNT	SL4	ELEC SUBSTATION 3	ELEC RM 1401
11	1	25	UNT	SL1	ELEC SUBSTATION 4	ELEC RM 1121
11	1	26				
11	1	27				
11	1	28				
11	1	29				
11	1	30				
11	1	31				
11	1	32				
11	1	33				
11	1	34				
11	1	35				
11	1	36				
11	1	37				
11	1	38				
11	1	39				
11	1	40				

N1 ADDRESS	N2 TRUNK	N2 ADDRESS	DEVICE TYPE	PANEL & SYSTEM LOCATED	PRIMARY MECHANICAL SYSTEM	SERVICE
11	1	41				
11	1	42				
11	1	43				
11	1	44				
11	1	45				
11	1	46				
11	1	47				
11	1	48				
11	1	49				
11	1	50				
11	1	51				
11	1	52				
11	1	53				
11	1	54				
11	1	55				
11	1	56				
11	1	57				
11	1	58				
11	1	59				
11	1	60	XTM	SL1	BOWL AH UNITS	FIREMAN'S PANEL
11	1	61	XTM	SL1	BOWL AH UNITS	FIREMAN'S PANEL
11	1	62	XTM	SL1	BOWL AH UNITS	FIREMAN'S PANEL
11	1	63	XTM	SL1	BOWL AH UNITS	FIREMAN'S PANEL
11	1	64	XTM	SL1	BOWL AH UNITS	FIREMAN'S PANEL
11	1	65	XTM	SL1	BOWL AH UNITS	FIREMAN'S PANEL
11	1	66				
11	1	67				
11	1	68				
11	1	69				
11	1	70	XTM	SL1	GENERATORS	GEN ALM PANEL
11	1	71				
11	1	72				
11	1	73				
11	1	74				
11	1	75				
11	1	76				
11	1	77				
11	1	78				
11	1	79				
11	1	80				

REVISION INFORMATION	Drawing Title								
NUMBER	COMMUNICATIONS BUS								
DATE	08/26/04	NO.	1	JCI CONTRACT 4933-0011		DATE	8/26/2004	BY	MLR
TIME	10:45 AM	SALES ENGINEER	PJS	PROJECT MANAGER	TP	APPLICATION ENGINEER	KJK	BY	MLR
FILE NAME	trunk11b.vsd	Project Title		MILLER PARK ONE BREWERS WAY MILWAUKEE, WI 53214		Branch Information		CONTRACT NUMBER	
				JOHNSON CONTROLS Systems & Services Division		Wisconsin Area Office 529 N. Jackson Street Milwaukee WI 53202 Phone: 414-524-7500 Fax: 414-524-7575		9 8075-0508	
								DRAWING NUMBER	
								2.5	





N1 ADDRESS	N2 TRUNK	N2 ADDRESS	DEVICE TYPE	PANEL & SYSTEM LOCATED	PRIMARY MECHANICAL SYSTEM	SERVICE
11	1	163				
11	1	164				
11	1	165				
11	1	199				
11	1	200	MIG	SL6	SOUTH GENERATOR	SOUTH GEN CCM
11	1	201	MIG	SL6	SOUTH GENERATOR	SOUTH GEN EMCP II
11	1	202	MIG	SL6	NORTH GENERATOR	NORTH GEN CCM

N1 ADDRESS	N2 TRUNK	N2 ADDRESS	DEVICE TYPE	PANEL & SYSTEM LOCATED	PRIMARY MECHANICAL SYSTEM	SERVICE
11	1	203	MIG	SL6	SOUTH GENERATOR	SOUTH GEN EMCP II
11	1	204				
11	1	205				
11	1	206				
11	1	207				
11	1	208				
11	1	209				
11	1	210	VND	SL8	JMI-210	ELEC SUBSTAT 1
11	1	211	VND	SL6	JMI-211	ELEC SUBSTAT 2
11	1	212	VND	SL4	JMI-212	ELEC SUBSTAT 3
11	1	213	VND	SL1	JMI-213	ELEC SUBSTAT 4
11	1	214	VND	SL8	JMI-214	ELEC SUBSTAT 5
11	1	215				
11	1	216				
11	1	217				
11	1	218				
11	1	219				
11	1	220				
11	1	221				
11	1	222				
11	1	223				
11	1	224				
11	1	225				
11	1	226				
11	1	227				
11	1	228				
11	1	229				
11	1	230				
11	1	231				
11	1	232				
11	1	233				
11	1	234				
11	1	235				
11	1	236				
11	1	237				
11	1	238				
11	1	239				
11	1	240				
11	1	241				
11	1	242				
11	1	243				

REVISION INFORMATION	Drawing Title				
NUMBER	COMMUNICATIONS BUS				
DATE	08/26/04	NO.	1	JCI CONTRACT 4933-0011	8/26/2004 MLR
TIME	10:58 AM	REFERENCE DRAWING			
FILE NAME	Trunk11d.vsd	Sales Engineer	PJS	Project Manager	TP
		Application Engineer	KJK	DATE	
		Branch Information	Wisconsin Area Office 529 N. Jackson Street Milwaukee WI 53202 Phone: 414-524-7500 Fax: 414-524-7575		
		CONTRACT NUMBER	9 8075-0508		
		DRAWING NUMBER	2.6.1		
		JOHNSON CONTROLS Systems & Services Division			

REV	N1 ADDRESS	N2 TRUNK	N2 ADDRESS	DEVICE TYPE	PANEL & SYSTEM LOCATED	PRIMARY MECHANICAL SYSTEM	SERVICE
5	14	1	1	VMA	FL8	VAV-A201	SEE ROOM SCHEDULE
5	14	1	2	VMA	FL8	VAV-A202	SEE ROOM SCHEDULE
5	14	1	3	VMA	FL8	VAV-A203	SEE ROOM SCHEDULE
5	14	1	4	VMA	FL8	VAV-A204	SEE ROOM SCHEDULE
4	14	1	5	VMA	LL8	VAV-A300	SEE ROOM SCHEDULE
4	14	1	6	VMA	LL8	VAV-A301	SEE ROOM SCHEDULE
4	14	1	7	VMA	LL8	VAV-A302	SEE ROOM SCHEDULE
4	14	1	8	VMA	LL8	VAV-A303	SEE ROOM SCHEDULE
4	14	1	9	VMA	LL8	VAV-A304	SEE ROOM SCHEDULE
4	14	1	10	VMA	LL8	VAV-A305	SEE ROOM SCHEDULE
4	14	1	11	VMA	LL8	VAV-A306	SEE ROOM SCHEDULE
4	14	1	12	VMA	LL8	VAV-A307	SEE ROOM SCHEDULE
4	14	1	13	VMA	LL8	VAV-A308	SEE ROOM SCHEDULE
4	14	1	14	VMA	LL8	VAV-A309	SEE ROOM SCHEDULE
4	14	1	15	VMA	LL8	VAV-A310	SEE ROOM SCHEDULE
4	14	1	16	VMA	LL8	VAV-A311	SEE ROOM SCHEDULE
4	14	1	17	VMA	LL8	VAV-A312	SEE ROOM SCHEDULE
4	14	1	18	VMA	LL8	VAV-A313	SEE ROOM SCHEDULE
4	14	1	19	VMA	CL8	VAV-A400	SEE ROOM SCHEDULE
4	12	1	38	VMA	CL8	VAV-A419	SEE ROOM SCHEDULE
	12	1	39				
	12	1	40				

REV	N1 ADDRESS	N2 TRUNK	N2 ADDRESS	DEVICE TYPE	PANEL & SYSTEM LOCATED	PRIMARY MECHANICAL SYSTEM	SERVICE
5	14	1	41	VMA	FL8	VAV-A205	SEE ROOM SCHEDULE
5	14	1	42	VMA	FL8	VAV-A206	SEE ROOM SCHEDULE
5	14	1	43	VMA	FL8	VAV-A207	SEE ROOM SCHEDULE
4	14	1	44	VMA	LL8	VAV-A314	SEE ROOM SCHEDULE
4	14	1	45	VMA	LL8	VAV-A315	SEE ROOM SCHEDULE
4	12	1	46	VMA	CL8	VAV-A420	SEE ROOM SCHEDULE
4	12	1	47	VMA	CL8	VAV-A421	SEE ROOM SCHEDULE
5	14	1	48	AHU	FL8	AH-BA1	BREWERS FLD LVL OFFICE
5	12	1	49	VMA	CL8	VAV-A422	SEE ROOM SCHEDULE
	14	1	50	VMA	FL8	VAV-A208	SEE ROOM SCHEDULE
	14	1	20	VND	Helfaer		
	14	1	21	VMA	Helfaer		
	14	1	22	VMA	Helfaer		
	14	1	23	VND	Helfaer		
	12	1	55				
	12	1	56				
	12	1	57				
	12	1	58				
	12	1	59				
	12	1	60				
	12	1	61				
	12	1	62				
	12	1	63				
	12	1	64				
	12	1	65				
	12	1	66				
	12	1	67				
	14	1	68	VAV	CL8	FC-C01	SEE ROOM SCHEDULE
	12	1	69	VAV	CL8	FC-C02	SEE ROOM SCHEDULE
	12	1	70	VAV	CL8	FC-C03	SEE ROOM SCHEDULE
	12	1	71	VAV	CL7	FC-C04	SEE ROOM SCHEDULE
	12	1	72	VAV	CL7	FC-C05	SEE ROOM SCHEDULE
	12	1	73	VAV	CL7	FC-C06	SEE ROOM SCHEDULE
	12	1	74	VAV	CL7	FC-C07	SEE ROOM SCHEDULE
	14	1	75	VAV	CL7	FC-C08	SEE ROOM SCHEDULE
	14	1	76	VAV	CL7	FC-C09	SEE ROOM SCHEDULE
	12	1	77	VAV	CL7	FC-C10	SEE ROOM SCHEDULE
	12	1	78	VAV	CL7	FC-C11	SEE ROOM SCHEDULE
	12	1	79	VAV	CL7	FC-C12	SEE ROOM SCHEDULE
	14	1	80	VAV	CL7	FC-C13	SEE ROOM SCHEDULE

REVISION INFORMATION	Drawing Title								
NUMBER	COMMUNICATIONS BUS			5		RECORD DRAWING		6/11/2001 MLR	
DATE	08/29/02	REFERENCE DRAWING		NO		REVISION-LOCATION		ECH DATE BY	
TIME	02:39 PM	Sales Engineer		Project Manager		Application Engineer		DRAWN APPROVED	
FILE NAME	trunk12b.vsd	PJS		TP		KJK		BY MLR DATE	
	Project Title	MILLER PARK ONE BREWERS WAY MILWAUKEE, WI 53214		Branch Information		Wisconsin Area Office 529 N. Jackson Street Milwaukee WI 53202 Phone: 414-524-7500 Fax: 414-524-7575		CONTRACT NUMBER <b>9 8075-0508</b> DRAWING NUMBER <b>2.7</b>	
		JOHNSON CONTROLS		Systems & Services Division					

REV	N1 ADDRESS	N2 TRUNK	N2 ADDRESS	DEVICE TYPE	PANEL & SYSTEM LOCATED	PRIMARY MECHANICAL SYSTEM	SERVICE
12	1	81	VAV	CL6	FC-C14	SEE ROOM SCHEDULE	
12	1	82	VAV	CL6	FC-C15	SEE ROOM SCHEDULE	
12	1	83	VAV	CL6	FC-C16	SEE ROOM SCHEDULE	
14	1	84	VAV	CL6	FC-C17	SEE ROOM SCHEDULE	
12	1	85	VAV	CL6	FC-C18	SEE ROOM SCHEDULE	
14	1	86	VAV	CL6	FC-C19	SEE ROOM SCHEDULE	
12	1	87	VAV	CL5	FC-C20	SEE ROOM SCHEDULE	
12	1	88	VAV	CL5	FC-C21	SEE ROOM SCHEDULE	
12	1	89	VAV	CL5	FC-C22	SEE ROOM SCHEDULE	
14	1	90	VAV	CL5	FC-C23	SEE ROOM SCHEDULE	
12	1	91	VAV	CL5	FC-C24	SEE ROOM SCHEDULE	
14	1	92	VAV	CL5	FC-C25	SEE ROOM SCHEDULE	
12	1	93	VAV	CL5	FC-C26	SEE ROOM SCHEDULE	
14	1	94	VAV	CL5	FC-C27	SEE ROOM SCHEDULE	
14	1	95	VAV	CL5	FC-C28	SEE ROOM SCHEDULE	
12	1	96	VAV	CL5	FC-C29	SEE ROOM SCHEDULE	
12	1	97	VAV	CL5	FC-C30	SEE ROOM SCHEDULE	
12	1	98	VAV	CL5	FC-C31	SEE ROOM SCHEDULE	
12	1	99	VAV	FL6	FC-F01	SEE ROOM SCHEDULE	
12	1	100	VAV	FL6	FC-F02	SEE ROOM SCHEDULE	
12	1	101	VAV	FL6	FC-F03	SEE ROOM SCHEDULE	
12	1	102	VAV	FL6	FC-F04	SEE ROOM SCHEDULE	
12	1	103	VAV	FL6	FC-F05	SEE ROOM SCHEDULE	
12	1	104	VAV	FL5	FC-F06	SEE ROOM SCHEDULE	
12	1	105	VAV	FL5	FC-F07	SEE ROOM SCHEDULE	
12	1	106	VAV	FL5	FC-F08	SEE ROOM SCHEDULE	
12	1	107	VAV	FL5	FC-F09	SEE ROOM SCHEDULE	
12	1	108	VAV	FL5	FC-F10	SEE ROOM SCHEDULE	
12	1	109	VAV	FL5	FC-F21	SEE ROOM SCHEDULE	
12	1	110					
12	1	111					
12	1	112					
12	1	113					
12	1	114					
12	1	115					
12	1	116					
12	1	117					
12	1	118					
12	1	119					
12	1	120					

12	1	125					
14	1	126	UNT	LL5	RCs	SEE ROOM SCHEDULE	
14	1	127	UNT	LL5	RCs	SEE ROOM SCHEDULE	
14	1	128	UNT	LL5	RCs	SEE ROOM SCHEDULE	
14	1	129	XTM	TC5	MUX	N/A	
14	1	130	XTM	TC5	MUX	N/A	
12	1	131	XTM	TB8	MUX	N/A	
14	1	132	XTM	TC5	MUX	N/A	
12	1	133	XTM	TC5	MUX	N/A	
12	1	134					
12	1	135					
12	1	136					
12	1	137					
12	1	138					
12	1	139					
12	1	140					
14	1	141	DX	FL7	AH-F01	RT FIELD BOWL	
12	1	142	XT	FL7	AH-F01	RT FIELD BOWL	
12	1	143	DX	FL6	AH-F02	HOME / RT FIELD BOWL	
12	1	144	XT	FL6	AH-F02	HOME / RT FIELD BOWL	
12	1	145	DX	FL5	AH-F03	1ST BASE BOWL	
12	1	146	XT	FL5	AH-F03	1ST BASE BOWL	
12	1	147	AHU	FL5	AH-F12	TICKET OFFICE RIGHT	
12	1	148	AHU	LL5	AH-L04	PRESS BOX	
12	1	149	AHU	CL7	AH-C01	RF CLUB CONCOURSE	
12	1	150	UNT	TC5	AH-T01	CLUB BOWL RT FIELD	
12	1	151	AHU	TC8	AH-T06	BREWER OFFICE	
14	1	152	UNT	TC5	AH-T09	FIRST AID - HOME PLATE	
12	1	153	DX	TB8	AH-TB01	RT FIELD BOWL	
12	1	154	XT	TB8	AH-TB01	RT FIELD BOWL	
14	1	155	DX	TB5	AH-TB02	HOME PLATE RIGHT	
12	1	156	XT	TB5	AH-TB02	HOME PLATE RIGHT	
12	1	157	UNT	TB8	AH-TB06	RT FIELD CONCOURSE	
14	1	158	AHU	TC4	AH-T08	NOVELTY STORE	
14	1	159	DX	TB4	AH-TB03	HOME PLATE LEFT	
12	1	160	XT	TB4	AH-TB03	HOME PLATE LEFT	
12	1	161	VAV	TB8	MUX	N/A	
12	1	162	VAV	CL5	FC1	SUITE KITCHEN	
12	1	163	VAV	CL5	FC2&3	SUITE KITCHEN	
12	1	164	VAV	CL5	FC4	SUITE KITCHEN	

REVISION INFORMATION	Drawing Title				
NUMBER	COMMUNICATIONS BUS				
DATE	08/16/02	REFERENCE DRAWING	NO	REVISION-LOCATION	DATE
TIME	10:10 AM	Sales Engineer	Project Manager	Application Engineer	DATE
FILE NAME	trunk12c.vsd	PJS	TP	KJK	DATE
	Project Title	Branch Information		CONTRACT NUMBER	
	MILLER PARK ONE BREWERS WAY MILWAUKEE, WI 53214	<b>JOHNSON CONTROLS</b> Wisconsin Area Office 529 N. Jackson Street Milwaukee WI 53202 Phone: 414-524-7500 Fax: 414-524-7575		9 8075-0508	
		Systems & Services Division		DRAWING NUMBER	2.8

N1 ADDRESS	N2 TRUNK	N2 ADDRESS	DEVICE TYPE	PANEL & SYSTEM LOCATED	PRIMARY MECHANICAL SYSTEM	SERVICE
13	1	1				
13	1	2				
13	1	3				
13	1	4				
13	1	5				
13	1	6				
13	1	7				
13	1	8				
13	1	9				
13	1	10				
13	1	11				
13	1	12				
13	1	13				
13	1	14				
13	1	15				
13	1	16				
13	1	17				
13	1	18				
13	1	19				
13	1	20				
13	1	21				
13	1	22				
13	1	23				
13	1	24				
13	1	25				
13	1	26	UNT	SCOREBOARD REAR	ELEC SUBSTATION 6	ELEC SUBSTATION 6
13	1	27	DX	FL4	AH-F04	3RD BASE BOWL
13	1	28	XT	FL4	AH-F04	3RD BASE BOWL
13	1	29	DX	FL3	AH-F05	HOME / LF BOWL
13	1	30	XT	FL3	AH-F05	HOME / LF BOWL
13	1	31	DX	FL1	AH-F06	LEFT FIELD BOWL
13	1	32	XT	FL1	AH-F06	LEFT FIELD BOWL
13	1	33	AHU	FL4	AH-F11	TICKET OFFICE LEFT
13	1	34				
13	1	35	AHU	FL1	AH-F13	BREW PUB
13	1	36	AHU	FL1	AH-F14	NOVELTY STORE
13	1	37	AHU	LL1	AH-L01	HALL OF FAME
13	1	38				
13	1	39				
13	1	40	AHU	CL1	AH-C02	.300 CLUB RESTAURANT

N1 ADDRESS	N2 TRUNK	N2 ADDRESS	DEVICE TYPE	PANEL & SYSTEM LOCATED	PRIMARY MECHANICAL SYSTEM	SERVICE
13	1	41				
13	1	42	UNT	TC4	AH-T02	CLUB BOWL LFT FIELD
13	1	43	AHU	TC1	AH-T05	LF CLUB CONCOURSE
13	1	44				
13	1	45	AHU	TC1	AH-T07	BEER GARDEN
13	1	46				
13	1	47				
13	1	48	UNT	TC1	AH-T10	CLUB KITCHEN
13	1	49	UNT141	P-F15	FL/1 MEZZANINE	AH-F15
13	1	50	UNT141	P-F15	FL/1 MEZZANINE	EXHAUST FANS
13	1	51	UNT140	P-BC1	FL/1 MEZZANINE	BOOSTER COILS
13	1	52	UNT140	P-BC1	FL/1 MEZZANINE	BOOSTER COILS
13	1	53	UNT140	P-BC1	FL/1 MEZZANINE	BOOSTER COILS
13	1	54	UNT140	P-BC1	FL/1 MEZZANINE	BOOSTER COILS
13	1	55	DX	TB1	AH-TB04	LEFT FIELD CLUB
13	1	56	XT	TB1	AH-TB04	LEFT FIELD CLUB
13	1	57	UNT	TB1	AH-TB05	LF BOWL / CONCOURSE
13	1	58				
13	1	59				
13	1	60				
13	1	61				
13	1	62				
13	1	63				
13	1	64				
13	1	65				
13	1	66				
13	1	67	VAV	CL4	FC-C32	SEE ROOM SCHEDULE
13	1	68	VAV	CL4	FC-C33	SEE ROOM SCHEDULE
13	1	69	VAV	CL4	FC-C34	SEE ROOM SCHEDULE
13	1	70	VAV	CL4	FC-C35	SEE ROOM SCHEDULE
13	1	71	VAV	CL4	FC-C36	SEE ROOM SCHEDULE
13	1	72	VAV	CL4	FC-C37	SEE ROOM SCHEDULE
13	1	73	VAV	CL4	FC-C38	SEE ROOM SCHEDULE
13	1	74	VAV	CL4	FC-C39	SEE ROOM SCHEDULE
13	1	75	VAV	CL4	FC-C40	SEE ROOM SCHEDULE
13	1	76	VAV	CL4	FC-C41	SEE ROOM SCHEDULE
13	1	77	VAV	CL4	FC-C42	SEE ROOM SCHEDULE
13	1	78	VAV	CL4	FC-C43	SEE ROOM SCHEDULE
13	1	79	VAV	CL3	FC-C44	SEE ROOM SCHEDULE
13	1	80	VAV	CL3	FC-C45	SEE ROOM SCHEDULE


REVISION INFORMATION	Drawing Title								
NUMBER	COMMUNICATIONS BUS								
DATE									
08/26/04									
TIME	Project Title								
11:00 AM	MILLER PARK ONE BREWERS WAY MILWAUKEE, WI 53214								
FILE NAME									
trunk13b.vsp									
		1		RECORD DRAWING		8/26/2004		MLR	
		NO.		REVISION LOCATION		EON		DATE	
		PJS		TP		KJK		DATE	
		BY		MLR		DATE		APPROVED	
		BY		MLR		DATE		APPROVED	
		CONTRACT NUMBER		9 8075-0508		DRAWING NUMBER		2.9	
		Branch Information		Johnson Controls Wisconsin Area Office 529 N Jackson Street Milwaukee WI 53202 Phone: 414-524-7500 Fax: 414-524-7575					

REV	N1 ADDRESS	N2 TRUNK	N2 ADDRESS	DEVICE TYPE	PANEL & SYSTEM LOCATED	PRIMARY MECHANICAL SYSTEM	SERVICE
4	13	1	81	VAV	CL3	FC-C46	SEE ROOM SCHEDULE
4	13	1	82	VAV	CL3	FC-C47	SEE ROOM SCHEDULE
4	13	1	83	VAV	CL3	FC-C48	SEE ROOM SCHEDULE
4	13	1	84	VAV	CL2	FC-C49	SEE ROOM SCHEDULE
4	13	1	85	VAV	CL2	FC-C50	SEE ROOM SCHEDULE
4	13	1	86	VAV	CL2	FC-C51	SEE ROOM SCHEDULE
4	13	1	87	VAV	CL2	FC-C52	SEE ROOM SCHEDULE
4	13	1	88	VAV	CL2	FC-C53	SEE ROOM SCHEDULE
4	13	1	89	VAV	CL2	FC-C54	SEE ROOM SCHEDULE
4	13	1	90	VAV	CL2	FC-C55	SEE ROOM SCHEDULE
4	13	1	91	VAV	CL2	FC-C56	SEE ROOM SCHEDULE
4	13	1	92	VAV	CL2	FC-C57	SEE ROOM SCHEDULE
4	13	1	93	VAV	CL2	FC-C58	SEE ROOM SCHEDULE
4	13	1	94	VAV	CL1	FC-C59	SEE ROOM SCHEDULE
4	13	1	95	VAV	FL4	FC-F11	SEE ROOM SCHEDULE
4	13	1	96	VAV	FL4	FC-F12	SEE ROOM SCHEDULE
4	13	1	97	VAV	FL4	FC-F13	SEE ROOM SCHEDULE
4	13	1	98	VAV	FL4	FC-F14	SEE ROOM SCHEDULE
4	13	1	99	VAV	FL4	FC-F15	SEE ROOM SCHEDULE
4	13	1	100	VAV	FL3	FC-F16	SEE ROOM SCHEDULE
4	13	1	101	VAV	FL3	FC-F17	SEE ROOM SCHEDULE
4	13	1	102	VAV	FL3	FC-F18	SEE ROOM SCHEDULE
4	13	1	103	VAV	FL3	FC-F19	SEE ROOM SCHEDULE
4	13	1	104	VAV	FL2	FC-F20	SEE ROOM SCHEDULE
4	13	1	105	VAV	FL4	FC-F22	SEE ROOM SCHEDULE
	13	1	106				
	13	1	107				
	13	1	108				
	13	1	109				
	13	1	110				
	13	1	111				
	13	1	112				
	13	1	113				
	13	1	114				
	13	1	115				
	13	1	116				
	13	1	117				
	13	1	118				
	13	1	119				
	13	1	120				

REV	N1 ADDRESS	N2 TRUNK	N2 ADDRESS	DEVICE TYPE	PANEL & SYSTEM LOCATED	PRIMARY MECHANICAL SYSTEM	SERVICE
	13	1	121				
	13	1	122				
	13	1	123				
	13	1	124				
4	13	1	125	UNT	FL4	RCs	SEE ROOM SCHEDULE
4	13	1	126	UNT	FL4	RCs	SEE ROOM SCHEDULE
	13	1	127				
	13	1	128				
	13	1	129				
	13	1	130				
4	13	1	131	UNT	TC1	RCs	SEE ROOM SCHEDULE
4	13	1	132	XTM	TB1	MUX	N/A
4	13	1	133	XTM	TB1	MUX	N/A
4	13	1	134	XTM	TC4	MUX	N/A
4	13	1	135	UNT	CL1	RCs	SEE ROOM SCHEDULE
4	13	1	136	UNT	CL1	RCs	SEE ROOM SCHEDULE
4	13	1	137	UNT	CL1	RCs	SEE ROOM SCHEDULE
	13	1	138	XTM	TC4	MUX	N/A
	13	1	139	VAV	FL1	RCs	FRIDAYS BB RADIATION
	13	1	140				
	13	1	141				
	13	1	142				
	13	1	143				
	13	1	144				
	13	1	145				
	13	1	146				
	13	1	147				
	13	1	148				
	13	1	149				
	13	1	150				
	13	1	151				
	13	1	152				
	13	1	153				
	13	1	154				
	13	1	155				
	13	1	156				
	13	1	157				
	13	1	158				
	13	1	159				
	13	1	160				

REVISION INFORMATION	Drawing Title																									
	NUMBER	COMMUNICATIONS BUS																								
DATE	08/16/02																									
TIME	10:10 AM																									
FILE NAME	trunk13c.vsd																									
Project Title		MILLER PARK ONE BREWERS WAY MILWAUKEE, WI 53214		<table border="1"> <tr> <td>REFERENCE DRAWING</td> <td>NO.</td> <td colspan="2">REVISION LOCATION</td> <td>ECH</td> <td>DATE</td> <td>BY</td> </tr> <tr> <td>Sales Engineer</td> <td>Project Manager</td> <td>Application Engineer</td> <td>BY</td> <td>MLR</td> <td>DATE</td> <td>APPROVED</td> </tr> <tr> <td>PJS</td> <td>TP</td> <td>KJK</td> <td></td> <td></td> <td></td> <td></td> </tr> </table>		REFERENCE DRAWING	NO.	REVISION LOCATION		ECH	DATE	BY	Sales Engineer	Project Manager	Application Engineer	BY	MLR	DATE	APPROVED	PJS	TP	KJK				
REFERENCE DRAWING	NO.	REVISION LOCATION		ECH	DATE	BY																				
Sales Engineer	Project Manager	Application Engineer	BY	MLR	DATE	APPROVED																				
PJS	TP	KJK																								
Branch Information		<b>JOHNSON CONTROLS</b> Systems & Services Division		Wisconsin Area Office 529 N. Jackson Street Milwaukee WI 53202 Phone: 414-524-7500 Fax: 414-524-7575																						
				CONTRACT NUMBER <b>9 8075-0508</b> DRAWING NUMBER <b>2.10</b>																						



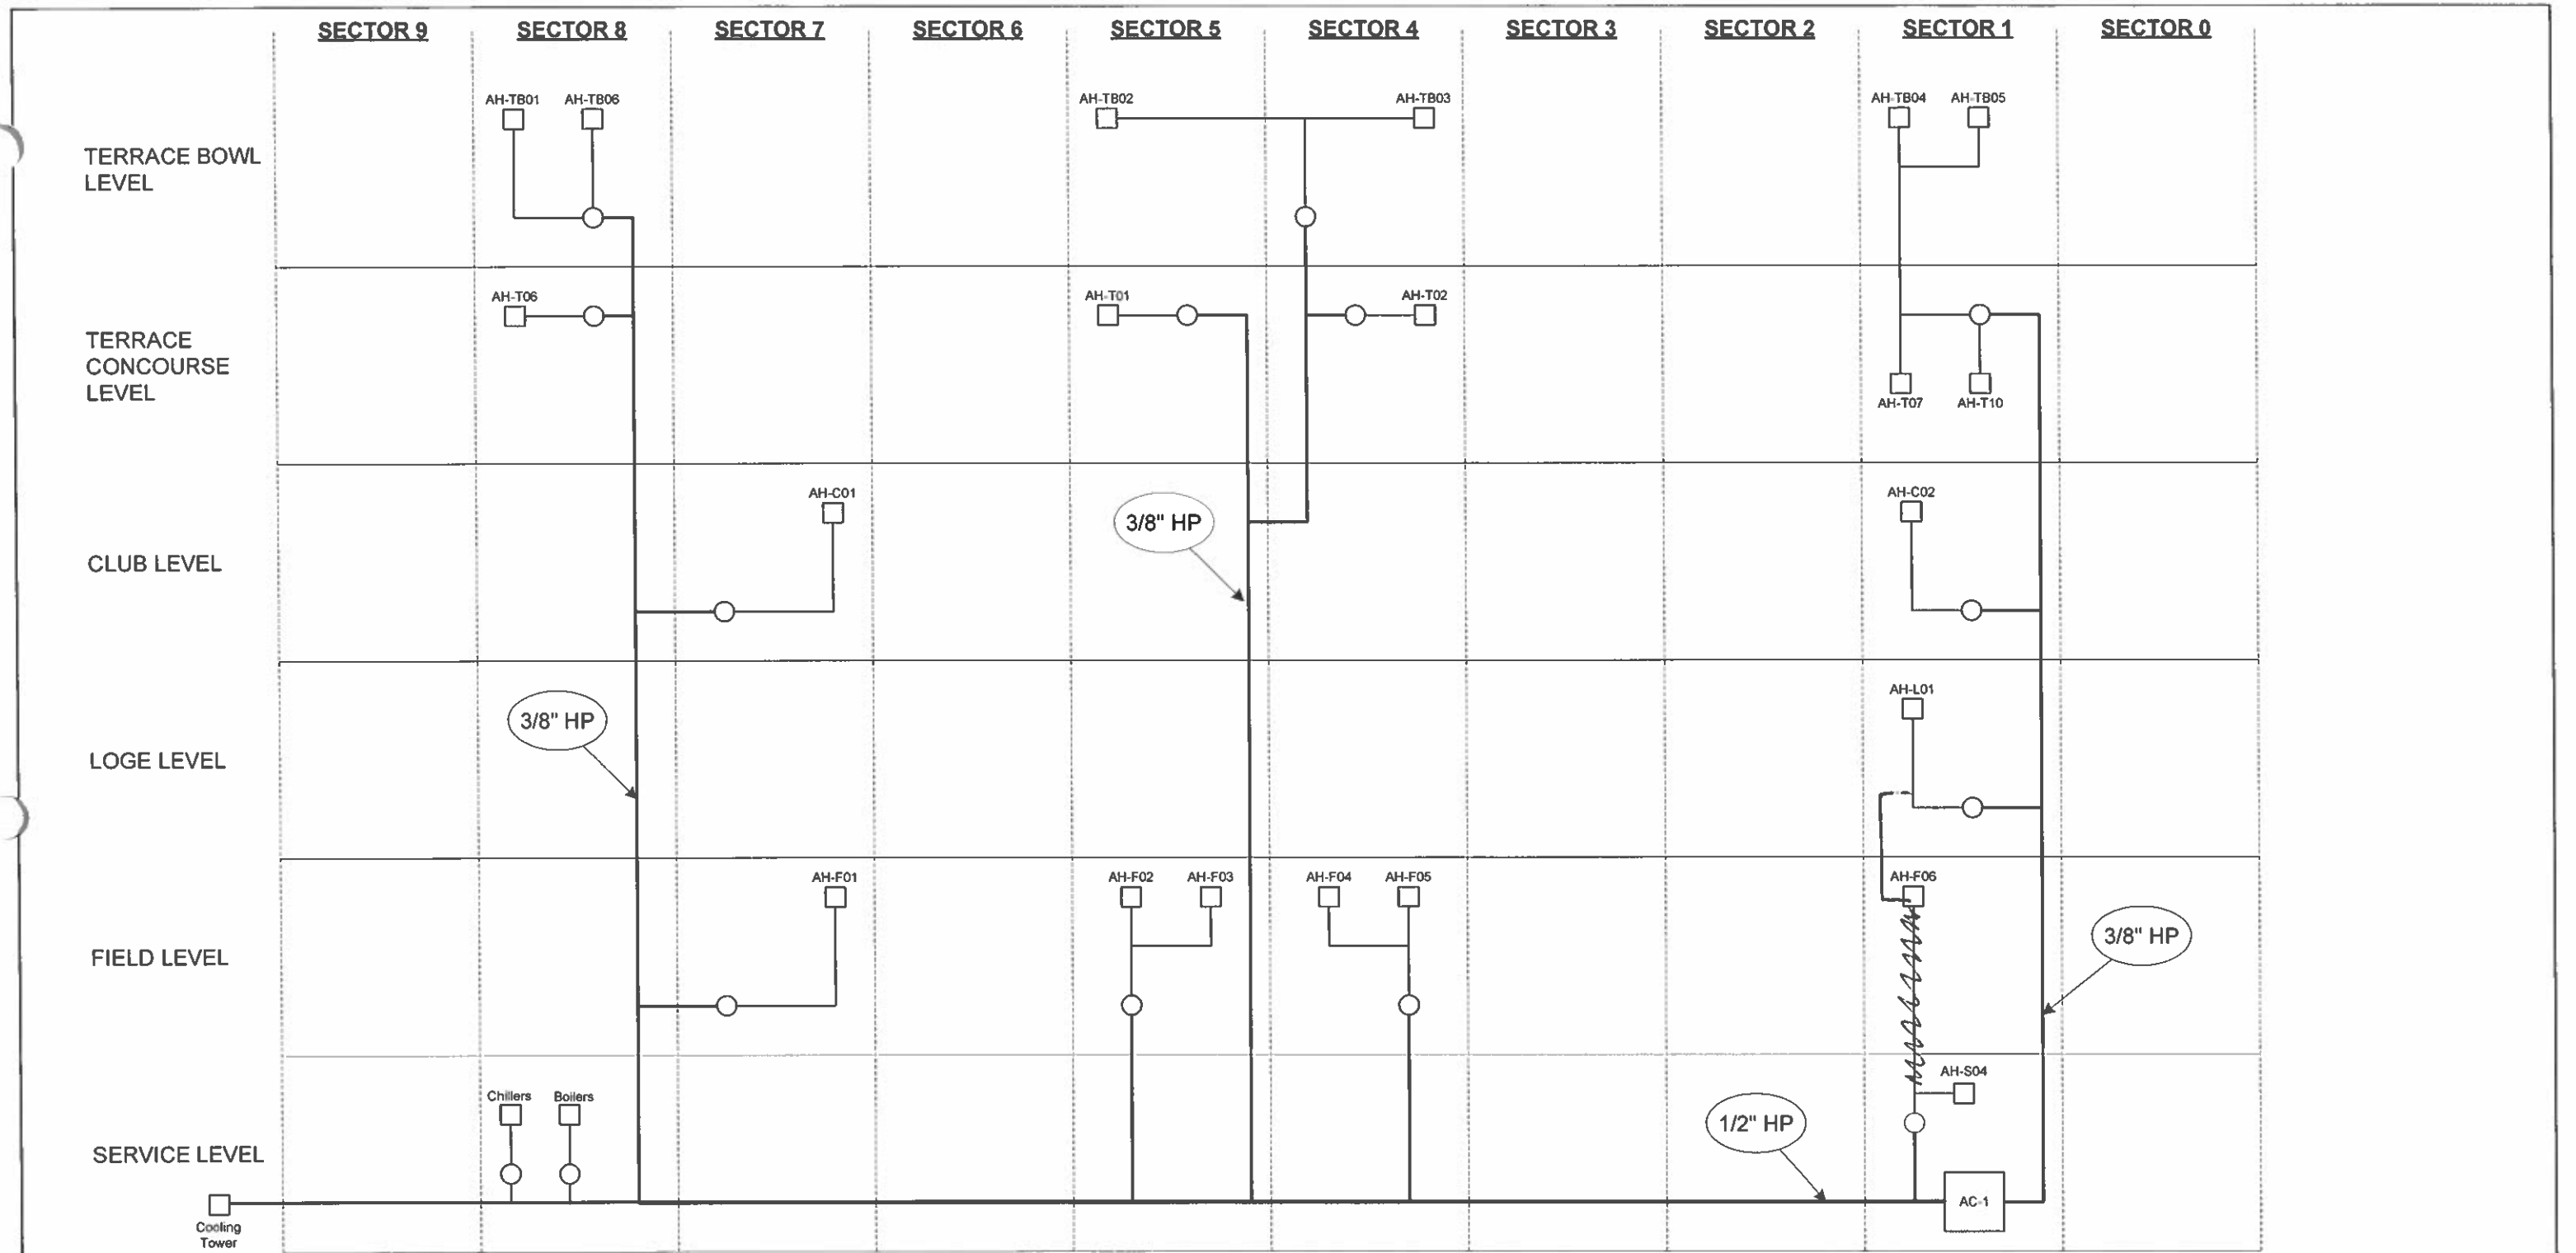

**NOTES:**

1. Not to Scale.
2. Main Sizing as shown with Compression Fittings.
3. For Air Compressor / Dryer Detail, See Page 36.7, Detail K
4. For DDC Temperature Control Panel Details, See the Individual Air Handler Drawings.





**LEGEND:**

- Pressure Reducing Valve
- DDC Temperature Control Panel
- High Pressure Mains (80PSIG)
- Low Pressure Mains (20PSIG)
- AC-1 Air Compressor & Dryer

<b>REVISION INFORMATION</b> NUMBER: _____ DATE: 07/17/01 TIME: 07:14 AM FILE NAME: pneum-riser.vsd		<b>Drawing Title</b> <b>PNEUMATIC RISER</b>		<b>Project Title</b> <b>MILLER PARK</b> <b>ONE BREWERS WAY</b> <b>MILWAUKEE, WI 53214</b>		<b>REFERENCE DRAWING</b> Sales Engineer: PJS Project Manager: TP Application Engineer: KJK		<b>NO.</b> KJK		<b>REVISION/LOCATION</b> BY: MLR DATE: _____		<b>ECN</b> DATE: _____ BY: _____		<b>APPROVED</b> DATE: _____ BY: _____	
<b>JOHNSON CONTROLS</b> Systems & Services Division						Wisconsin Area Office 529 N. Jackson Street Milwaukee WI 53202 Phone: 414-524-7500 Fax: 414-524-7575				<b>CONTRACT NUMBER</b> <b>9 8075-0508</b>		<b>DRAWING NUMBER</b> <b>3.1</b>			


**BILL OF MATERIALS**

Designation	Qty	Part Number	Description
<b>Field Devices:</b>			
ASV-x	4	VGA8B2GT+3008E	3-W AIR VALVE 3/8IN BARB FTGS & MTG BRKT
ES-x	4	802T-A	
	4	802T-W2A	POSITION SWITCH - AB
SHWx-DP	3	PR282-44B12B	XDUCER, HI-DP 0-100# 4-20MA 24VAC NEMA 1
	9	VNH3-AM	1/4" BALL VALVE, 200F - DYNAQUIP
X-T	9	TE-631AP-1	SENS. T-NI, 0.1%, F/MZ1000-5
	9	WZ-1000-5	WELL BRASS, 1/2"NPT+COMPND
X-VLV	0	VALVE	SEE VALVE SCHEDULE

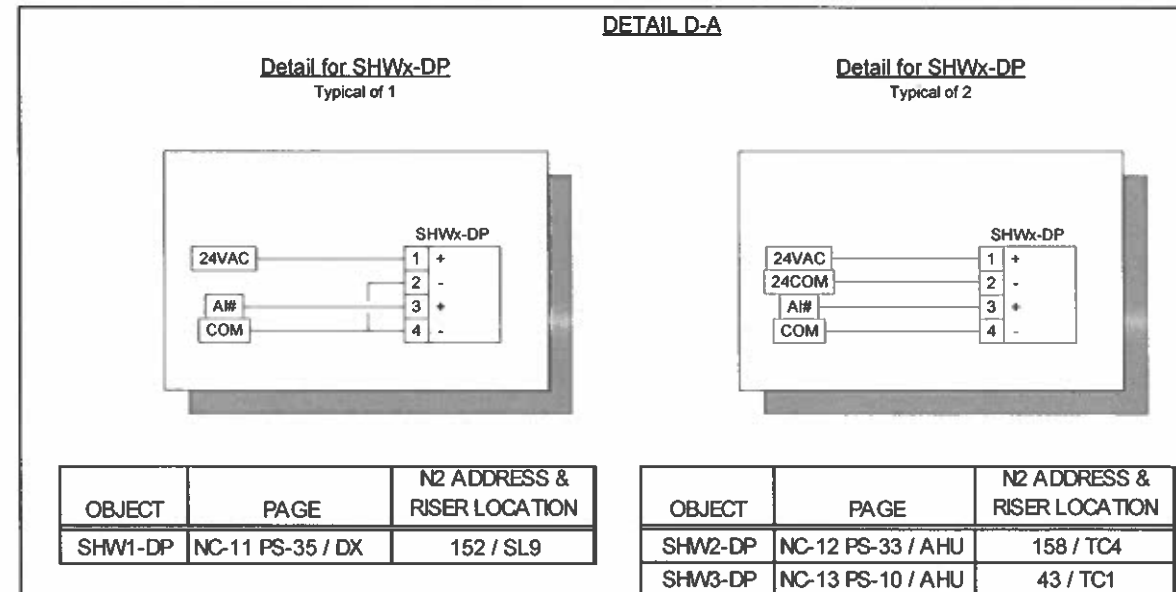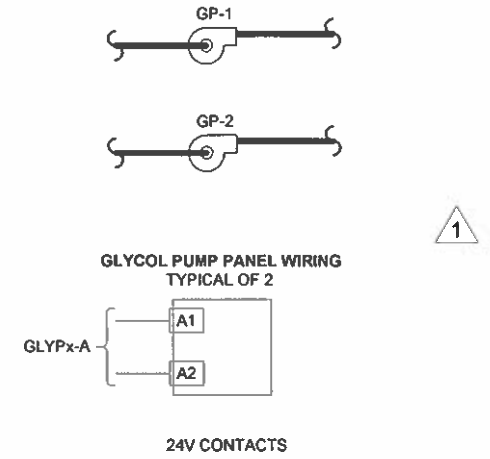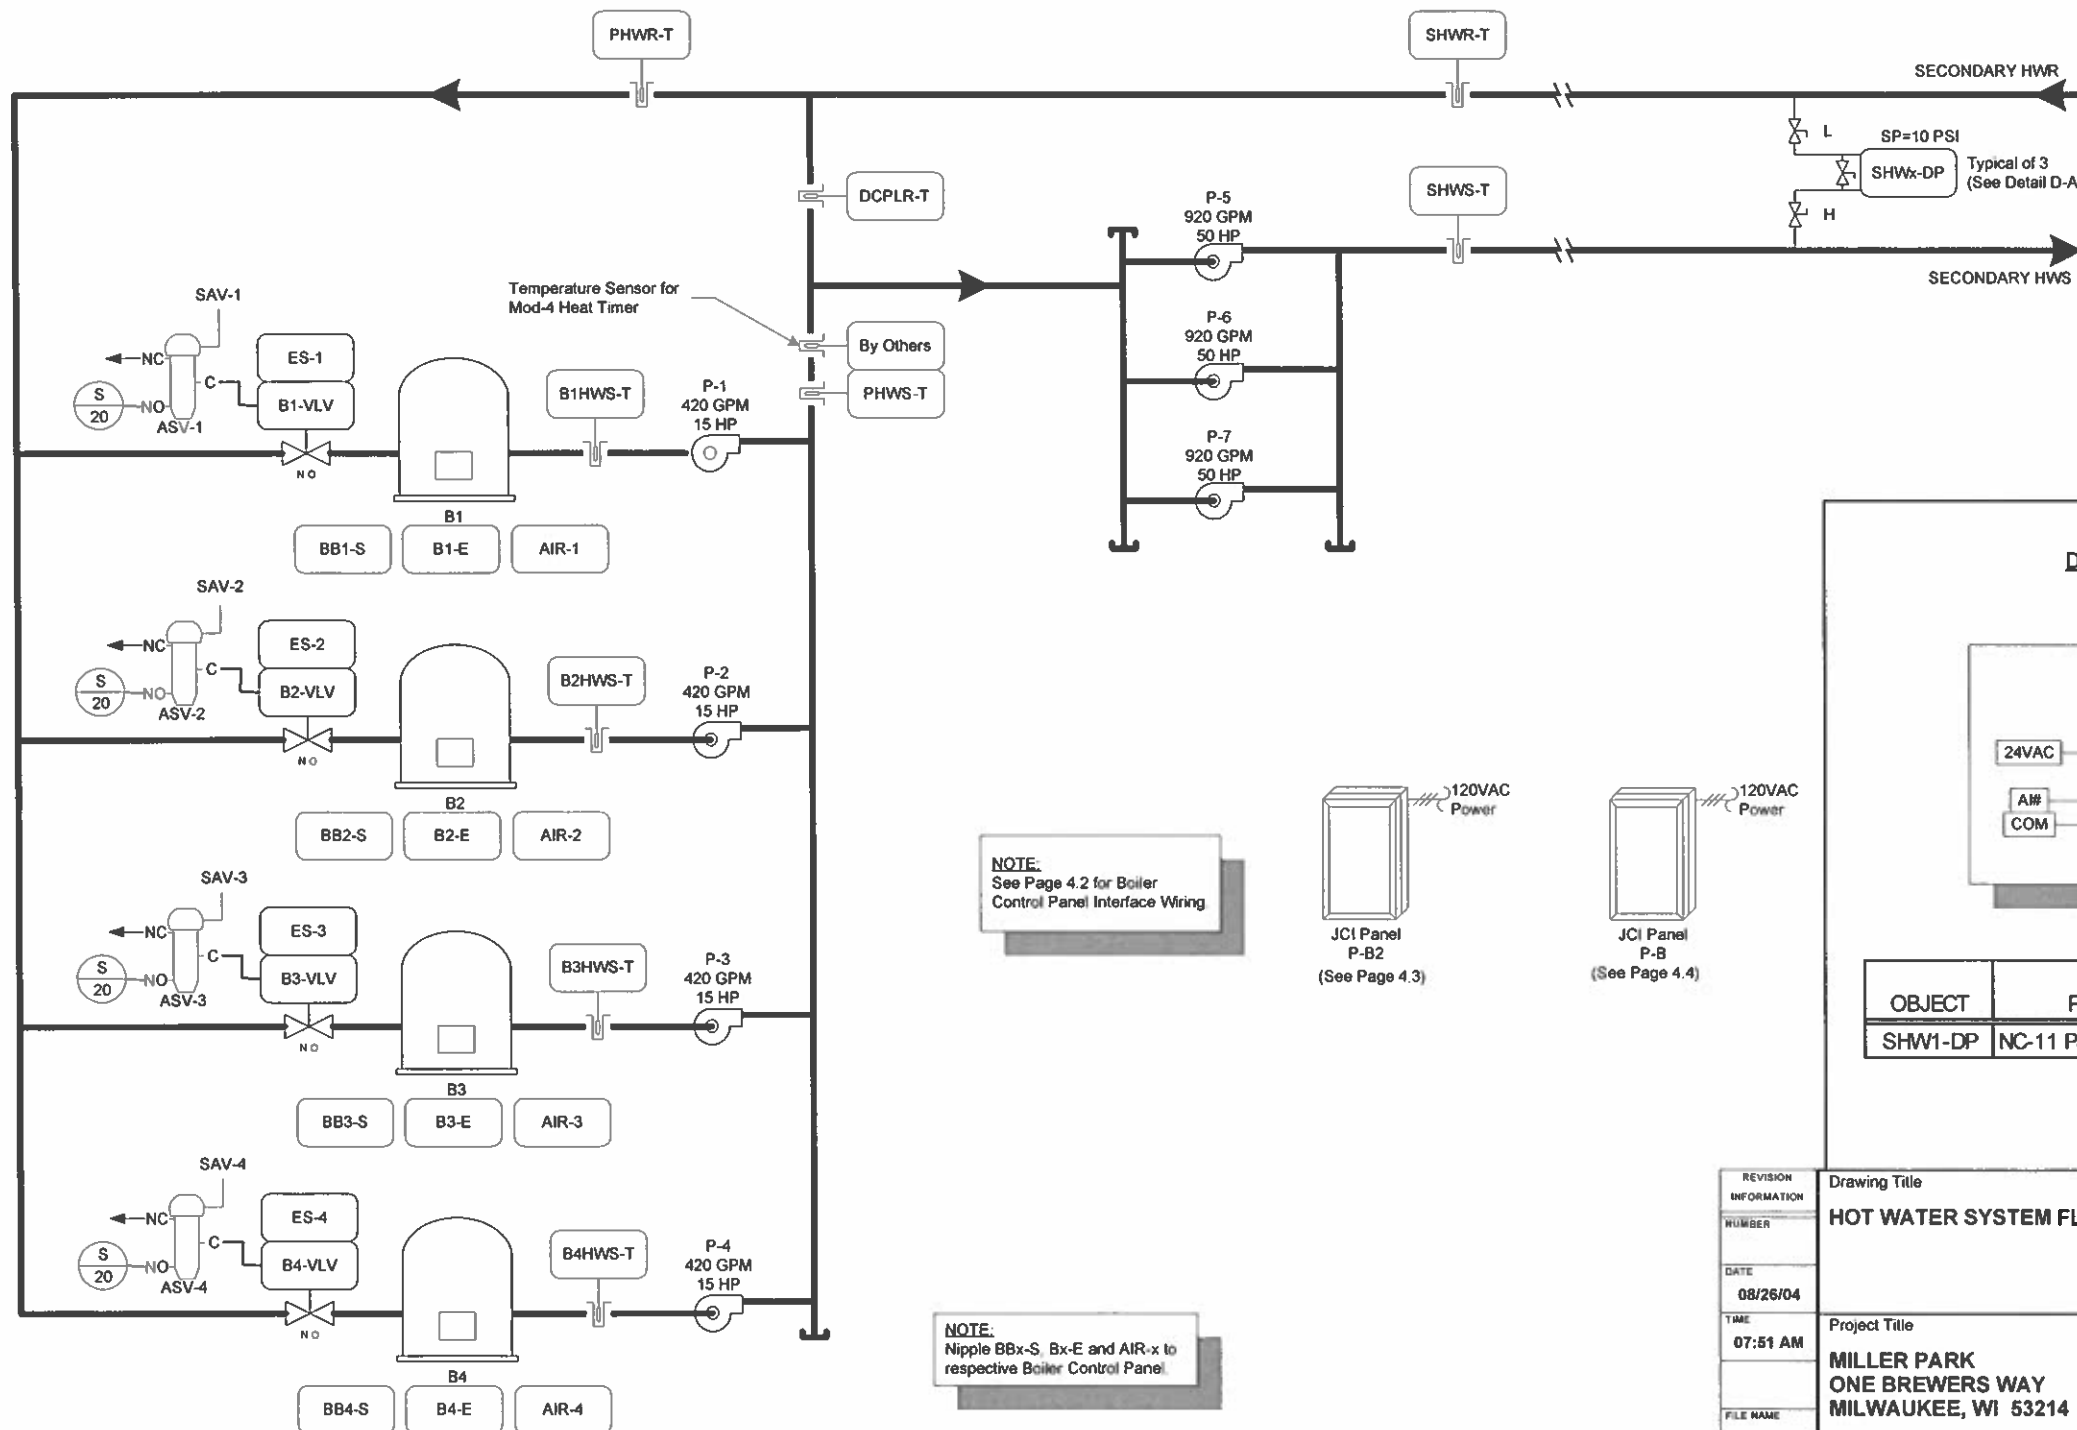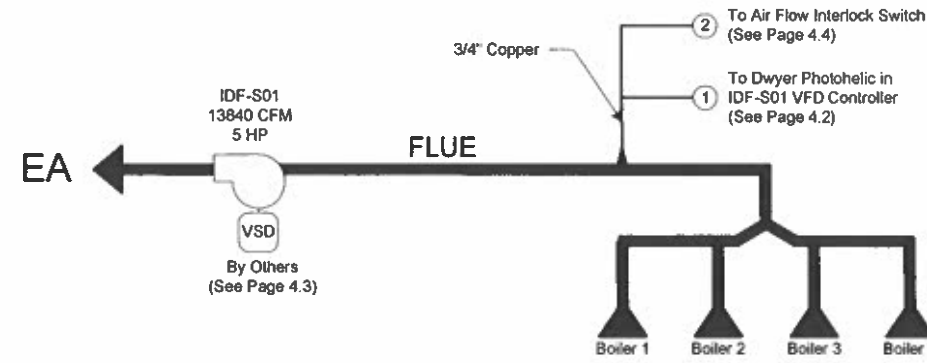

**NOTE:**  
See Page 4.2 for Boiler Control Panel Interface Wiring


**NOTE:**  
Nipple BBx-S, Bx-E and AIR-x to respective Boiler Control Panel.

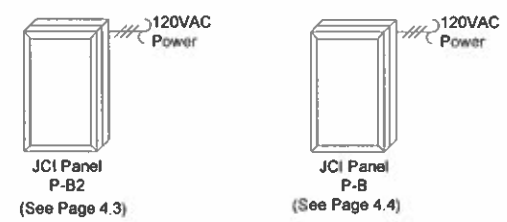

<b>REVISION INFORMATION</b> NUMBER: 1 DATE: 08/26/04 TIME: 07:51 AM FILE NAME: hws-f.vsd		<b>Drawing Title</b> HOT WATER SYSTEM FLOW Project Title: MILLER PARK ONE BREWERS WAY MILWAUKEE, WI 53214		NO. 1 JCI CONTRACT 4933-0011 DATE: 8/26/2004 BY: MLR DATE:		ECN: MLR DATE:		APPROVED:	
Sales Engineer: PJS Project Manager: TP Application Engineer: KJK		Branch Information: Wisconsin Area Office 529 N. Jackson Street Milwaukee WI 53202 Phone: 414-524-7500 Fax: 414-524-7575		CONTRACT NUMBER: <b>9 8075-0508</b>		DRAWING NUMBER: <b>4.1</b>		JOHNSON CONTROLS Systems & Services Division	


**PRIMARY HW PUMP STARTER WIRING**

TYPICAL OF 4  
P-1, P-2, P-3, P-4

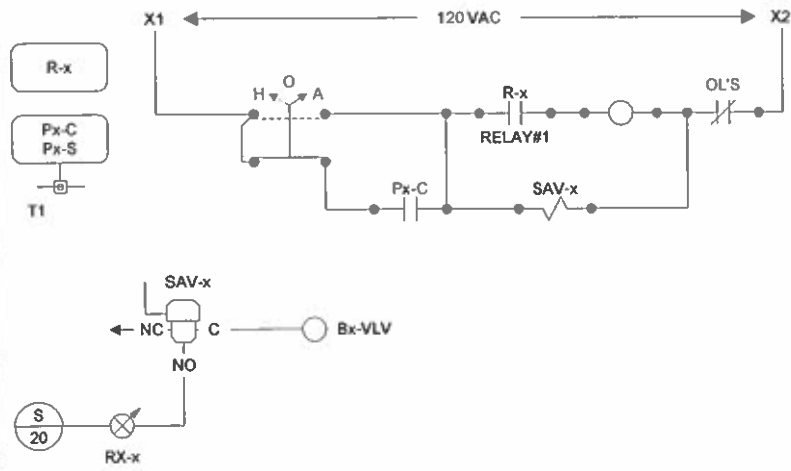

**SECONDARY HW PUMP VSD WIRING**


TYPICAL OF 3  
P-5, P-6, P-7

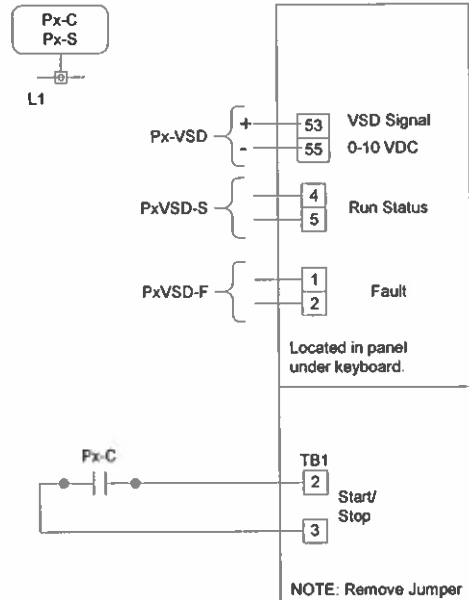

NOTE:  
SEE MANUFACTURER'S WIRING DIAGRAM FOR COMPLETE WIRING DETAILS.

**BOILER CONTROL PANEL INTERFACE WIRING**

TYPICAL OF 4

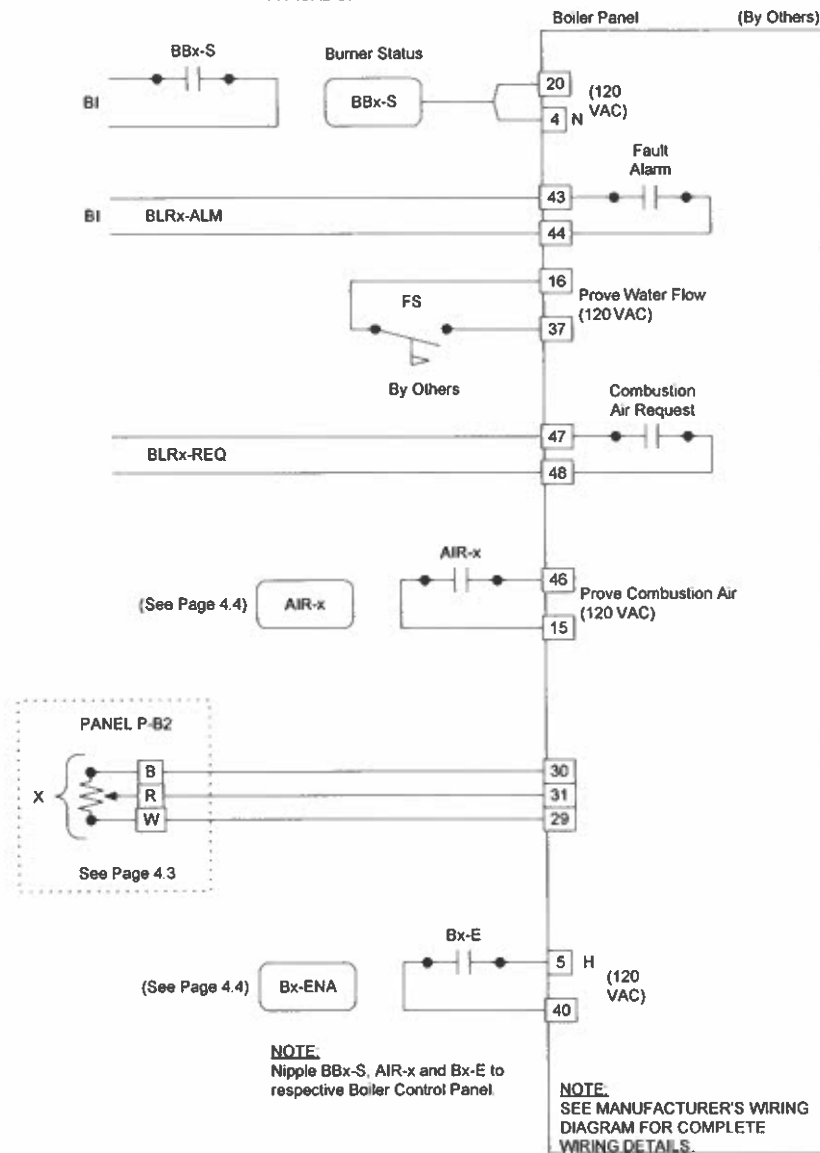

NOTE:  
Nipple BBx-S, AIR-x and Bx-E to respective Boiler Control Panel.


NOTE:  
SEE MANUFACTURER'S WIRING DIAGRAM FOR COMPLETE WIRING DETAILS.

**BILL OF MATERIALS**

Designation	Qty	Part Number	Description
Field Devices:			
BBx-S, AIR-x, R-x	12	CVR-21C-O	RELAY 2 SPDT 120 VAC
Bx-E, IDF-C	5	CVR-21A1C-H	RLY SPDT, SPST, 10-30A/DC 120V, LED HOA@LEC
IDF-S	1	H-908	SW, CURRENT, 1-135A ADJ, SPLIT @VER
Px-C, Px-S	7	H-735	SW, CURRENT, 1-135A CMND RLY SOLID @VER
RX-x	4	R-3710-2010	RESTRICTOR INLINE ADJ
SAV-x	4	V11HAA-100	3-W SOLENOID, W/OV, 120VAC

**INDUCTION FAN VFD WIRING**

TYPICAL OF 1

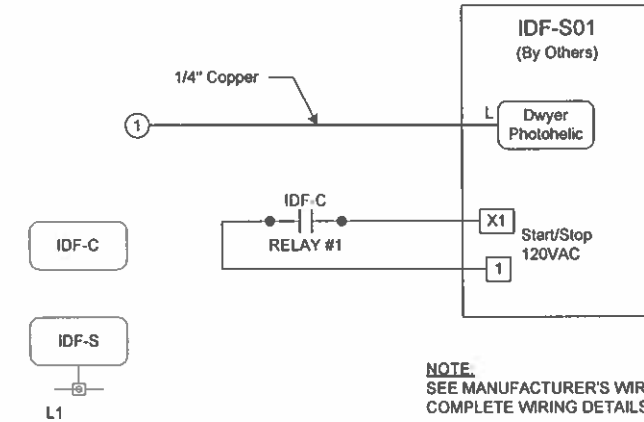

NOTE:  
SEE MANUFACTURER'S WIRING DIAGRAM FOR COMPLETE WIRING DETAILS.


REVISION INFORMATION	Drawing Title								
NUMBER	HOT WATER SYSTEM WIRING								
DATE	08/16/02	REFERENCE DRAWING	NO.	REVISION-LOCATION	ECH	DATE	BY		
TIME	10:08 AM	Sales Engineer	Project Manager	Application Engineer	BY	DATE	APPROVED		
FILE NAME	hws-w.vsd	PJS	TP	KJK	MLR				
Project Title		MILLER PARK ONE BREWERS WAY MILWAUKEE, WI 53214		JOHNSON CONTROLS Systems & Services Division		Wisconsin Area Office 529 N. Jackson Street Milwaukee WI 53202 Phone: 414-524-7500 Fax: 414-524-7575		CONTRACT NUMBER 9 8075-0508	
								DRAWING NUMBER 4.2	

**BILL OF MATERIALS**

Designation	Qty	Part Number	Description
Field Devices:			
TX-1	1	Y65-T31-0	120 TO 24 VAC TRANSFORMER 40VA
VTR-x	4	DRN3.1	0-10VDC TO 0-135 OHM TRANSDUCER

**Boiler Interface Panel**


Typical of 1

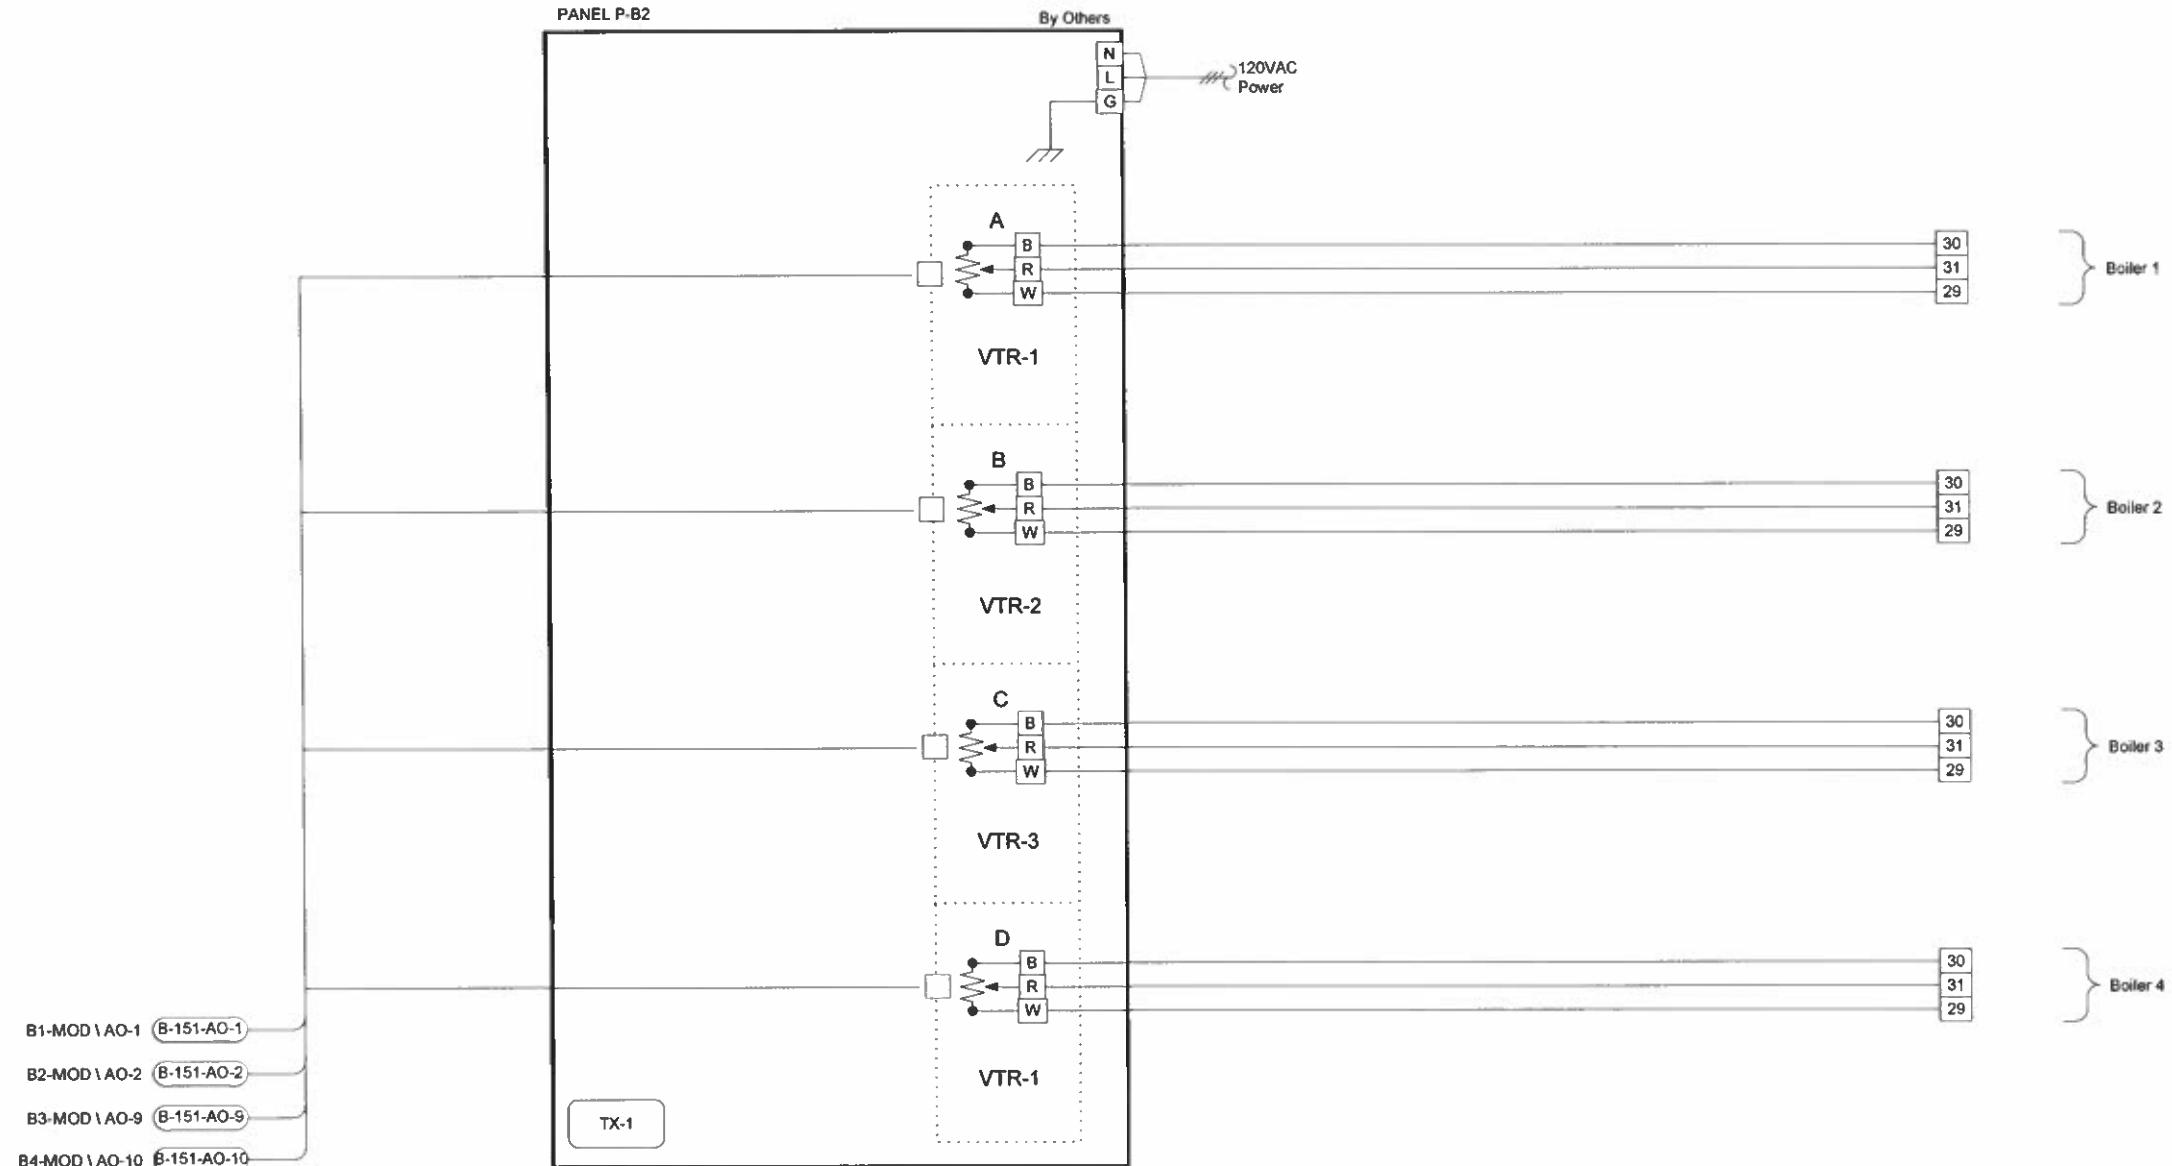



**NOTE:**  
Nipple Bx-E to respective  
Boiler Control Panel  
(See Page 4.2)

REVISION INFORMATION	Drawing Title								
	NUMBER	HOT WATER SYSTEM BOILER INTERFACE PANEL							
DATE	08/16/02								
TIME	10:08 AM								
FILE NAME	hws-w2.vsc								
Project Title		MILLER PARK ONE BREWERS WAY MILWAUKEE, WI 53214				Wisconsin Area Office 529 N Jackson Street Milwaukee WI 53202 Phone: 414-524-7500 Fax: 414-524-7575		CONTRACT NUMBER <b>9 8075-0508</b>	
				Systems & Services Division				DRAWING NUMBER <b>4.3</b>	

FROM LAST N2 DEVICE (N2) 3/18 BLU	SHWR-T \ XT1A1 (B-152A-AI-1) 2/18 YEL
TO NEXT N2 DEVICE (N2) 3/18 BLU	DCPLR-T \ XT1A12 (B-152A-AI-2) 2/18 YEL
BLR1-ALM \ DI1 (B-151-DI-1) 2/18 ORG	ACS14-T \ XT1A15 (B-152A-AI-5) 2/18 YEL
BLR2-ALM \ DI2 (B-151-DI-2) 2/18 ORG	ACS10-T \ XT1A16 (B-152A-AI-6) 2/18 YEL
BLR3-ALM \ DI3 (B-151-DI-3) 2/18 ORG	BB1-S \ XT2D11 (B-152B-DI-1) 2/18 ORG
BLR4-ALM \ DI4 (B-151-DI-4) 2/18 ORG	BB2-S \ XT2D12 (B-152B-DI-2) 2/18 ORG
P1-S \ DI-5 (B-151-DI-5) 2/18 ORG	BB3-S \ XT2D13 (B-152B-DI-3) 2/18 ORG
P2-S \ DI-6 (B-151-DI-6) 2/18 ORG	BB4-S \ XT2D14 (B-152B-DI-4) 2/18 ORG
P3-S \ DI-7 (B-151-DI-7) 2/18 ORG	IDF-S \ XT2D15 (B-152B-DI-5) 2/18 ORG
P4-S \ DI-8 (B-151-DI-8) 2/18 ORG	P5VSD-F \ XT2D16 (B-152B-DI-6) 2/18 ORG
B1-MOD \ AO-1 (B-151-AO-1) 2/18 TAN	P5VSD-S \ XT2D17 (B-152B-DI-7) 2/18 ORG
B2-MOD \ AO-2 (B-151-AO-2) 2/18 TAN	P5-S \ XT2D18 (B-152B-DI-8) 2/18 ORG
B3-MOD \ AO-9 (B-151-AO-9) 2/18 TAN	P6VSD-F \ XT3D11 (B-153A-DI-1) 2/18 ORG
B4-MOD \ AO-10 (B-151-AO-10) 2/18 TAN	P6VSD-S \ XT3D12 (B-153A-DI-2) 2/18 ORG
P5-VSD \ AO-11 (B-151-AO-11) 2/18 TAN	P6-S \ XT3D13 (B-153A-DI-3) 2/18 ORG
P6-VSD \ AO-12 (B-151-AO-12) 2/18 TAN	P7VSD-F \ XT3D14 (B-153A-DI-4) 2/18 ORG
P7-VSD \ AO-13 (B-151-AO-13) 2/18 TAN	P7VSD-S \ XT3D15 (B-153A-DI-5) 2/18 ORG
P5-C \ DO-4 (B-151-DO-4) 2/18 VIO	P7-S \ XT3D16 (B-153A-DI-6) 2/18 ORG
P6-C \ DO-5 (B-151-DO-5) 2/18 VIO	GLYP1-A \ XT3D17 (B-153A-DI-7) 2/18 ORG
P7-C \ DO-6 (B-151-DO-6) 2/18 VIO	GLYP2-A \ XT3D18 (B-153A-DI-8) 2/18 ORG
P1-C \ DO-7 (B-151-DO-7) 2/18 VIO	P3-C \ XT4D01 (B-153B-DO-1) 2/18 VIO
P2-C \ DO-8 (B-151-DO-8) 2/18 VIO	P4-C \ XT4D02 (B-153B-DO-2) 2/18 VIO
SHW1-DP \ AI-1 (B-151-AI-1) 3/18 YEL	IDF-C \ XT4D03 (B-153B-DO-3) 2/18 VIO
PHWS-T \ AI-2 (B-151-AI-2) 2/18 YEL	COMB AIR \ XT4D04 (B-153B-DO-4) 2/18 VIO
PHWR-T \ AI-3 (B-151-AI-3) 2/18 YEL	B1-ENA \ XT4D05 (B-153B-DO-5) 2/18 VIO
B1HWS-T \ AI-4 (B-151-AI-4) 2/18 YEL	B2-ENA \ XT4D06 (B-153B-DO-6) 2/18 VIO
B2HWS-T \ AI-5 (B-151-AI-5) 2/18 YEL	B3-ENA \ XT4D07 (B-153B-DO-7) 2/18 VIO
B3HWS-T \ AI-6 (B-151-AI-6) 2/18 YEL	B4-ENA \ XT4D08 (B-153B-DO-8) 2/18 VIO
B4HWS-T \ AI-7 (B-151-AI-7) 2/18 YEL	
SHWS-T \ AI-8 (B-151-AI-8) 2/18 YEL	

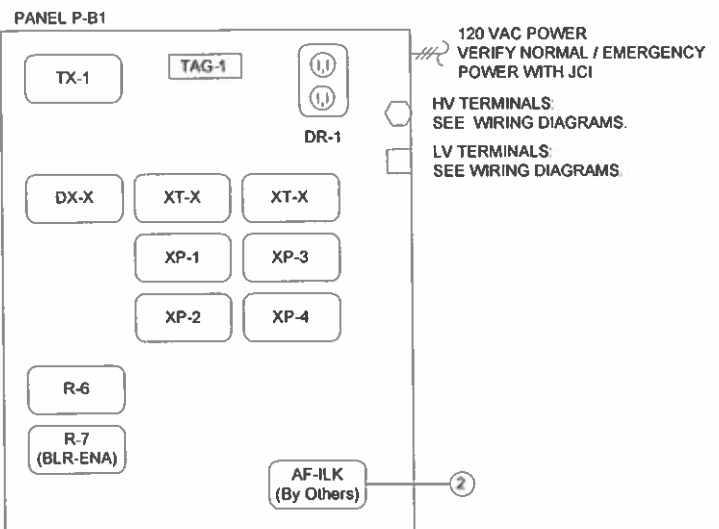

PANEL FACE TAGS:  
TAG-1: PANEL P-B  
HOT WATER SYSTEM  
JCI 9 8075-0508

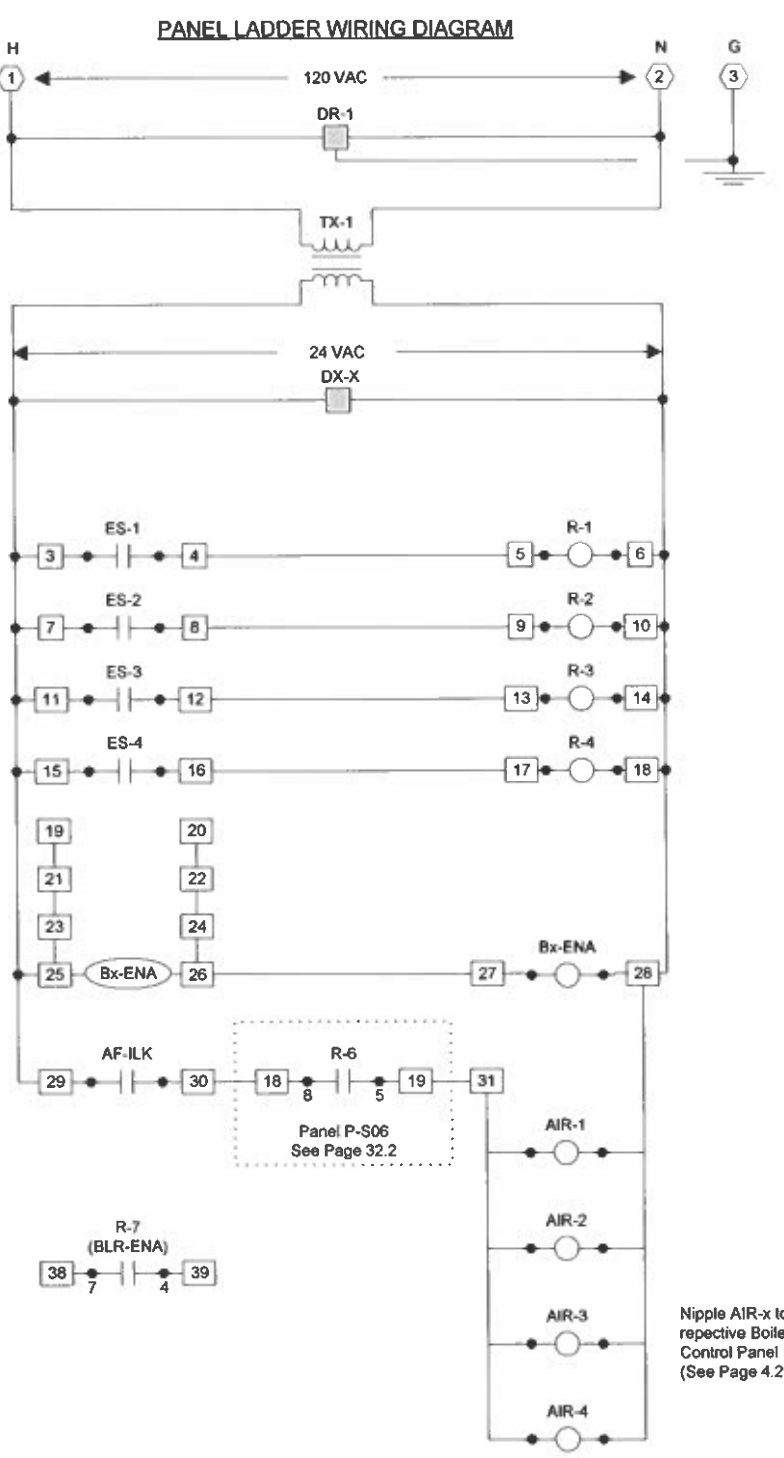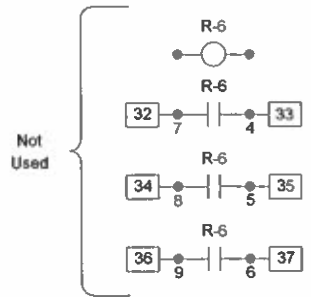

Designation	Qty	Part Number	Description
Panel Devices:			
DR-1	1	PD-117-2	RECEPTACLE DUPLEX, UL, WHT
	1	PD-121-1	RECEPTACLE DUPLEX, CVR
	1	PD-121-6	HANDY BOX 2 IN
DX-X	1	AS-LCPKEY-0	LCP SERVICE PORT ADJ KEY
	1	DX-9100-8454	DIGITAL CONTR., EXTENDED
	1	DX-9100-8990	MTG BASE (DX9100-8454)
P-B	1	M-8100-2436	PANEL, STANDARD, 15 UNITS
R-6.7	2	PD-101-35	RLY BASE 3PDT, 11PIN, 10A
	2	PD-109-51	RELAY PLUG-IN 3PDT 24VAC
TAG-1	1	M-8000-393	NAMEPLT, LAMICOID, 3 LINE
TX-1	1	PD-114-2	TRANSFORMER 100VA, 120/24
XP-1	1	XP-9102-8304	EXPANSION MODULE, 6 AI
XP-2,3	2	XP-9105-8304	DX EXPN MOD, 8 DI
XP-4	1	XP-9104-8303	EXPANSION MODULE, 8 DO
XT-X	2	XT-9100-8304	EXTENSION MODULE

Nipple AIR-x to  
respective Boiler  
Control Panel  
(See Page 4.2)

REVISION INFORMATION	Drawing Title						
NUMBER	HOT WATER SYSTEM PANEL	1		JCI CONTRACT 4933-0011		8/26/2004 MLR	
DATE	08/26/04	Sales Engineer	Project Manager	Application Engineer	BY	DATE	BY
TIME	08:04 AM	PJS	TP	KJK	MLR	DATE	DATE
FILE NAME	hws-p.vsd	Project Title		Branch Information		CONTRACT NUMBER	
		MILLER PARK ONE BREWERS WAY MILWAUKEE, WI 53214		 Wisconsin Area Office 529 N. Jackson Street Milwaukee WI 53202 Phone: 414-524-7500 Fax: 414-524-7575		9 8075-0508	
				Systems & Services Division		DRAWING NUMBER 4.4	

**Main Hot Water System**

1. The system consists of four boilers, four primary hot water pumps, one induction fan with a VFD, and three secondary hot water pumps with VFDs. The hot water system is designed to operate at 190°F supply water temperature.
2. When the hot water system is enabled, the lead secondary hot water pump will energize. When the lead secondary hot water pump is energized, as proved from the current switch across the motor, the hot water boilers will be enabled from the EMCS. The lead boiler control stop valve will be opened from a solenoid wired in the primary hot water pump, and primary hot water pump will be energized from the stop valve end switch. The hot water stop valve end switch will be hard-wired into the associated primary hot water pumps starter safety circuit to prevent the EMCS or the Hand position of the starter to energize a primary hot water pump unless the valve is proven open. If the primary hot water pump start switch is placed in the Hand position, the stop valve solenoid will energize and open the stop valve fully and when the stop valve is fully open the end switch will energize the primary hot water pump.
3. A current sensing relay across the primary hot water pump will confirm pump status. If the EMCS detects no status, the primary hot water pump will be de-energized, the stop valve will close and an alarm given at the EMCS.
4. The lead boiler is selected through Metasys.
5. When flow has been confirmed at the lead boiler through a flow switch and electrical interlock, the lead boiler will complete its initiating sequence and begin to operate through its on-board Fireye controls.
6. Each boiler is allowed to modulate independently based on a common adjustable setpoint (190°). Metasys will control the boiler staging as well as burner modulation. Each boiler's control panel provides a method of manually enabling and modulating the boiler as well.
7. When the outdoor air temp is below 42 (adjustable) OR the lead boiler is in alarm, the lag boiler will start
8. When the outdoor air temp is below 0 (adjustable) OR either the lead or lag boiler is in alarm, a 3<sup>rd</sup> boiler will start
9. On a call for any boiler burner to fire, open the combustion fan damper fully (See the Boiler Room Ventilation sequence of operation). The combustion air damper end switch will energize the combustion fan when the combustion damper is proven fully open. The combustion damper end switch will be hard-wired into the safety circuit of the combustion supply fan to prevent the EMCS or the Hand position of the starter to energize the fan unless the combustion damper end switch is closed. Also, on a call for any boiler burner to fire the induction fan will energize. Hard-wire the induction fan VFD run contact and the combustion damper end switch into the four boiler panels to prevent the burner from firing unless the combustion damper is fully open and the induction fan is energized. If they fail to operate, an alarm will be raised at the EMCS. The induction fan status monitored on the EMCS will be a current switch. The induction start and the combustion damper open command will be hard-wired directly from the four boiler burner panels.
10. Provide manufacturers recommended field control wiring on the boilers. This includes mounting and wiring any manufacturers recommended controls for the flue pressure speed control on the induction fan VFD.
11. When all the boilers are off, close the combustion damper, de-energize the induction fan, de-energize the secondary hot water pumps, disable the boilers, let the primary hot water pump through the boiler for an adjustable time delay. After the delay, de-energize the primary hot water pump and close the boiler stop valve.

**Boiler Staging Sequence**


Lead Boiler	Lag Boiler	3rd Boiler	4th Boiler
Boiler 1	Boiler 2	Boiler 3	Boiler 4
Boiler 2	Boiler 3	Boiler 4	Boiler 1
Boiler 3	Boiler 4	Boiler 1	Boiler 2
Boiler 4	Boiler 1	Boiler 2	Boiler 3

**Secondary Hot Water System**


1. The secondary hot water pumps P-5, P-6 and P-7 will operate through a lead/lag sequence, which will be initialized by the EMCS when the hot water system is enabled. One pump will be designated as standby
2. The lead secondary hot water pump will be energized by the EMCS as part of boiler start-up sequence. If the pump indicates a common trouble alarm at the EMCS it will be de-energized, but the alarm remains active. The lag pump will then be energized.
3. The lag secondary hot water pump will be energized in sequence with the lead pump only if the second lag boiler is energized and if the EMCS has determined that both pumps are required for best system efficiency.
4. Secondary hot water supply and return water temperature will be continuously monitored by the EMCS.
5. A current sensing relay across the secondary pumps will confirm pump status. If the EMCS detects no flow, that pump will be de-energized and an alarm given at the EMCS.
6. The lead pump will run continuously, until it cannot satisfy demand at which point the lag pump will be energized. The pumps will continue to run in parallel until demand drops to a point where a single pump can handle the load. Pumps will be de-energized in reverse order. The EMCS will schedule the pumps on and off to maintain the most efficient system operating point.
7. The EMCS will select the lowest of three pressure differential sensors to modulate the pump speed to maintain the hot water differential pressure setpoint. All energized pumps will operate at the same speed.
8. Provide a software lead pump rotation point (5-6-7 lead pump select) to equalize pump runtimes.
9. No secondary hot water flow meter is provided.

REVISION INFORMATION	Drawing Title								
NUMBER	SEQUENCE								
DATE	08/16/02	REFERENCE DRAWING NO.		REVISION-LOCATION	ECN	DATE	BY		
TIME	10:11 AM	Sales Engineer	PJS	Project Manager	TP	Application Engineer	KJK	BY	MLR
FILE NAME	hws-s.vsd	DATE		APPROVED		DATE		CONTRACT NUMBER	9 8075-0508
		Project Title	MILLER PARK ONE BREWERS WAY MILWAUKEE, WI 53214	Branch Information	Wisconsin Area Office 529 N Jackson Street Milwaukee WI 53202 Phone: 414-524-7500 Fax: 414-524-7575			DRAWING NUMBER	4.5
				<b>JOHNSON CONTROLS</b>					
				Systems & Services Division					



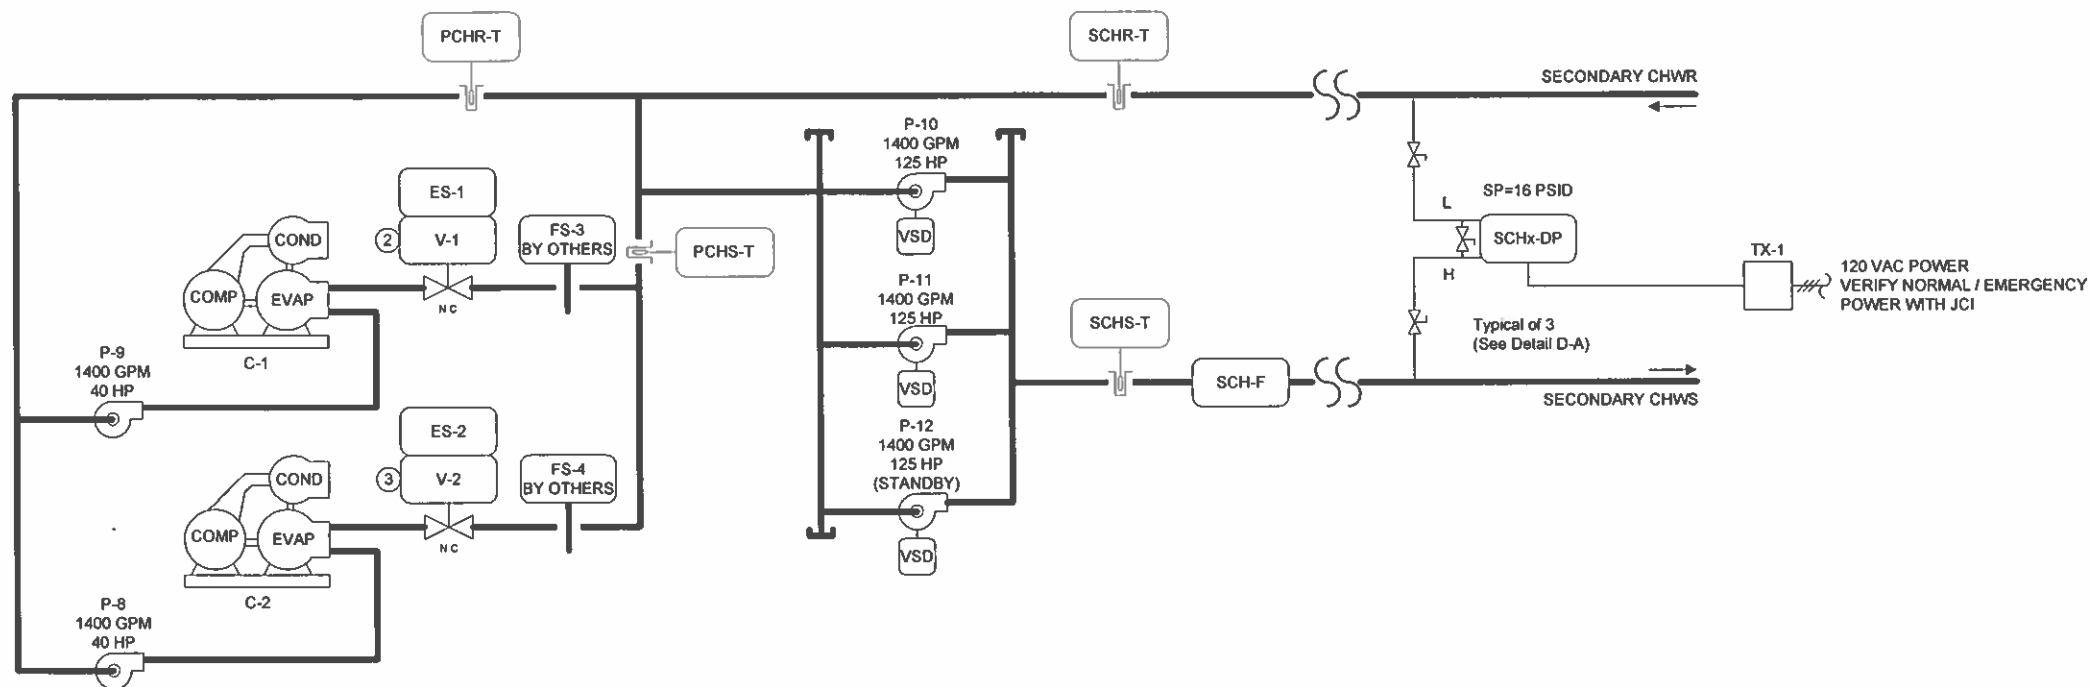

NOTE: REFRIGERANT IS R-123

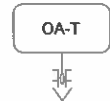


**BILL OF MATERIALS**


Designation	Qty	Part Number	Description
<b>Field Devices:</b>			
ES-x	2	802T-A	CRANKARM - AB
	2	802T-W2A	POSITION SWITCH - AB
OA-T	1	TE-6316P-1	SENSOR,T-NI,0.1%,17FT AVG
PCHR-T, SCHX-T	4	TE-631AP-1	SENS,T-NI,0.1%,FWZ1000-5
	4	WZ-1000-5	WELL, BRASS, 1/2"NPT+COMPND
SCH-F	1	BR24665-72-41	VENTURI 12" - BARCO
	1	FHNT33V1AACYYAA	TRANSMITTER - FUJI
	1	HM531S3399412	3-VALVE MANIFOLD - HEX VALVE
SCHx-DP	3	PD-101-1	RESISTOR, 4990HM 1/2W 1%
	3	PR282-44B12B	XDUCER, HI-DP 0-100# 4-20MA 24VAC NEMA 1
	9	VNH3-AM	1/4" BALL VALVE, 200F - DYNAQUIP
TX-1	3	Y65T31-0	XFMR,120-208-240/24,40VA,FOOT [Y65AR+]
V-x	0	VALVE	SEE VALVE SCHEDULE

**DETAIL D-A**

Detail for SCHx-DP  
Typical of 3

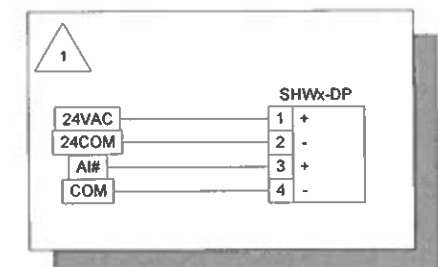


REVISION INFORMATION	Drawing Title				
	NUMBER	CHILLED WATER SYSTEM FLOW	1	RECORD DRAWING	6/14/2001 MLR
DATE	08/16/02	REFERENCE DRAWING	NO	REVISION-LOCATION	ESN DATE BY
TIME	10:10 AM	Sales Engineer	PJS	Project Manager	TP
FILE NAME	cws-f.vsd	Application Engineer	KJK	DATE	APPROVED
Project Title		BY MLR		DATE	
MILLER PARK ONE BREWERS WAY MILWAUKEE, WI 53214		Branch Information		CONTRACT NUMBER	
		JOHNSON CONTROLS Systems & Services Division		9 8075-0508	
		Wisconsin Area Office 529 N. Jackson Street Milwaukee WI 53202 Phone: 414-524-7500 Fax: 414-524-7575		DRAWING NUMBER	
				5.1	

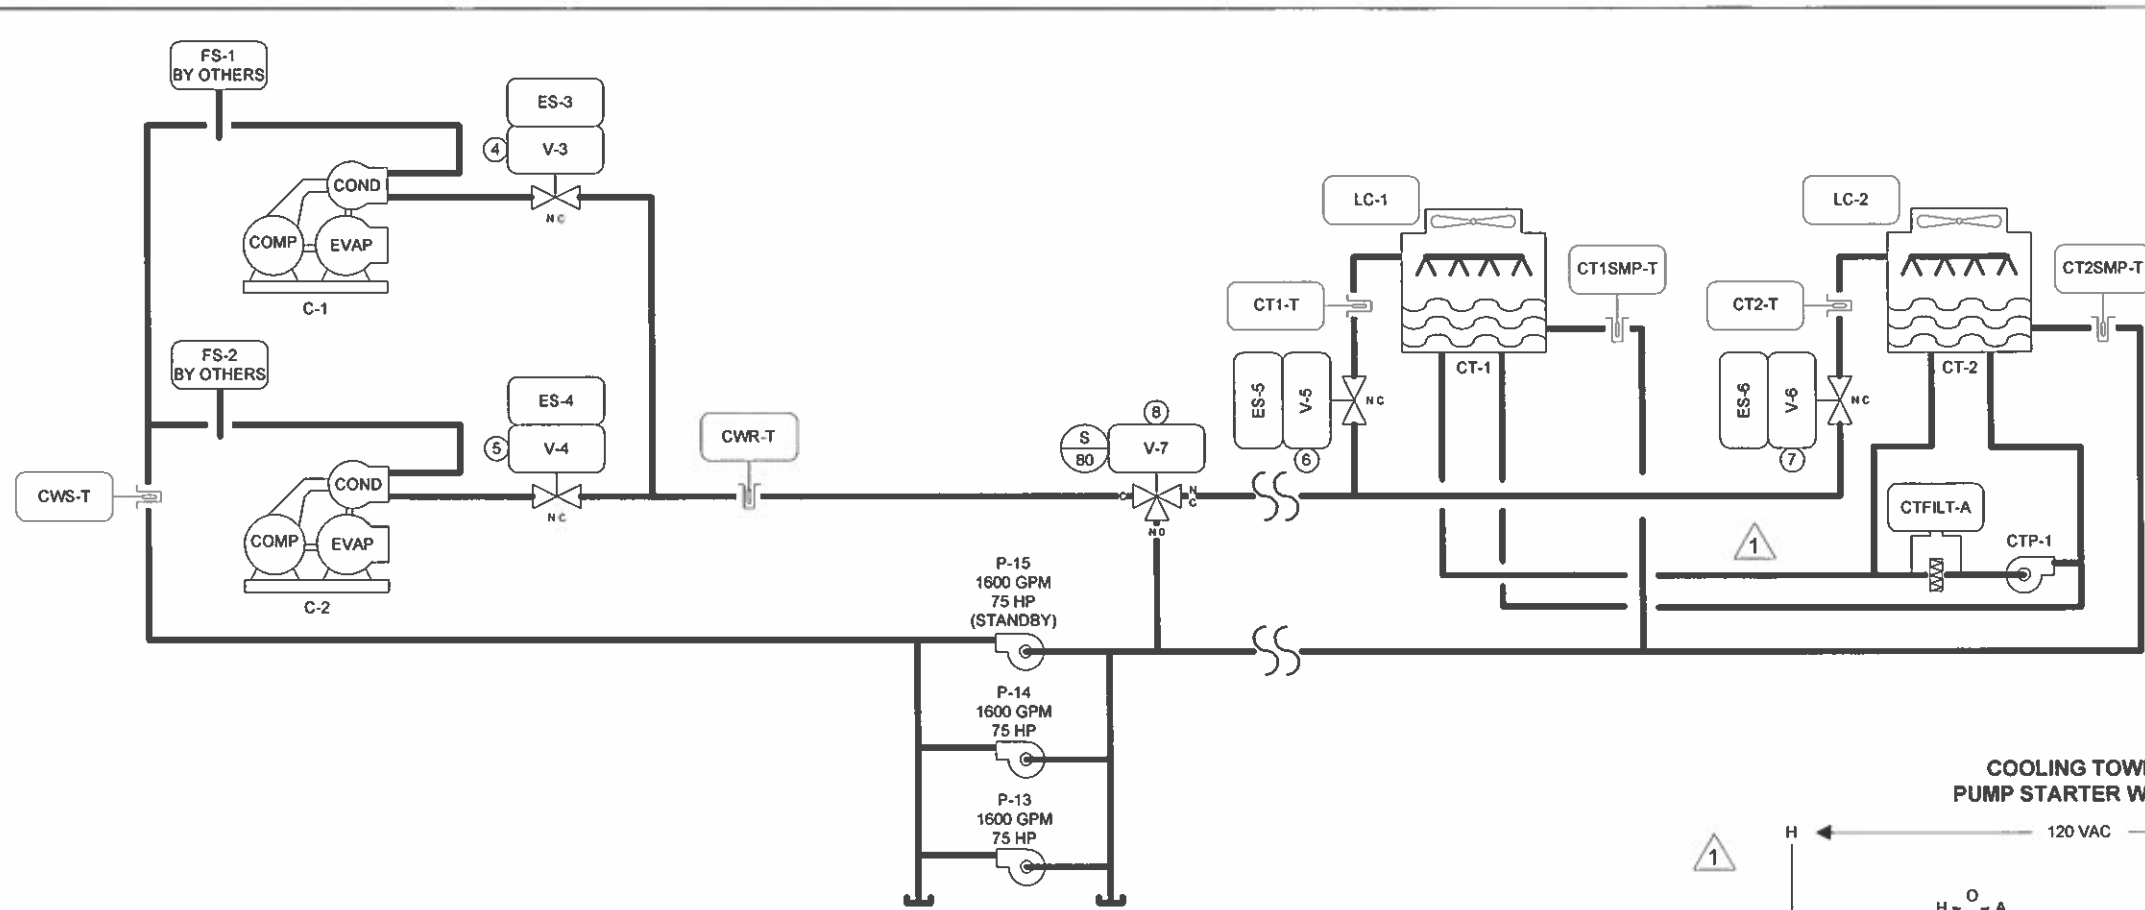

**BILL OF MATERIALS**


Designation	Qty	Part Number	Description
<b>Field Devices:</b>			
CTxPHx-S, CTP-X	5	H-708	SW,CURRENT,1-135A,ADJ.SOLID,W/LED
CTFILT-A	1	24-014	NEMA 4 DIFF PRESS SWITCH 5.5-45PSID - KELE
ES-x	2	802T-A	CRANKARM - AB
LC-x	2	802T-W2A	POSITION SWITCH - AB
	6	16MB3A0	WARRICK SERIES CONTROLS - KELBURN
	2	3E5B	RED BRASS CONTROL FITTING - KELBURN
	4	3R2C0	STAINLESS STEEL ELECTRODES (2' FT) - KELBURN
	6	3R3C0	STAINLESS STEEL ELECTRODES (3' FT) - KELBURN
	2	7765281	NEMA 4X ENCLOSURE - KELBURN
	2	7765282	SUB-PANEL - KELBURN
V-x	0	SEE VALVE SCHEDULE	
X-T	6	TE-631AP-1	SENS,T-NI,0.1%,FWZ1000-5
	6	WZ-1000-5	WELL,BRASS,1/2"NPT+COMPND

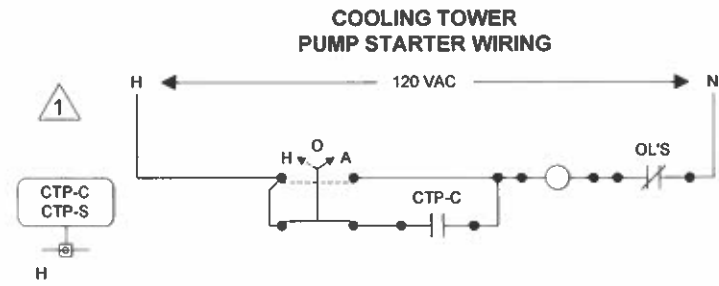

**CONDENSER WATER CHEMICAL TREATMENT**

NOTE: SEE MANUFACTURER'S WIRING DIAGRAM FOR COMPLETE WIRING DETAILS.


**COOLING TOWER LEVEL CONTROL WIRING**

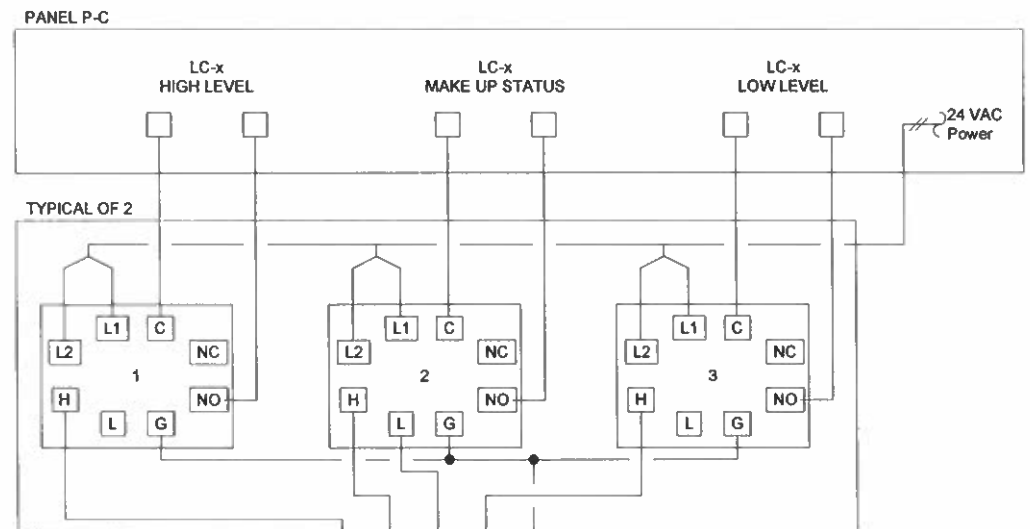


**NOTE:**  
**DIRECT MODE - SINGLE LEVEL SERVICE (UNITS 1 & 3):**  
 WHEN THE LIQUID RISES TO THE ELECTRODE ON TERMINAL 3, THE CONTROL ENERGIZES. THE CONTROL REMAINS ENERGIZED UNTIL THE LIQUID RECEDES BELOW ELECTRODE ON TERMINAL 3.

**INVERSE MODE - DIFFERENTIAL SERVICE (UNIT 2):**  
 CONTROL ENERGIZES WITH POWER. WHEN THE LIQUID RISES TO THE ELECTRODE ON TERMINAL 3, THE CONTROL DE-ENERGIZES. THE CONTROL REMAINS DE-ENERGIZED UNTIL THE LIQUID RECEDES BELOW ELECTRODE ON TERMINAL 4. THE CONTROL THEN ENERGIZES.

**COOLING TOWER PUMP STARTER WIRING**

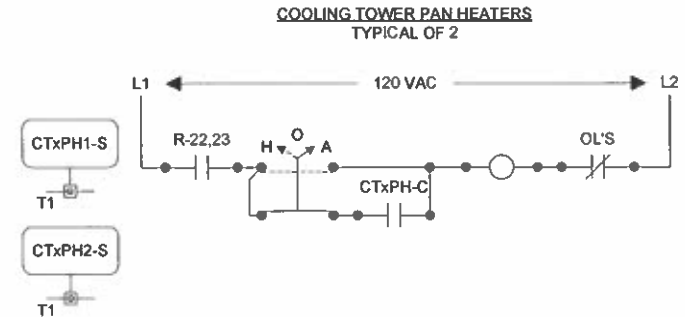


**TRACE HEATING**  
TYPICAL OF 1

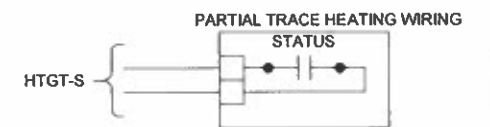





NOTE: SEE MANUFACTURER'S WIRING DIAGRAM FOR COMPLETE WIRING DETAILS.

**COOLING TOWER PAN HEATERS**  
TYPICAL OF 4

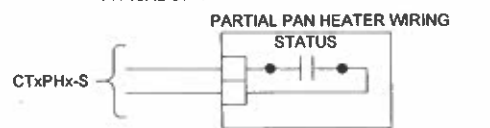




NOTE: SEE MANUFACTURER'S WIRING DIAGRAM FOR COMPLETE WIRING DETAILS.

REVISION INFORMATION	Drawing Title	CONDENSER WATER SYSTEM FLOW			
	NUMBER	1	JCI CONTRACT 4933-0011	8/26/2004	MLR
DATE	08/26/04				
TIME	11:14 AM				
FILE NAME	cws-f2.vsd				
Project Title	MILLER PARK ONE BREWERS WAY MILWAUKEE, WI 53214				
JOHNSON CONTROLS Systems & Services Division		Wisconsin Area Office 529 N. Jackson Street Milwaukee WI 53202 Phone: 414-524-7500 Fax: 414-524-7575		CONTRACT NUMBER 9 8075-0508 DRAWING NUMBER 5.2	

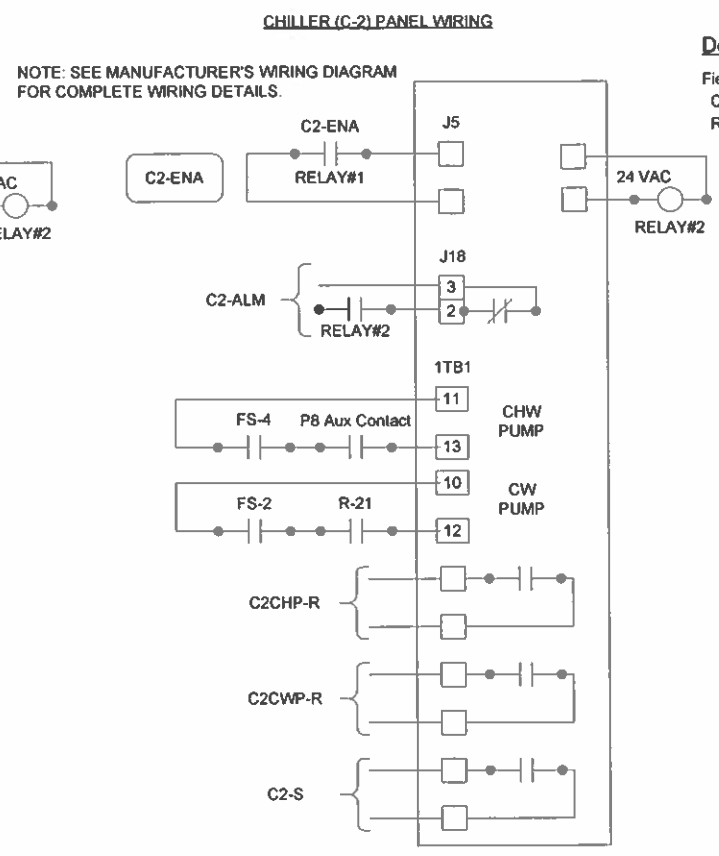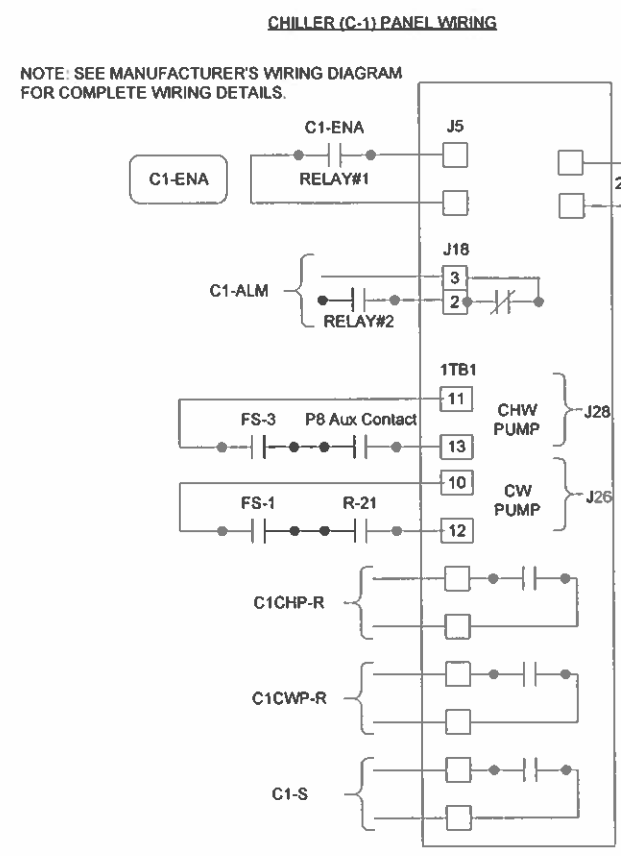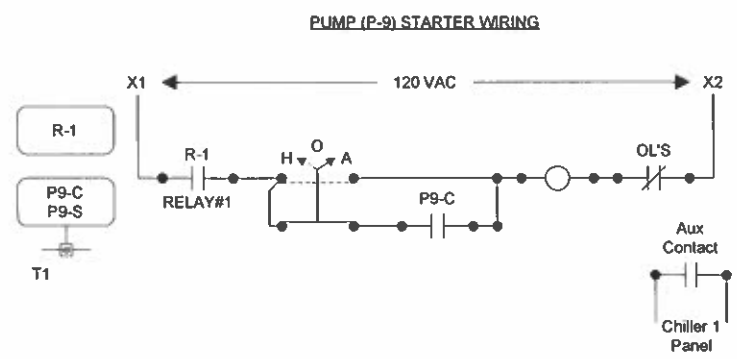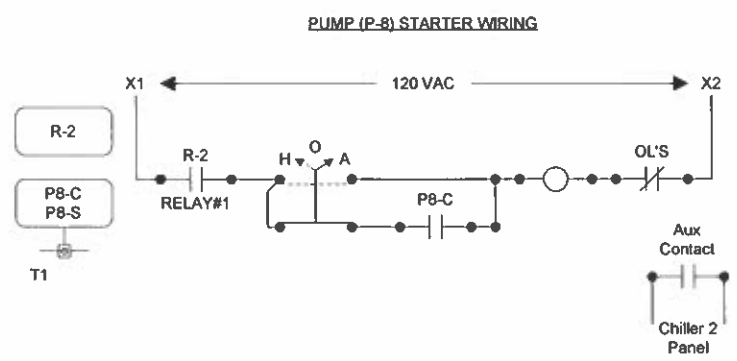

**BILL OF MATERIALS**

Designation	Qty	Part Number	Description
Field Devices: CS-x, Px-C, Px-S R-1-2, Cx-ENA	5 4	H-735 CVR-21C-O	SW. CURRENT, 1-135A CMND RLY SOLID @VER RLY 2SPDT, 10-30VAC/DC OR 120VAC.LED @LEC

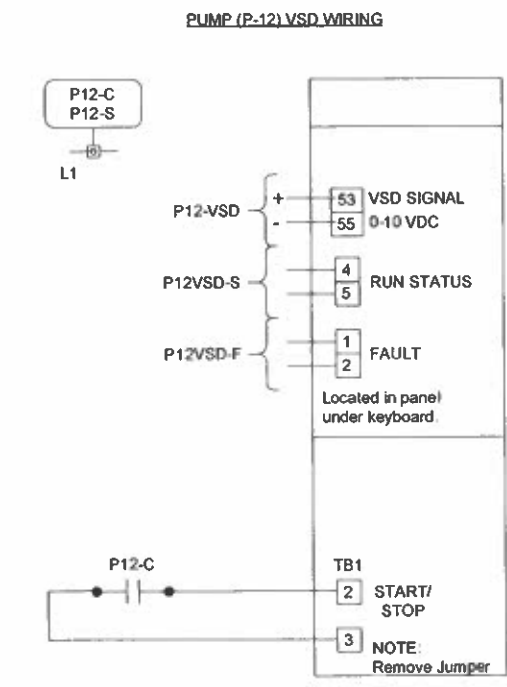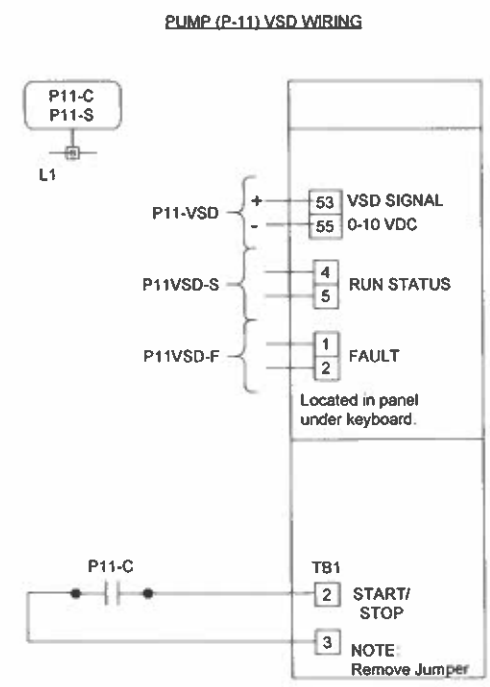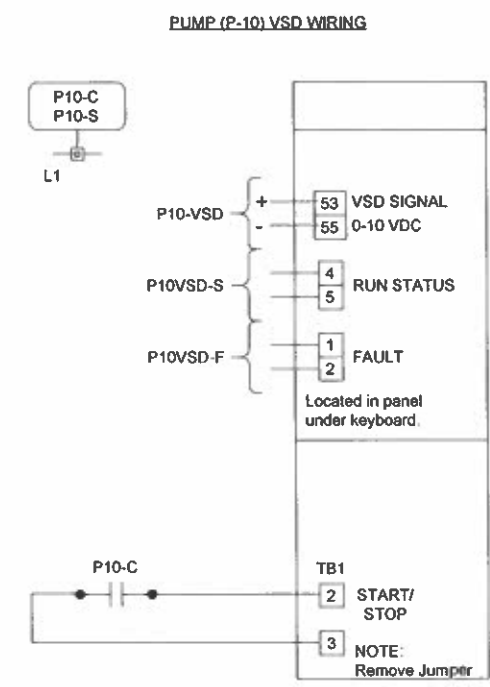


<b>REVISION INFORMATION</b> NUMBER DATE 08/16/02 TIME 10:07 AM FILE NAME CWS-w.vsd	<b>Drawing Title</b> <b>CHILLED WATER SYSTEM WIRING</b>							
	<b>Project Title</b> <b>MILLER PARK          ONE BREWERS WAY          MILWAUKEE, WI 53214</b>		<b>JOHNSON CONTROLS</b> Systems & Services Division		Wisconsin Area Office 529 N. Jackson Street Milwaukee WI 53202 Phone: 414-524-7500 Fax: 414-524-7575		<b>9 8075-0508</b> DRAWING NUMBER <b>5.3</b>	
	<b>REFERENCE DRAWING</b> PJS TP KJK		<b>REVISION-LOCATION</b> NO. DATE BY		<b>CONTRACT NUMBER</b> 9 8075-0508			
	<b>DATE</b> 08/16/02		<b>TIME</b> 10:07 AM		<b>FILE NAME</b> CWS-w.vsd			


**BILL OF MATERIALS**

Designation	Qty	Part Number	Description
Field Devices:			
CS-x, Px-C, Px-S, C	7	H-735	SW. CURRENT, 1-135A CMND RLY SOLID @VER
TxH-C, CTxL-C			
R-3-7	5	CVR-21C-O	RLY 2SPDT,10-30VAC/DC OR 120VAC,LED @LEC
TDR-x	4	PD-101-37	RLY BASE ROUND,11 PIN
	4	PD-109-29	TDR,MULTI-FV/DPDT,11RND




**PUMP (P-13) STARTER WIRING**

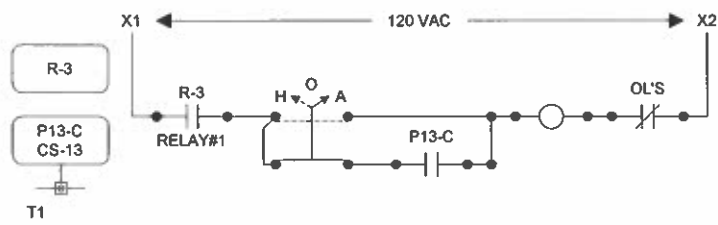


**PUMP (P-14) STARTER WIRING**

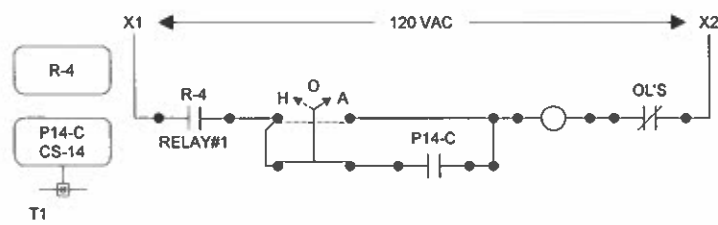


**PUMP (P-15) STARTER WIRING**

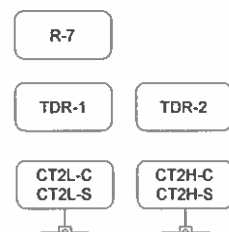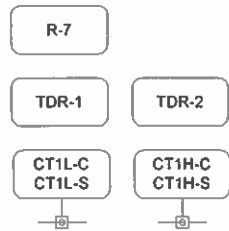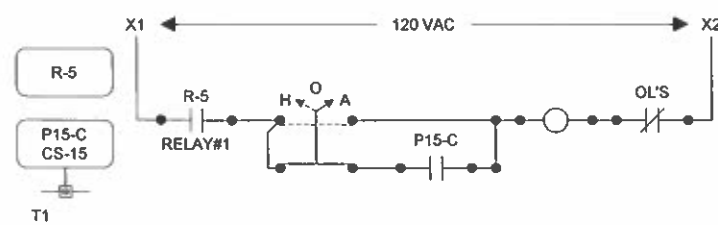


**COOLING (CT-1) TOWER CONTROL**

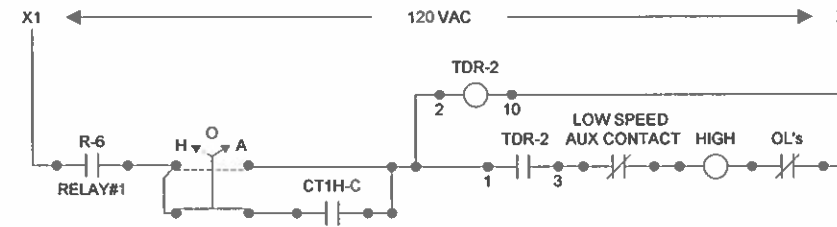


**COOLING (CT-1) TOWER CONTROL**

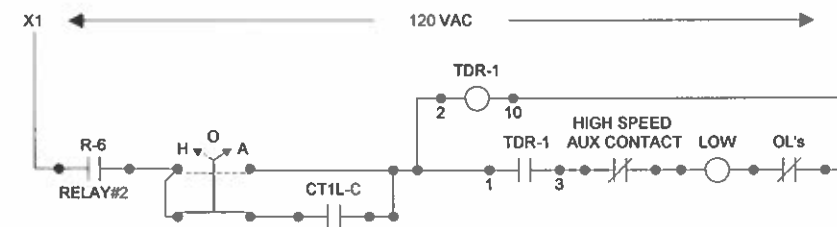

**COOLING (CT-2) TOWER CONTROL**

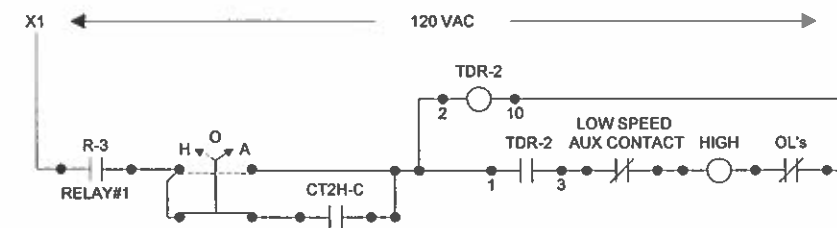

**COOLING (CT-2) TOWER CONTROL**

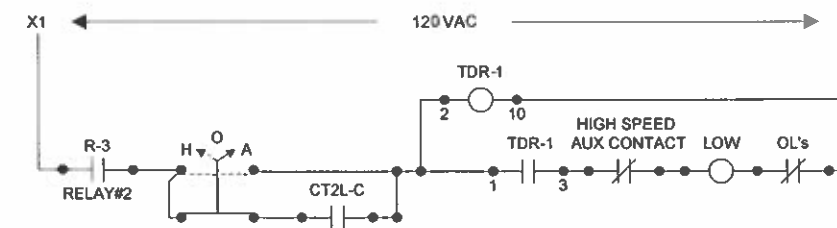


REVISION INFORMATION		Drawing Title		NO		REVISION-LOCATION		ECN	DATE	BY
NUMBER		COOLING TOWER SYSTEM WIRING								
DATE	07/17/01			PJS		TP		KJK	MLR	
TIME	07:18 AM	Project Title		MILLER PARK ONE BREWERS WAY MILWAUKEE, WI 53214		Wisconsin Area Office 529 N. Jackson Street Milwaukee WI 53202 Phone: 414-524-7500 Fax: 414-524-7575		CONTRACT NUMBER		9 8075-0508
FILE NAME	cltwr-w.vsc			JOHNSON CONTROLS Systems & Services Division				DRAWING NUMBER		5.4

1

CTP-C\DO-7 (C-155B-DO-7) 2/18 VIO  
 CTP-S\DI-7 (C-155A-DI-7) 2/18 ORG  
 CTFILT-A\DI-8 (C-155A-DI-8) 2/18 ORG

PANEL P-C

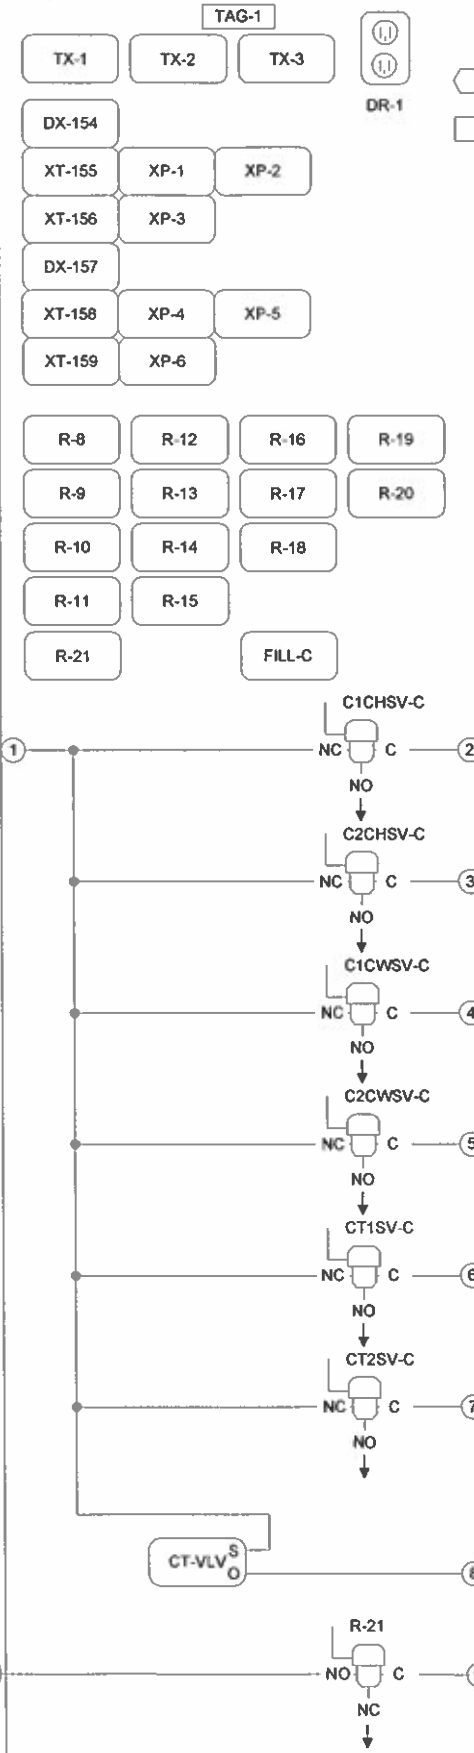

120 VAC POWER  
 VERIFY NORMAL / EMERGENCY  
 POWER WITH JCI



HV TERMINALS:  
 SEE WIRING DIAGRAMS.  
 LV TERMINALS:  
 SEE WIRING DIAGRAMS.

BILL OF MATERIALS

Designation	Qty	Part Number	Description
<b>Panel Devices:</b>			
CX-C	6	V11HGA-100	3-W SOLENOID W/0V, 24 VAC
DR-1	1	PD-117-2	RECEPTACLE, DUPLEX, UL WHT
	1	PD-121-1	RECEPTACLE, DUPLEX, CVR
	1	PD-121-6	HANDY BOX 2 IN
DX-X	1	AS-LCPKEY-0	LCP SERVICE PORT ADJ KEY
	1	DX-9100-8454	DIGITAL CONTR., EXTENDED
	1	DX-9100-8990	MTG BASE (DX9100-8454)
P-C	1	M-8100-3648	PANEL STANDARD, 31 UNITS
R-8-20	13	PD-101-35	RLY BASE 3PDT, 11PIN, 10A
	13	PD-109-61	RELAY PLUG IN 3PDT 24VAC 10A w/LED
TAG-1	1	M-8000-393	NAMEPLT, LAMICOID, 3 LINE
TX-1-3	3	PD-114-2	TRANSFORMER 100VA, 120/24
X-VLV	1	EP-8000-2	XDUCR EP 0/10V HI VOL
XP-1	1	XP-9102-8304	EXPANSION MODULE, 6 AI
XP-2-4,7	4	XP-9105-8304	DX EXPN MOD, 8 DI
XP-5,6,8	3	XP-9103-8304	DX EXPN MOD, 8 DO TRIAC
XT-X	4	XT-9100-8304	EXTENSION MODULE

PANEL FACE TAGS  
 TAG-1: PANEL P-C  
 CHILLED WATER SYSTEM  
 JCI 9 8075-0508

REVISION INFORMATION	Drawing Title <b>CHILLED WATER SYSTEM PANEL</b>				
NUMBER		1	JCI CONTRACT 4933-0011	8/26/2004	MLR
DATE	08/26/04				
TIME	08:24 AM				
FILE NAME	cws-p.vsd				
REFERENCE DRAWING	NO.	REVISION-LOCATION	ECH	DATE	BY
Sales Engineer PJS	Project Manager TP	Application Engineer KJK	BY MLR	DATE	APPROVED DATE
Project Title <b>MILLER PARK ONE BREWERS WAY MILWAUKEE, WI 53214</b>		Branch Information <b>JOHNSON CONTROLS</b> Systems & Services Division		CONTRACT NUMBER <b>9 8075-0508</b> DRAWING NUMBER <b>5.5</b>	
		Wisconsin Area Office 529 N. Jackson Street Milwaukee WI 53202 Phone: 414-524-7500 Fax: 414-524-7575			

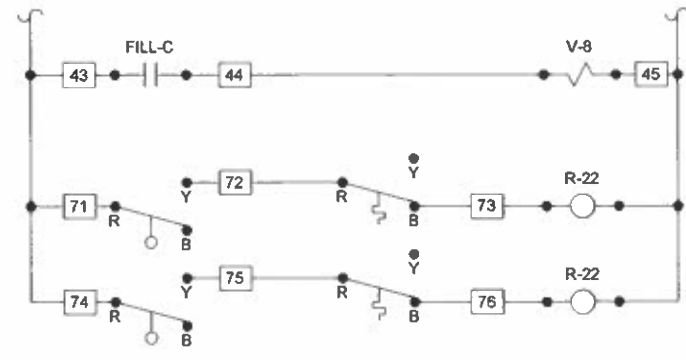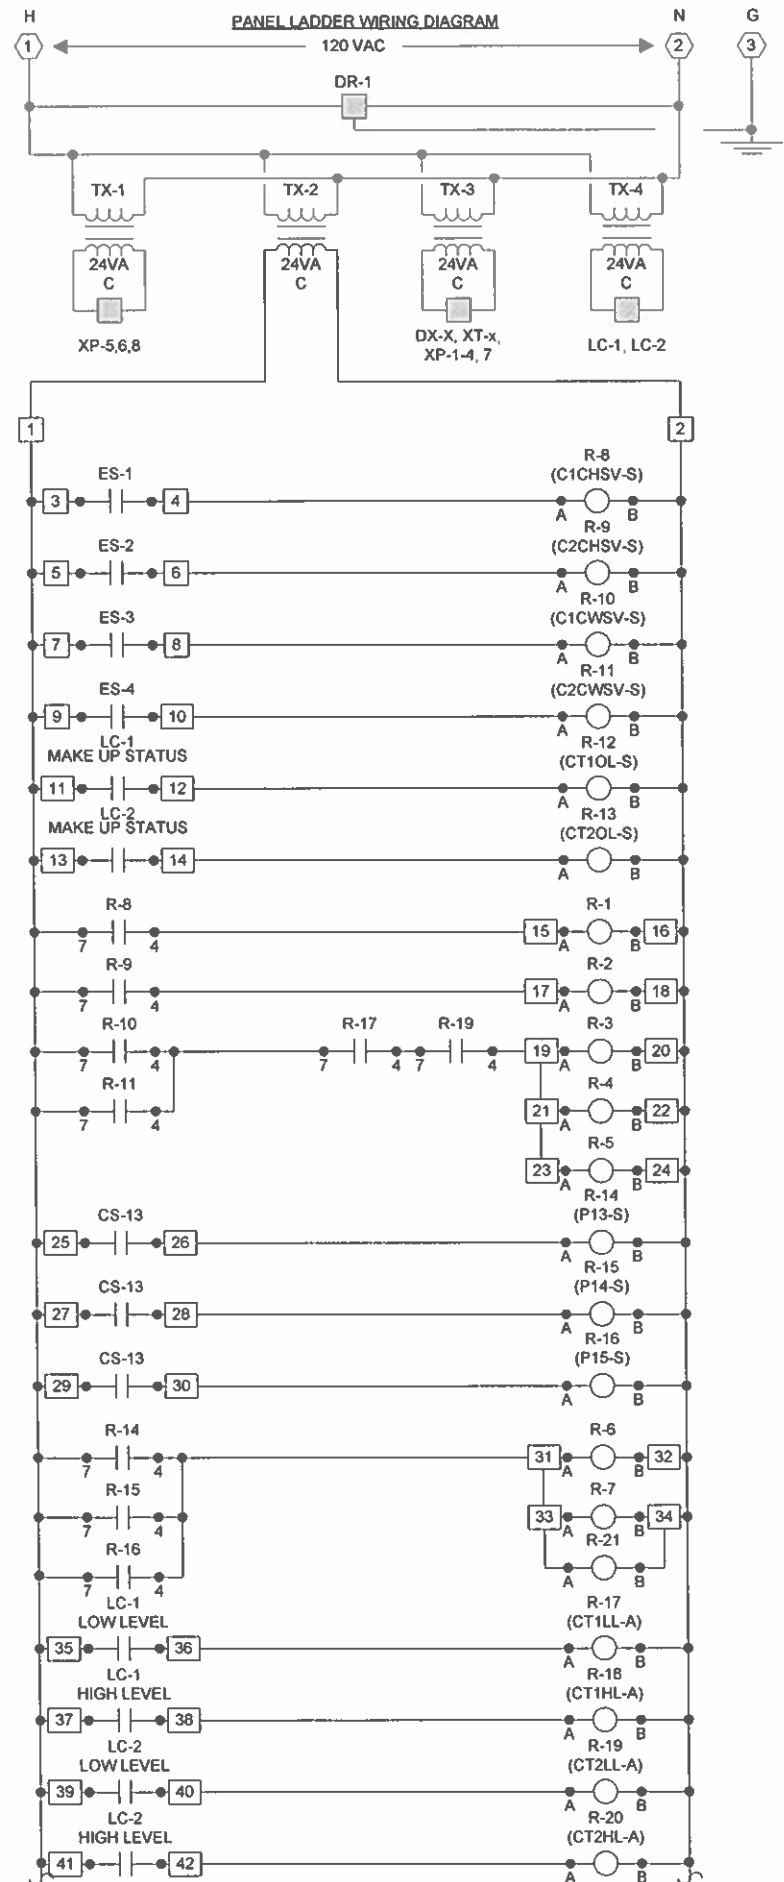

REVISION INFORMATION		Drawing Title <b>CHILLED WATER SYSTEM PANEL WIRING</b>							
NUMBER				1		RECORD DRAWING		6/14/2001 MLR	
DATE		06/14/01		REFERENCE DRAWING		NO		REVISION-LOCATION	
TIME		10:22 AM		Sales Engineer		Project Manager		Application Engineer	
FILE NAME		CWS-pw.vsc		PJS		TP		KJK	
		Project Title		MILLER PARK ONE BREWERS WAY MILWAUKEE, WI 53214		Branch Information		CONTRACT NUMBER	
				JOHNSON CONTROLS Systems & Services Division		Wisconsin Area Office 529 N. Jackson Street Milwaukee WI 53202 Phone: 414-524-7500 Fax: 414-524-7575		9 8075-0508	
								DRAWING NUMBER	
								5.6	



**Main Chilled Water System**


- The chilled water system consists of two chillers with two primary chilled water pumps, two cooling towers with 2-speed motors, three condenser pumps and three chilled water secondary pumps with variable frequency drives.
- The chilled water system is designed to operate at 42°F supply water temperature. The supply temperature will be reset upwards (if only one chiller is enabled) from the chilled water valve position of the air handling unit calling for the most cooling.
- The chilled water plant equipment will operate through a lead-lag sequence which will be initialized by the EMCS based on a preprogrammed schedule. The lead chiller and primary pump will be alternated between CH-1/P-9 and CH-2/P-8 based on a preprogrammed schedule in the EMCS.
- Upon a demand for cooling (based on any equipment requesting chilled water including any food service water condensing units) an enable signal will be given to the lead secondary chilled water pump. Once one secondary chilled water pump is enabled as proven by the current sensing relay across the pump, an enable command will be issued to the lead chiller by the EMCS which will begin the chillers on-board controller internal startup sequence. The chiller panel will request the evaporator pump to enable to the EMCS. The EMCS will issue the lead chillers evaporator control stop valve to open fully. After a predetermined time, to allow the evaporator stop valve to move into the open position as determined by an end switch, the lead chilled water pump will be energized by the EMCS. The chilled water stop valve end switch will be hard-wired into the primary chilled water pumps starter safety circuit to prevent the EMCS or the Hand position of the starter to energize the evaporator pump unless the associated evaporator stop valve is proven open. The chiller panel on-board controller will request the condenser pump to enable to the EMCS. The EMCS will open the lead condenser control stop valve and the lead tower stop valve will fully open. After a predetermined time, to allow the stop valve to move into the open position as determined by the end switches, the lead condenser water pump will be energized from the EMCS. The condenser stop valve per chiller and the tower stop valve per tower end switches will be hard-wired into the three condenser pump starters safety circuit to prevent the EMCS or the Hand position of the starter to energize a condenser pump unless one condenser stop valve is open and one tower stop valve is open as proven open by the end switches. The lead cooling tower and condenser water pumps will be alternated based on a preprogrammed schedule in the EMCS.
- When condenser water flow is proven, as detected by a current sensing relay across the condenser pump, the cooling towers will be energized in sequence from the EMCS. If the EMCS detects low flow, the lead condenser pump will be de-energized and an alarm given at the EMCS. The lag pump will then be energized. The auxiliary contacts of the condenser pumps will be hard-wired into the safety circuit of the tower fan motors so that the EMCS or the Hand position of the tower fan starter will not allow the tower fan to enable unless at least one condenser pump auxiliary contact is closed.
- A current sensing relay across the secondary pump will provide status indication (on/off) to the EMCS.
- The lead chiller will then be enabled through its on-board controls which will control the chiller to maintain its setpoint. Mount and wire field controls per the chiller manufacturer recommendations.
- If the lead chiller sends out a general alarm (from its Trane chiller panel) or loses power, the EMCS will initiate the sequence to bring the lag chiller on line. With both chillers on, chiller on-board controller will provide optimum operating point for both machines. The EMCS will bring on in sequence the lag condenser water pump, chilled water pump and secondary water pump and open control stop valves as described for the lead equipment. Provide delays and minimum on/off times in the EMCS software to prevent unnecessary chiller cycling.
- Both chillers and support equipment will continue to run until the chilled water supply temperature is at the chilled water supply water setpoint and the tons used can be handled by one chiller, at which time the EMCS will initiate the sequence to de-energize the lag chiller.
- The EMCS will first disable the lag chiller and simultaneously the lag primary chilled water pump and lag condenser water pump. After a predetermined time delay, the EMCS will close all control valves on the condenser and evaporative barrel of the lag chiller. The EMCS will only de-energize the secondary chilled water pump when it has determined the best system efficiency requires only one pump.
- The supply temperature for each chiller will be set at 42°F at the local chiller control panel. The supply temperature in the primary chilled water loop will be continuously monitored by the EMCS. If the chilled water supply temperature rises above 47°F or below 37°F an alarm will be raised at the EMCS. The EMCS will remotely reset the chillers on-board controller setpoint per the sequence.
- Chilled water return temperature in the primary loop will be continuously monitored by the EMCS. If the return temperature rises above 60°F an alarm will be raised at the EMCS.
- The condenser water system will be energized through the EMCS during the start-up of either CH-1 or CH-2. The condenser water flow and return temperature will be continuously monitored by the EMCS. The condenser water supply temperature will operate with reset in the range 75°F to 80°F based on outside air temperature. If the condenser water supply temperature rises above 85°F an alarm will be raised at the EMCS. If the condenser water temperature drops below 60°F an alarm will be raised at the EMCS.
- The lead cooling tower pony motor will be energized by the EMCS. If the auxiliary contact at the starter fails to close an alarm will be raised at the EMCS. The motor will de-energize, but alarm will remain. The pony motor of the lag cooling tower will then be energized after the lag cooling tower stop valve is fully open as determined by the stop valve end switch. The EMCS will close the lead cooling tower stop control valve.
- When the condenser water supply temperature rises above 85°F while operating as described above, the EMCS will de-energize the pony motor and energize the primary motor. If the auxiliary contact at the starter fails to close an alarm will be raised at the EMCS, the primary motor de-energized and the pony motor energized.

- When the condenser water supply temperature rises above 85°F while operating as described above, the EMCS will de-energize the pony motor and energize the primary motor. If the auxiliary contact at the starter fails to close an alarm will be raised at the EMCS, the primary motor de-energized and the pony motor energized.
- When the condenser water supply temperature drops below 75°F the cooling tower fans will cycle back to the pony motor. Provide a de-accelerating relay in each two speed motor starter. If the condenser water temperature continues to drop, de-energize the pony motor.
- The condenser water chemical treatment system will operate through an independent local control panel to meter the required chemicals to the cooling tower basins. Mount and wire controls per the manufacturer recommendations.
- Upon the outside temperature reaching 50°F and the towers being off, the pan heaters and pipe trace heating will be activated. The pan heaters and trace heating will continue to be energized, until outside air temperature rises above 50°F or the cooling tower is activated. The pan heaters and trace heating will be furnished and installed by others, this contractor will be required to provide pilot duty relays from EMCS to energize and de-energize them.
- The lead condenser pump will run continuously, until it cannot satisfy demand at which point the lag pump will be energized. The pumps will continue to run in parallel until demand drops to a point where a single pump can handle the load. Pumps will be de-energized in reverse order. The EMCS will schedule the pumps on and off to maintain the most efficient system operating point.
- If the condenser entering temperature continues to drop below setpoint, the cooling tower bypass valve will modulate to bypass the condenser water from the cooling tower.
- No chiller integrator panel is provided.
- Provide a 3 level cooling tower sump level switch for both tower sumps. Wire the pump on/off level contact directly into the condenser pump safety circuits. This contact will open if the sump level is too low, which will de-energize all condenser pumps if both sumps are low. The EMCS will alarm each low level individually. If the sump level rises above the high level setpoint, alarm the EMCS.

**Secondary Chilled Water System**

- The secondary chilled water pumps P-10, P-11 and P-12 will operate through a lead/lag sequence which will be initialized by the EMCS based on a preprogrammed schedule. One pump will be designated as standby.
- The lead secondary chilled water pump will be energized by the EMCS as part of chiller start-up sequence. If the pump indicates a common trouble alarm at the EMCS it will be de-energized but the alarm remains active. The lag pump will then be energized.
- The lag secondary chilled water pump will be energized in sequence with the lead pump only if the lag chiller is energized and if the EMCS has determined that both pumps are required for best system efficiency.
- Secondary chilled water supply and return water temperature will be continuously monitored by the EMCS.
- A current sensing relay across the lead pump will confirm pump status. If the EMCS detects no flow, the lead pump will be de-energized and an alarm given at the EMCS.
- The lead pump will run continuously, until it cannot satisfy demand at which point the lag pump will be energized. The pumps will continue to run in parallel until demand drops to a point where a single pump can handle the load. Pumps will be de-energized in reverse order. The EMCS will schedule the pumps on and off to maintain the most efficient system operating point.
- The EMCS will select the lowest of three pressure differential sensors to modulate the pump speed to maintain the chilled water differential pressure setpoint. All energized pumps will operate at the same speed.
- Provide a software lead pump rotation point (10-11-12 lead pump select) to equalize pump runtimes.

REVISION INFORMATION	Drawing Title										
	NUMBER	SEQUENCE									
DATE	08/16/02										
TIME	10:07 AM										
FILE NAME	CWS-S.vsd										
		Project Title		MILLER PARK ONE BREWERS WAY MILWAUKEE, WI 53214		Branch Information		Wisconsin Area Office 529 N. Jackson Street Milwaukee WI 53202 Phone: 414-524-7500 Fax: 414-524-7575		CONTRACT NUMBER <b>9 8075-0508</b> DRAWING NUMBER <b>5.7</b>	
		Drawing Title		SEQUENCE		REFERENCE DRAWING		NO.		REVISION-LOCATION	
		DATE		08/16/02		Sales Engineer		Project Manager		Application Engineer	
		TIME		10:07 AM		PJS		TP		KJK	
		FILE NAME		CWS-S.vsd		BY		MLR		DATE	
		DRAWN				APPROVED					
		JOHNSON CONTROLS		Systems & Services Division							

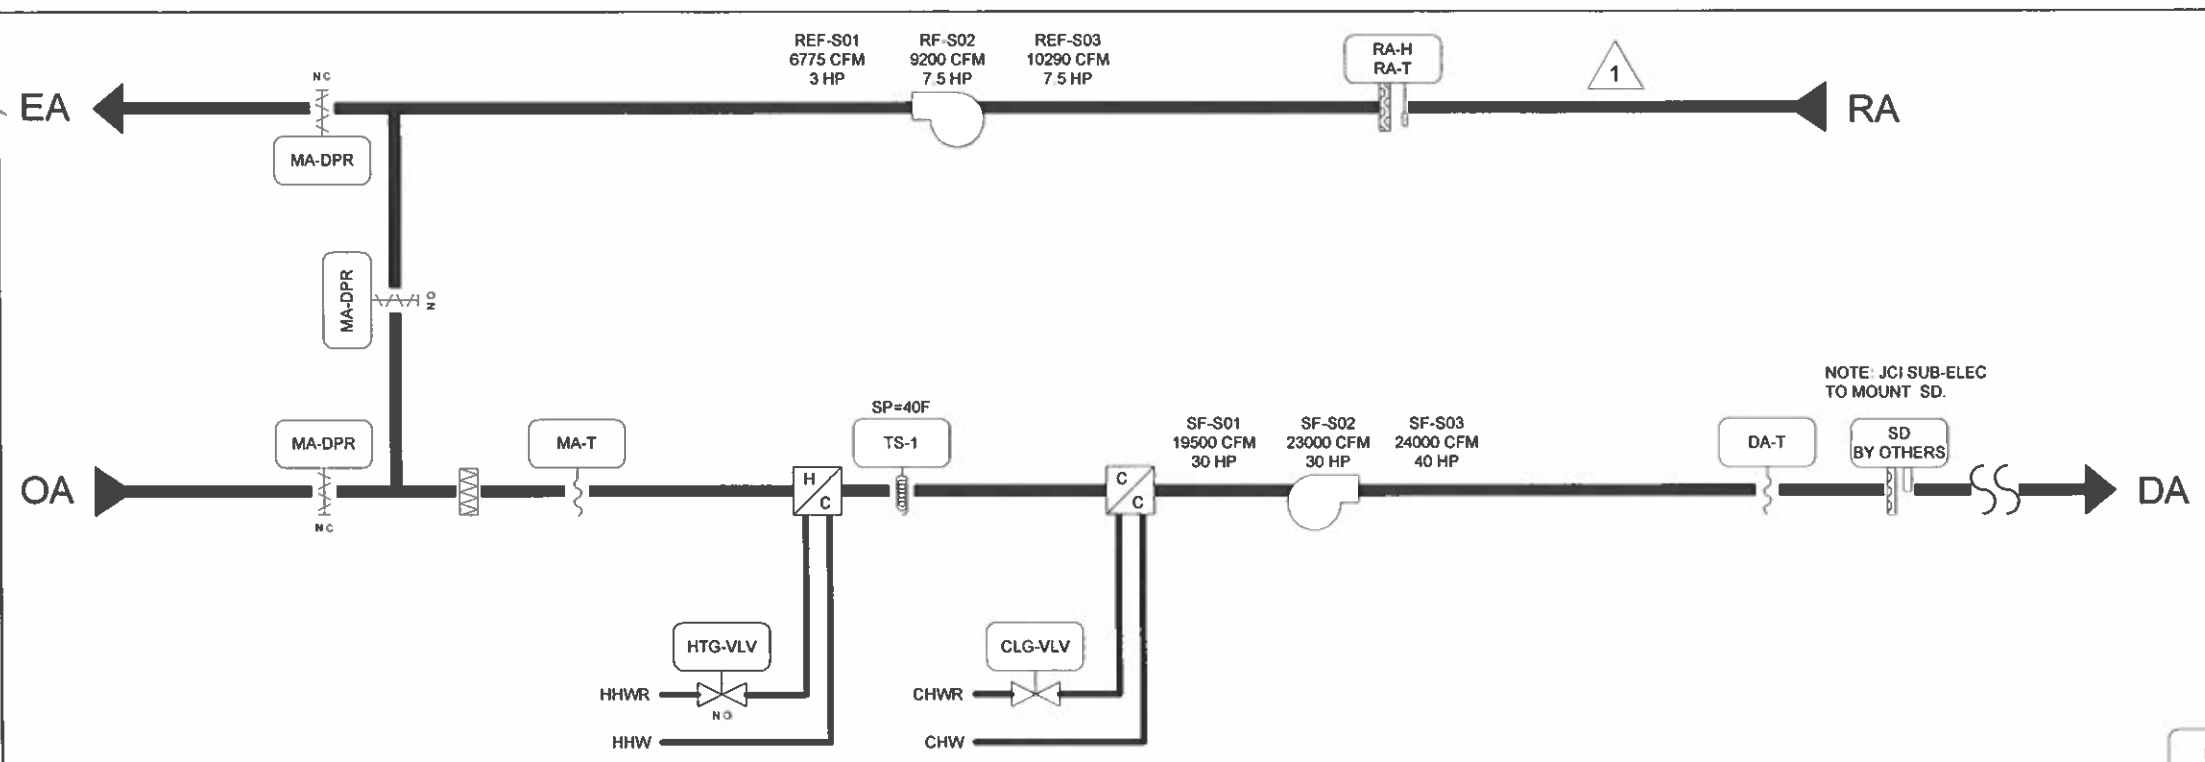


**BILL OF MATERIALS**

Designation	Qty	Part Number	Description
<b>Field Devices:</b>			
DA-T	1	TE-6315P-1	SENS.T-Ni.0.1%,8' AVG
MA-T	1	TE-6316P-1	SENS.T-Ni.0.1%,17' AVG
MA-T, TS-1	1	TE-6001-8	CLIP F/AVG ELEM (10/PKG)
R-1, R-2	2	CVR-21C-0	RLY 2SPDT,10-30VAC/DC OR 120VAC,LED @LEC
RA-H, RA-T	1	HE-6310-2	XMTR,RH/T-Ni,DUCT,AC/DC
RF-C,RF-S,SF-C,CS-1	2	H-735	SW, CURRENT, 1-135A CMND RLY SOLID @VER
TS-1	2	A70HA-1C	STAT LL,20',EL,MAN,15/55F
X-DPR	0		SEE DAMPER SCHEDULE
X-DPR, X-VLV	5	PD-101-1	RESISTOR, 4990HM 1/2W 1%
X-VLV	0		SEE VALVE SCHEDULE
<b>Panel Devices:</b>			
AHU-X	1	AS-AHU103-300	AHU TERMINATION BD/ELECTRONICS IN EWC35
P-X	2	EN-EXP101-0	EXPANSION COVER AND BACKBONE
R-3-R-5	3	PD-101-35	RLY BASE,3PDT,11PIN,10A
	3	PD-109-51	RELAY PLUG-IN 3PDT 24VAC
TAG-1	1	M-8000-393	NAMEPLT,LAMICOID,3 LINE
TX-1	1	PD-114-2	TRANSFORMER 100VA, 120/24



NOTE: JCI SUB-ELEC TO MOUNT SD.

- FROM LAST N2 DEVICE (N2) -3/18
- TO NEXT N2 DEVICE (N2) -3/18
- SF-C\BO-1 (S01-1-BO-1) 2/18
- RF-C\BO-2 (S01-1-BO-2) 2/18
- MA-DPR\AO-1 (S01-1-AO-1) 2/18
- HTG-VLV\AO-2 (S01-1-AO-2) 2/18
- CLG-VLV\AO-3 (S01-1-AO-3) 2/18
- RF-S\BI-2 (S01-1-BI-2) 2/18
- MA-T\AI-2 (S01-1-AI-2) 2/18
- DA-T\AI-3 (S01-1-AI-3) 2/18
- RA-T\AI-5 (S01-1-AI-5) 2/18
- RA-H\AI-6 (S01-1-AI-6) 3/18

NOTE: SEE POINT SCHEDULE FOR MULTIPLEXED POINTS NOT SHOWN.

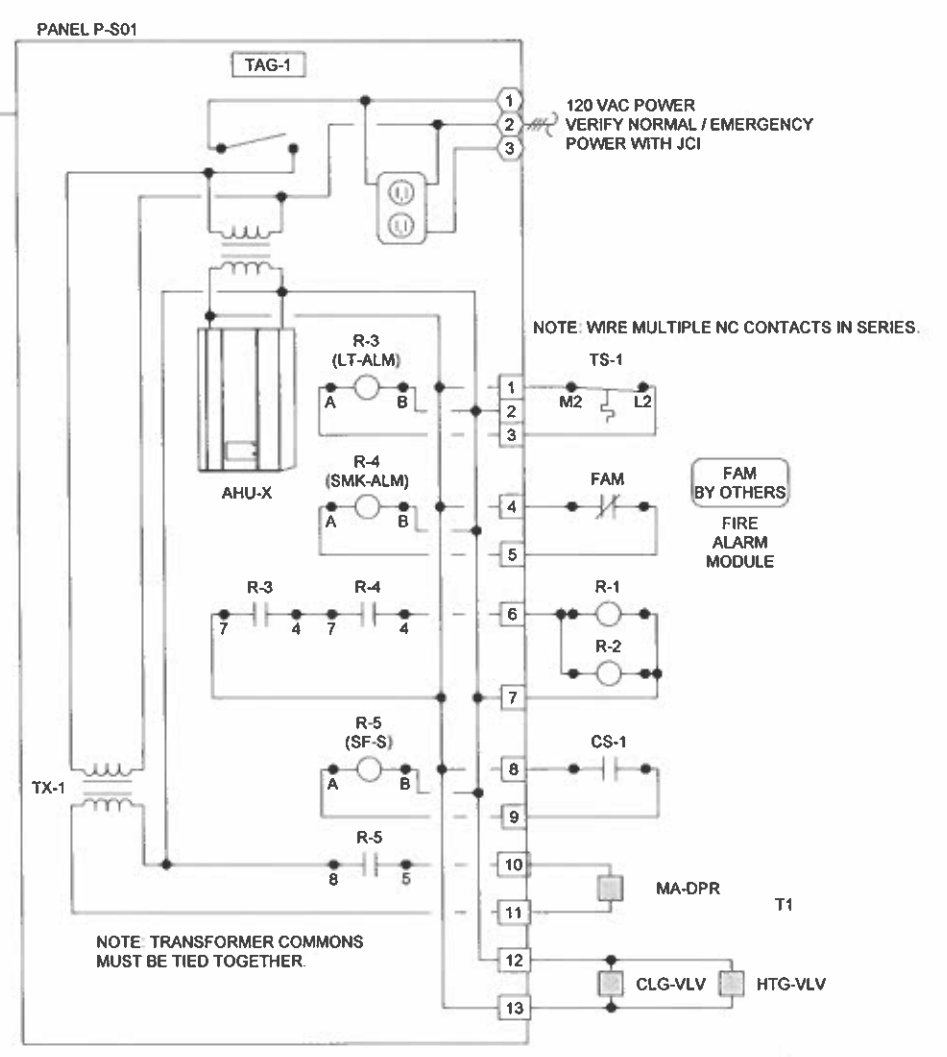

**PANEL FACE TAGS:**  
 TAG-1: PANEL P-S01 AH-S01 JCI 9 8075-0508  
 TAG-1: PANEL P-S02 AH-S02 JCI 9 8075-0508  
 TAG-1: PANEL P-S03 AH-S03 JCI 9 8075-0508

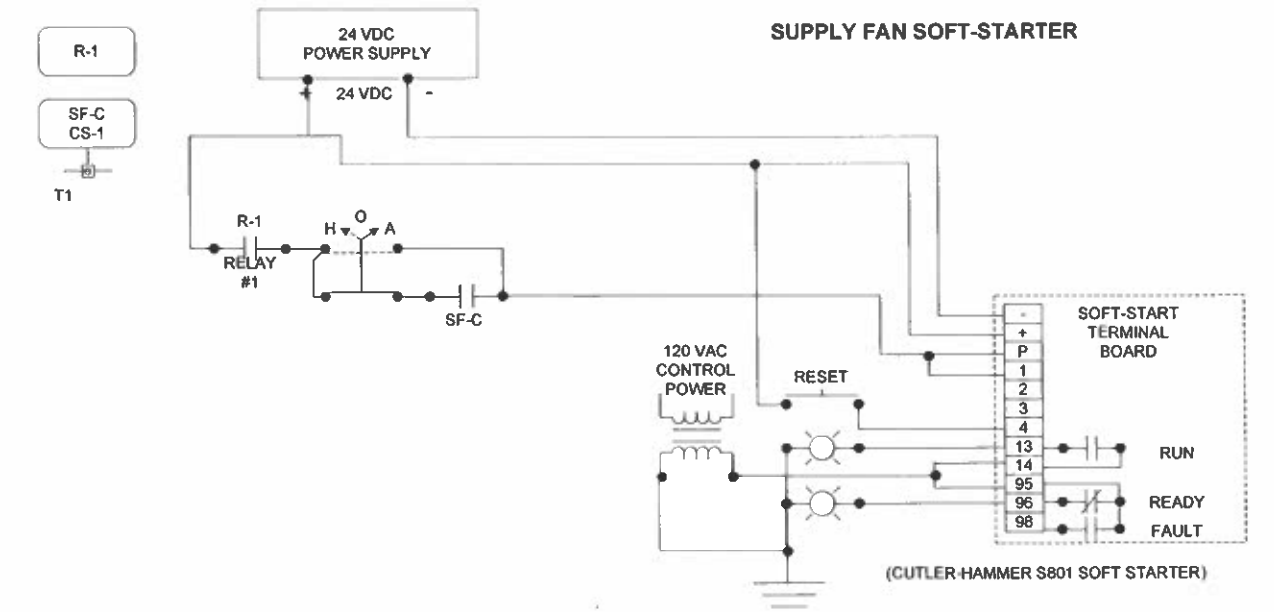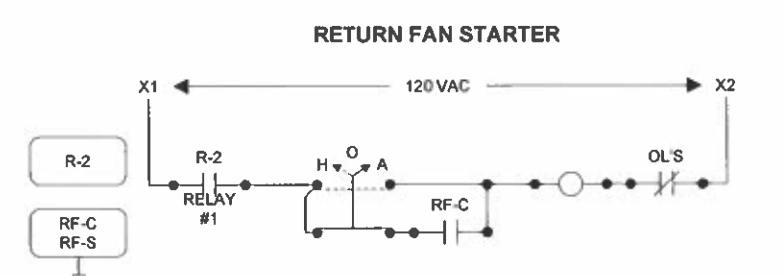

Pilot lights were changed from "On" and "Off" to "Run" and "Ready" when Soft-Starter was installed


REVISION INFORMATION	Drawing Title	Soft-Starter added	2003-14	2003 SRF Project	DAM
	NUMBER	AH-S01 FLOW TYPICAL FOR AH-S02, AH-S03			
DATE	11/06/09	REFERENCE DRAWING	NO	REVISION LOCATION	ECN
TIME	09:11 AM	DATE	11/06/09	BY	MLR
FILE NAME	ahs01f2.vsd	PROJECT MANAGER	TP	APPLICATION ENGINEER	KJK
Project Title		MILLER PARK ONE BREWERS WAY MILWAUKEE, WI 53214		CONTRACT NUMBER	
		JOHNSON CONTROLS Systems & Services Division		9 8075-0508	
		Wisconsin Area Office 529 N Jackson Street Milwaukee WI 53202 Phone: 414-524-7500 Fax: 414-524-7575		DRAWING NUMBER	
				6.1	

AH-S01, AH-S02, AH-S03

**Multi-zone Constant Volume MASP Air Handling System with Return Fan and Economizer Cycle**

1. The air handling unit is equipped with supply fan, return fan, heating coil, cooling coil, pre-filter, final filter and economizer mixing box.
2. The air handling unit supply and return fans will be energized through the EMCS on a scheduled basis.
3. Provide for the air handling unit, an economizer logic network controller to position the economizer dampers for maximum economy and sequenced with the heating and cooling valves.
4. Unless the economizer controller is overridden by the warm-up cycle, the controller will verify that the air handling unit is running via a fan proof of flow controller and open the outside air damper to the minimum required ventilation position.
5. When the outside air dry bulb temperature is less than outside air dry bulb setpoint, the economizer dampers will be positioned for maximum free cooling using outside air to meet the cooling demand. The mechanical cooling equipment will only be used if the outside air cannot provide enough free cooling to meet demand.
6. Upon morning start-up of the occupied mode, mechanical cooling will be locked out, the heating coil control valve will fully open, the outside air damper will move to the closed position, and any interlocked exhaust fans will be de-energized. When the return air temperature reaches the warm-up setpoint, the air handler will return to normal operation.
7. Each zone sensor or group of zone sensors modulate the reheat coil hot water control valve to satisfy the required room temperature. See the Reheat Coil sequence of operation.
8. The chilled and hot water control valves will modulate in sequence to maintain the discharge air temperature. The discharge air temperature setpoint will be reset based on the operation of the zone reheat coil control valves and return air humidity.
9. Smoke detectors located in the supply and return ducts will on detection of smoke shut down the air handler supply and return fans via a hard-wire interlock with fan starters. Smoke detector status will be indicated at the EMCS.
10. Filter replacement will be scheduled based on supply fan runtime.
11. Current switches will be located on the feed to the supply fan and return fan to provide status indication (on/off). In off hours DDC controller will command the chilled water two-way control valve and outside air damper to a fully closed position, heating coil control valve to fully open position.
12. The EMCS will monitor and control all points for each air handling unit.
13. In off hours, the supply fan and return fan will be cycled intermittently at night by the zone sensor to maintain 60°F.


REVISION INFORMATION	Drawing Title								
NUMBER	SEQUENCE								
DATE		REFERENCE DRAWING	NO	REVISION LOCATION	ECN	DATE	BY		
04/12/01		Sales Engineer	Project Manager	Application Engineer	BY	MLR	DATE	BY	DATE
		PJS	TP	KJK					
TIME	Project Title	Branch Information		CONTRACT NUMBER					
08:17 AM	MILLER PARK ONE BREWERS WAY MILWAUKEE, WI 53214	JOHNSON CONTROLS		Wisconsin Area Office 529 N. Jackson Street Milwaukee WI 53202 Phone: 414-524-7500 Fax: 414-524-7575		9 8075-0508			
FILE NAME		Systems & Services Division		DRAWING NUMBER					
ahs01s.vsd				6.2					

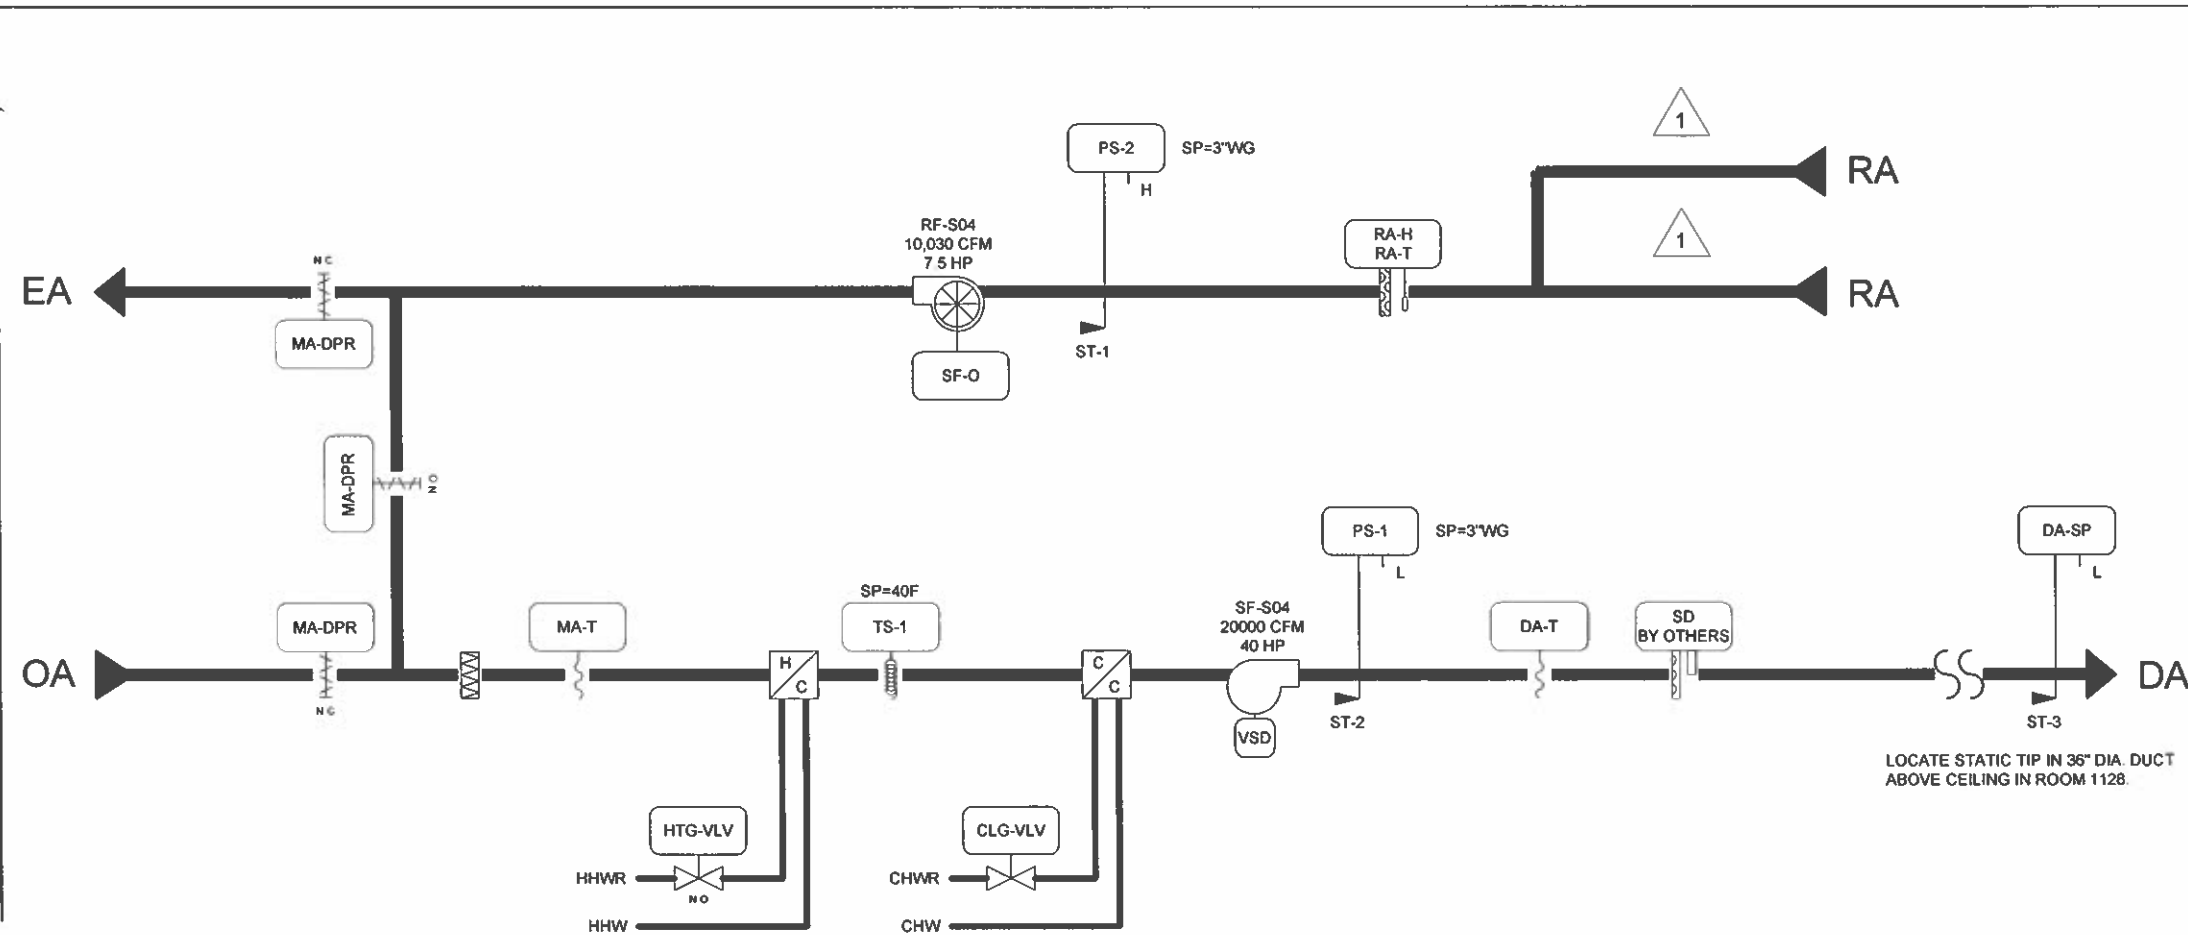

**BILL OF MATERIALS**


Designation	Qty	Part Number	Description
<b>Field Devices:</b>			
DA-SP	1	DPT-2640-26	XDUCR DP -5.0/5.0" 0-5V
DA-T	1	TE-6315P-1	SENS,T-NI,0.1%,8" AVG
MA-T	1	TE-6316P-1	SENS,T-NI,0.1%,17" AVG
MA-T, TS-1	1	TE-6001-8	CLIP F/AVG ELEM (10/PKG)
PS-x	2	AFS-460	SW, AIR FLOW, SPST-NC RESET .05-12" @CLE
R-1, R-2	2	CVR-21C-O	RLY 2SPDT,10-30VAC/DC OR 120VAC,LED @LE
RA-H, RA-T	1	HE-6310-2	XMTR,RH/T-NI,DUCT,AC/DC
RF-C,RF-S,SF-C,CS-1	2	H-735	SW, CURRENT, 1-135A CMND RLY SOLID @VER
ST-x	3	A520-2-A-1	8" STATIC PROBE, ALUM, 1/4" TUBE @MAMAC
TS-1	2	A70HA-1C	STAT,LL,20',EL,MAN,15/5SF
X-DPR, X-VLV,XF-O	4	PD-101-1	RESISTOR, 4990HM 1/2W 1%
X-DPR, XF-O	0		SEE DAMPER SCHEDULE
X-VLV	0		SEE VALVE SCHEDULE

**SUPPLY FAN VARIABLE SPEED DRIVE**

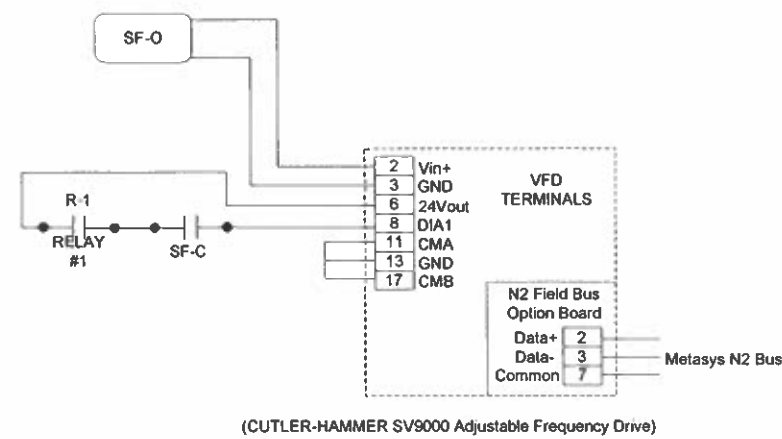

(CUTLER-HAMMER SV9000 Adjustable Frequency Drive)

**RETURN FAN STARTER**

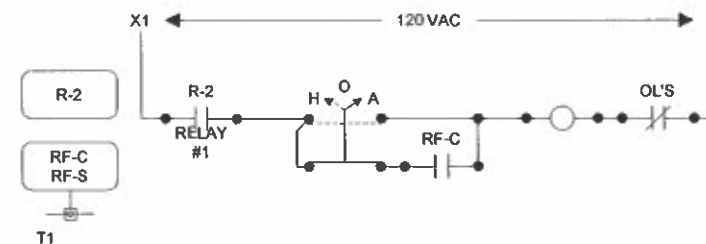


REVISION INFORMATION	Drawing Title	VFD Relpaced inlet Vanes			2003-14	2003 SRF Project	DAM
	NUMBER	AH-S04 FLOW					
DATE	11/06/09	Project Manager	Application Engineer	By	DATE	By	DATE
TIME	09:12 AM	PJS	TP	KJK	MLR		
FILE NAME	ahs04f2.vsd	Project Title		Branch Information		CONTRACT NUMBER	
		MILLER PARK ONE BREWERS WAY MILWAUKEE, WI 53214		Wisconsin Area Office 529 N. Jackson Street Milwaukee WI 53202 Phone: 414-524-7500 Fax: 414-524-7575		9 8075-0508	
		JOHNSON CONTROLS Systems & Services Division				DRAWING NUMBER 7.1	

**BILL OF MATERIALS**

Designation	Qty	Part Number	Description
Panel Devices:			
AHU-X	1	AS-AHU103-300	AHU TERMINATION BD/ELECTRONICS IN EWC35
P-X	2	EN-EXP101-0	EXPANSION COVER AND BACKBONE
R-3-R-8	6	PD-101-35	RLY BASE,3PDT,11PIN,10A
	6	PD-109-51	RELAY PLUG-IN 3PDT 24VAC
SMKDPR-C	1	V11HGA-100	3-W SOLENOID,W/OV,24 VAC
TAG-1	1	M-8000-393	NAMEPLT,LAMICOID,3 LINE
TX-1	1	PD-114-2	TRANSFORMER 100VA, 120/24

1

- FROM LAST N2 DEVICE (N2) 3/18 BLU
- TO NEXT N2 DEVICE (N2) 3/18 BLU
- SF-C\BO-1 (S04-4-BO-1) 2/18 VIO
- RF-C\BO-2 (S04-4-BO-2) 2/18 VIO
- MA-DPR\AO-1 (S04-4-AO-1) 2/18 TAN
- HTG-VLV\AO-2 (S04-4-AO-2) 2/18 TAN
- CLG-VLV\AO-3 (S04-4-AO-3) 2/18 TAN
- SF-O\AO-4 (S04-4-AO-4) 2/18 TAN
- RF-S\BI-2 (S04-4-BI-2) 2/18 ORG
- CEFS01-S\BI-3 (S04-4-BI-3) 2/18 ORG
- MA-T\AI-2 (S04-4-AI-2) 2/18 YEL
- DA-T\AI-3 (S04-4-AI-3) 2/18 YEL
- RA-T\AI-5 (S04-4-AI-5) 2/18 YEL
- RA-H\AI-6 (S04-4-AI-6) 3/18 YEL
- DA-SP\AI-7 (S04-4-AI-7) 3/18 YEL
- SP14-A\1DI1 (S04-134A-DI-1) 2/18 ORG

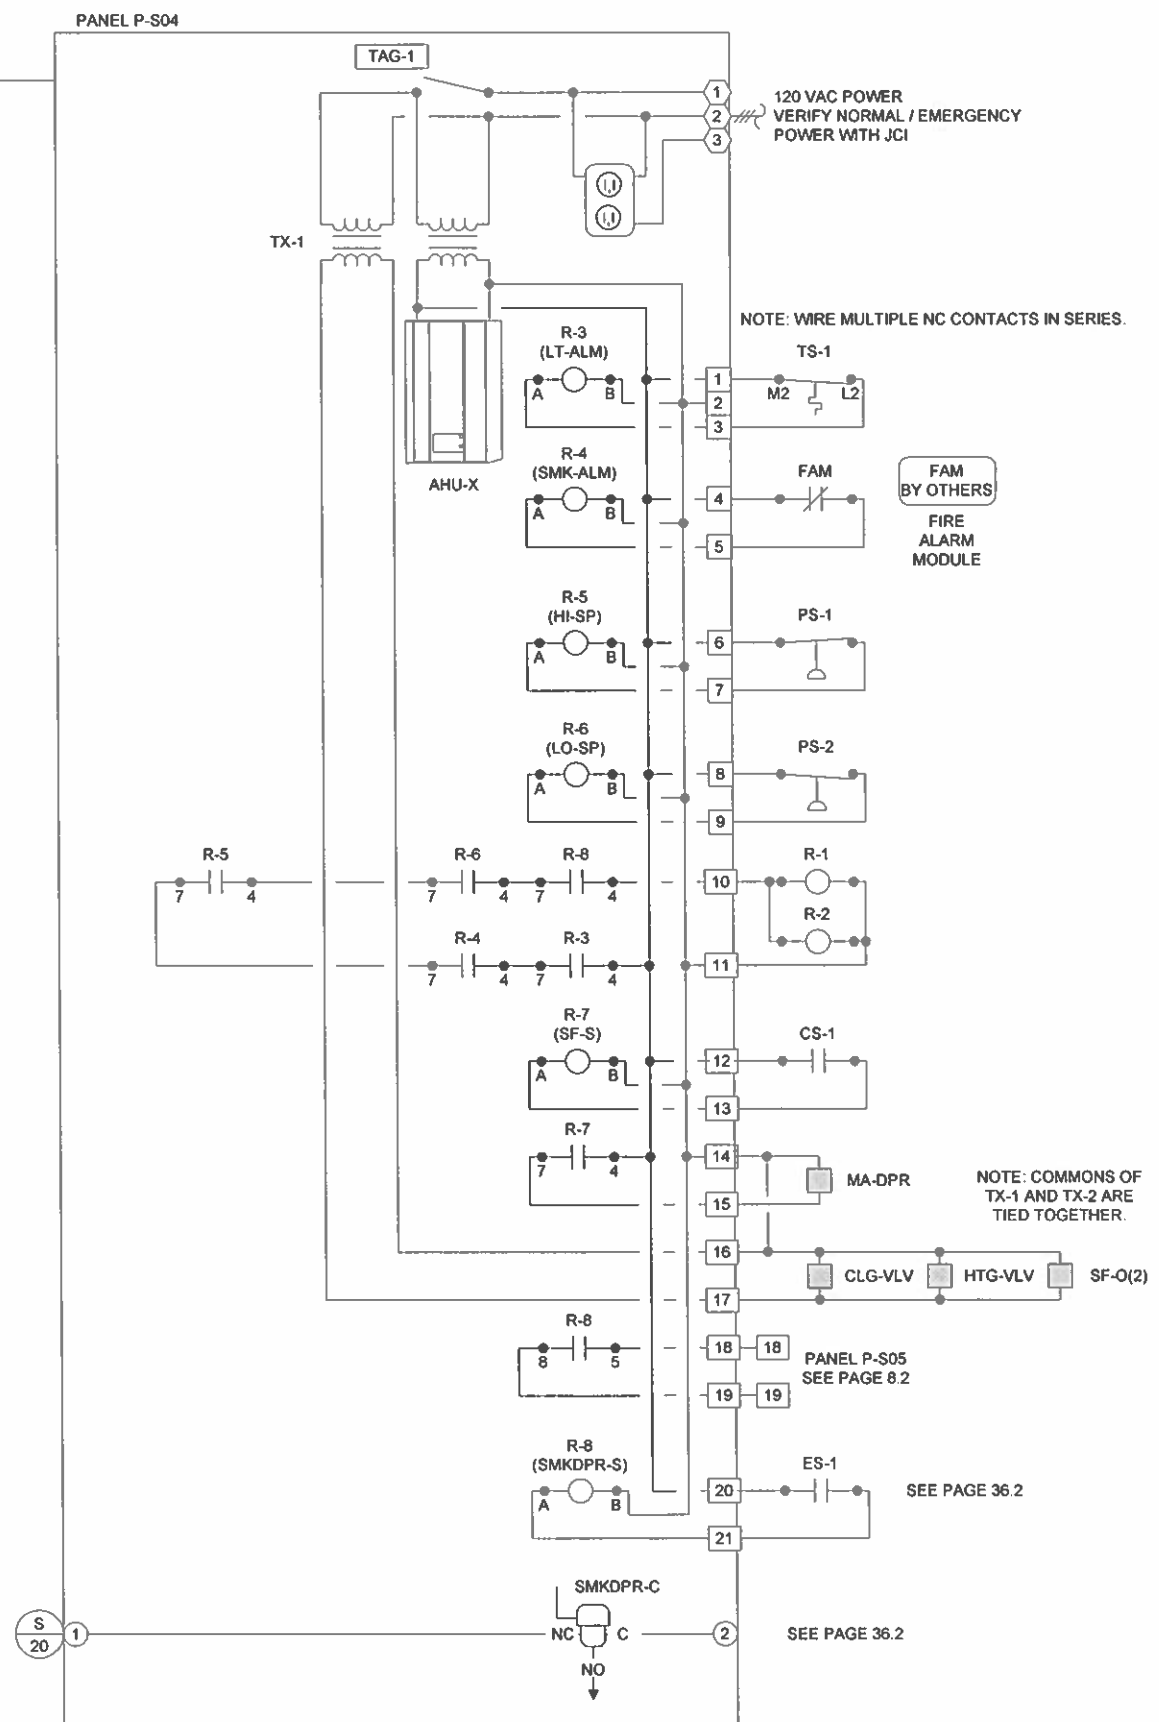


PANEL FACE TAGS:  
TAG-1: PANEL P-S04  
AH-S04  
JCI 9 8075-0508

REVISION INFORMATION	Drawing Title				
NUMBER	AH-S04 PANEL				
DATE	04/12/01	REFERENCE DRAWING	NO	REVISION LOCATION	ECH DATE BY
TIME	08:40 AM	Sales Engineer	Project Manager	Application Engineer	BY DATE
FILE NAME	ahs04p.vsd	PJS	TP	KJK	MLR DATE
Project Title		Branch Information		CONTRACT NUMBER	
MILLER PARK ONE BREWERS WAY MILWAUKEE, WI 53214		JOHNSON CONTROLS Systems & Services Division		9 8075-0508	
		Wisconsin Area Office 529 N. Jackson Street Milwaukee WI 53202 Phone: 414-524-7500 Fax: 414-524-7575		DRAWING NUMBER 7.2	

AH-S04

**Multi-zone VAV MASP Air Handling System with Return Fan and Economizer Cycle**



1. The air handling unit is equipped with supply fan, return fan, heating coil, cooling coil, pre-filter, final filter and economizer mixing box.
2. The air handling unit supply and return fans will be energized through the EMCS on a scheduled basis.
3. The supply fan capacity will be modulated via inlet guide vanes based upon static pressure in the supply duct. The return fan capacity will track the supply fan capacity. A high pressure safety cut-out located in the air handling unit will deactivate the unit upon a static pressure of 3.0" w.c. being detected in the cabinet. Provide actuators for inlet vanes.
4. Provide on the air handling unit, an economizer logic network controller to position the economizer dampers for maximum economy and sequenced with the heating and cooling valves.
5. Unless the economizer controller is overridden by the warm-up cycle, the controller will verify that the air handling unit is running via a fan proof of flow controller and open the outside air damper to the minimum required ventilation position.
6. When the outside air dry bulb temperature is less than outside air dry bulb setpoint, the economizer dampers will be positioned for maximum free cooling using outside air to meet the cooling demand. The mechanical cooling equipment will only be used if the outside air cannot provide enough free cooling to meet demand.
7. Upon morning start-up of the occupied mode mechanical cooling will be locked out, the heating control valve will fully open, the outside air damper will remain in the closed position, all VAV boxes will be at maximum CFM though the reheat valve will remain under the control of zone sensors, all interlocked exhaust fans will be de-energized, and the supply and return fan will track with no offset. When the return air temperature reaches the warm-up setpoint, the air handler will return to normal operation. Provide all relays, solenoids, and wiring required to lock out warm-up during normal occupancy hours.
8. Each zone sensor modulates the VAV box damper to satisfy the required room temperature. See the VAV Box sequence of operation.
9. The chilled water control valve will modulate in sequence to maintain the discharge air temperature. The discharge air temperature setpoint will be reset based on return air humidity.
10. Smoke detectors located in the supply and return ducts will on detection of smoke shut down the air handler supply and return fans via a hard-wire interlock with fan starters. Smoke detectors will indicate status at EMCS.
11. Filter replacement will be scheduled based on supply fan runtime.
12. Current switches will be located on the feed to the supply fan and return fan to provide status indication (on/off). In off hours DDC controller will command the chilled water two-way control valve to a fully closed position, the heating valve to the fully open position, and the outside air damper to the fully closed position.
13. The EMCS will monitor and control all points for each air handling unit.
14. If the supply air static at the supply fan raises above the high limit setpoint, the system will be shutdown. If the return air static drops below the low limit setpoint, the system will be shutdown.
15. In off hours, the supply fan and return fan will be cycled intermittently at night by the zone sensor to maintain 60°F.

REVISION INFORMATION NUMBER	Drawing Title								
	SEQUENCE								
DATE	04/12/01	REFERENCE DRAWING	NO	REVISION LOCATION	ECH	DATE	BY		
TIME	08:44 AM	Sales Engineer	Project Manager	Application Engineer	BY	MLR	DATE	BY	DATE
FILE NAME	ahs04s.vsd	PJS	TP	KJK					
	Project Title				Branch Information Wisconsin Area Office 529 N. Jackson Street Milwaukee WI 53202 Phone: 414-524-7500 Fax: 414-524-7575		CONTRACT NUMBER <b>9 8075-0508</b>		
	MILLER PARK ONE BREWERS WAY MILWAUKEE, WI 53214	Systems & Services Division					DRAWING NUMBER <b>7.3</b>		



**BILL OF MATERIALS**


Designation	Qty	Part Number	Description
<b>Field Devices:</b>			
D-1, ES-1	0	DAMPER	SEE DAMPER SCHEDULE
DA-T	1	TE-6315P-1	SENS T-NI,0.1%,8' AVG
R-1-R-3	3	CVR-21C-0	RLY 2SPDT,10-30VAC/DC OR 120VAC,LED @LEC
SF-C,SF-S	1	H-735	SW. CURRENT, 1-135A CMND RLY SOLID @VER
TS-1	2	A70HA-1C	STAT.LL,20' EL.MAN,15/55F
	1	TE-6001-8	CLIP F/AVG ELEM (10/PKG)
X-VLV	0	VALVE	SEE VALVE SCHEDULE
ZN-H	1	HE-6300-2	XMTR,RH/T-NI,WALL,AC/DC

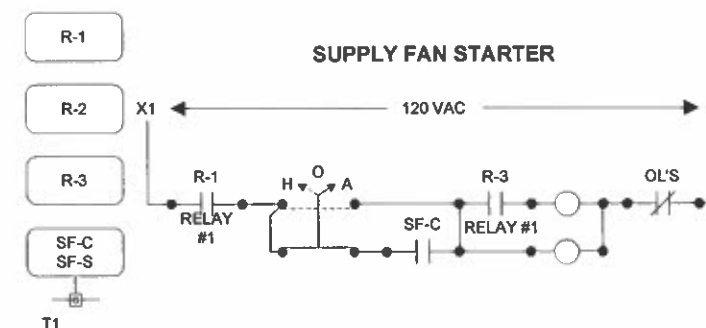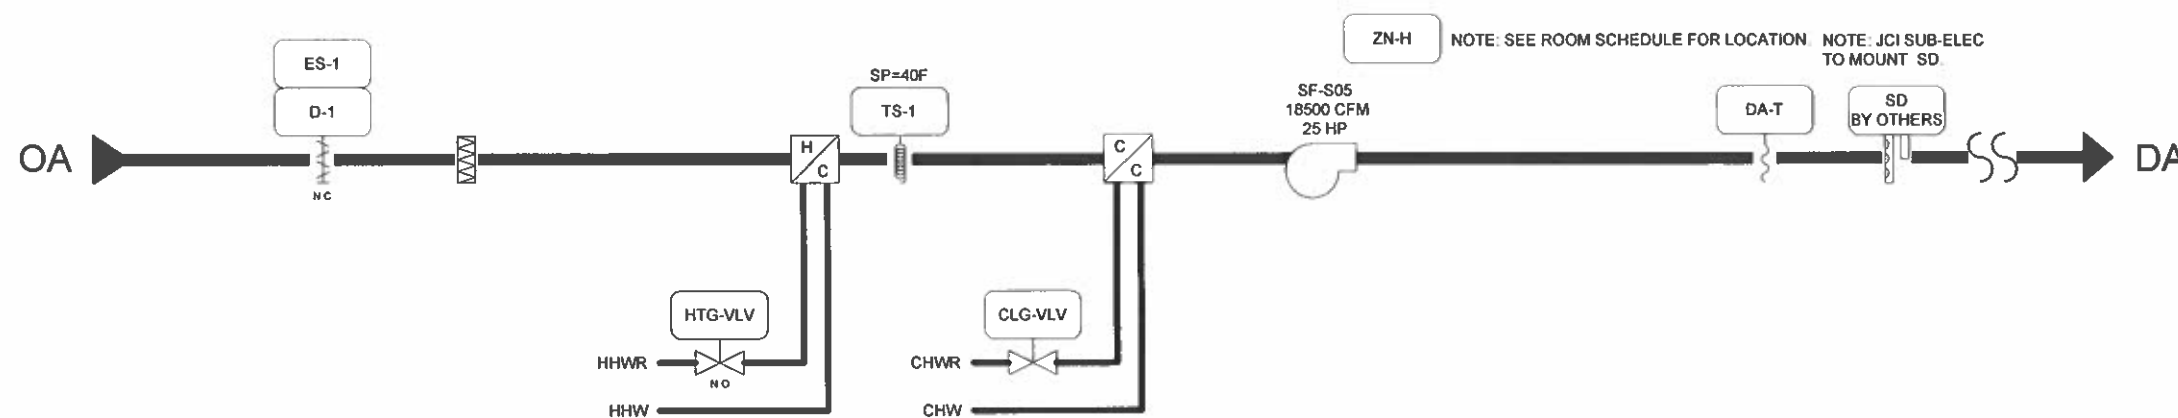

REVISION INFORMATION	Drawing Title				
	NUMBER	AH-S05 FLOW			
DATE	04/12/01	REFERENCE DRAWING		NO.	REVISION-LOCATION
TIME	08:49 AM	Sales Engineer	Project Manager	Application Engineer	DATE
FILE NAME	ahs05f.vsd	PJS	TP	KJK	BY MLR DATE
Project Title		Wisconsin Area Office		CONTRACT NUMBER	
MILLER PARK		529 N. Jackson Street		9 8075-0508	
ONE BREWERS WAY		Milwaukee		DRAWING NUMBER	
MILWAUKEE, WI 53214		WI 53202		8.1	
		Phone: 414-524-7500			
		Fax: 414-524-7575			

**BILL OF MATERIALS**

Designation	Qty	Part Number	Description
Panel Devices:			
AHU-X	1	AS-AHU103-300	AHU TERMINATION BD/ELECTRONICS IN EWC35
P-X	1	EN-EXP101-0	EXPANSION COVER AND BACKBONE
R-4-R-6	3	PD-101-35	RLY BASE,3PDT,11PIN,10A
	3	PD-109-51	RELAY PLUG-IN 3PDT 24VAC
TAG-1	1	M-8000-393	NAMEPLT,LAMICOID,3 LINE
XPB-1	1	XPB-821-5	CNTRLR,N2 EXPN MOD,8BI
XTM-134	1	XTM-105-5	CNTRLR,N2 EXTENSION MOD,COMM I/F

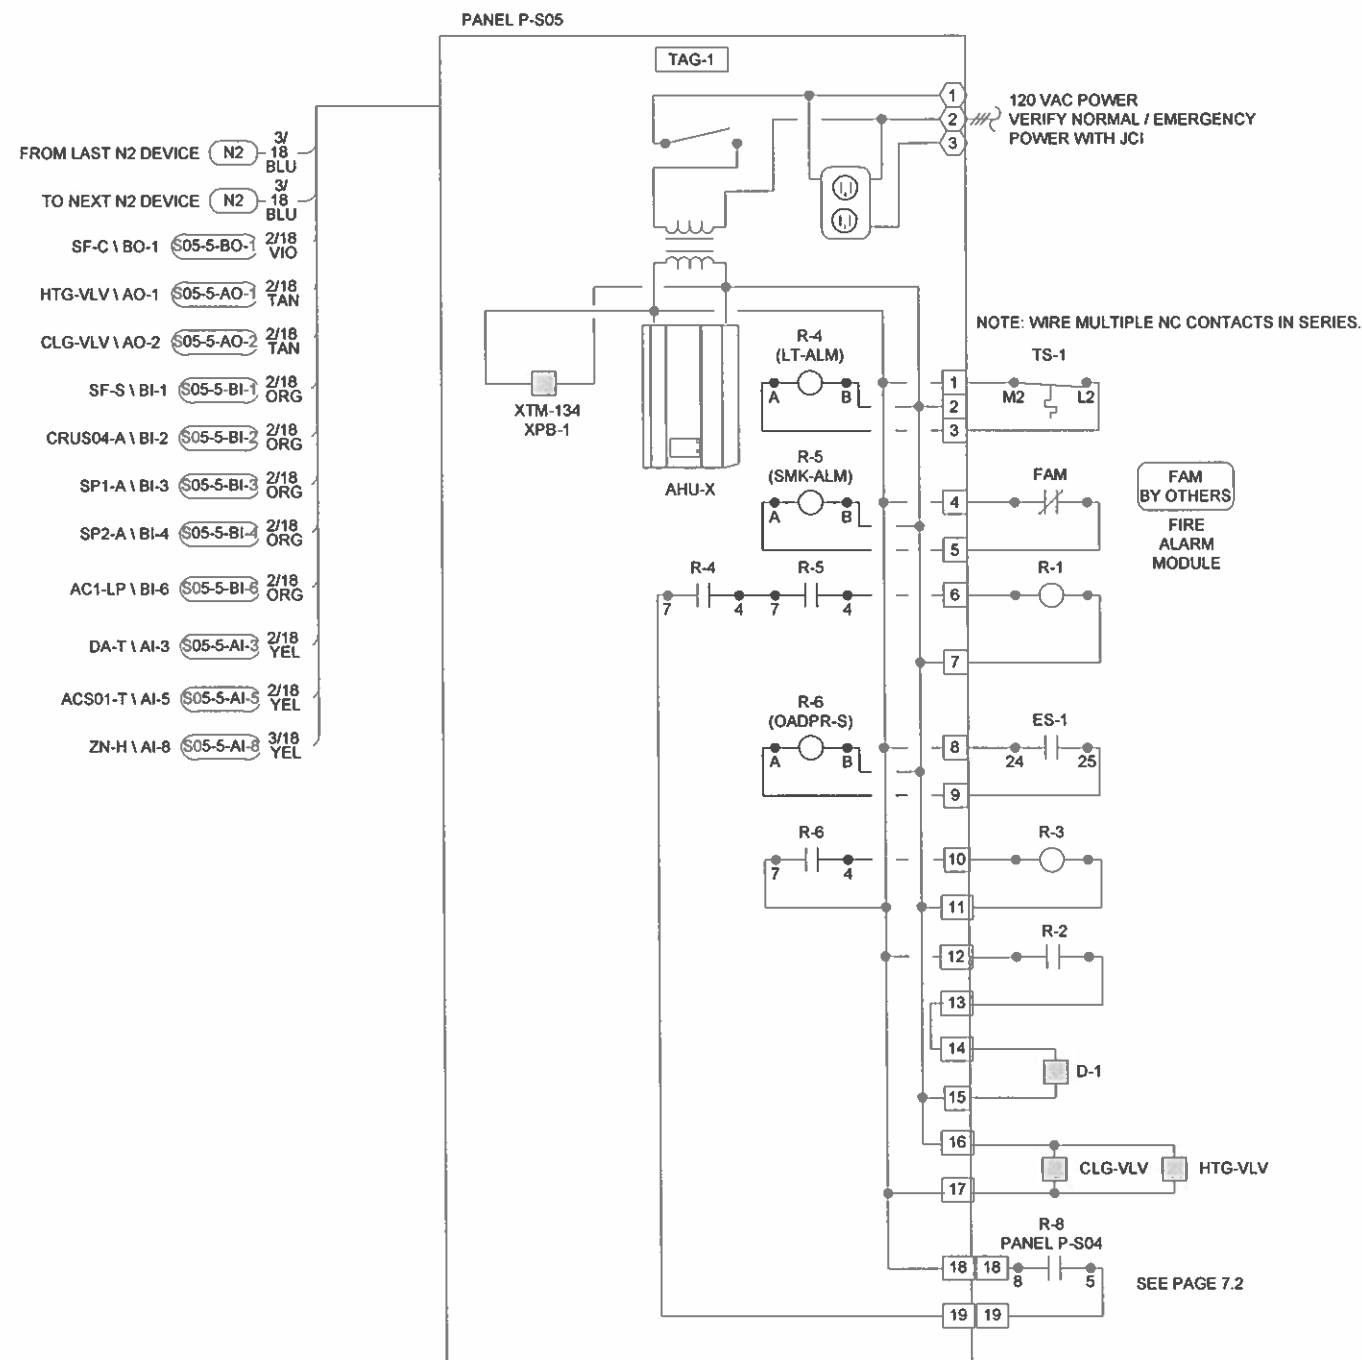


**PANEL FACE TAGS:**  
 TAG-1: PANEL P-S05  
 AH-S05  
 JCI 9 8075-0508


REVISION INFORMATION	Drawing Title				
NUMBER	AH-S05 PANEL				
DATE	04/12/01	REFERENCE DRAWING	NO	REVISION-LOCATION	ECH DATE BY
TIME	08:52 AM	Sales Engineer	Project Manager	Application Engineer	BY DATE APPROVED
FILE NAME	ahs05p.vsd	PJS	TP	KJK	BY MLR DATE
	Project Title	Branch Information			CONTRACT NUMBER
	MILLER PARK ONE BREWERS WAY MILWAUKEE, WI 53214	JOHNSON CONTROLS Systems & Services Division Wisconsin Area Office 529 N. Jackson Street Milwaukee WI 53202 Phone: 414-524-7500 Fax: 414-524-7575			9 8075-0508
					DRAWING NUMBER
					8.2

AH-S05

**Multi-zone Constant Volume 100%OA Air Handling System**

1. The air handling unit is equipped with supply fan, heating coil, cooling coil, pre-filter and final filter.
2. The air handling unit supply fan and associated exhaust fans will be energized through the EMCS on a scheduled basis.
3. The chilled and hot water control valves will modulate in sequence to maintain the discharge air temperature. The discharge air temperature will be reset based on the operation of the zone reheat coil control valves and room humidity.
4. Upon morning start-up of the occupied mode, mechanical cooling will be locked out, the heating control valve will fully open.
5. Smoke detectors located in the supply and exhaust ducts will on detection of smoke shut down the air handler supply fan and associated exhaust fan via a hard-wire interlock with fan starters. Smoke detector status will be indicated at the EMCS.
6. Filter replacement will be scheduled based on supply fan runtime.
7. Current switches will be located on the feed to the supply fan to provide status indication (on/off). In off hours DDC controller will command the chilled water two-way control valve and outside air damper to a fully closed position, hot water control valve to the fully open position.
8. The EMCS will monitor and control all points for each air handling unit.
9. End switches will be provided on all outside air dampers. Hard-wire the end switches into the safety circuit of the supply fan starter.
10. Each zone sensor or group of zone sensors modulate the reheat coil hot water control valve to satisfy the required room temperature. See the Reheat Coil sequence of operation.
11. In off hours, the supply fan will be cycled intermittently at night by the zone sensor to maintain 60°F.

REVISION INFORMATION	Drawing Title								
NUMBER	SEQUENCE								
DATE	04/12/01	REFERENCE DRAWING	NO.	REVISION-LOCATION	ECN	DATE	BY		
TIME	08:57 AM	Basics Engineer	Project Manager	Application Engineer					
FILE NAME	ahs05s.vsc	PJS	TP	KJK	BY	MLR	DATE	BY	DATE
	Project Title				Branch Information Wisconsin Area Office 529 N. Jackson Street Milwaukee WI 53202 Phone: 414-524-7500 Fax: 414-524-7575			CONTRACT NUMBER <b>9 8075-0508</b>	
	MILLER PARK ONE BREWERS WAY MILWAUKEE, WI 53214	Systems & Services Division						DRAWING NUMBER <b>8.3</b>	

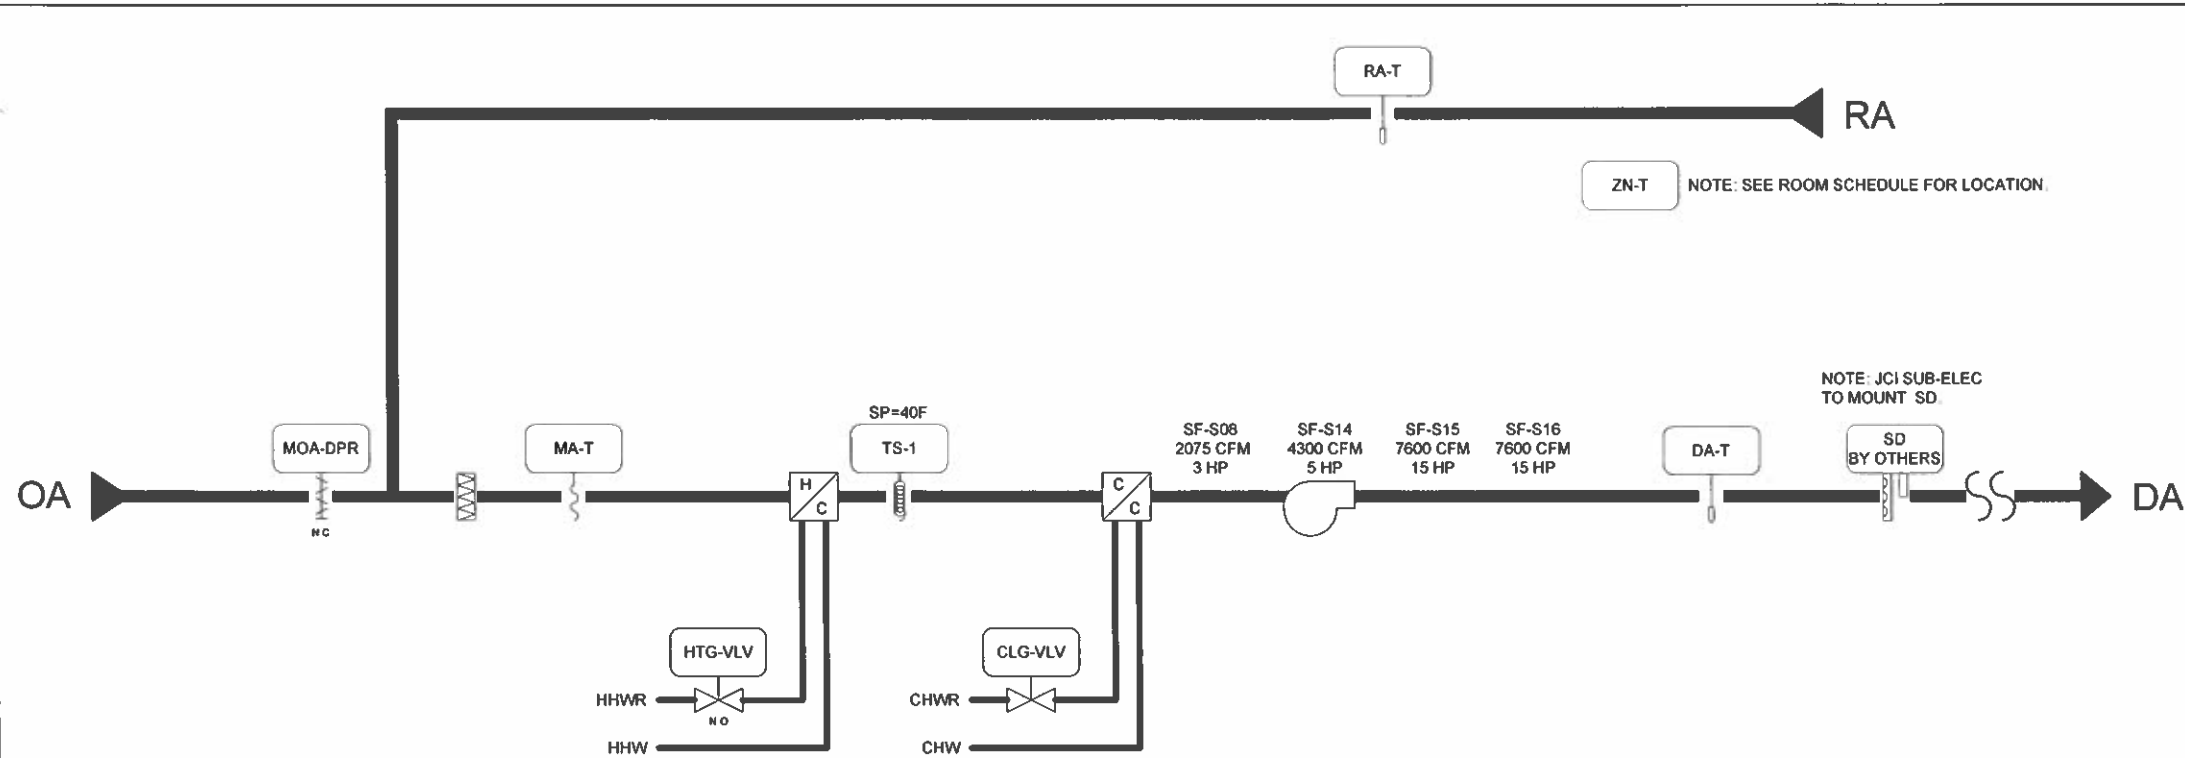


**BILL OF MATERIALS**

Designation	Qty	Part Number	Description
<b>Field Devices:</b>			
DA-T, RA-T	2	TE-6311P-1	SENS, T-NI, 0.1%, 8" DUCT
MA-T	1	TE-6316P-1	SENS, T-NI, 0.1%, 17" AVG
MOA-DPR	0		SEE DAMPER SCHEDULE
R-1	1	CVR-21C-O	RLY 2SPDT, 10-30VAC/DC OR 120VAC LED @ LEC
SF-C, SF-S	1	H-735	SW, CURRENT, 1-135A CMND RLY SOLID @ VER
TS-1	1	A70HA-1C	STAT, LL, 20' EL, MAN, 1.5/55F
	1	TE-6001-8	CLIP F/AVG ELEM (10/PKG)
X-VLV	0		SEE VALVE SCHEDULE
ZN-T	1	TE-6314P-1	SENS, T-NI, 0.1%, RM
<b>Panel Devices:</b>			
P-X	1	EN-EWC35-0	TRIPLE ENCLOSURE WITH 100VA POWER
R-3-R-4	2	PD-101-35	RLY BASE, 3PDT, 11PIN, 10A
	2	PD-109-51	RELAY PLUG-IN 3PDT 24VAC
TAG-1	1	M-8000-393	NAMEPLT, LAMICOID, 3 LINE
UNT-X	1	AS-UNT141-1	UNT CNTRL 6AI 4BI 6BO 2AO W/O ENCL SCREW

ZN-T NOTE: SEE ROOM SCHEDULE FOR LOCATION.


NOTE: JCI SUB-ELEC TO MOUNT SD.

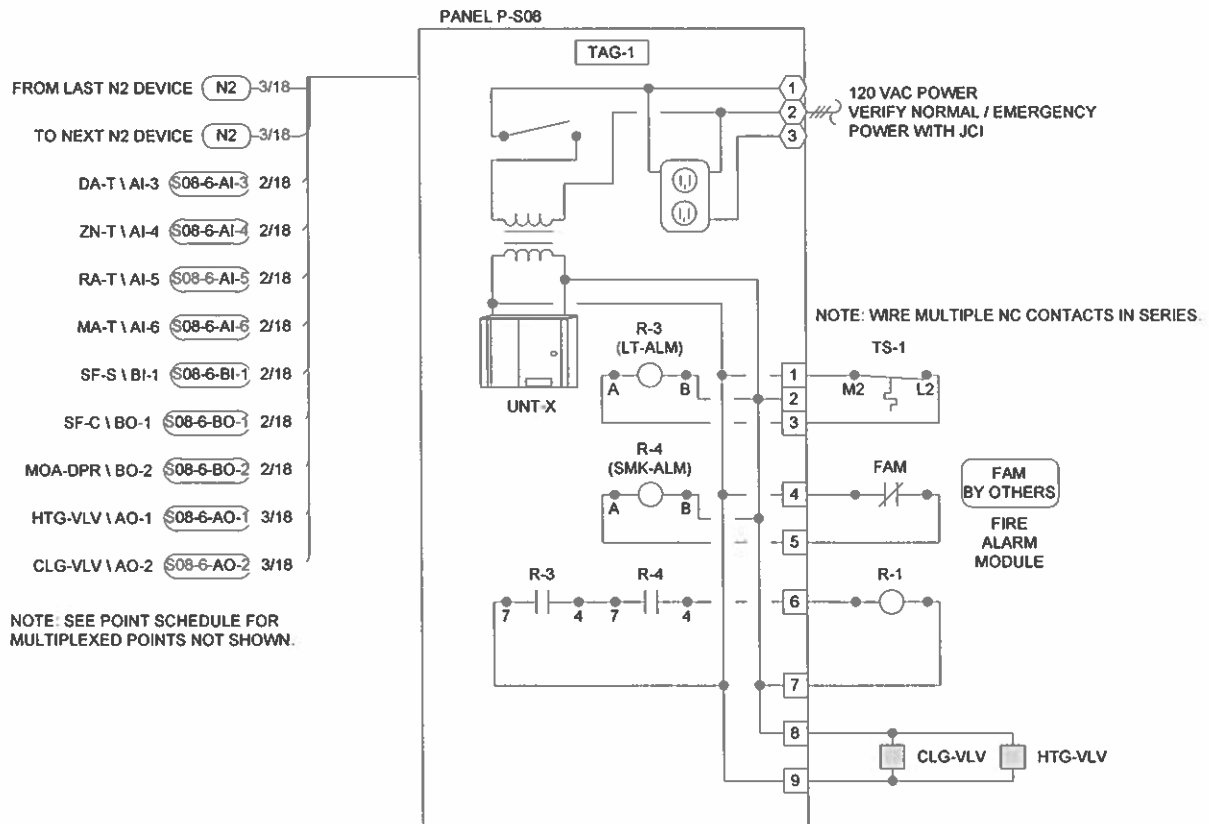

- FROM LAST N2 DEVICE (N2) 3/18
- TO NEXT N2 DEVICE (N2) 3/18
- DA-T \ AI-3 (S08-6-AI-3) 2/18
- ZN-T \ AI-4 (S08-6-AI-4) 2/18
- RA-T \ AI-5 (S08-6-AI-5) 2/18
- MA-T \ AI-6 (S08-6-AI-6) 2/18
- SF-S \ BI-1 (S08-6-BI-1) 2/18
- SF-C \ BO-1 (S08-6-BO-1) 2/18
- MOA-DPR \ BO-2 (S08-6-BO-2) 2/18
- HTG-VLV \ AO-1 (S08-6-AO-1) 3/18
- CLG-VLV \ AO-2 (S08-6-AO-2) 3/18

NOTE: SEE POINT SCHEDULE FOR MULTIPLEXED POINTS NOT SHOWN.

- PANEL FACE TAGS: TAG-1: PANEL P-S08 AH-S08 JCI 9 8075-0508
- PANEL FACE TAGS: TAG-1: PANEL P-S14 AH-S14 JCI 9 8075-0508
- PANEL FACE TAGS: TAG-1: PANEL P-S15 AH-S15 JCI 9 8075-0508
- PANEL FACE TAGS: TAG-1: PANEL P-S16 AH-S16 JCI 9 8075-0508

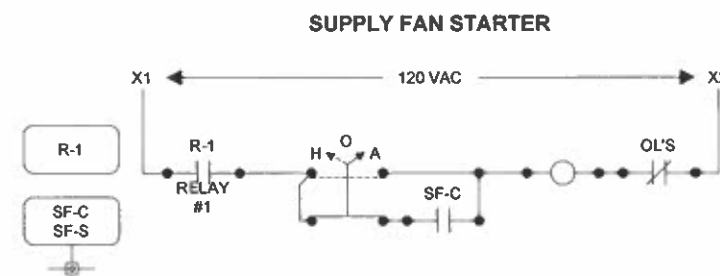


REVISION INFORMATION	Drawing Title						
	NUMBER	AH-S08 FLOW TYPICAL FOR AH-S14, AH-S15, AH-S16					
DATE	04/12/01	REFERENCE DRAWING	NO.	REVISION-LOCATION	ECN	DATE	BY
TIME	09:04 AM	Sales Engineer	Project Manager	Application Engineer	By	DATE	APPROVED
FILENAME	ahs08f.vsd	PJS	TP	KJK	MLR		
Project Title		Branch Information		CONTRACT NUMBER			
MILLER PARK ONE BREWERS WAY MILWAUKEE, WI 53214		Wisconsin Area Office 529 N Jackson Street Milwaukee WI 53202 Phone: 414-524-7500 Fax: 414-524-7575		9 8075-0508			
		JOHNSON CONTROLS Systems & Services Division		DRAWING NUMBER		9.1	

**AH-S08, AH-S14, AH-S15, AH-S16**



**Single-zone Constant Volume MASP Air Handling System with Minimum Outside Air**

1. The air handling unit is equipped with supply fan, heating coil, cooling coil, pre-filter, final filter and minimum outside air damper.
2. The air handling unit supply fan will be energized through the EMCS on a scheduled basis.
3. No economizer controller is provided.
4. Unless in the warm-up cycle, the controller will verify that the air handling unit is running via a fan proof of flow controller and open the outside air damper to the minimum required ventilation position.
5. No economizer controller is provided.
6. Upon morning start-up of the occupied mode, mechanical cooling will be locked out, the heating coil control valve will fully open, and the outside air damper will move to the closed position, and any interlocked exhaust fans will be de-energized. When the return air temperature reaches the warm-up setpoint, the air handlers will return to normal operation. Provide all relays, solenoids and wiring required to lock out warm-up during normal occupancy hours.
7. The chilled water control valve will modulate in sequence with the heating coil control valve to maintain the discharge air temperature. The discharge air temperature setpoint will be reset based on room temperature.
8. Smoke detectors located in the supply and return ducts will on detection of smoke shut down the air handler supply fan via a hard-wire interlock with fan starters. Smoke detector status will be indicated at the EMCS.
9. Filter replacement will be scheduled based on supply fan runtime.
10. Current switches will be located on the feed to the supply fan to provide status indication (on/off). In off hours DDC controller will command the chilled water two-way control valve and outside air damper to a fully closed position, heating coil control valve to fully open position.
11. The EMCS will monitor and control all points for each air handling unit.
12. In off hours, the supply fan will be cycled intermittently at night by the zone sensor to maintain 60°F.

REVISION INFORMATION	Drawing Title								
NUMBER	SEQUENCE								
DATE	04/12/01	REFERENCE DRAWING	NO	REVISION LOCATION	ECH	DATE	BY		
TIME	09:07 AM	Sales Engineer	Project Manager	Application Engineer	BY	MLR	DATE	APPROVED	DATE
FILE NAME	ahs08s.vsd	PJS	TP	KJK					
	Project Title	MILLER PARK ONE BREWERS WAY MILWAUKEE, WI 53214				Branch Information Wisconsin Area Office 529 N. Jackson Street Milwaukee WI 53202 Phone: 414-524-7500 Fax: 414-524-7575		CONTRACT NUMBER	9 8075-0508
				Systems & Services Division				DRAWING NUMBER	9.2

**BILL OF MATERIALS**


Designation	Qty	Part Number	Description
<b>Field Devices:</b>			
D-1, ES-1	0	DAMPER	SEE DAMPER SCHEDULE
DA-T	1	TE-6311P-1	SENS,T-NI,0.1%,8" DUCT
R-1-R-3	3	CVR-21C-O	RLY 2SPDT,10-30VAC/DC OR 120VAC,LED @LEC
SF-C,SF-S	1	H-735	SW, CURRENT, 1-135A CMND RLY SOLID @VER
TS-1	1	A70HA-1C	STAT,LL,20",EL,MAN,15/55F
	1	TE-6001-8	CLIP F/AVG ELEM (10/PKG)
X-VLV	0	VALVE	SEE VALVE SCHEDULE
ZN-T	1	TE-6314P-1	SENS,T-NI,0.1%,RM

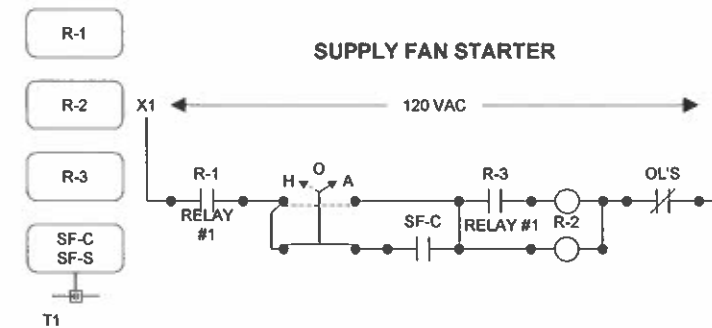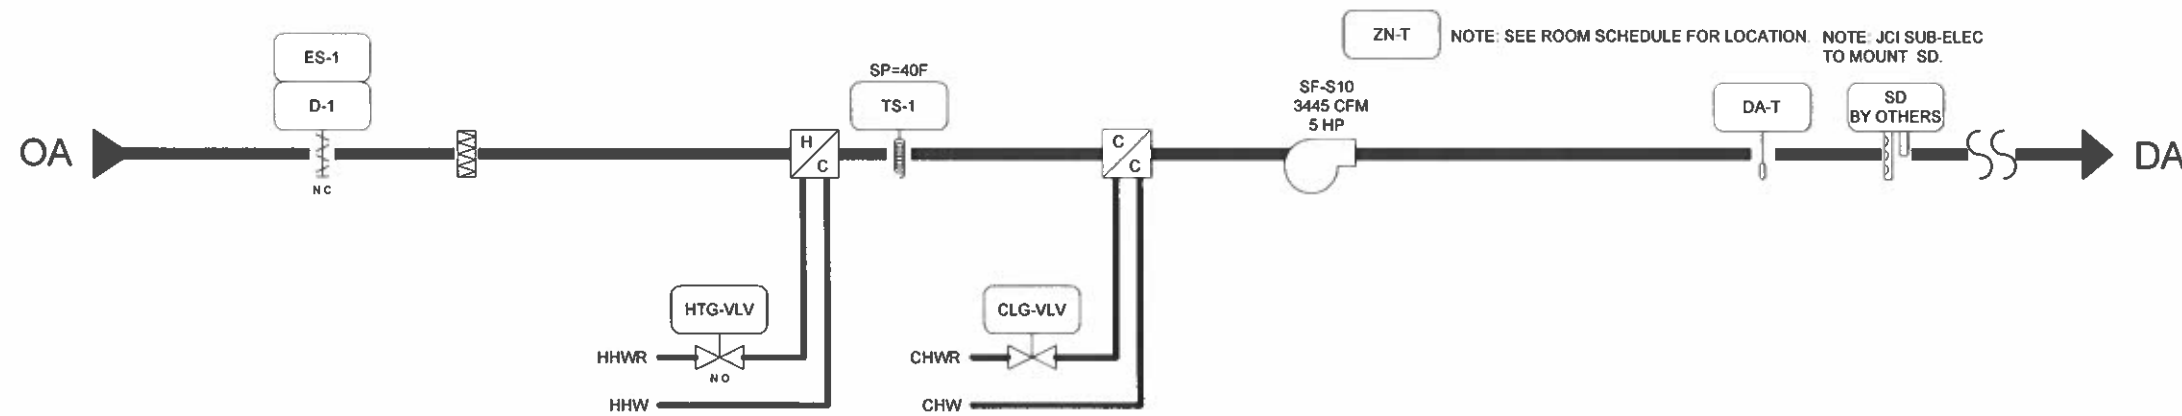

<b>REVISION INFORMATION</b> NUMBER DATE TIME FILE NAME ahs10f.vsd	Drawing Title <b>AH-S10 FLOW</b>							
	Project Title <b>MILLER PARK          ONE BREWERS WAY          MILWAUKEE, WI 53214</b>	<b>JOHNSON          CONTROLS</b> Systems & Services Division		Wisconsin Area Office 529 N. Jackson Street Milwaukee WI 53202 Phone: 414-524-7500 Fax: 414-524-7575		<b>9 8075-0508</b> DRAWING NUMBER <b>10.1</b>		
	REFERENCE DRAWING NO. PJS TP KJK	REVISION-LOCATION DATE BY MLR	DATE BY	DATE BY	DATE BY	DATE BY	DATE BY	DATE BY
	CONTRACT NUMBER <b>9 8075-0508</b>							

**BILL OF MATERIALS**

Designation	Qty	Part Number	Description
Panel Devices:			
P-X	1	EN-EWC35-0	TRIPLE ENCLOSURE WITH 100VA POWER
R-4-R-6	3	PD-101-35	RLY BASE,3PDT,11PIN,10A
	3	PD-109-51	RELAY PLUG-IN 3PDT 24VAC
TAG-1	1	M-8000-393	NAMEPLT,LAMICOID,3 LINE
UNT-X	1	AS-UNT141-1	UNT CNTRL 6AI 4BI 6BO 2AO W/O ENCL SCREW

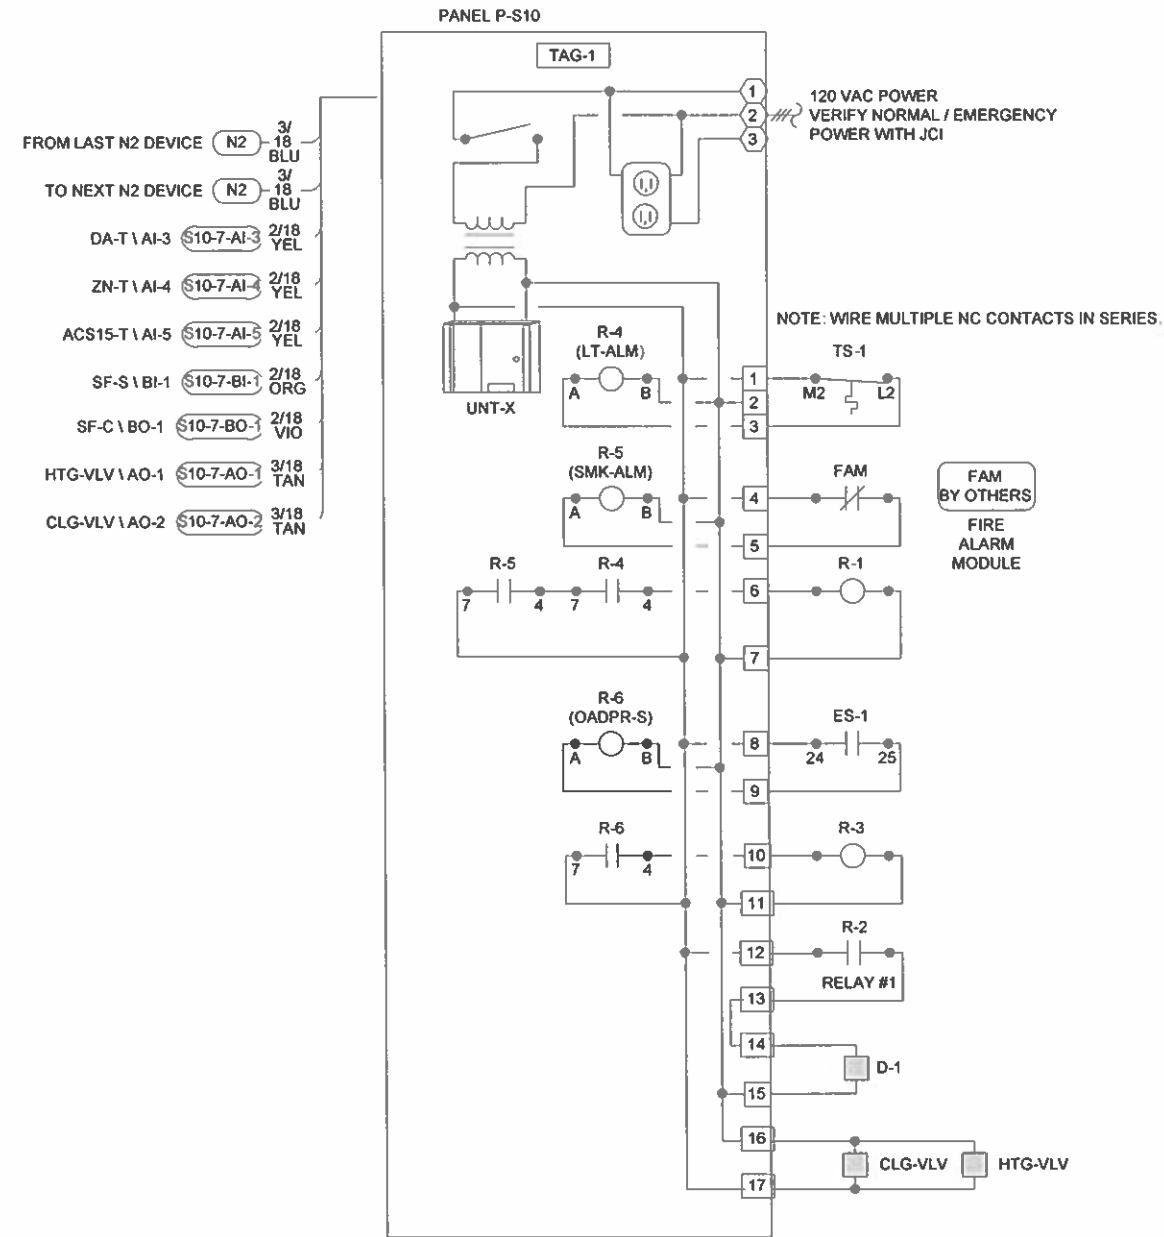


PANEL FACE TAGS:  
 TAG-1 PANEL P-S10  
 AH-S10  
 JCI 9 8075-0508

REVISION INFORMATION	Drawing Title								
NUMBER	AH-S10 PANEL								
DATE	04/12/01	REFERENCE DRAWING	NO.	REVISION-LOCATION	ETN	DATE	BY		
TIME	09:19 AM	Sales Engineer	Project Manager	Application Engineer	BY	MLR	DATE	APPROVED	
FILE NAME	ahs10p.vsd	PJS	TP	KJK					
	Project Title	Branch Information			CONTRACT NUMBER				
	MILLER PARK ONE BREWERS WAY MILWAUKEE, WI 53214	<b>JOHNSON CONTROLS</b> Systems & Services Division			Wisconsin Area Office 529 N. Jackson Street Milwaukee WI 53202 Phone: 414-524-7500 Fax: 414-524-7575		<b>9 8075-0508</b> DRAWING NUMBER <b>10.2</b>		

AH-S10

Single-zone Constant Volume 100%OA Air Handling System


1. The air handling unit is equipped with supply fan, heating coil, cooling coil, pre-filter and final filter.
2. The air handling unit supply fan and associated exhaust fans will be energized through the EMCS on a scheduled basis.
3. The chilled and hot water control valves will modulate in sequence to maintain the discharge air temperature. The discharge air temperature setpoint is reset based on room temperature.
4. Upon morning start-up of the occupied mode, mechanical cooling will be locked out, the heating control valve will fully open.
5. Smoke detectors located in the supply and exhaust ducts will on detection of smoke shut down the air handler supply fan and associated exhaust fan via a hard-wire interlock with fan starters. Smoke detector status will be indicated at the EMCS.
6. Filter replacement will be scheduled based on supply fan runtime.
7. Current switches will be located on the feed to the supply fan to provide status indication (on/off). In off hours DDC controller will command the chilled water two-way control valve and outside air damper to a fully closed position, hot water control valve to the fully open position.
8. The EMCS will monitor and control all points for each air handling unit.
9. End switches will be provided on all outside air dampers. Hard-wire the end switches into the safety circuit of the supply fan starter.
10. In off hours, the supply fan will be cycled intermittently at night by the zone sensor to maintain 60°F.

REVISION INFORMATION	Drawing Title								
NUMBER	SEQUENCE								
DATE	04/12/01	REFERENCE DRAWING	NO.	REVISION LOCATION	ECN	DATE	BY		
TIME	09:22 AM	Sales Engineer	Project Manager	Application Engineer	BY	MLR	DATE	BY	DATE
FILE NAME	ahs10s.vsd	PJS	TP	KJK					
	Project Title	MILLER PARK ONE BREWERS WAY MILWAUKEE, WI 53214			 Systems & Services Division		Branch Information Wisconsin Area Office 529 N. Jackson Street Milwaukee WI 53202 Phone: 414-524-7500 Fax: 414-524-7575		CONTRACT NUMBER <b>9 8075-0508</b>  DRAWING NUMBER <b>10.3</b>



**BILL OF MATERIALS**

Designation	Qty	Part Number	Description
Panel Devices:			
P-X	1	EN-EWC35-0	TRIPLE ENCLOSURE WITH 100VA POWER
R-4-R-6	3	PD-101-35	RLY BASE, 3PDT, 11PIN 10A
	3	PD-109-51	RELAY PLUG-IN 3PDT 24VAC
TAG-1	1	M-8000-393	NAMEPLT, LAMICOID, 3 LINE
UNT-X	1	AS-UNT141-1	UNT CNTRL 6AI 4BI 6BO 2AO W/O ENCL SCREW

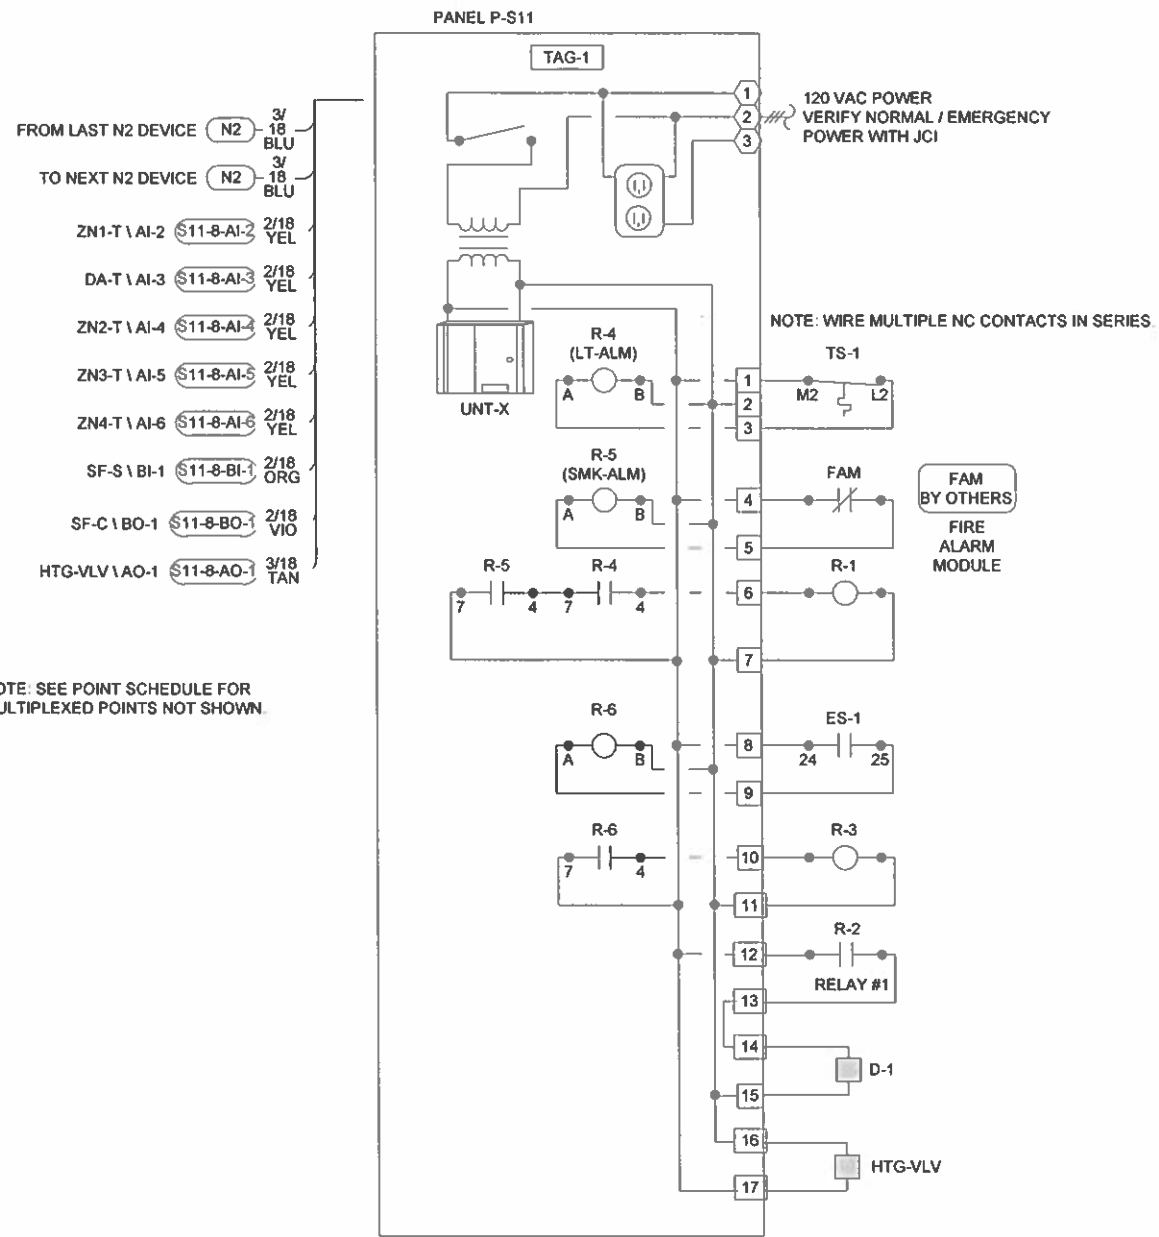



**PANEL FACE TAGS:**  
TAG-1: PANEL P-S11 AH-S11 JCI 9 8075-0508

**PANEL FACE TAGS:**  
TAG-1: PANEL P-S12 AH-S12 JCI 9 8075-0508

REVISION INFORMATION	Drawing Title				
NUMBER	<b>AH-S11 PANEL TYPICAL FOR AH-S12</b>				
DATE	04/12/01	REFERENCE DRAWING	NO.	REVISION-LOCATION	ECH DATE BY
TIME	09:29 AM	Sales Engineer	Project Manager	Application Engineer	DRAWN
FILE NAME	ahs11p.vsd	PJS	TP	KJK	BY MLR DATE
Project Title		Branch Information		CONTRACT NUMBER	
<b>MILLER PARK ONE BREWERS WAY MILWAUKEE, WI 53214</b>		<b>JOHNSON CONTROLS</b> Wisconsin Area Office 529 N. Jackson Street Milwaukee WI 53202 Phone: 414-524-7500 Fax: 414-524-7575		<b>9 8075-0508</b>	
		Systems & Services Division		DRAWING NUMBER <b>11.2</b>	

**BILL OF MATERIALS**

Designation	Qty	Part Number	Description
Field Devices:			
D-1, ES-1	0	DAMPER	SEE DAMPER SCHEDULE
DA-T	1	TE-6316P-1	SENS.T-NI,0.1%,17' AVG
R-1-R-3	3	CVR-21C-O	RLY 2SPDT,10-30VAC/DC OR 120VAC.LED @LEC
SF-C SF-S	1	H-735	SW, CURRENT, 1-135A CMND RLY SOLID @VER
TS-1	4	A70HA-1C	STAT,LL 20',EL,MAN,15/55F
	1	TE-6001-8	CLIP F/AVG ELEM (10/PKG)
X-VLV	0	VALVE	SEE VALVE SCHEDULE
ZNx-T	4	TE-6314P-1	SENS.T-NI,0.1%,RM

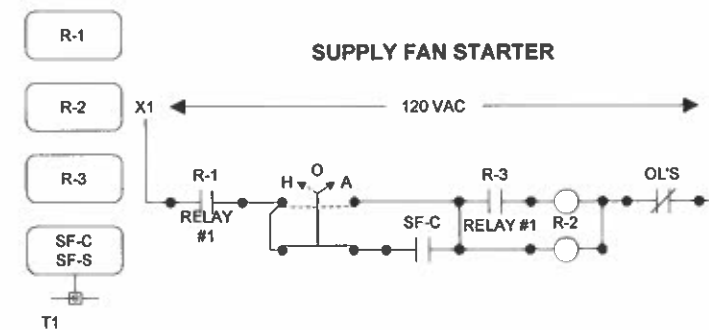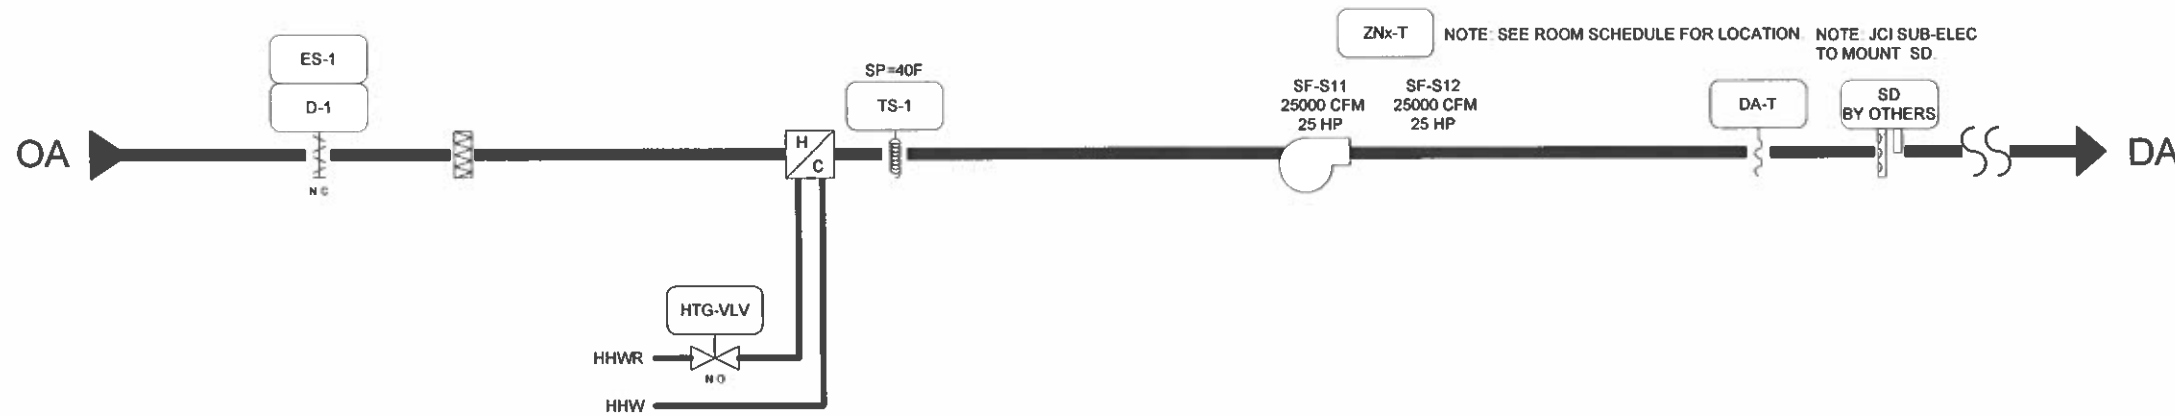


REVISION INFORMATION	Drawing Title						
NUMBER	AH-S11 FLOW TYPICAL FOR AH-S12						
DATE	04/12/01	REFERENCE DRAWING	NO	REVISION-LOCATION	E/CN	DATE	BY
TIME	09:30 AM	Sales Engineer	PJS	Project Manager	TP	Application Engineer	KJK
FILE NAME	ahs11f.vsd	BY	MLR	DATE	BY	DATE	APPROVED
	Project Title	Branch Information				CONTRACT NUMBER	
	MILLER PARK ONE BREWERS WAY MILWAUKEE, WI 53214	Wisconsin Area Office 529 N. Jackson Street Milwaukee WI 53202 Phone: 414-524-7500 Fax: 414-524-7575				9 8075-0508	
		Systems & Services Division				DRAWING NUMBER	
						11.1	

AH-S11, AH-S12



Service Tunnel Ventilation

1. The tunnel exhaust and supply fans will be interlocked to ensure that they always operate at the same time. Provide the CO gas detection system.
2. The fans will be energized through the EMCS based on CO sensors located in the tunnel, reading a preset CO level. Simultaneously, the outside air and exhaust air dampers will open. The heating hot water valve will modulate to maintain a space temperature of 55°F +/- 5°F.
3. The CO will be overridden should the space temperature in the tunnel fall below 50°F as determined by any one of four temperature sensors.
4. Upon a call for heating, the outside air and exhaust air dampers will open, the fans will be energized and the heating hot water valve will be fully open. The system will continue to operate until a space temperature of 60°F is detected by all temperature sensors.
5. Smoke detectors located in the supply and exhaust ducts will on detection of smoke shut down the fans via a hard-wire interlock with the fan starters. Smoke detectors will indicate status at EMCS.
6. Filter replacement will be scheduled based on supply fan runtime.
7. Current switches will be located on the feed to the fans to provide status indication.
8. If the supply fan starter switch is in the Hand position, a hard-wired solenoid will open the outside air damper fully, and when the dampers fully open as proven from the end switch, the supply fan will energize. Hard-wire the damper end switch into the safety side of the fan motor starter to prevent the fan from energizing from the EMCS or the Hand position of the starter, unless the end switch is closed.
9. Furnish and install the CO detection system. Monitor the status of the CO alarm on the EMCS.

REVISION INFORMATION	Drawing Title								
NUMBER	SEQUENCE								
DATE		REFERENCE DRAWING	NO.	REVISION-LOCATION	ECH	DATE	BY		
04/12/01		Sales Engineer	Project Manager	Application Engineer					
		PJS	TP	KJK	BY	MLR	DATE	BY	DATE
TIME	Project Title	Branch Information		CONTRACT NUMBER					
09:48 AM	MILLER PARK ONE BREWERS WAY MILWAUKEE, WI 53214			Wisconsin Area Office 529 N. Jackson Street Milwaukee WI 53202 Phone: 414-524-7500 Fax: 414-524-7575		<b>9 8075-0508</b>			
FILE NAME		Systems & Services Division		DRAWING NUMBER					
ahs11s.vsd				<b>11.3</b>					

**BILL OF MATERIALS**

Designation	Qty	Part Number	Description
<b>Field Devices:</b>			
D-1, ES-1	0	DAMPER	SEE DAMPER SCHEDULE
DA-T	1	TE-6315P-1	SENS,T-NI,0.1%,8' AVG
R-1-R-3	3	CVR-21C-O	RLY 2SPDT,10-30VAC/DC OR 120VAC,LED @LEC
SF-C,SF-S	1	H-735	SW, CURRENT, 1-135A CMND RLY SOLID @VER
TS-1	2	A70HA-1C	STAT,LL,20',EL,MAN,15/55F
	1	TE-6001-8	CLIP F/AVG ELEM (10/PKG)
X-VLV	0	VALVE	SEE VALVE SCHEDULE
ZN-H	1	HE-6300-2	XMTR,RH/T-NI,WALL,AC/DC

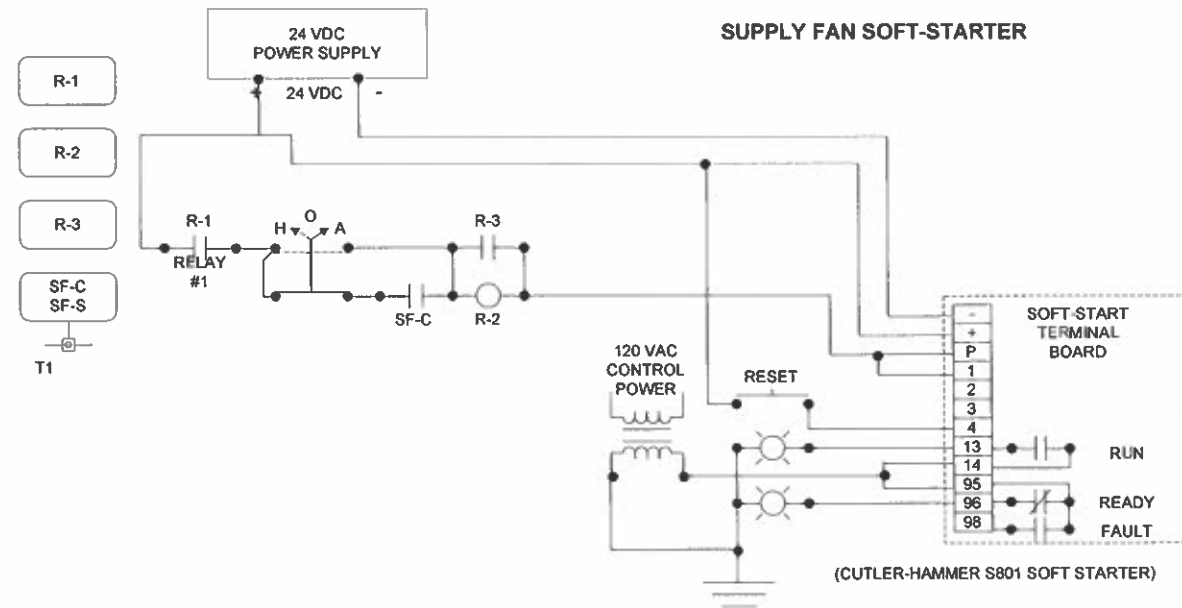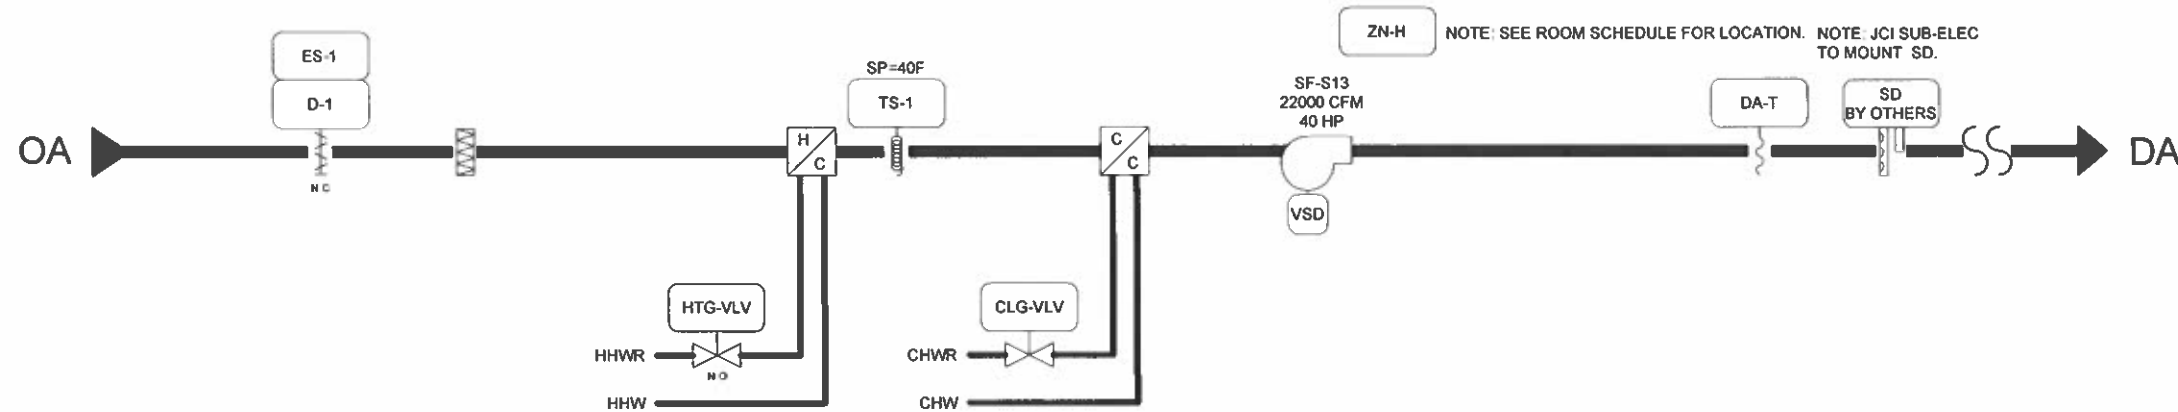


Pilot lights were changed from "On" and "Off" to "Run" and "Ready" when Soft-Starter was installed

REVISION INFORMATION	Drawing Title				
NUMBER	AH-S13 FLOW	Soft Starter Added	2003-14	2003 SRF Project	DAM
DATE	11/06/09	REFERENCE DRAWING	NO	REVISION-LOCATION	ECH DATE BY
TIME	09:12 AM	Sales Engineer	PJS	Project Manager	TP
FILE NAME	ahs13f-SS4.vsd	Application Engineer	KJK	DATE	DATE
Project Title		BY MLR		DATE	APPROVED
MILLER PARK ONE BREWERS WAY MILWAUKEE, WI 53214		DATE		DATE	DATE
JOHNSON CONTROLS Systems & Services Division		Branch Information		CONTRACT NUMBER	
		Wisconsin Area Office 529 N. Jackson Street Milwaukee WI 53202 Phone: 414-524-7500 Fax: 414-524-7575		9 8075-0508	
				DRAWING NUMBER	
				12.1	

**BILL OF MATERIALS**

Designation	Qty	Part Number	Description
Panel Devices:			
P-X	1	EN-EWC35-0	TRIPLE ENCLOSURE WITH 100VA POWER
R-4-R-6	3	PD-101-35	RLY BASE,3PDT,11PIN,10A
	3	PD-109-51	RELAY PLUG-IN 3PDT 24VAC
TAG-1	1	M-8000-393	NAMEPLT,LAMICOID,3 LINE
UNT-X	1	AS-UNT141-1	UNT CNTRL 6AI 4BI 6BO 2AO W/O ENCL SCREW

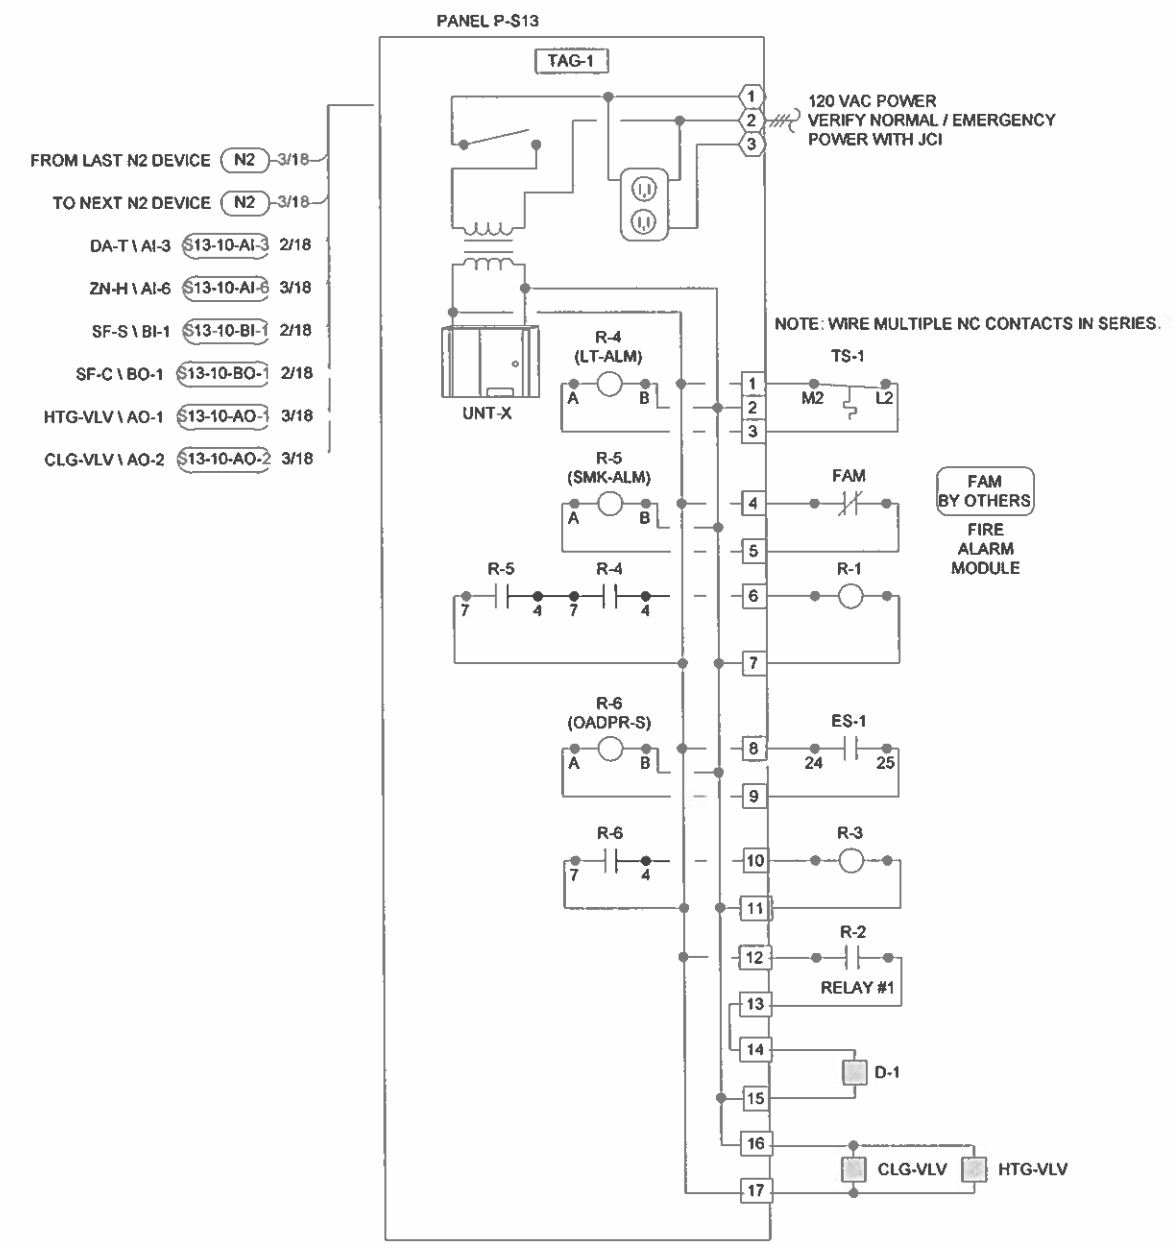

- FROM LAST N2 DEVICE (N2) 3/18
- TO NEXT N2 DEVICE (N2) 3/18
- DA-T1 AI-3 (S13-10-AI-3) 2/18
- ZN-H1 AI-6 (S13-10-AI-6) 3/18
- SF-S1 BI-1 (S13-10-BI-1) 2/18
- SF-C1 BO-1 (S13-10-BO-1) 2/18
- HTG-VLV1 AO-1 (S13-10-AO-1) 3/18
- CLG-VLV1 AO-2 (S13-10-AO-2) 3/18


PANEL FACE TAGS:  
 TAG-1 PANEL P-S13  
 AH-S13  
 JCI 9 8075-0508


REVISION INFORMATION	Drawing Title				
NUMBER	AH-S13 PANEL				
DATE	04/12/01	REFERENCE DRAWING	NO	REVISION-LOCATION	ECH DATE BY
TIME	09:57 AM	Sales Engineer	Project Manager	Application Engineer	BY DATE
FILE NAME	ahs13p.vsd	PJS	TP	KJK	MLR DATE
Project Title		Branch Information		CONTRACT NUMBER	
MILLER PARK ONE BREWERS WAY MILWAUKEE, WI 53214		Wisconsin Area Office 529 N. Jackson Street Milwaukee WI 53202 Phone: 414-524-7500 Fax: 414-524-7575		9 8075-0508	
		Systems & Services Division		DRAWING NUMBER	
				12.2	

AH-S13

**Single-zone Constant Volume MASP Air Handling System with Minimum Outside Air**


1. The air handling unit is equipped with supply fan, heating coil, cooling coil, pre-filter, final filter and minimum outside air damper.
2. The air handling unit supply fan will be energized through the EMCS on a scheduled basis.
3. No economizer controller is provided.
4. Unless in the warm-up cycle, the controller will verify that the air handling unit is running via a fan proof of flow controller and open the outside air damper to the minimum required ventilation position.
5. No economizer controller is provided.
6. Upon morning start-up of the occupied mode, mechanical cooling will be locked out, the heating coil control valve will fully open, and the outside air damper will move to the closed position, and any interlocked exhaust fans will be de-energized. When the return air temperature reaches the warm-up setpoint, the air handlers will return to normal operation. Provide all relays, solenoids and wiring required to lock out warm-up during normal occupancy hours.
7. The chilled water control valve will modulate in sequence with the heating coil control valve to maintain the discharge air temperature. The discharge air temperature setpoint will be reset based on room temperature.
8. Smoke detectors located in the supply and return ducts will on detection of smoke shut down the air handler supply fan via a hard-wire interlock with fan starters. Smoke detector status will be indicated at the EMCS.
9. Filter replacement will be scheduled based on supply fan runtime.
10. Current switches will be located on the feed to the supply fan to provide status indication (on/off). In off hours DDC controller will command the chilled water two-way control valve and outside air damper to a fully closed position, heating coil control valve to fully open position.
11. The EMCS will monitor and control all points for each air handling unit.
12. In off hours, the supply fan will be cycled intermittently at night by the zone sensor to maintain 60°F.

REVISION INFORMATION	Drawing Title								
NUMBER	SEQUENCE								
DATE		REFERENCE DRAWING	NO.	REVISION LOCATION	ECH	DATE	BY		
04/12/01		Sales Engineer	Project Manager	Application Engineer					
TIME	Project Title	PJS	TP	KJK	BY	MLR	DATE	BY	DATE
10:01 AM	MILLER PARK ONE BREWERS WAY MILWAUKEE, WI 53214								
FILE NAME				Wisconsin Area Office 529 N. Jackson Street Milwaukee WI 53202 Phone: 414-524-7500 Fax: 414-524-7575		CONTRACT NUMBER <b>9 8075-0508</b>		DRAWING NUMBER <b>12.3</b>	
ahs13s.vsd									


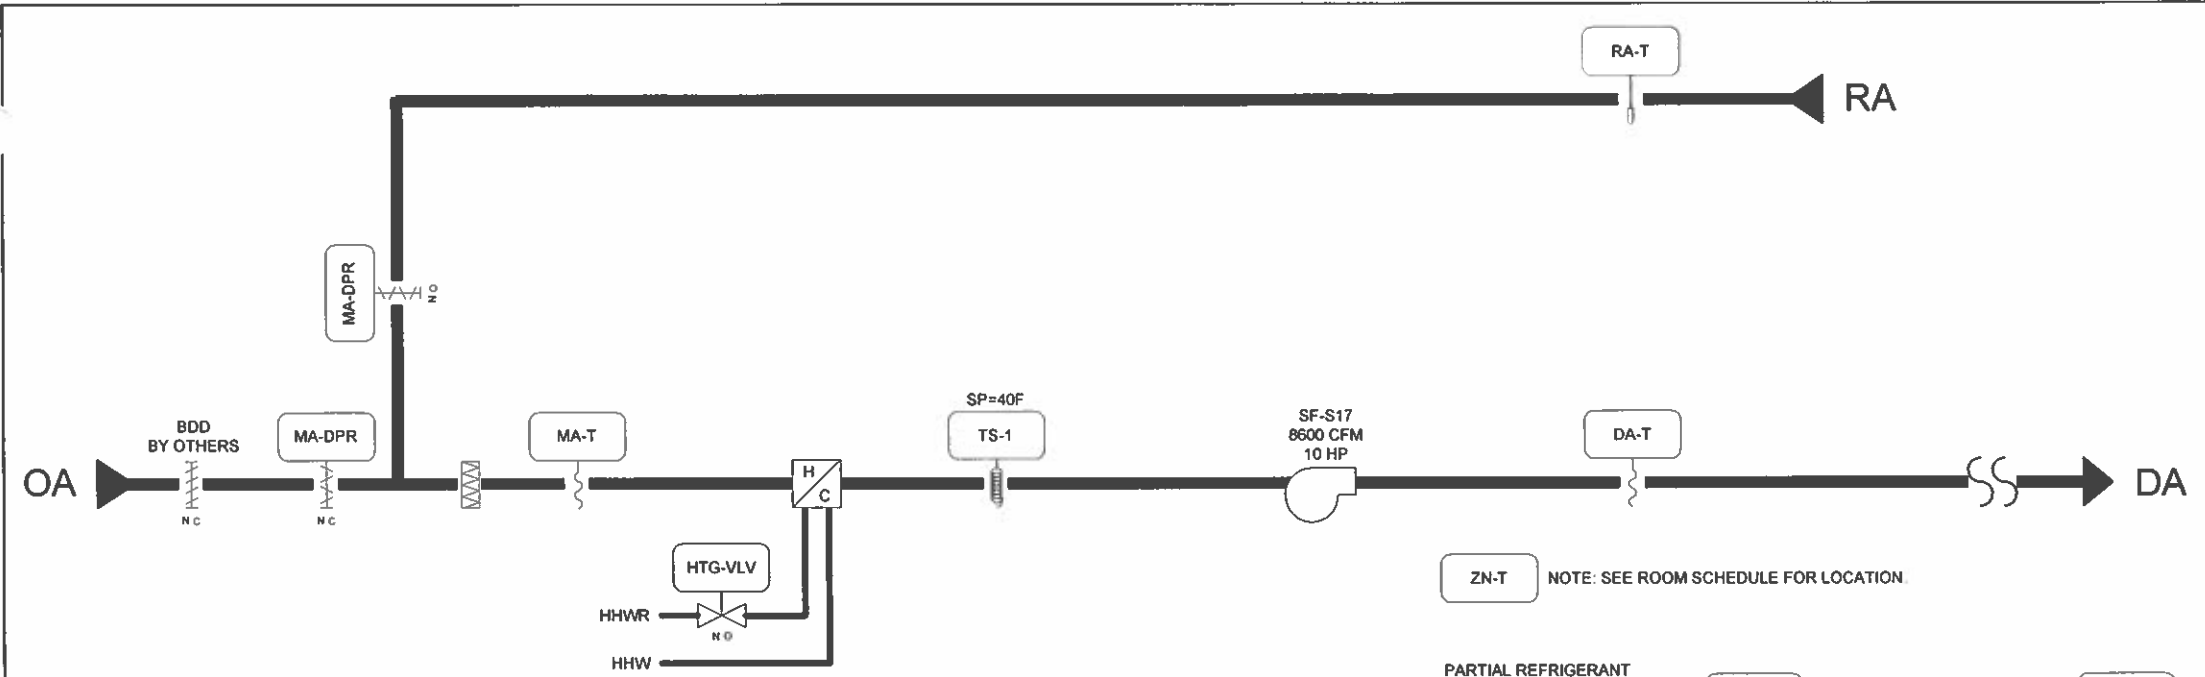


**BILL OF MATERIALS**

Designation	Qty	Part Number	Description
<b>Field Devices:</b>			
AOVx-S	1	ZB2BG0	KEY OPERATOR - SQD
	1	ZB2BY2002	LEGEND PLATE - SQD
	1	ZB2BZ103	CONTACT BLOCK 2 NO - SQD
BG-S	1	800T-N28	BREAK GLASS SPARES - AB
	1	800T-NX114	BREAK GLASS SWITCH - AB
	1	800T-X559E	LEGEND PLATE - AB
DA-T, MA-T	2	TE-6315P-1	SENS,T-Ni,0.1%,8" AVG
MA-T, TS-1	1	TE-6001-8	CLIP F/AVG ELEM (10/PKG)
R-1	1	CVR-21C-0	RLY 2SPDT,10-30VAC/DC OR 120VAC,LED @LEC
RA-T	1	TE-6311P-1	SENS,T-Ni,0.1%,8" DUCT
SF-C,CS-1	1	H-735	SW, CURRENT, 1-135A CMND RLY SOLID @VER
TAG-2	1	M-8000-391	NAMEPLT,LAMICOID,1 LINE
TS-1	1	A70HA-1C	STAT,LL,20",EL,MAN,15/55F
X-DPR	0		SEE DAMPER SCHEDULE
X-DPR, X-VLV	3	PD-101-1	RESISTOR, 4990HM 1/2W 1%
X-VLV	0		SEE VALVE SCHEDULE
ZN-T	1	TE-6314P-1	SENS,T-Ni,0.1%,RM
<b>Panel Devices:</b>			
AHU-X	1	AS-AHU103-300	AHU TERMINATION BD/ELECTRONICS IN EWC35
P-X	1	EN-EXP101-0	EXPANSION COVER AND BACKBONE
R-3,4,6	3	PD-101-35	RLY BASE,3PDT,11PIN,10A
	3	PD-109-51	RELAY PLUG-IN 3PDT 24VAC
TAG-1	1	M-8000-393	NAMEPLT,LAMICOID,3 LINE

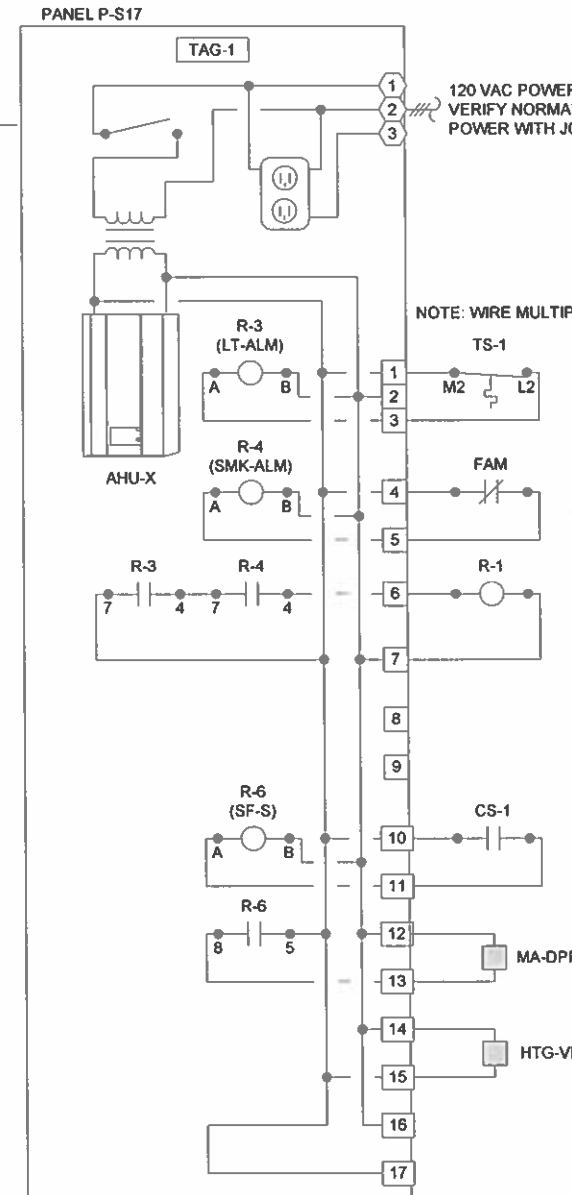

- FROM LAST N2 DEVICE (N2) 3/18 BLU
- TO NEXT N2 DEVICE (N2) 3/18 BLU
- SF-C \ BO-1 (S17-14-BO-1) 2/18 VIO
- MA-DPR \ AO-1 (S17-14-AO-1) 2/18 TAN
- HTG-VLV \ AO-3 (S17-14-AO-3) 2/18 TAN
- SP15-A \ BI-2 (S17-14-BI-2) 2/18 ORG
- AOV1-S \ BI-3 (S17-14-BI-3) 2/18 ORG
- AOV2-S \ BI-4 (S17-14-BI-4) 2/18 ORG
- BG-S \ BI-5 (S17-14-BI-5) 2/18 ORG
- REF-ALM \ BI-6 (S17-14-BI-6) 2/18 ORG
- MA-T \ AI-2 (S17-14-AI-2) 2/18 YEL
- DA-T \ AI-3 (S17-14-AI-3) 2/18 YEL
- ZN-T \ AI-4 (S17-14-AI-4) 2/18 YEL
- RA-T \ AI-5 (S17-14-AI-5) 2/18 YEL

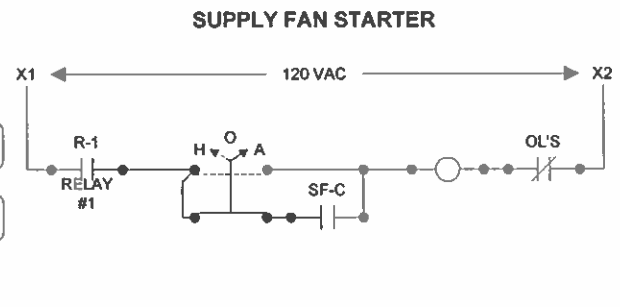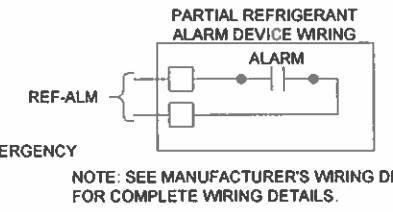

PANEL FACE TAGS:  
TAG-1: PANEL P-S17 AH-S17  
JCI 9 8075-0508

REVISION INFORMATION	Drawing Title				
NUMBER	AH-S17 FLOW	1		RECORD DRAWINGS	6/14/2001 MLR
DATE	06/14/01	REFERENCE DRAWING	NO	REVISION/LOCATION	E/CN DATE BY
TIME	10:39 AM	Sales Engineer	Project Manager	Application Engineer	DATE
FILE NAME	ahs17f.vsd	PJS	TP	KJK	DATE
Project Title		Branch Information		CONTRACT NUMBER	
MILLER PARK ONE BREWERS WAY MILWAUKEE, WI 53214		 Systems & Services Division Wisconsin Area Office 529 N Jackson Street Milwaukee WI 53202 Phone: 414-524-7500 Fax: 414-524-7575		<b>9 8075-0508</b> DRAWING NUMBER <b>13.1</b>	


AH-S17

**Chiller Room Ventilation**

1. Upon the activation of the refrigeration equipment the air handling unit will be energized from the EMCS. This will mean that the supply fan will start and the outside air damper will move to its minimum position.
2. The hot water valve, outside and return dampers will modulate to maintain space temperature. The heating hot water valve will only modulate open should the space temperature fall below 50°F.
3. Upon the activation of the refrigerant leak detection system, an audible and visual alarm will be raised outside the chiller room. At the same time the exhaust fan will be energized from an interlock to the refrigerant alarm contact, and the outside air damper will move to a fully open position from the EMCS. The fan will continue to run until the alarm has been manually reset.
4. Provide an emergency break glass switch located outside the refrigeration equipment room which will upon activation actuate the exhaust fan and move the outside air damper to a fully open position. The fan will continue to run until the switch has been manually reset.
5. Removed per Brewers Operations.
6. Provide a manual key operated "AUTO-OFF-VENT" switch that will also be provided for the exhaust fan, supply fan and outside air damper.
7. Current switches located on the feed to the fans will provide status indication.
8. Filter replacement will be scheduled based on supply fan runtime.
9. The "AUTO-OFF-VENT" switch will have the first priority of control with the emergency break glass switch having second priority. The refrigerant leak detection system will have the lowest priority of control when the "AUTO-OFF-VENT" switch is in "AUTO" and the emergency break glass switch is in the normal position.



REVISION INFORMATION	Drawing Title								
NUMBER	SEQUENCE		1	RECORD DRAWINGS					MLR
DATE		REFERENCE DRAWING	NO.	REVISION-LOCATION	ECN	DATE	BY		
06/14/01		Sales Engineer	Project Manager	Application Engineer					
		PJS	TP	KJK					
TIME	Project Title	DRAWN		APPROVED		DATE		CONTRACT NUMBER	
10:46 AM	MILLER PARK ONE BREWERS WAY MILWAUKEE, WI 53214	BY MLR		BY		DATE		9 8075-0508	
FILE NAME		Branch Information		DRAWING NUMBER					
ahs17a.vsd		JOHNSON CONTROLS Systems & Services Division		Wisconsin Area Office 529 N. Jackson Street Milwaukee WI 53202 Phone: 414-524-7500 Fax: 414-524-7575				13.2	



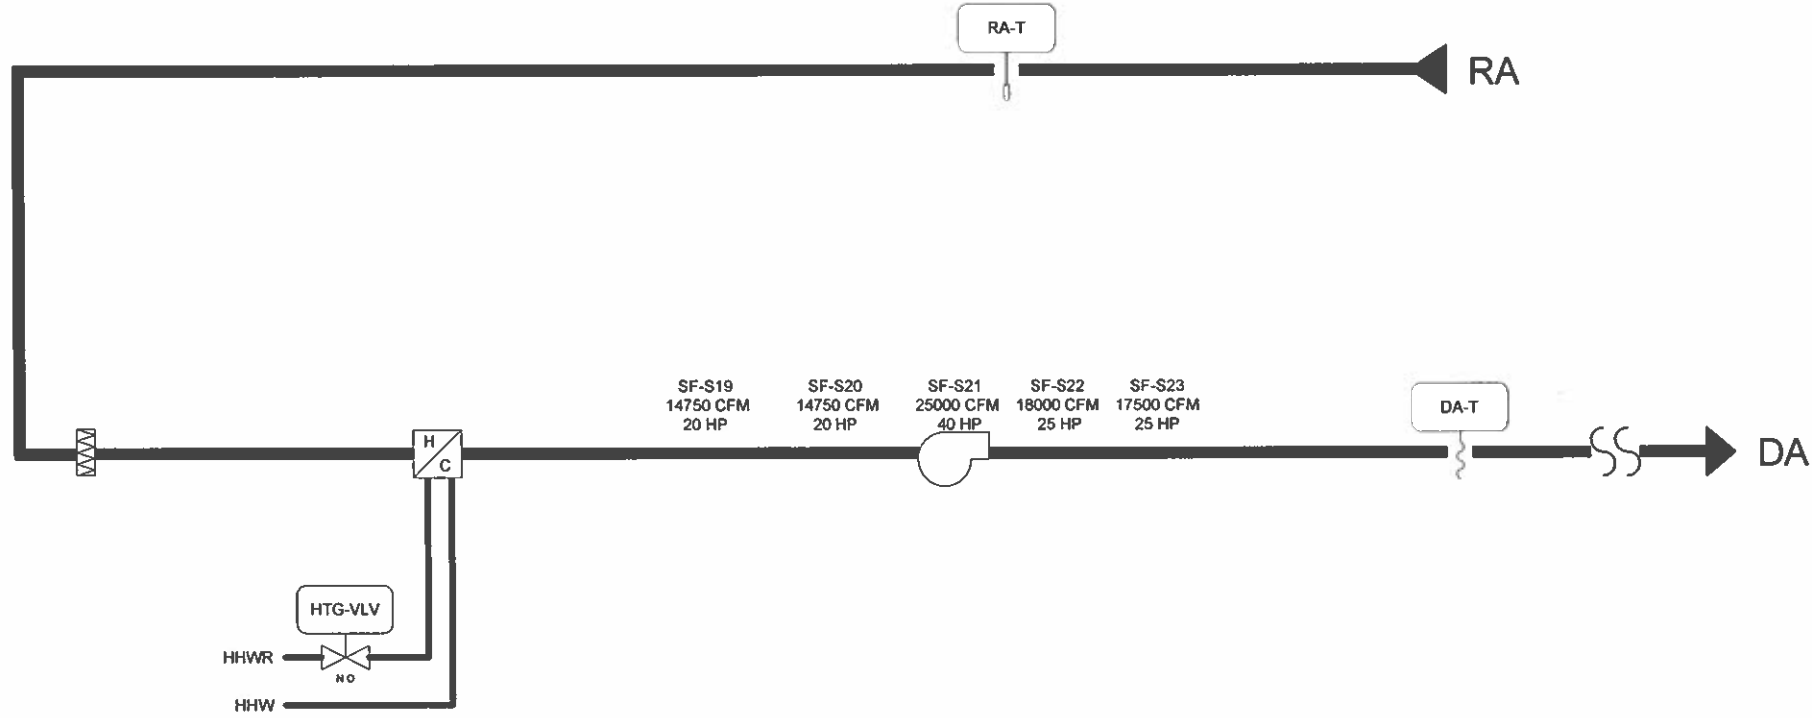

**BILL OF MATERIALS**

Designation	Qty	Part Number	Description
<b>Field Devices:</b>			
DA-T	1	TE-6001-8	CLIP F/AVG ELEM (10/PKG)
	1	TE-6315P-1	SENS.T-NI,0.1%,8" AVG
R-1	1	CVR-21C-O	RLY 2SPDT,10-30VAC/DC OR 120VAC,LED @LEC
RA-T	1	TE-6311P-1	SENS.T-NI,0.1%,8" DUCT
SF-C,SF-S	1	H-735	SW. CURRENT, 1-135A CMND RLY SOLID @VER
X-VLV	0	VALVE	SEE VALVE SCHEDULE
<b>Panel Devices:</b>			
P-X	1	EN-EWC35-0	TRIPLE ENCLOSURE WITH 100VA POWER
R-4	1	PD-101-35	RLY BASE,3PDT,11PIN,10A
	1	PD-109-51	RELAY PLUG-IN 3PDT 24VAC
TAG-1	1	M-8000-393	NAMEPLT,LAMICO,D.3 LINE
UNT-X	1	AS-UNT141-1	UNT CNTRL 6AI 4BI 6BO 2AO W/O ENCL SCREW

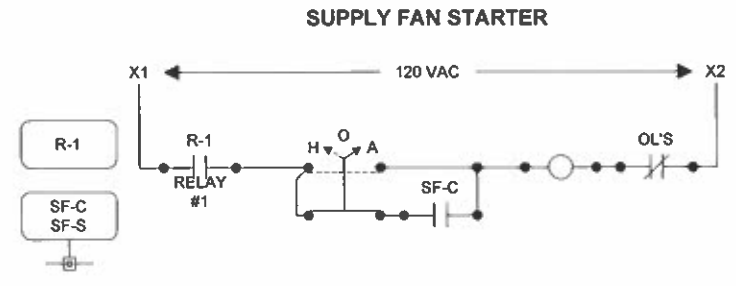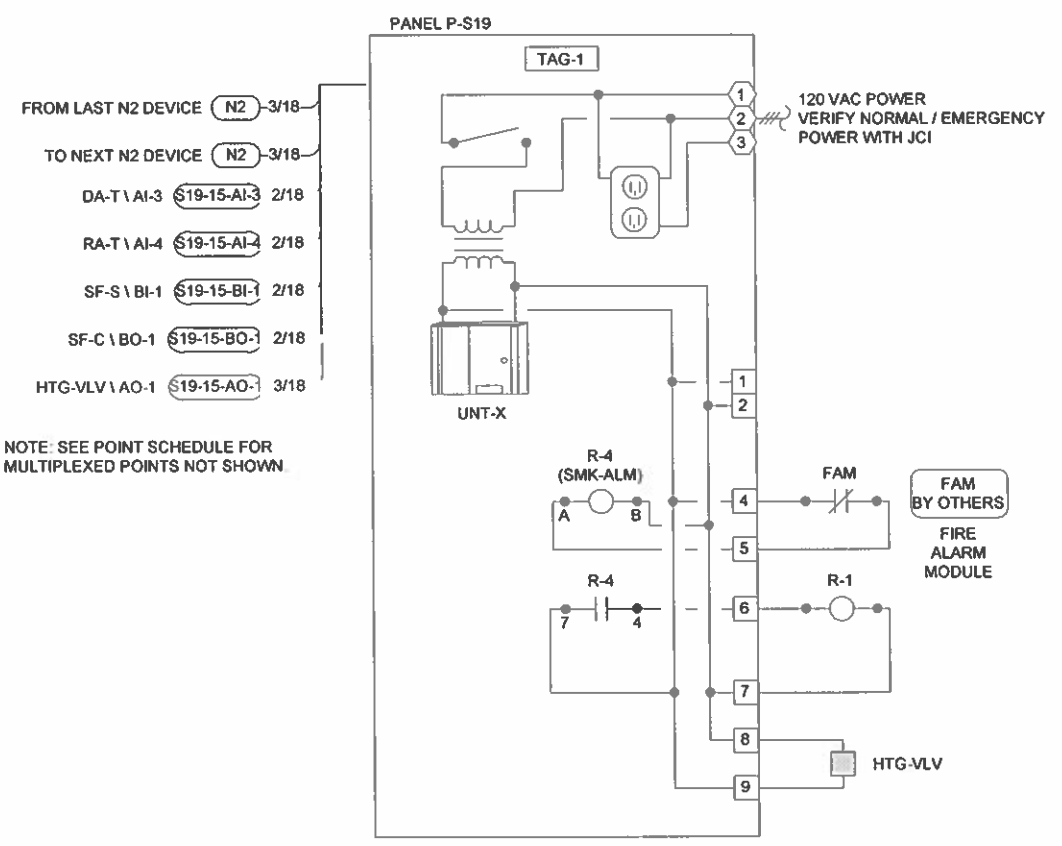


- PANEL FACE TAGS: TAG-1 PANEL P-S19 AH-S19 JCI 9 8075-0508
- PANEL FACE TAGS: TAG-1 PANEL P-S20 AH-S20 JCI 9 8075-0508
- PANEL FACE TAGS: TAG-1 PANEL P-S21 AH-S21 JCI 9 8075-0508
- PANEL FACE TAGS: TAG-1 PANEL P-S22 AH-S22 JCI 9 8075-0508
- PANEL FACE TAGS: TAG-1 PANEL P-S23 AH-S23 JCI 9 8075-0508


REVISION INFORMATION	Drawing Title						
	NUMBER	AH-S19 FLOW TYPICAL FOR AH-S20, AH-S21, AH-S22, AH-S23					
DATE	04/12/01	REFERENCE DRAWING	NO	REVISION-LOCATION	ECH	DATE	BY
TIME	10:23 AM	Sales Engineer	PJS	Project Manager	TP	Application Engineer	KJK
FILE NAME	ahs19f.vsd	Project Title		MILLER PARK ONE BREWERS WAY MILWAUKEE, WI 53214		Branch Information	
		JOHNSON CONTROLS Systems & Services Division		Wisconsin Area Office 529 N Jackson Street Milwaukee WI 53202 Phone: 414-524-7500 Fax: 414-524-7575		CONTRACT NUMBER	
						9 8075-0508	
						DRAWING NUMBER	
						14.1	

AH-S19, AH-S20, AH-S21, AH-S22, AH-S23

**Constant Volume 100%RA Air Handling System**



1. The air handling unit is equipped with supply fan, heating coil, pre-filter and final filter.
2. The air handling unit supply fan will be energized through the EMCS on a scheduled basis.
3. The hot water control valve will modulate to maintain the discharge air temperature. The discharge air temperature setpoint is reset based on return air temperature.
4. Smoke detectors located in the supply and return ducts will on detection of smoke shut down the air handler supply fan via a hard-wire interlock with fan starters. Smoke detector status will be indicated at the EMCS.
5. Filter replacement will be scheduled based on supply fan runtime.
6. Current switches will be located on the feed to the supply fan to provide status indication (on/off). In off hours DDC controller will command the hot water control valve to the fully open position.
7. The EMCS will monitor and control all points for each air handling unit.

REVISION INFORMATION	Drawing Title								
NUMBER	SEQUENCE								
DATE		REFERENCE DRAWING	NO	REVISION LOCATION	EIN	DATE	BY		
04/12/01		Sales Engineer	Project Manager	Application Engineer					
		PJS	TP	KJK	BY	MLR	DATE	BY	DATE
TIME	Project Title	Branch Information		CONTRACT NUMBER					
10:26 AM	MILLER PARK ONE BREWERS WAY MILWAUKEE, WI 53214			Wisconsin Area Office 529 N. Jackson Street Milwaukee WI 53202 Phone: 414-524-7500 Fax: 414-524-7575		<b>9 8075-0508</b>			
FILE NAME		Systems & Services Division		DRAWING NUMBER					
ahs19s.vsd				<b>14.2</b>					

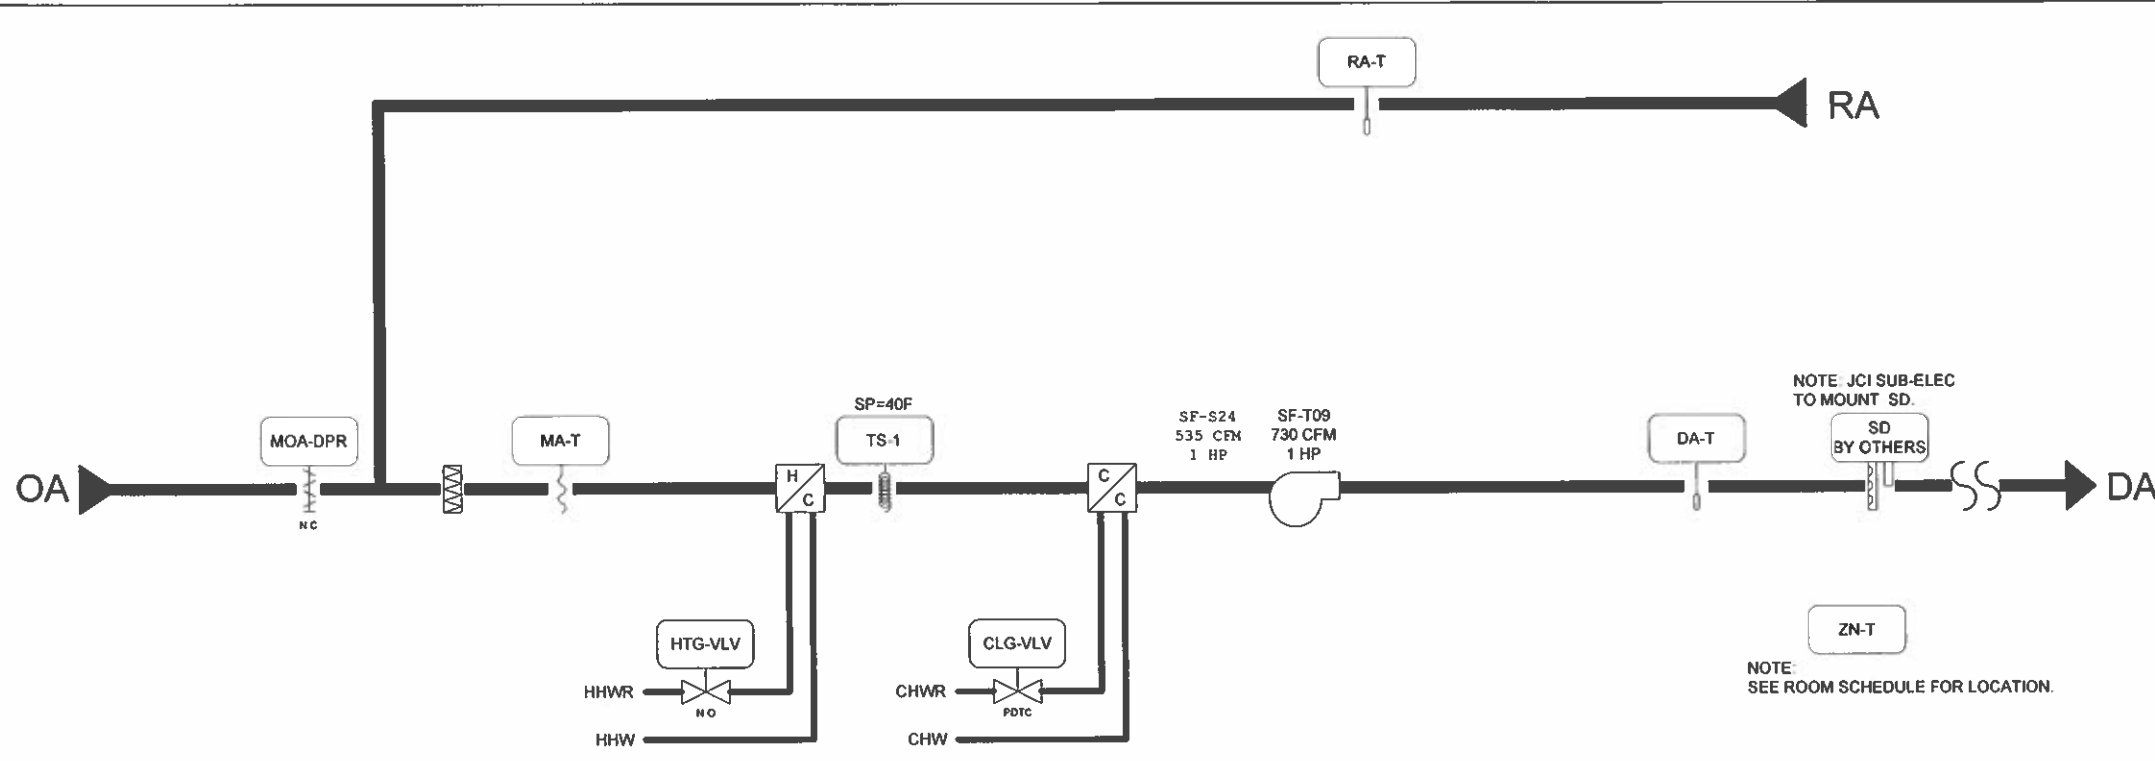

**BILL OF MATERIALS**

Designation	Qty	Part Number	Description
<b>Field Devices:</b>			
DA-T, RA-T	2	TE-6311P-1	SENS, T-Ni, 0.1%, 8" DUCT
MA-T	1	TE-6315P-1	SENS, T-Ni, 0.1%, 8" AVG
MA-T, TS-1	1	TE-8001-8	CLIP F/AVG ELEM (10/PKG)
MOA-DPR	0	DAMPER	SEE DAMPER SCHEDULE
R-1	1	CVR-21C-O	RLY 2SPDT, 10-30VAC/DC OR 120VAC, LED @ LEC
SF-C, SF-S	1	H-735	SW, CURRENT, 1-135A CMND RLY SOLID @ VER
TS-1	1	A70HA-1C	STAT, LL, 20', EL, MAN, 15/55F
X-VLV	0	VALVE	SEE VALVE SCHEDULE
ZN-T	1	TE-6314P-1	SENS, T-Ni, 0.1%, RM
<b>Panel Devices:</b>			
P-X	1	EN-EWC35-0	TRIPLE ENCLOSURE WITH 100VA POWER
R-3	1	PD-101-35	RLY BASE, 3PDT, 11PIN, 10A
	1	PD-109-51	RELAY PLUG-IN 3PDT 24VAC
TAG-1	1	M-8000-393	NAMEPLT, LAMICOID, 3 LINE
UNT-X	1	AS-UNT141-1	UNT CNTRL 6AI 4BI 6BO 2AO W/O ENCL SCREW
<b>P-T09 PANEL</b>			
<b>Panel Devices:</b>			
HTR-1	1	EN2-12-P-040-D	PANEL HEATER, 120VAC, ELECTRO-FLEX
P-T09	1	M-8100-2424	CONTROL CABINET, STD. FACE
R-3	1	PD-101-35	RLY BASE, 3PDT, 11PIN, 10A
	1	PD-109-51	RELAY PLUG-IN 3PDT 24VAC
TAG-1	1	M-8000-393	NAMEPLT, LAMICOID, 3 LINE
UNT-X	1	AS-UNT141-1	UNT CNTRL 6AI 4BI 6BO 2AO W/O ENCL SCREW

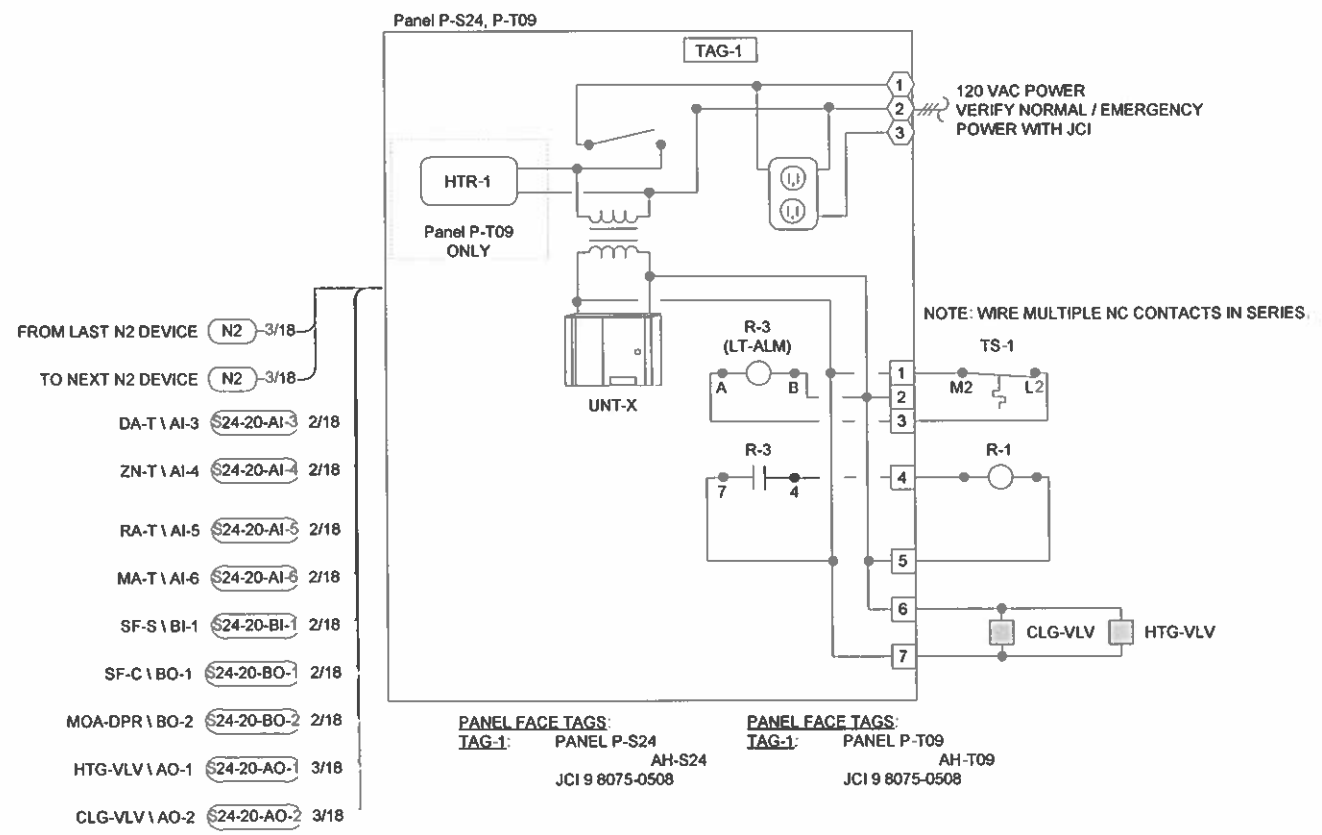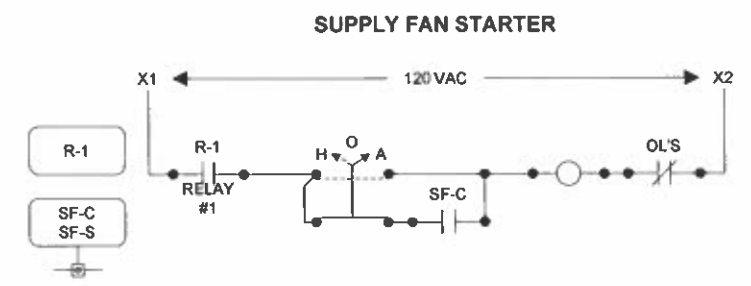


NOTE: SEE POINT SCHEDULE FOR MULTIPLEXED POINTS NOT SHOWN


REVISION INFORMATION	Drawing Title				
	NUMBER	1	RECORD DRAWING		MLR
DATE	06/14/01	REFERENCE DRAWING	NO	REVISION LOCATION	ECH DATE BY
TIME	10:49 AM	Sales Engineer	PJS	Project Manager	TP
FILE NAME	ahs24f.vsd	Application Engineer	KJK	BY	MLR
Project Title		DRAWN		APPROVED	
MILLER PARK ONE BREWERS WAY MILWAUKEE, WI 53214		DATE		DATE	
JOHNSON CONTROLS Systems & Services Division		Branch Information		CONTRACT NUMBER	
Wisconsin Area Office 529 N Jackson Street Milwaukee WI 53202 Phone: 414-524-7500 Fax: 414-524-7575				9 8075-0508	
				DRAWING NUMBER	
				15.1	

AH-S24, AH-T09

Single-zone Constant Volume MASP Air Handling System with Minimum Outside Air




1. The air handling unit is equipped with supply fan, heating coil, cooling coil, pre-filter, final filter and minimum outside air damper.
2. The air handling unit supply fan will be energized through the EMCS on a scheduled basis.
3. No economizer controller is provided.
4. Unless in the warm-up cycle, the controller will verify that the air handling unit is running via a fan proof of flow controller and open the outside air damper to the minimum required ventilation position.
5. No economizer controller is provided.
6. Upon morning start-up of the occupied mode, mechanical cooling will be locked out, the heating coil control valve will fully open, and the outside air damper will move to the closed position, and any interlocked exhaust fans will be de-energized. When the return air temperature reaches the warm-up setpoint, the air handlers will return to normal operation. Provide all relays, solenoids and wiring required to lock out warm-up during normal occupancy hours.
7. The chilled water control valve will modulate in sequence with the heating coil control valve to maintain the discharge air temperature. The discharge air temperature setpoint will be reset based on room temperature.
8. No smoke detectors will be provided.
9. Filter replacement will be scheduled based on supply fan runtime.
10. Current switches will be located on the feed to the supply fan to provide status indication (on/off). In off hours DDC controller will command the chilled water two-way control valve and outside air damper to a fully closed position, heating coil control valve to fully open position.
11. The EMCS will monitor and control all points for each air handling unit.
12. In off hours, the supply fan will be cycled intermittently at night by the zone sensor to maintain 60°F.

REVISION INFORMATION	Drawing Title								
NUMBER	SEQUENCE								
DATE	04/12/01	REFERENCE DRAWING	NO.	REVISION-LOCATION	ECN	DATE	BY		
TIME	10:37 AM	Sales Engineer	Project Manager	Application Engineer	BY	MLR	DATE	BY	DATE
FILE NAME	ahs24s.vsd	PJS	TP	KJK					
	Project Title				Branch Information Wisconsin Area Office 529 N. Jackson Street Milwaukee WI 53202 Phone: 414-524-7500 Fax: 414-524-7575		CONTRACT NUMBER <b>9 8075-0508</b>		
	MILLER PARK ONE BREWERS WAY MILWAUKEE, WI 53214	Systems & Services Division					DRAWING NUMBER <b>15.2</b>		

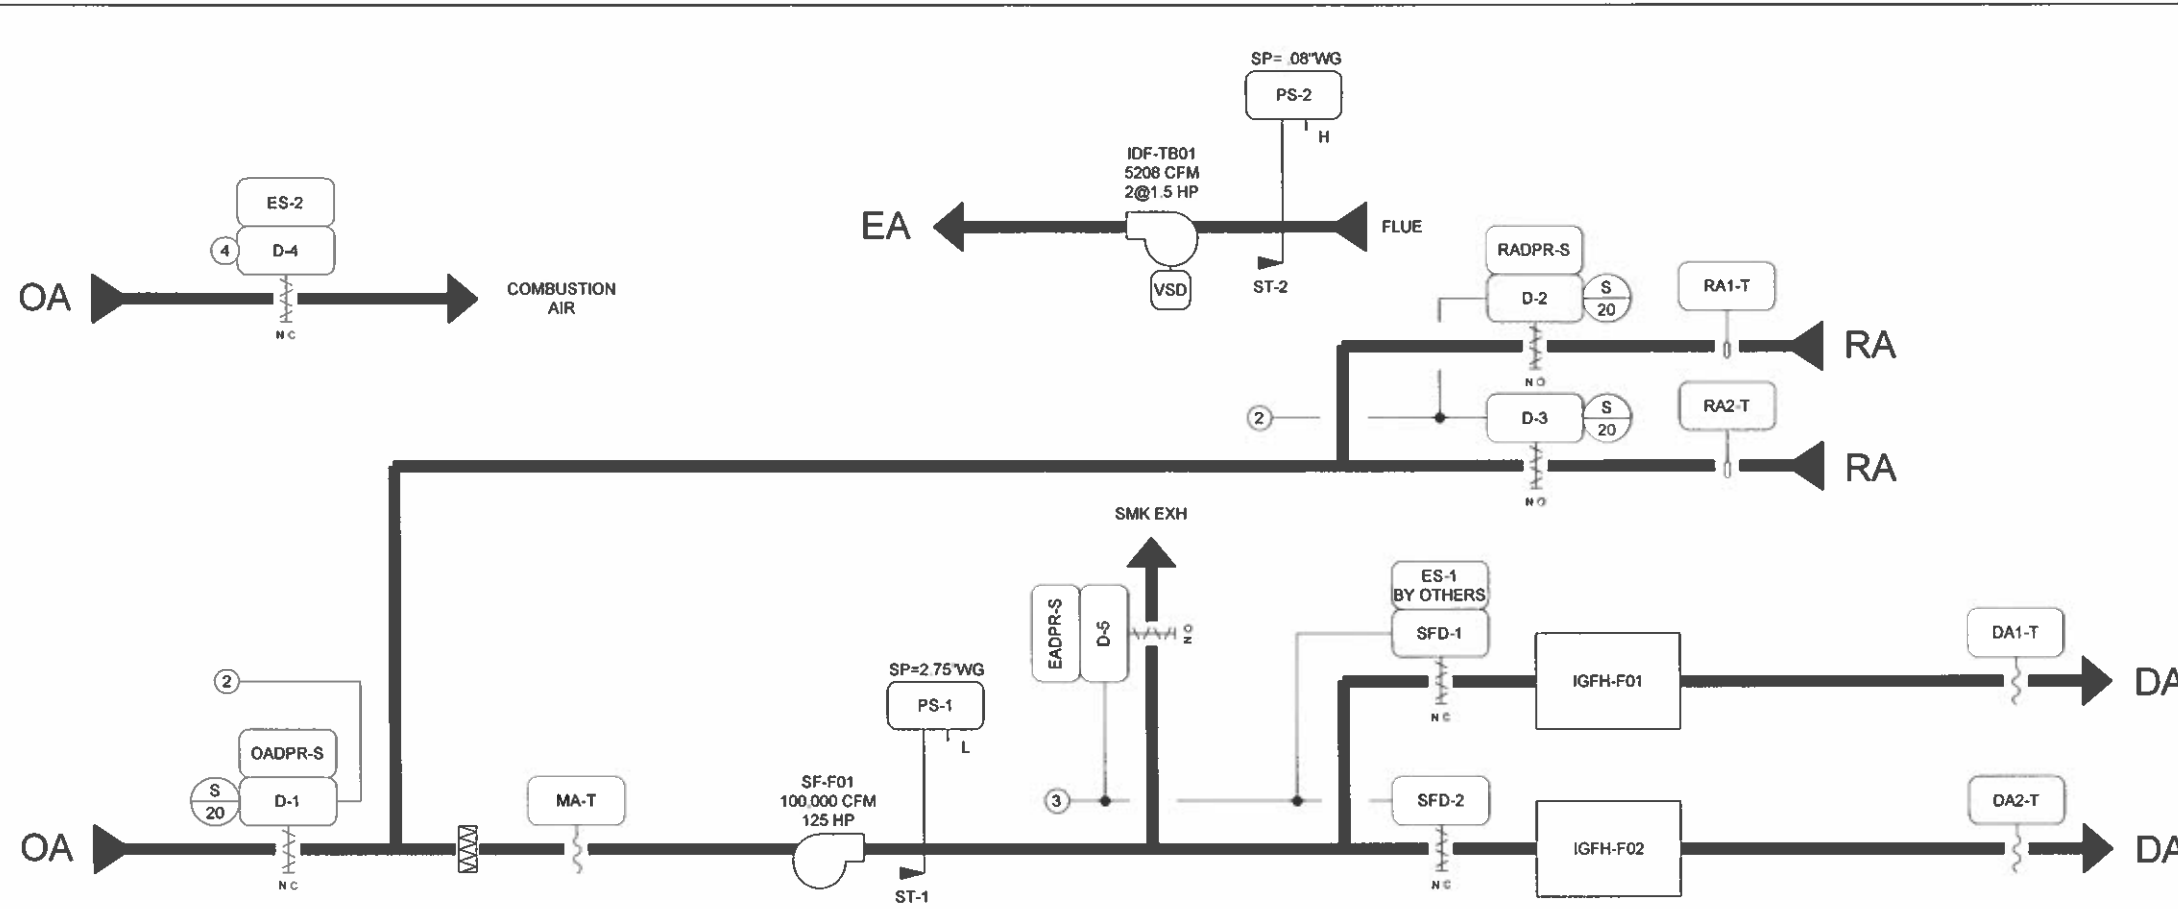

**BILL OF MATERIALS**

Designation	Qty	Part Number	Description
Field Devices:			
BOWL-T	1	TE-6000-1	SENS.T-NI,1.0%
	1	TE-6001-2	MTG,OAT SENS (CONDULET)
D-x,SFD-x	0		SEE DAMPER SCHEDULE
ES-2,XDPR-S	4	TS-470	DAMPER POSITION SWITCH - KELE
MA-T	1	TE-6001-8	CLIP F/AVG ELEM (10/PKG)
MA-T, Dax-T	3	TE-6316P-1	SENS.T-NI,0.1%,17' AVG
PB-1	1	User Item	EMERGENCY STOP PUSH BUTTON
PS-1	1	AFS-460	SW, AIR FLOW, SPST-NC RESET .05-12" @CLE
PS-2	1	P32AC-2C	SW,DP,SPDT,5",U-BRKT
R-1-2,SFSTA-C	3	CVR-21C-O	RLY 2SPDT,10-30VAC/DC OR 120VAC.LED @LEC
RAX-T	2	TE-6311P-1	SENS.T-NI,0.1%,8" DUCT
SF-C,CS-1,IDF-C,ID	2	H-735	SW, CURRENT, 1-135A CMND RLY SOLID @VER
F-S			
ST-x	2	A520-2-A-1	8" STATIC PROBE, ALUM, 1/4" TUBE @MAMAC

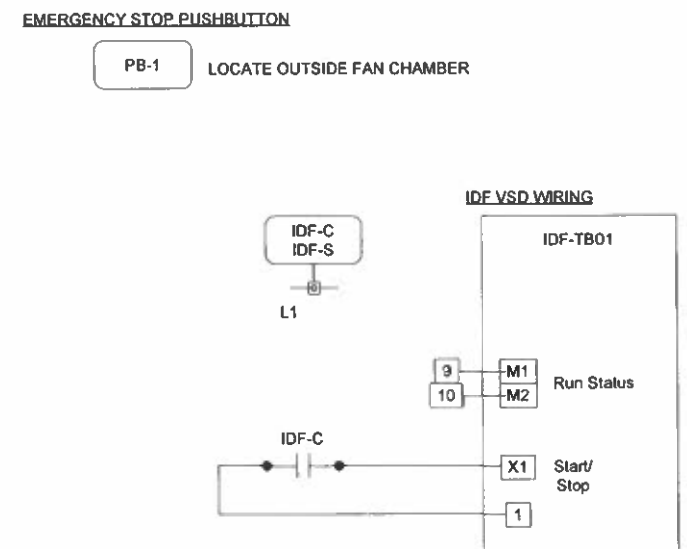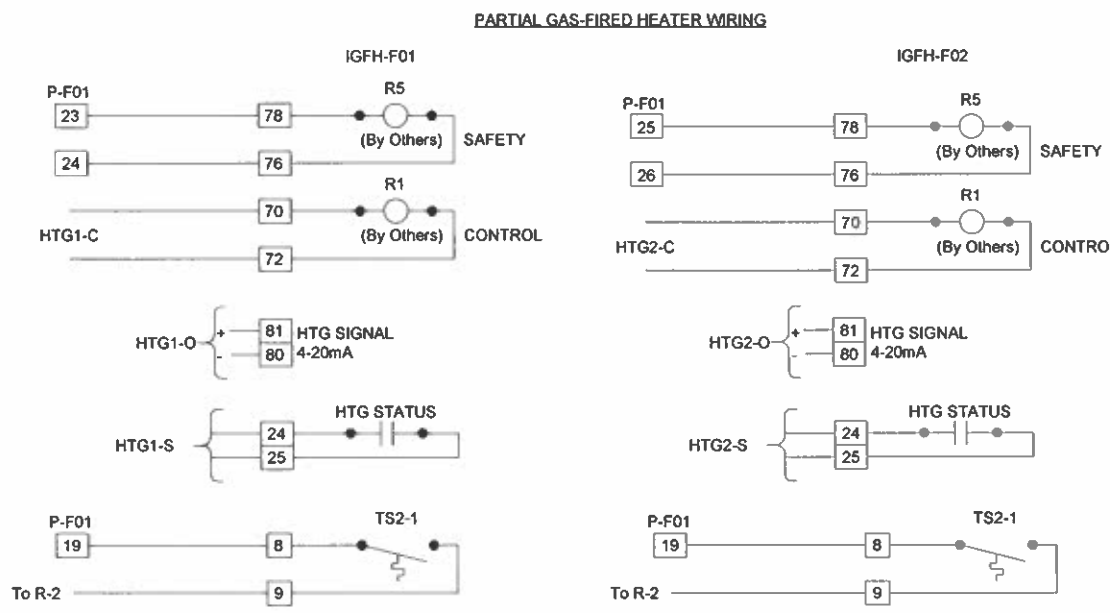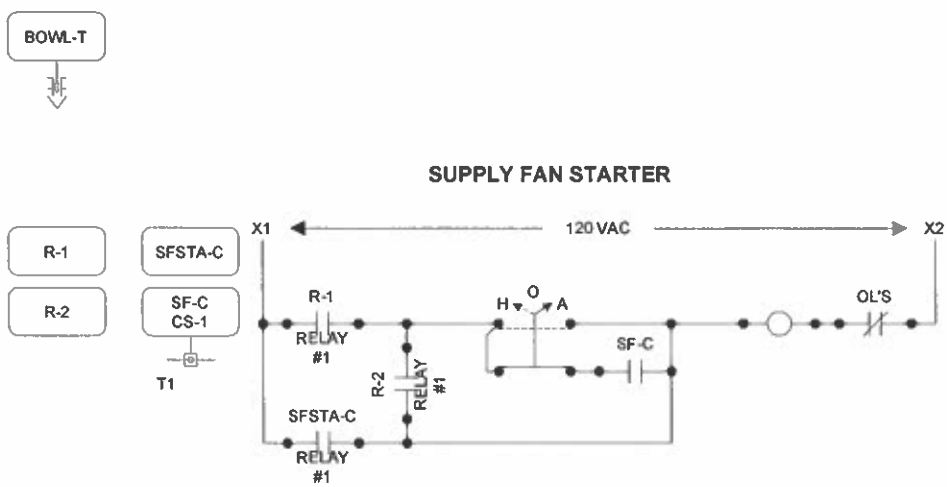


NOTE: SEE MANUFACTURER'S WIRING DIAGRAM FOR COMPLETE WIRING DETAILS.

NOTE: SEE MANUFACTURER'S WIRING DIAGRAM FOR COMPLETE WIRING DETAILS.

REVISION INFORMATION		Drawing Title							
NUMBER		AH-F01 FLOW		1		RECORD DRAWINGS		MLR	
DATE		06/14/01		REFERENCE DRAWING		NO		REVISION LOCATION	
TIME		11:01 AM		Sales Engineer		Project Manager		Application Engineer	
FILE NAME		ahf01f.vsd		PJS		TP		KJK	
				BY		MLR		DATE	
				Branch Information		CONTRACT NUMBER			
						Wisconsin Area Office 529 N. Jackson Street Milwaukee WI 53202 Phone: 414-524-7500 Fax: 414-524-7575		<b>9 8075-0508</b> DRAWING NUMBER <b>16.1</b>	


- FROM LAST N2 DEVICE (N2) 3/18 BLU
- TO NEXT N2 DEVICE (N2) 3/18 BLU
- HTG1-S \ DI-2 (F01-141-DI-2) 2/18 ORG
- HTG2-S \ DI-3 (F01-141-DI-3) 2/18 ORG
- IDF-S \ DI-4 (F01-141-DI-4) 2/18 ORG
- HTG1-O \ AO-2 (F01-141-AO-2) 2/18 TAN
- HTG2-O \ AO-9 (F01-141-AO-9) 2/18 TAN
- SF-C \ DO-3 (F01-141-DO-3) 2/18 VIO
- HTG1-C \ DO-4 (F01-141-DO-4) 2/18 VIO
- HTG2-C \ DO-5 (F01-141-DO-5) 2/18 VIO
- IDF-C \ DO-6 (F01-141-DO-6) 2/18 VIO
- DA1-T \ AI-1 (F01-141-AI-1) 2/18 YEL
- DA2-T \ AI-2 (F01-141-AI-2) 2/18 YEL
- RA1-T \ AI-3 (F01-141-AI-3) 2/18 YEL
- RA2-T \ AI-4 (F01-141-AI-4) 2/18 YEL
- MA-T \ AI-5 (F01-141-AI-5) 2/18 YEL
- BOWL-T \ AI-6 (F01-141-AI-6) 2/18 YEL
- EADPR-S \ XT1DI2 (F01-142A-DI-2) 2/18 ORG
- OADPR-S \ XT1DI3 (F01-142A-DI-3) 2/18 ORG
- RADPR-S \ XT1DI4 (F01-142A-DI-4) 2/18 ORG
- SFSTA-C \ XT1DO6 (F01-142A-DO-6) 2/18 VIO
- EFF07-S \ XT2DI3 (F01-142B-DI-3) 2/18 ORG
- EFF07-C \ XT2DO5 (F01-142B-DO-5) 2/18 VIO
- UH2812-D \ XT2DO6 (F01-142B-DO-6) 2/18 VIO
- UH2814-D \ XT2DO7 (F01-142B-DO-7) 2/18 VIO

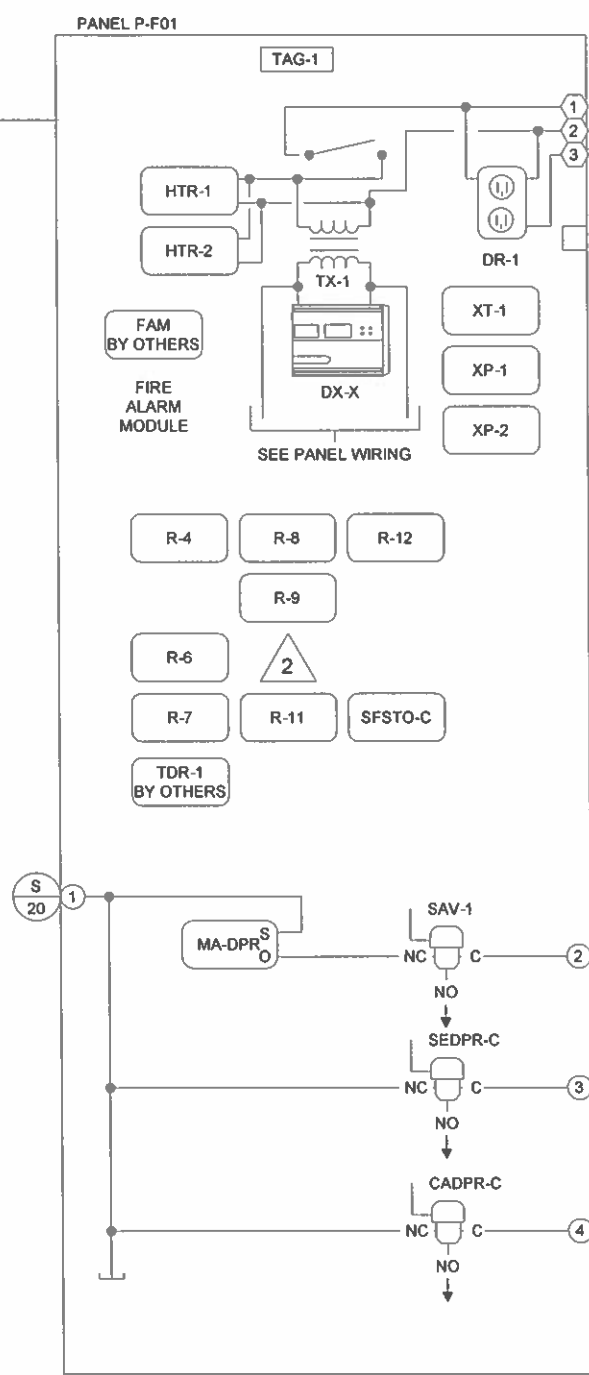

PANEL FACE TAGS:  
TAG-1: PANEL P-F01  
AH-F01  
JCI 9 8075-0508

120 VAC POWER  
VERIFY NORMAL / EMERGENCY  
POWER WITH JCI

LV TERMINALS:  
SEE WIRING DIAGRAMS.

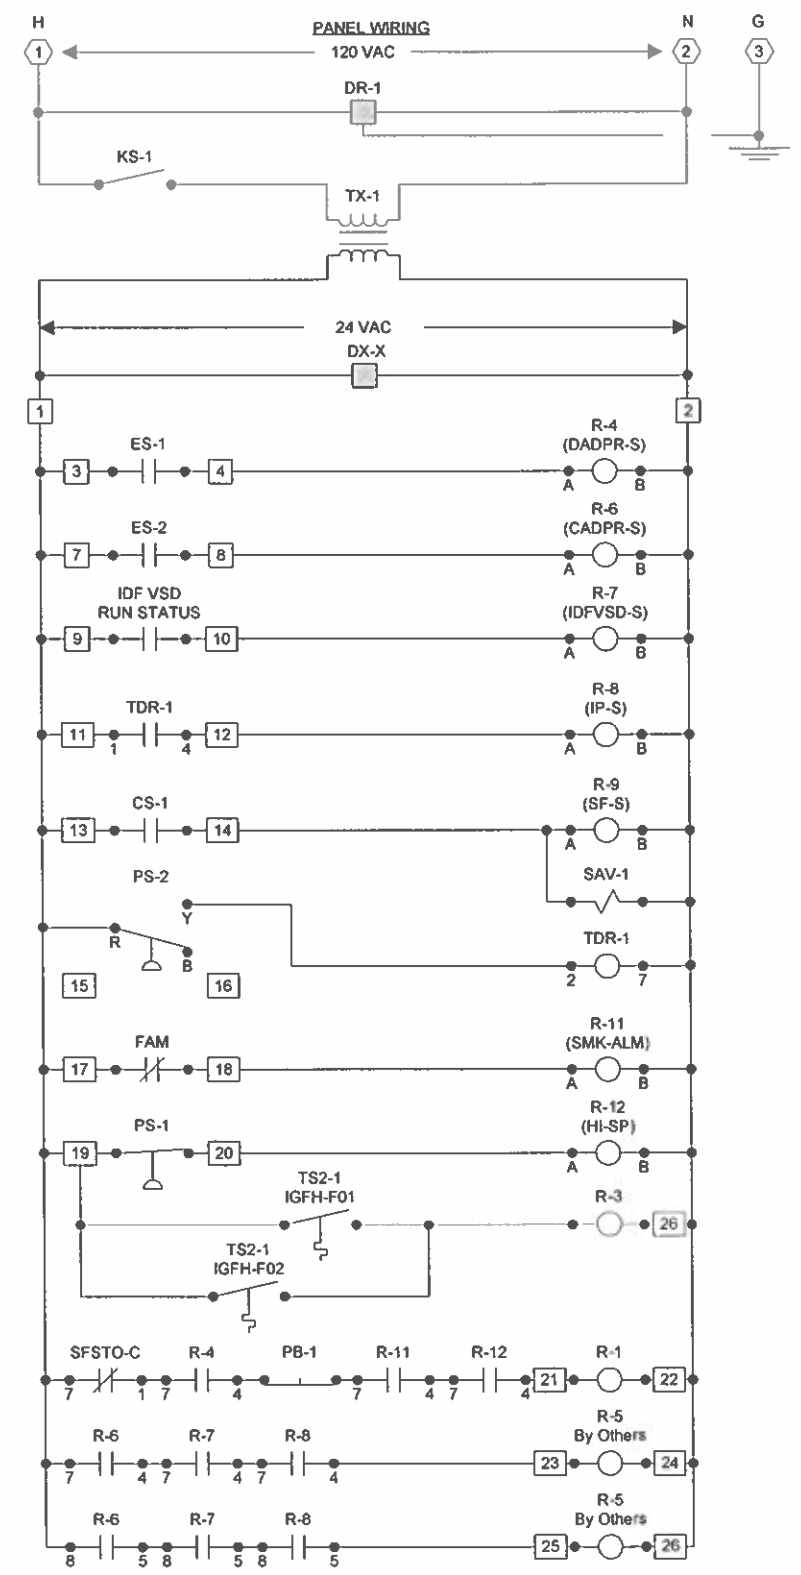

**BILL OF MATERIALS**

Designation	Qty	Part Number	Description
<b>Panel Devices:</b>			
DR-1	1	PD-117-2	RECEPTACLE DUPLEX,UL,WHT
	1	PD-121-1	RECEPTACLE DUPLEX,CVR
	1	PD-121-6	HANDY BOX 2 IN
DX-X	1	AS-LCPKEY-0	LCP SERVICE PORT ADJ KEY
	1	DX-9100-8454	DIGITAL CONTR., EXTENDED
	1	DX-9100-8990	MTG BASE (DX9100-8454)
HTR-x	2	EN2-12-P-040-D	PANEL HEATER, 120VAC, ELECTRO-FLEX
KS-1	1	PD-112-12	KNIFE SWITCH BLOCK
MA-DPR	1	EP-8000-2	XDUCR,EP,0/10V,HI VOL
P-X	1	M-8100-2436	PANEL, STANDARD, 15 UNITS
SAV-1, XDPR-C	3	V11HGA-100	3-W SOLENOID, W/0V, 24 VAC
SFSTO-C, R-4, 6-12	8	PD-101-35	RLY BASE, 3PDT, 11PIN, 10A
	8	PD-109-51	RELAY PLUG-IN, 3PDT, 24VAC
TAG-1	1	M-8000-393	NAMEPLT, LAMICOID, 3 LINE
TX-x	1	PD-114-2	TRANSFORMER 100VA, 120/24
XP-1, 2	2	XP-9104-8004	DX EXP MOD, 4 DI, 4DO TRIAC
XT-1	1	XT-9100-8204	EXTENSION MODULE


REVISION INFORMATION		Drawing Title									
NUMBER		AH-F01 PANEL		1		RECORD DRAWINGS				MLR	
DATE		06/14/01		Sales Engineer		Project Manager		Application Engineer		ECH DATE BY	
TIME		10:57 AM		PJS		TP		KJK		APPROVED	
FILE NAME		ahf01p.vsd		Project Title		MILLER PARK ONE BREWERS WAY MILWAUKEE, WI 53214		Branch Information		CONTRACT NUMBER	
				Systems & Services Division		Wisconsin Area Office 529 N. Jackson Street Milwaukee WI 53202 Phone: 414-524-7500 Fax: 414-524-7575				9 8075-0508	
										DRAWING NUMBER	
										16.2	

AH-F01

**MASP Indirect Gas Fired Air Handling System**

1. The air handling unit is equipped with supply fan, filter, 2 indirect gas-fired heaters, dedicated induction fan.
2. The air handling unit supply fan will be energized through the EMCS. The air handling unit will be interlocked with the operation of the roof, being started upon the roof being closed. An override will be provided to operate the unit in ventilation mode when the roof is open.
3. Upon the call for heating the air handling unit will be set to pre-heat mode. This will mean that the high level bowl louvers will be closed and the outside air dampers will be fully closed. The fan will be energized by the EMCS. The indirect heaters will be enabled but will be prevented from firing unless the combustion air dampers are proved to be open as detected by an end switch on the actuator and the associated induction fan is energized as proven by the induction fan VSD run contact. Both of these safeties will be hard-wired into the burner circuits to prevent firing until both conditions are met.
4. At the end of the pre-heat period, as determined by the return temperature reaching a preset limit, the unit will revert to normal operation. This will mean that the outside air damper will move to its minimum position. The indirect gas-fired burners will modulate to maintain the discharge air temperature. The discharge air temperature setpoint will be reset based on the return air temperature.
5. Upon the call for ventilation as determined by the EMCS and the outside air temperature, the outside air damper will fully open and the return air damper will fully close. The indirect gas-fired heaters will be prevented from firing, and the combustion air damper will close and the induction fan will de-energize. At the same time the high level left and right field dampers will fully open.
6. Filter replacement will be scheduled based on supply fan runtime.
7. Current switches located on the feed to the supply fan and draft induce fan will provide status indication (on/off).
8. The EMCS will monitor and control all points for each air handling unit.
9. End switches will be provided on dampers to provide status indication in the smoke exhaust mode. See the Smoke Exhaust System sequence of operation.
10. Where provided, flue draft fans will be interlocked with the gas burners. Low draft detector will be provided at the unit and roof fan; it will raise an alarm upon detection of low draft and shut down unit.
11. Mount and wire any manufacturers recommended controls for the flue pressure speed control on the induction fan VSDs. If any air handler supply fan burner is requesting heat, the associated induction fan will be energized until all the associated burners are not requesting heat.
12. In off hours, see the Frost Protection sequence of operation.


REVISION INFORMATION	Drawing Title								
NUMBER	SEQUENCE								
DATE		REFERENCE DRAWING	NO.	REVISION-LOCATION	ECH	DATE	BY		
04/12/01		Sales Engineer	Project Manager	Application Engineer					
		PJS	TP	KJK	BY	MLR	DATE	BY	DATE
TIME	Project Title	Branch Information		CONTRACT NUMBER					
11:55 AM	MILLER PARK ONE BREWERS WAY MILWAUKEE, WI 53214	Wisconsin Area Office 529 N. Jackson Street Milwaukee WI 53202 Phone: 414-524-7500 Fax: 414-524-7575		9 8075-0508					
FILE NAME		JOHNSON CONTROLS Systems & Services Division		DRAWING NUMBER					
ahf01s.vsd				16.3					

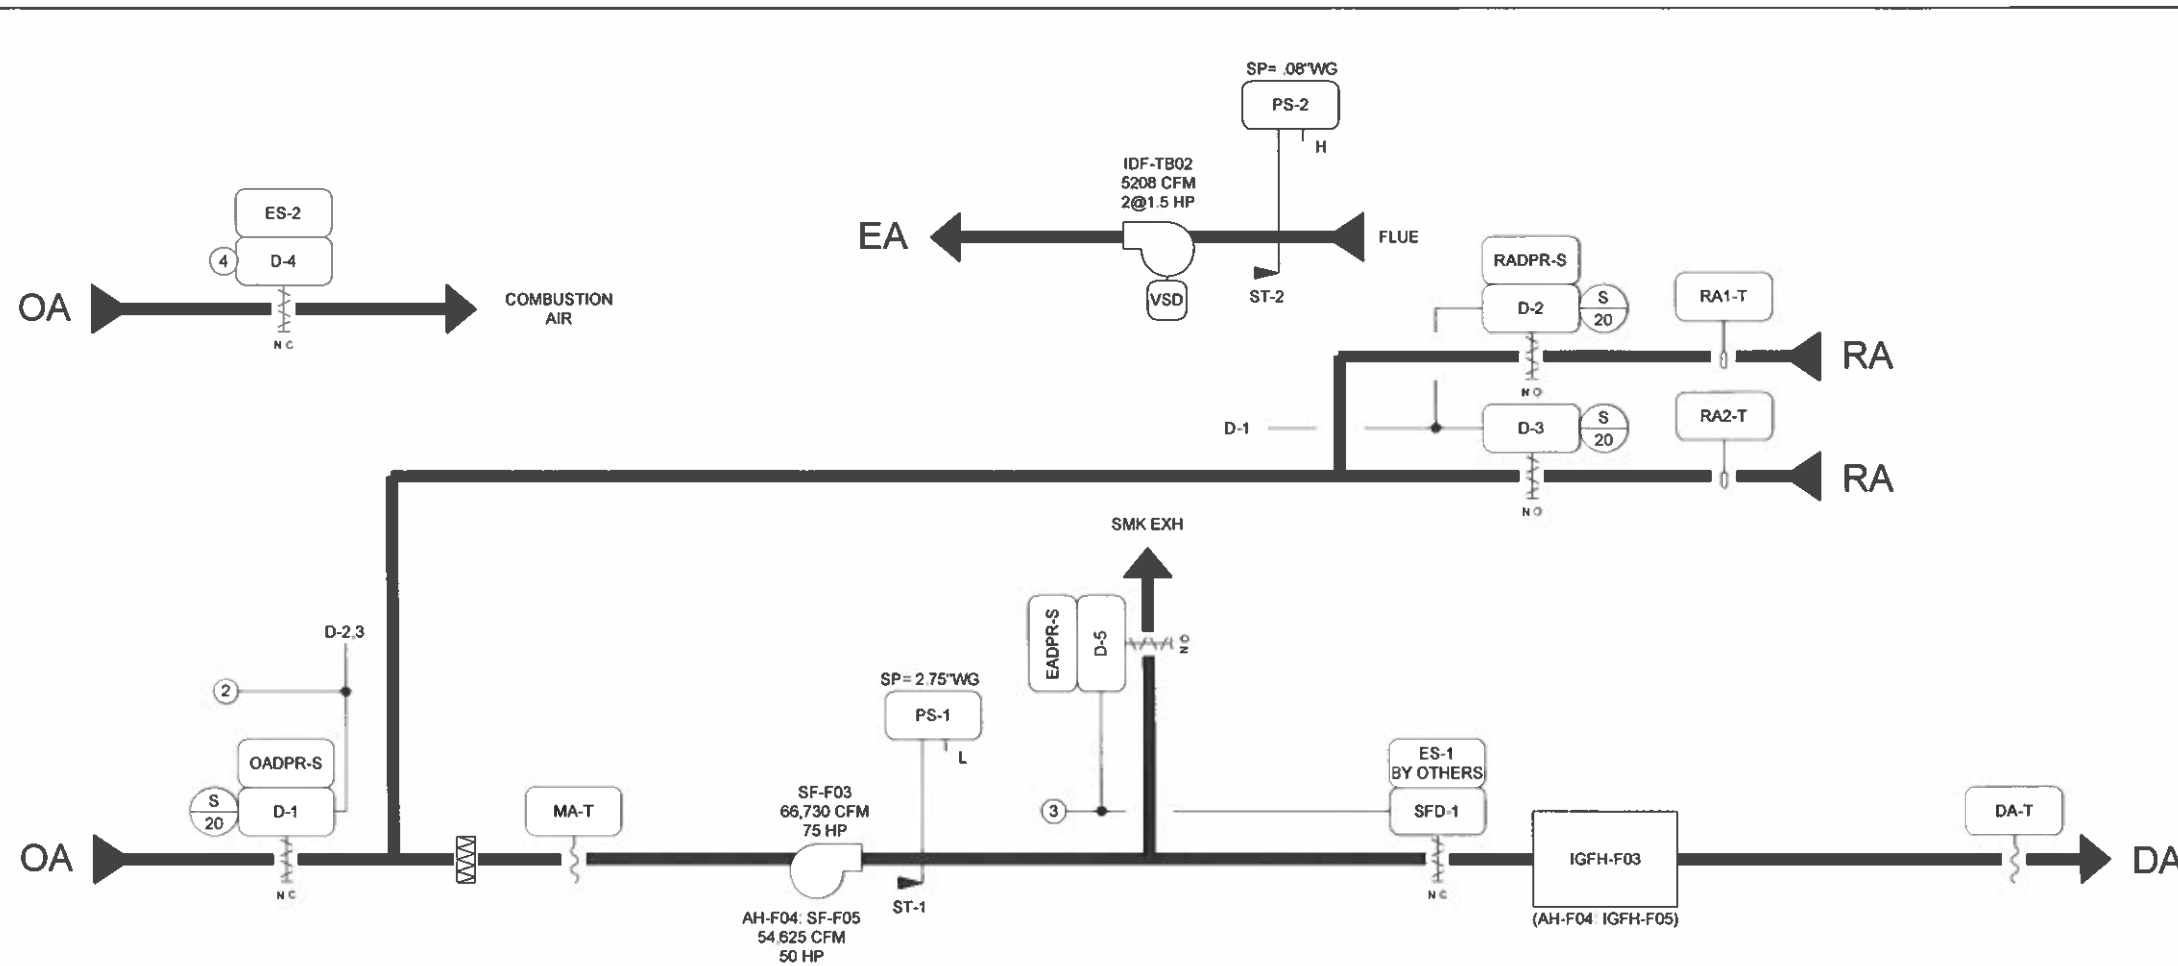


**BILL OF MATERIALS**

Designation	Qty	Part Number	Description
Field Devices:			
BOWL-T	1	TE-6000-1	SENS,T-NI,1.0%
	1	TE-6001-2	MTG,OAT SENS (CONDULET)
D-x,SFD-x	0	DAMPER	SEE DAMPER SCHEDULE
ES-2,XDPR-S	4	TS-470	DAMPER POSITION SWITCH - KELE
MA-T	1	TE-6001-8	CLIP FIA/VG ELEM (10/PKG)
MA-T, DA-T	2	TE-6316P-1	SENS,T-NI,0.1%,17" AVG
PS-1	1	AFS-460	SW, AIR FLOW, SPST-NC RESET .05-12" @CLE
PS-2	1	P32AC-2C	SW,DP,SPDT,5" U-BRKT
R-1-2,SFSTA-C	3	CVR-21C-O	RLY 2SPDT,10-30VAC/DC OR 120VAC LED @LEC
RAx-T	2	TE-6311P-1	SENS,T-NI,0.1%,8" DUCT
SF-C,CS-1,R-3,R-x,S	4	H-735	SW, CURRENT, 1-135A CMND RLY SOLID @VER
EFx-S			
ST-x	2	A520-2-A-1	8" STATIC PROBE, ALUM, 1/4" TUBE @MAMAC


**SMOKE EXHAUST FAN STARTER**

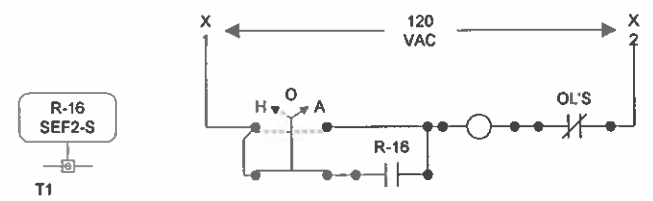


**SMOKE CURTAIN STARTER**

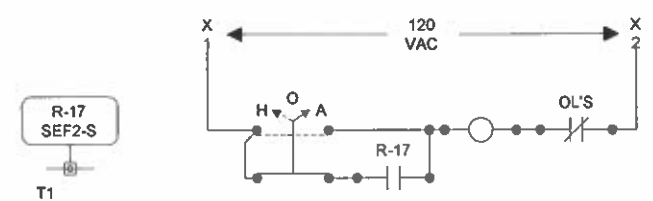

**SUPPLY FAN STARTER**

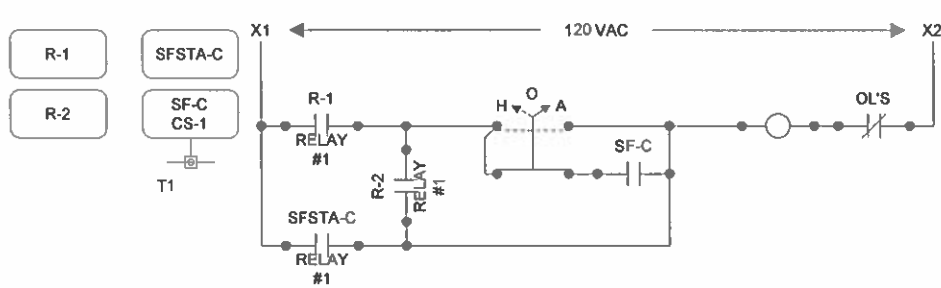


**PARTIAL GAS-FIRED HEATER WIRING**

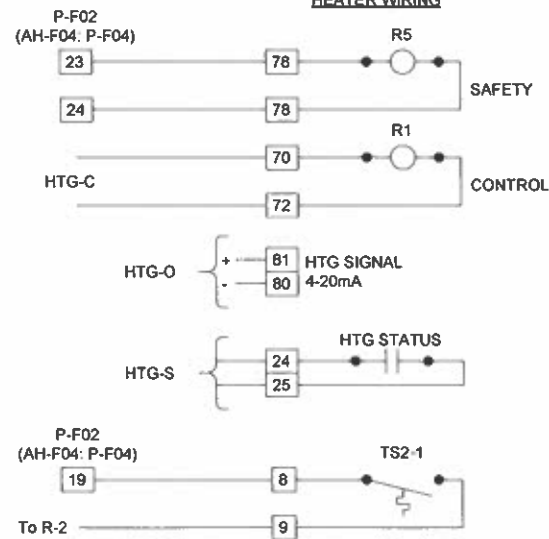

NOTE: SEE MANUFACTURER'S WIRING DIAGRAM FOR COMPLETE WIRING DETAILS.

**IDF VSD WIRING**

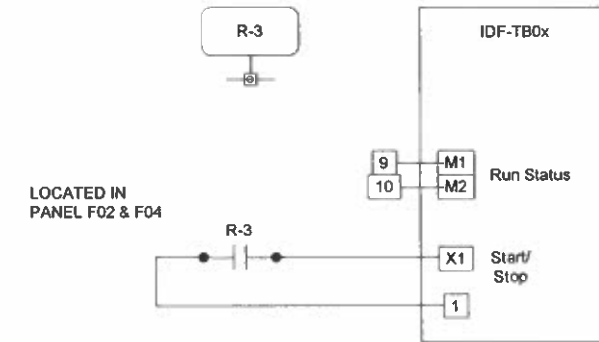

NOTE: IDF-TB02 Serves AH-F02 and AH-F03  
IDF-TB03 Serves AH-F04 and AH-F05

NOTE: SEE MANUFACTURER'S WIRING DIAGRAM FOR COMPLETE WIRING DETAILS.





REVISION INFORMATION	Drawing Title				
NUMBER	AH-F02 FLOW TYPICAL FOR AH-F04				
DATE	06/14/01	1	RECORD DRAWINGS		MLR
TIME	12:59 PM	REFERENCE DRAWING	NO	REVISION-LOCATION	ECN
FILE NAME	ahf02f.vsd	Engineer	PJS	Project Manager	TP
		Application Engineer	KJK	DATE	DATE
		BY	MLR	DATE	DATE
		Branch Information	CONTRACT NUMBER		
		Wisconsin Area Office	9 8075-0508		
		529 N Jackson Street	DRAWING NUMBER		
		Milwaukee	17.1		
		WI 53202			
		Phone: 414-524-7500			
		Fax: 414-524-7575			

**JOHNSON CONTROLS**  
Systems & Services Division



**BILL OF MATERIALS**

Designation	Qty	Part Number	Description
<b>Panel Devices:</b>			
DR-1	1	PD-117-2	RECEPTACLE, DUPLEX, UL, WHT
	1	PD-121-1	RECEPTACLE, DUPLEX, CVR
	1	PD-121-6	HANDY BOX 2 IN
DX-X	1	AS-LCPKEY-0	LCP SERVICE PORT ADJ KEY
	1	DX-9100-8454	DIGITAL CONTR., EXTENDED
	1	DX-9100-8990	MTG BASE (DX9100-8454)
HTR-x	2	EN2-12-P-040-D	PANEL HEATER, 120VAC, ELECTRO-FLEX
KS-1	1	PD-112-12	KNIFE SWITCH BLOCK
MA-DPR	1	EP-8000-2	XDUCR, EP, 0/10V, HI VOL
P-X	1	M-8100-2436	PANEL, STANDARD, 15 UNITS
SAV-1, XDPR-C	3	V11HGA-100	3-W SOLENOID W/OV, 24 VAC
SFSTO-C, R-4, 6-14, S	11	PD-101-35	RLY BASE, 3PDT, 11PIN, 10A
EF2-C	11	PD-109-51	RELAY PLUG-IN 3PDT 24VAC
TAG-1	1	M-8000-393	NAMEPLT, LAMICOID, 3 LINE
TX-x	1	PD-114-2	TRANSFORMER 100VA, 120/24
XP-1, 2	2	XP-9104-8004	DX EXP MOD, 4 DI, 4DO TRIAC
XT-1	1	XT-9100-8204	EXTENSION MODULE

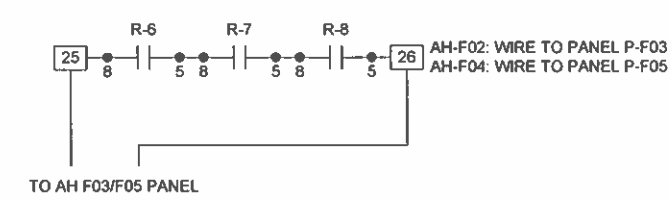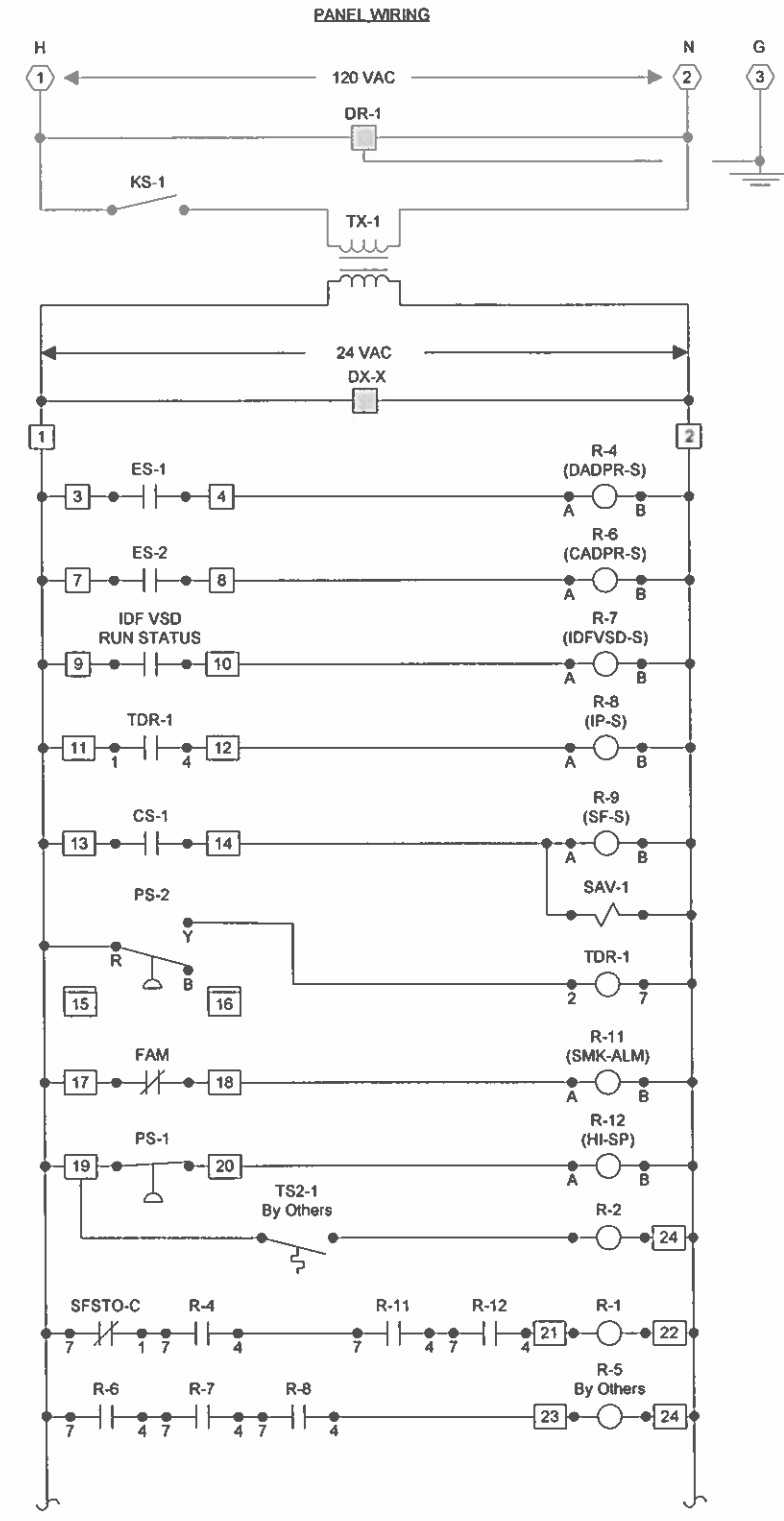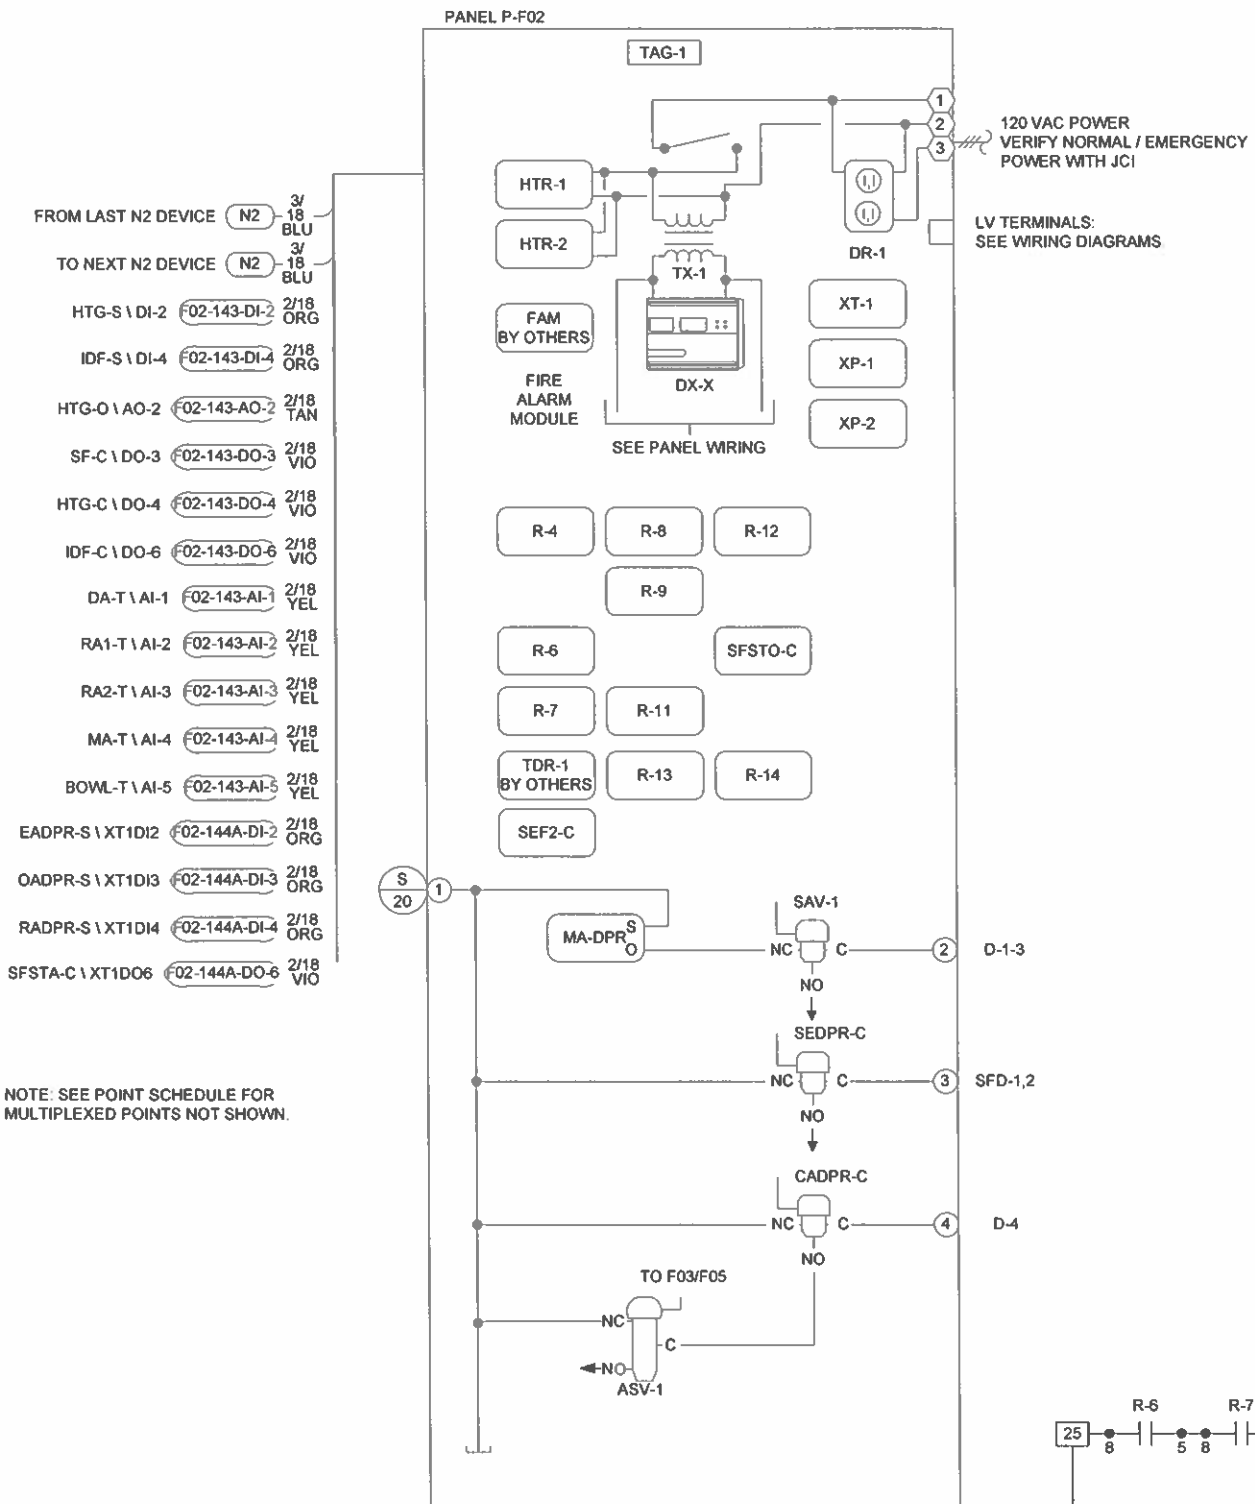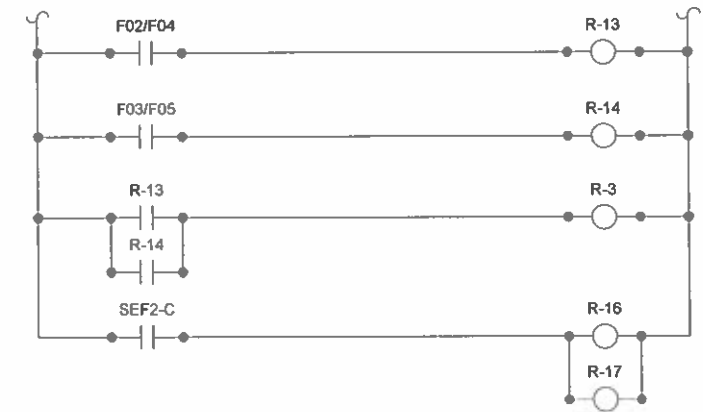


NOTE: SEE POINT SCHEDULE FOR MULTIPLEXED POINTS NOT SHOWN.

PANEL FACE TAGS:  
TAG-1: PANEL P-F02 AH-F02 JCI 9 8075-0508  
TAG-1: PANEL P-F04 AH-F04 JCI 9 8075-0508

REVISION INFORMATION		Drawing Title							
NUMBER		AH-F02 PANEL TYPICAL FOR AH-F04		1		RECORD DRAWINGS		6/14/2001 MLR	
DATE		06/14/01		PJS		TP		KJK	
TIME		11:41 AM		Project Title		MILLER PARK ONE BREWERS WAY MILWAUKEE, WI 53214		CONTRACT NUMBER	
FILE NAME		ahf02p.vsd		Systems & Services Division		JOHNSON CONTROLS		9 8075-0508	
						Wisconsin Area Office 529 N. Jackson Street Milwaukee WI 53202 Phone: 414-524-7500 Fax: 414-524-7575		DRAWING NUMBER	
								17.2	


- FROM LAST N2 DEVICE (N2) 3/18 BLU
- TO NEXT N2 DEVICE (N2) 3/18 BLU
- HTG1-S \ DI-3 (F06-31-DI-3) 2/18 ORG
- HTG2-S \ DI-4 (F06-31-DI-4) 2/18 ORG
- IDF-S \ DI-5 (F06-31-DI-5) 2/18 ORG
- HTG1-O \ AO-2 (F06-31-AO-2) 2/18 TAN
- HTG2-O \ AO-9 (F06-31-AO-9) 2/18 TAN
- SF-C \ DO-3 (F06-31-DO-3) 2/18 VIO
- HTG1-C \ DO-4 (F06-31-DO-4) 2/18 VIO
- HTG2-C \ DO-5 (F06-31-DO-5) 2/18 VIO
- IDF-C \ DO-6 (F06-31-DO-6) 2/18 VIO
- DA1-T \ AI-1 (F06-31-AI-1) 2/18 YEL
- DA2-T \ AI-2 (F06-31-AI-2) 2/18 YEL
- RA1-T \ AI-3 (F06-31-AI-3) 2/18 YEL
- RA2-T \ AI-4 (F06-31-AI-4) 2/18 YEL
- RA3-T \ AI-5 (F06-31-AI-5) 2/18 YEL
- MA-T \ AI-6 (F06-31-AI-6) 2/18 YEL
- BOWL-T \ AI-7 (F06-31-AI-7) 2/18 YEL
- EADPR-S \ XT1DI2 (F06-32A-DI-2) 2/18 ORG
- OADPR-S \ XT1DI3 (F06-32A-DI-3) 2/18 ORG
- RADPR-S \ XT1DI4 (F06-32A-DI-4) 2/18 ORG
- SFSTA-C \ XT1DO6 (F06-32A-DO-6) 2/18 VIO
- UH2004-D \ XT2DO5 (F06-32B-DO-5) 2/18 VIO
- UH2005-D \ XT2DO6 (F06-32B-DO-6) 2/18 VIO
- UH2103-D \ XT2DO7 (F06-32B-DO-7) 2/18 VIO
- UH2104-D \ XT2DO8 (F06-32B-DO-8) 2/18 VIO

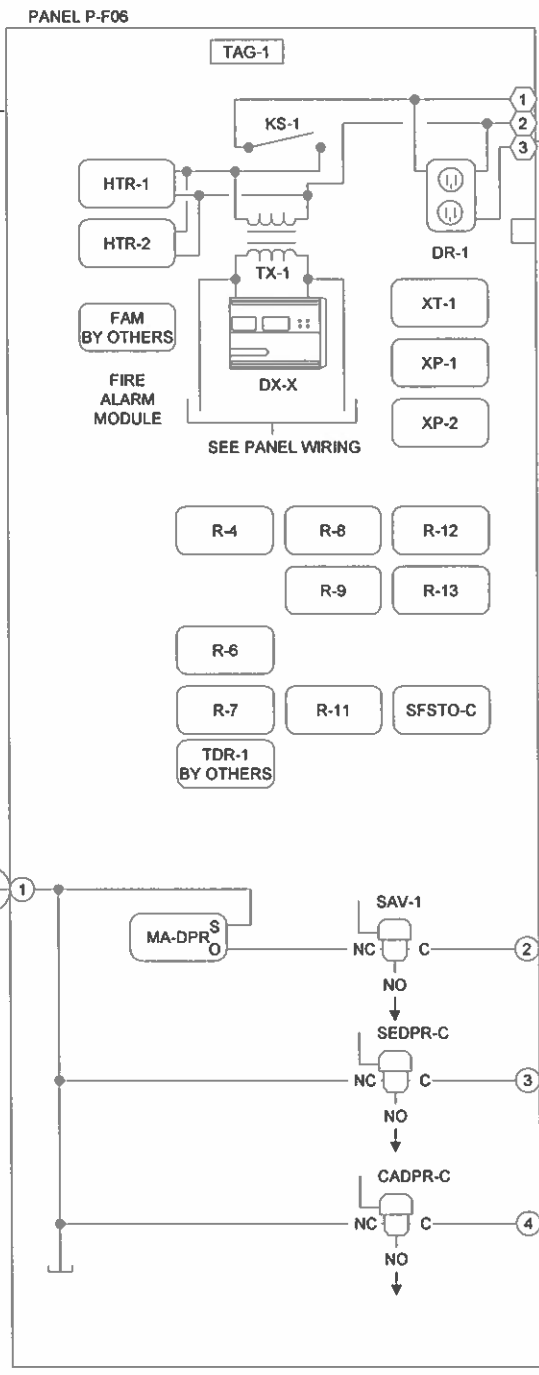


PANEL FACE TAGS:  
 TAG-1: PANEL P-F06  
 AH-F06  
 JCI 9 8075-0508

120 VAC POWER  
 VERIFY NORMAL / EMERGENCY  
 POWER WITH JCI

LV TERMINALS:  
 SEE WIRING DIAGRAMS.

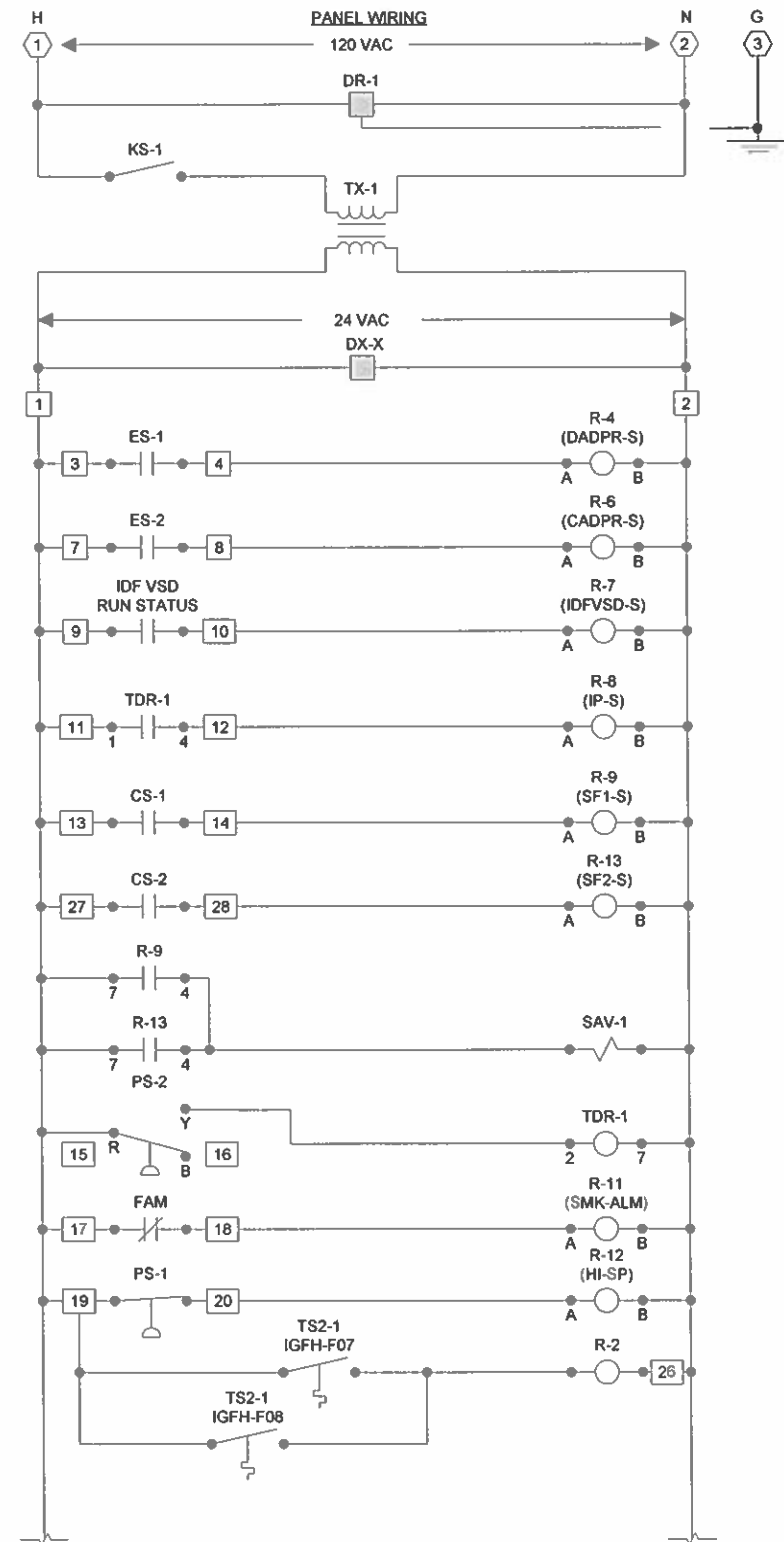

BILL OF MATERIALS			
Designation	Qty	Part Number	Description
Panel Devices:			
DR-1	1	PD-117-2	RECEPTACLE, DUPLEX, UL, WHT
	1	PD-121-1	RECEPTACLE, DUPLEX, CVR
	1	PD-121-6	HANDY BOX 2 IN
DX-X	1	AS-LCPKEY-0	LCP SERVICE PORT ADJ KEY
	1	DX-9100-8454	DIGITAL CONTR., EXTENDED
	1	DX-9100-8990	MTG BASE (DX9100-8454)
HTR-x	2	EN2-12-P-040-D	PANEL HEATER, 120VAC, ELECTRO-FLEX
KS-1	1	PD-112-12	KNIFE SWITCH BLOCK
MA-DPR	1	EP-8000-2	XDUCR, EP, 0/10V, HI VOL
P-X	1	M-8100-2436	PANEL STANDARD, 15 UNITS
SAV-1, XDPR-C	3	V11HGA-100	3-W SOLENOID, W/OV, 24 VAC
SFSTO-C, R-4, 6-13	9	PD-101-35	RLY BASE, 3PDT, 11PIN, 10A
	9	PD-109-51	RELAY PLUG-IN 3PDT 24VAC
TAG-1	1	M-8000-393	NAMEPLT, LAMICOID, 3 LINE
TX-x	1	PD-114-2	TRANSFORMER 100VA, 120/24
XP-1, 2	2	XP-9104-8004	DX EXP MOD, 4 DI, 4DO TRIAC
XT-1	1	XT-9100-8204	EXTENSION MODULE

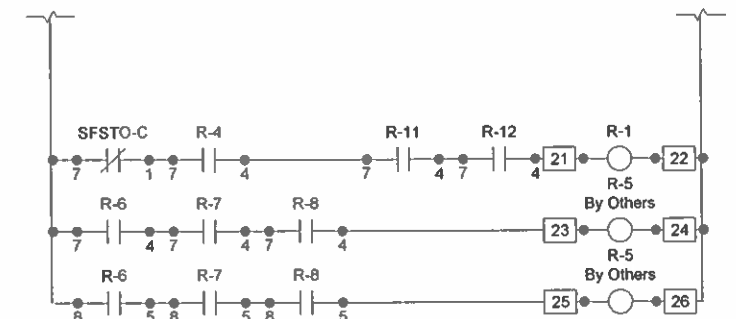


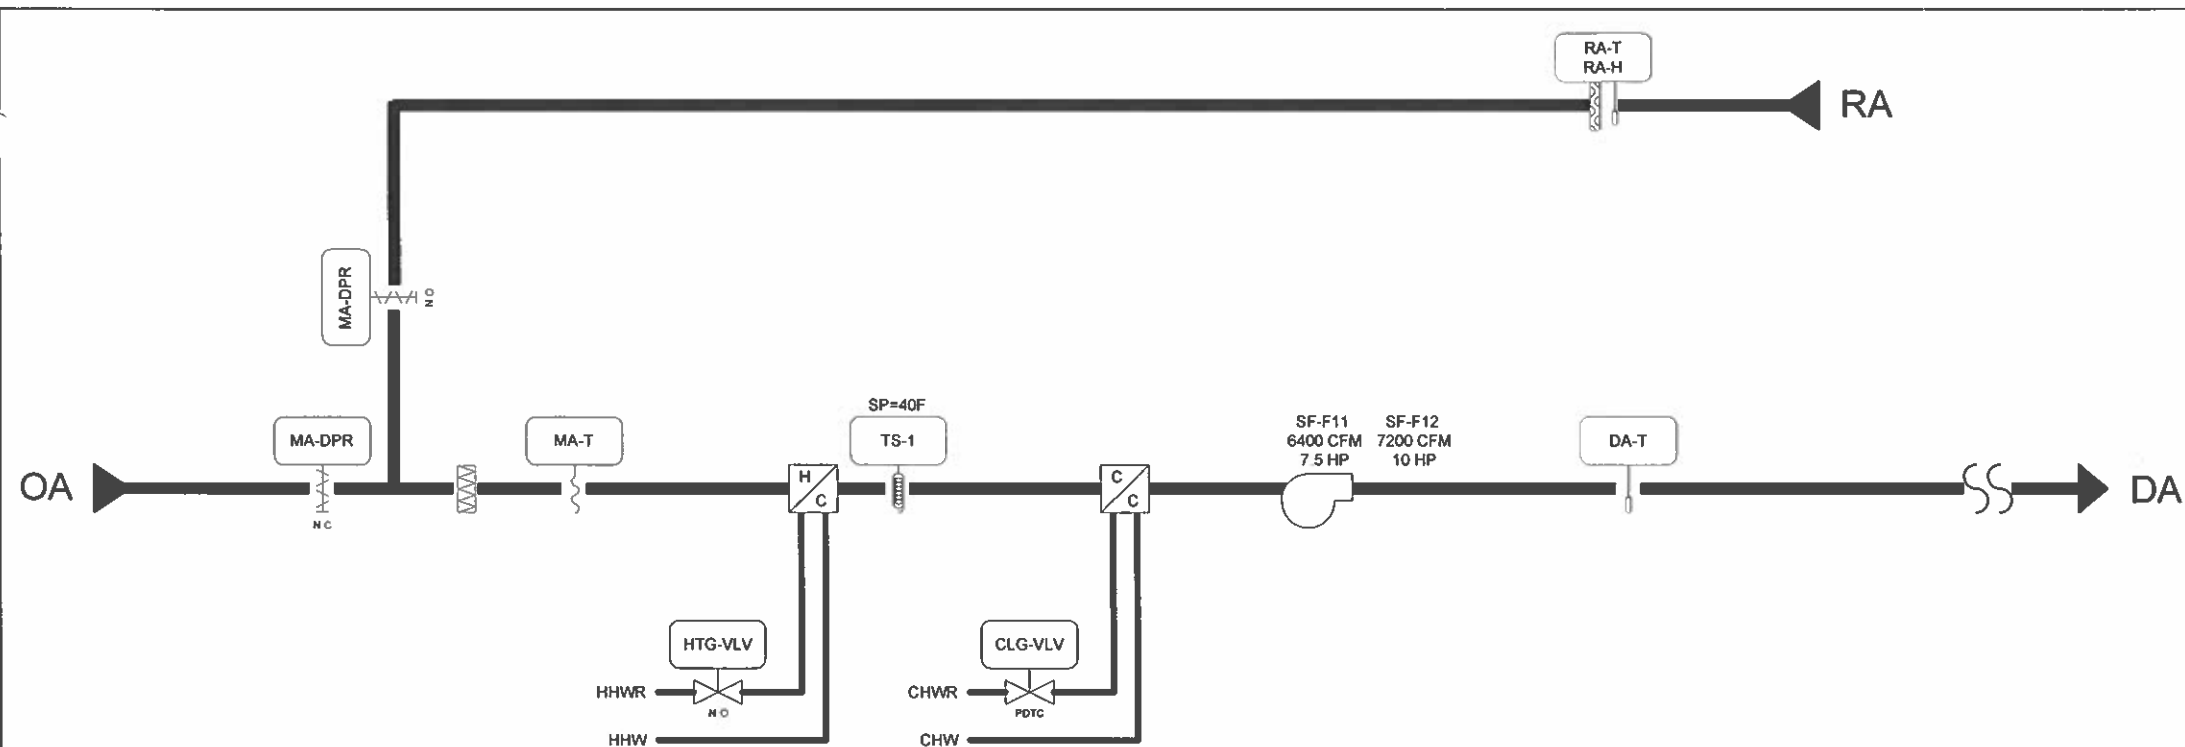
REVISION INFORMATION		Drawing Title									
NUMBER		AH-F06 PANEL		1		RECORD DRAWINGS				MLR	
DATE		06/14/01		Sales Engineer		Project Manager		Application Engineer		ECN DATE BY	
TIME		01:26 PM		PJS		TP		KJK		APPROVED	
FILE NAME		ahf06p.vsd		Project Title		MILLER PARK ONE BREWERS WAY MILWAUKEE, WI 53214		Branch Information		CONTRACT NUMBER	
				JOHNSON CONTROLS		Systems & Services Division		Wisconsin Area Office 529 N. Jackson Street Milwaukee WI 53202 Phone: 414-524-7500 Fax: 414-524-7575		9 8075-0508	
										DRAWING NUMBER	
										19.2	

AH-F06

**MASP Indirect Gas Fired Air Handling System**



1. The air handling unit is equipped with 2 supply fans, filter, 2 indirect gas-fired heaters, dedicated induction fan.
2. The air handling unit supply fans will be energized through the EMCS. The air handling unit will be interlocked with the operation of the roof, being started upon the roof being closed. An override will be provided to operate the unit in ventilation mode when the roof is open.
3. Upon the call for heating the air handling unit will be set to pre-heat mode. This will mean that the high level bowl louvers will be closed and the outside air dampers will be fully closed. The fans will be energized by the EMCS. The indirect heaters will be enabled but will be prevented from firing unless the combustion air dampers are proved to be open as detected by an end switch on the actuator and the associated induction fan is energized as proven by the induction fan VSD run contact. Both of these safeties will be hard-wired into the burner circuits to prevent firing until both conditions are met.
4. At the end of the pre-heat period, as determined by the return temperature reaching a preset limit, the unit will revert to normal operation. This will mean that the outside air damper will move to its minimum position. The indirect gas-fired burners will modulate to maintain the discharge air temperature. The discharge air temperature setpoint will be reset based on the return air temperature.
5. Upon the call for ventilation as determined by the EMCS and the outside air temperature, the outside air damper will fully open and the return air damper will fully close. The indirect gas-fired heaters will be prevented from firing, and the combustion air damper will close and the induction fan will de-energize. At the same time the high level left and right field dampers will fully open.
6. Filter replacement will be scheduled based on supply fan runtime.
7. Current switches located on the feed to the supply fans and draft induce fan will provide status indication (on/off).
8. The EMCS will monitor and control all points for each air handling unit.
9. End switches will be provided on dampers to provide status indication in the smoke exhaust mode. See the Smoke Exhaust System sequence of operation.
10. Where provided, flue draft fans will be interlocked with the gas burners. Low draft detector will be provided at the unit and roof fan; it will raise an alarm upon detection of low draft and shut down unit.
11. Mount and wire any manufacturers recommended controls for the flue pressure speed control on the induction fan VSDs. If any air handler supply fan burner is requesting heat, the associated induction fan will be energized until all the associated burners are not requesting heat.
12. In off hours, see the Frost Protection sequence of operation.

REVISION INFORMATION	Drawing Title								
NUMBER	SEQUENCE								
DATE	04/12/01	REFERENCE DRAWING	NO	REVISION-LOCATION	ECH	DATE	BY		
TIME	01:39 PM	Sales Engineer	Project Manager	Application Engineer	BY	MLR	DATE	BY	DATE
FILE NAME	ahf06s.vsd	PJS	TP	KJK					
	Project Title				Branch Information Wisconsin Area Office 529 N. Jackson Street Milwaukee WI 53202 Phone: 414-524-7500 Fax: 414-524-7575		CONTRACT NUMBER <b>9 8075-0508</b>		
	MILLER PARK ONE BREWERS WAY MILWAUKEE, WI 53214	Systems & Services Division					DRAWING NUMBER <b>19.3</b>		



**BILL OF MATERIALS**

Designation	Qty	Part Number	Description
<b>Field Devices:</b>			
DA-T	1	TE-6311P-1	SENS,T-NI,0.1% 8" DUCT
MA-T	1	TE-6315P-1	SENS,T-NI,0.1% 8" AVG
MA-T, TS-1	1	TE-6001-8	CLIP F/AVG ELEM (10/PKG)
R-1	1	CVR-21C-O	RLY 2SPDT,10-30VAC/DC OR 120VAC.LED @LEC
RA-H, RA-T	1	HE-6310-2	XMTR,RHT-NI,DUCT,AC/DC
SF-C,CS-1	1	H-735	SW. CURRENT, 1-135A CMND RLY SOLID @VER
TS-1	1	A70HA-1C	STAT,LL,20' EL,MAN 15/55F
X-DPR	0	DAMPER	SEE DAMPER SCHEDULE
X-DPR, X-VLV	3	PD-101-1	RESISTOR, 4990HM 1/2W 1%
X-VLV	0	VALVE	SEE VALVE SCHEDULE
<b>Panel Devices:</b>			
AHU-X	1	AS-AHU103-300	AHU TERMINATION BD/ELECTRONICS IN EWC35
HTR-x	2	EN2-12-P-040-D	PANEL HEATER, 120VAC, ELECTRO-FLEX
P-X	1	EN-EXP101-0	PANEL,STANDARD,22 UNITS
	1	M-8100-3042	PANEL,STANDARD,22 UNITS
R-3-R-5	3	PD-101-35	RLY BASE,3PDT,11PIN,10A
	3	PD-109-51	RELAY PLUG-IN 3PDT 24VAC
TAG-x	1	M-8000-393	NAMEPLT,LAM/COID,3 LINE
UNT-x	2	AS-UNT141-1	CNTRLR,DIG,UNT,6AI,4BI,6BO,2AO SCR

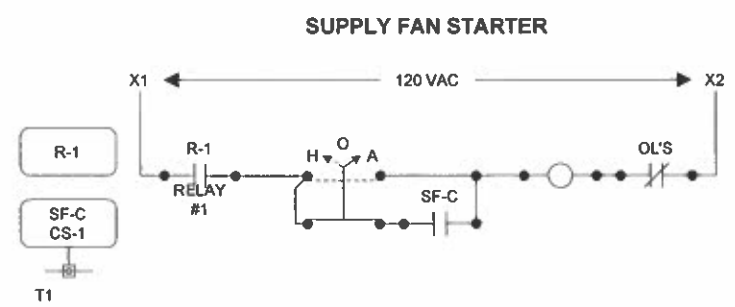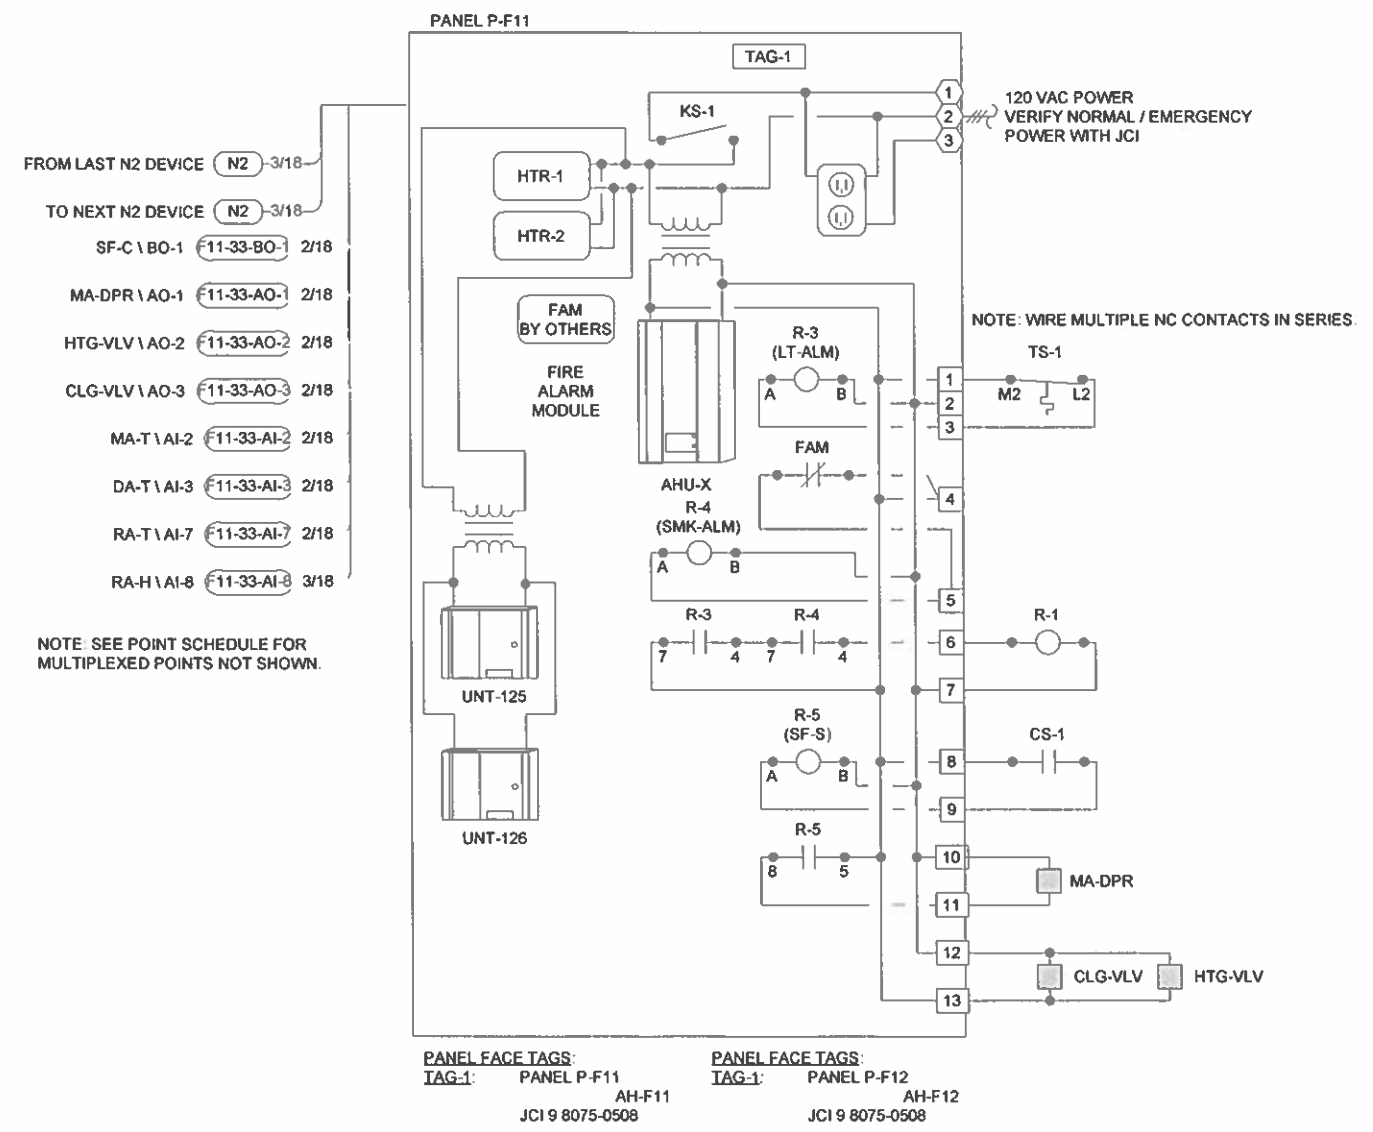

NOTE: SEE POINT SCHEDULE FOR MULTIPLEXED POINTS NOT SHOWN.

PANEL FACE TAGS:  
TAG-1: PANEL P-F11 AH-F11 JCI 9 8075-0508


PANEL FACE TAGS:  
TAG-1: PANEL P-F12 AH-F12 JCI 9 8075-0508


REVISION INFORMATION	Drawing Title				
NUMBER	AH-F11 FLOW TYPICAL FOR AH-F12				
DATE	04/12/01	REFERENCE DRAWING	NO.	REVISION-LOCATION	ECN
TIME	01:44 PM	Sales Engineer	Project Manager	Application Engineer	DATE
FILE NAME	ahf11f.vsd	PJS	TP	KJK	BY MLR DATE
Project Title		Branch Information		CONTRACT NUMBER	
MILLER PARK ONE BREWERS WAY MILWAUKEE, WI 53214		Wisconsin Area Office 529 N. Jackson Street Milwaukee WI 53202 Phone: 414-524-7500 Fax: 414-524-7575		9 8075-0508	
		JOHNSON CONTROLS Systems & Services Division		DRAWING NUMBER 20.1	

AH-F11, AH-F12

Multi-zone Constant Volume MASP Air Handling System with Economizer Cycle

1. The air handling unit is equipped with supply fan, heating coil, cooling coil, pre-filter, final filter and economizer mixing box.
2. The air handling unit supply fan will be energized through the EMCS on a scheduled basis.
3. Provide for the air handling unit, an economizer logic network controller to position the economizer dampers for maximum economy and sequenced with the heating and cooling valves.
4. Unless the economizer controller is overridden by the warm-up cycle, the controller will verify that the air handling unit is running via a fan proof of flow controller and open the outside air damper to the minimum required ventilation position.
5. When the outside air dry bulb temperature is less than outside air dry bulb setpoint, the economizer dampers will be positioned for maximum free cooling using outside air to meet the cooling demand. The mechanical cooling equipment will only be used if the outside air cannot provide enough free cooling to meet demand.
6. Upon morning start-up of the occupied mode, mechanical cooling will be locked out, the heating coil control valve will fully open, the outside air damper will move to the closed position, and any interlocked exhaust fans will be de-energized. When the return air temperature reaches the warm-up setpoint, the air handler will return to normal operation.
7. Each zone sensor or group of zone sensors modulate the reheat coil hot water control valve to satisfy the required room temperature. See the Reheat Coil sequence of operation.
8. The chilled and hot water control valves will modulate in sequence to maintain the discharge air temperature. The discharge air temperature setpoint will be reset based on the operation of the zone reheat coil control valves and return air humidity.
9. Smoke detectors located in the supply and return ducts will on detection of smoke shut down the air handler supply fan via a hard-wire interlock with fan starters. Smoke detector status will be indicated at the EMCS.
10. Filter replacement will be scheduled based on supply fan runtime.
11. Current switches will be located on the feed to the supply fan to provide status indication (on/off). In off hours DDC controller will command the chilled water two-way control valve and outside air damper to a fully closed position, heating coil control valve to fully open position.
12. The EMCS will monitor and control all points for each air handling unit.
13. In off hours, the supply fan will be cycled intermittently at night by the zone sensor to maintain 60°F.

REVISION INFORMATION	Drawing Title								
NUMBER	SEQUENCE								
DATE	04/12/01	REFERENCE DRAWING	NO	REVISION-LOCATION	ECN	DATE	BY		
TIME	01:48 PM	Sales Engineer	Project Manager	Application Engineer	BY	MLR	DATE	BY	DATE
FILE NAME	ahf11s.vsd	PJS	TP	KJK					
	Project Title			Branch Information Wisconsin Area Office 529 N. Jackson Street Milwaukee WI 53202 Phone: 414-524-7500 Fax: 414-524-7575		CONTRACT NUMBER <b>9 8075-0508</b>		DRAWING NUMBER <b>20.2</b>	
	MILLER PARK ONE BREWERS WAY MILWAUKEE, WI 53214	Systems & Services Division							

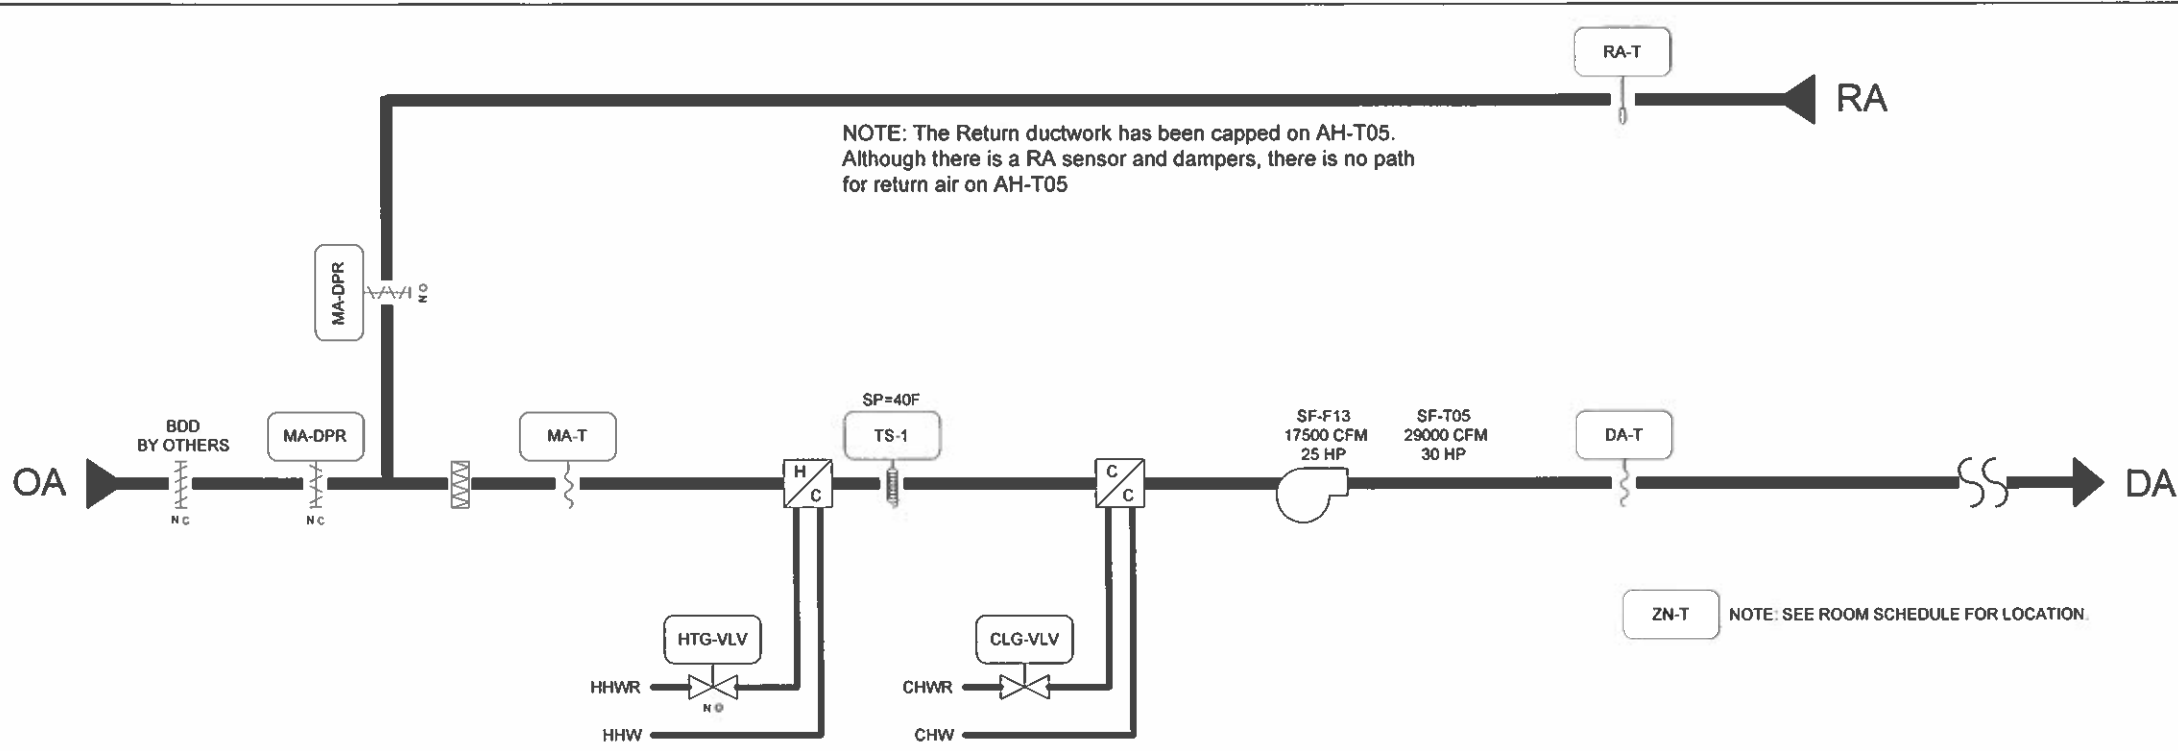

NOTE: The Return ductwork has been capped on AH-T05. Although there is a RA sensor and dampers, there is no path for return air on AH-T05


ZN-T NOTE: SEE ROOM SCHEDULE FOR LOCATION.

**BILL OF MATERIALS**

Designation	Qty	Part Number	Description
<b>Field Devices</b>			
DA-T, MA-T	2	TE-6316P-1	SENS,T-NI,0.1%,17' AVG
MA-T, TS-1	1	TE-6001-8	CLIP F/AVG ELEM (10/PKG)
R-1	1	CVR-21C-0	RLY 2SPDT,10-30VAC/DC OR 120VAC,LED @LEC
RA-T	1	TE-6311P-1	SENS,T-NI,0.1%,8" DUCT
SF-C,CS-1	1	H-735	SW, CURRENT, 1-135A CMND RLY SOLID @VER
TS-1	2	A70HA-1C	STAT,LL,20',EL,MAN,15/55F
X-DPR	0	DAMPER	SEE DAMPER SCHEDULE
X-DPR, X-VLV	3	PD-101-1	RESISTOR, 4990HM 1/2W 1%
X-VLV	0	VALVE	SEE VALVE SCHEDULE
ZN-T	1	TE-6314P-1	SENS,T-NI,0.1%,RM
<b>P-F13 PANEL</b>			
<b>Panel Devices:</b>			
AHU-X	1	AS-AHU103-300	AHU TERMINATION BD/ELECTRONICS IN EWC35
HTR-x	2	EN2-12-P-040-D	PANEL HEATER, 120VAC, ELECTRO-FLEX
P-X	2	EN-EXP101-0	EXPANSION COVER AND BACKBONE
R-3-R-5	1	M-8100-3042	PANEL STANDARD,22 UNITS
	3	PD-101-35	RLY BASE,3PDT,11PIN,10A
	3	PD-109-51	RELAY PLUG-IN 3PDT 24VAC
TAG-1	1	M-8000-393	NAMEPLT,LAMICOID,3 LINE
TX-x	2	PD-114-2	TRANSFORMER 100VA, 120/24
<b>P-T05 PANEL</b>			
<b>Panel Devices:</b>			
AHU-X	1	AS-AHU103-300	AHU TERMINATION BD/ELECTRONICS IN EWC35
HTR-1	1	EN2-12-P-040-D	PANEL HEATER, 120VAC, ELECTRO-FLEX
P-X	1	M-8100-2424	PANEL STANDARD 9 UNITS
R-3-R-5	3	PD-101-35	RLY BASE,3PDT,11PIN,10A
	3	PD-109-51	RELAY PLUG-IN 3PDT 24VAC
TAG-1	1	M-8000-393	NAMEPLT,LAMICOID,3 LINE
TX-x	2	PD-114-2	TRANSFORMER 100VA, 120/24

- FROM LAST N2 DEVICE (N2) 3/18
- TO NEXT N2 DEVICE (N2) 3/18
- SF-C \ BO-1 (F13-35-BO-1) 2/18
- MA-DPR \ AO-1 (F13-35-AO-1) 2/18
- HTG-VLV \ AO-2 (F13-35-AO-2) 2/18
- CLG-VLV \ AO-3 (F13-35-AO-3) 2/18
- MA-T \ AI-2 (F13-35-AI-2) 2/18
- DA-T \ AI-3 (F13-35-AI-3) 2/18
- ZN-T \ AI-4 (F13-35-AI-4) 2/18
- RA-T \ AI-7 (F13-35-AI-7) 2/18


NOTE: SEE POINT SCHEDULE FOR MULTIPLEXED POINTS NOT SHOWN.

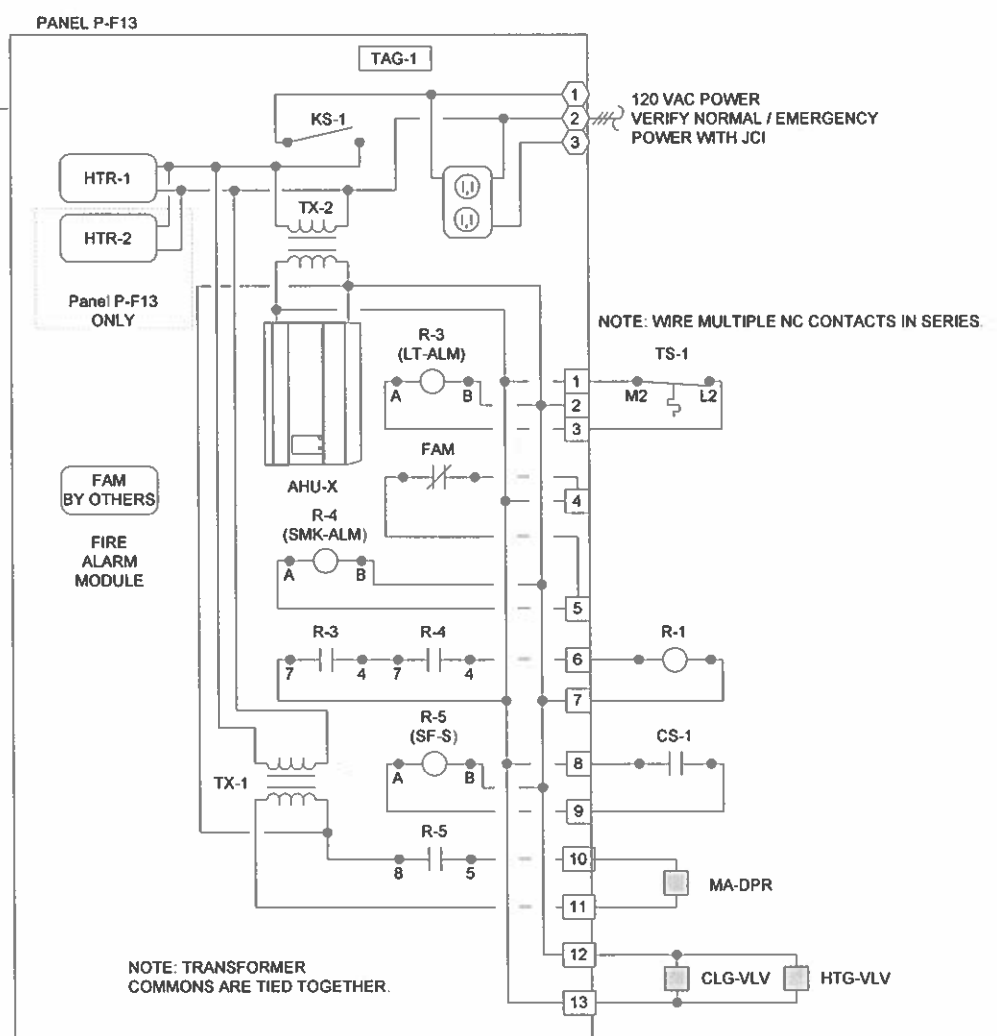

NOTE: TRANSFORMER COMMONS ARE TIED TOGETHER.

PANEL FACE TAGS:  
TAG-1: PANEL P-T05 AH-T05  
JCI 9 8075-0508

**SUPPLY FAN STARTER**

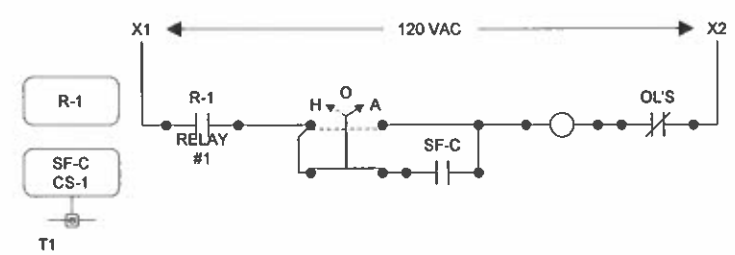

<b>REVISION INFORMATION</b> NUMBER: _____ DATE: 08/16/02 TIME: 10:09 AM FILE NAME: ahf13f.vsd		<b>Drawing Title</b> <b>AH-F13 FLOW TYPICAL FOR AH-T05</b>		<b>REFERENCE DRAWING</b> NO. _____ REVISION-LOCATION _____ EUM _____ DATE _____ BY _____	
Sales Engineer: PJS Project Manager: TP Application Engineer: KJK		DRAWN BY: MLR DATE: _____ APPROVED BY: _____ DATE: _____		Branch Information: Wisconsin Area Office 529 N. Jackson Street Milwaukee WI 53202 Phone: 414-524-7500 Fax: 414-524-7575	
<b>JOHNSON CONTROLS</b> Systems & Services Division				<b>CONTRACT NUMBER</b> <b>9 8075-0508</b> <b>DRAWING NUMBER</b> <b>21.1</b>	

**AH-F13**

**Single-zone Constant Volume MASP Air Handling System with Economizer Cycle**


1. The air handling unit is equipped with supply fan, heating coil, cooling coil, pre-filter, final filter and economizer mixing box.
2. The air handling unit supply fan will be energized through the EMCS on a scheduled basis.
3. Provide for the air handling unit, an economizer logic network controller to position the economizer dampers for maximum economy and sequenced with the heating and cooling valves.
4. Unless the economizer controller is overridden by the warm-up cycle, the controller will verify that the air handling unit is running via a fan proof of flow controller and open the outside air damper to the minimum required ventilation position.
5. When the outside air dry bulb temperature is less than outside air dry bulb setpoint, the economizer dampers will be positioned for maximum free cooling using outside air to meet the cooling demand. The mechanical equipment will only be used if the outside air cannot provide enough free cooling to meet demand.
6. Upon morning start-up of the occupied mode, mechanical cooling will be locked out, the heating coil control valve will fully open, and the outside air damper will move to the closed position, and any interlocked exhaust fans will be de-energized. When the return air temperature reaches the warm-up setpoint, the air handlers will return to normal operation. Provide all relays, solenoids and wiring required to lock out warm-up during normal occupancy hours.
7. The chilled water control valve will modulate in sequence with the heating coil control valve to maintain the discharge air temperature. The discharge air temperature setpoint will be reset based on room temperature.
8. Smoke detectors located in the supply and return ducts will on detection of smoke shut down the air handler supply fan via a hard-wire interlock with fan starters. Smoke detector status will be indicated at the EMCS.
9. Filter replacement will be scheduled based on supply fan runtime.
10. Current switches will be located on the feed to the supply fan to provide status indication (on/off). In off hours DDC controller will command the chilled water two-way control valve and outside air damper to a fully closed position, heating coil control valve to fully open position.
11. The EMCS will monitor and control all points for each air handling unit.
12. In off hours, the supply fan will be cycled intermittently at night by the zone sensor to maintain 60°F.


**AH-T05**

**Single-zone Constant Volume 100% OA Air Handling System**

1. The air handling unit is equipped with supply fan, heating coil, cooling coil, pre-filter, final filter and economizer mixing box. This unit does not have mixed air; the return ductwork has been capped off.
2. The air handling unit supply fan will be energized through the EMCS on a scheduled basis.
3. Provide for the air handling unit, an economizer logic network controller to position the economizer dampers for maximum economy and sequenced with the heating and cooling valves. Although economizer dampers are provided, there is no economizer logic on AH-T05. The unit is controlled based on 100% outdoor air logic.
4. There is no warm-up cycle on this air handler. When the supply fan status is on, the outdoor air dampers open 100%.
5. The chilled water control valve will modulate in sequence with the heating coil control valve to maintain the discharge air temperature. The discharge air temperature setpoint will be reset based on room temperature.
6. Smoke detectors located in the supply and return ducts will on detection of smoke shut down the air handler supply fan via a hard-wire interlock with fan starters. Smoke detector status will be indicated at the EMCS.
7. Filter replacement will be scheduled based on supply fan runtime.
8. Current switches will be located on the feed to the supply fan to provide status indication (on/off). In off hours DDC controller will command the chilled water two-way control valve and outside air damper to a fully closed position, heating coil control valve to fully open position.
9. The EMCS will monitor and control all points for each air handling unit.
10. In off hours, the supply fan will be cycled intermittently at night by the zone sensor to maintain 60°F. The outside air dampers will open during this unoccupied mode when the fan status is on.

The sequence for AH-T05 was updated by DAM 12/6/01



REVISION INFORMATION	Drawing Title								
NUMBER	SEQUENCE								
DATE	08/16/02	REFERENCE DRAWING	NO	REVISION LOCATION	EON	DATE	BY		
TIME	10:09 AM	Sales Engineer	Project Manager	Application Engineer	BY	MLR	DATE	BY	DATE
FILE NAME	ahf13s.vsd	PJS	TP	KJK					
	Project Title	MILLER PARK ONE BREWERS WAY MILWAUKEE, WI 53214				Wisconsin Area Office 529 N. Jackson Street Milwaukee WI 53202 Phone: 414-524-7500 Fax: 414-524-7575		CONTRACT NUMBER <b>9 8075-0508</b>  DRAWING NUMBER <b>21.2</b>	
		Systems & Services Division							

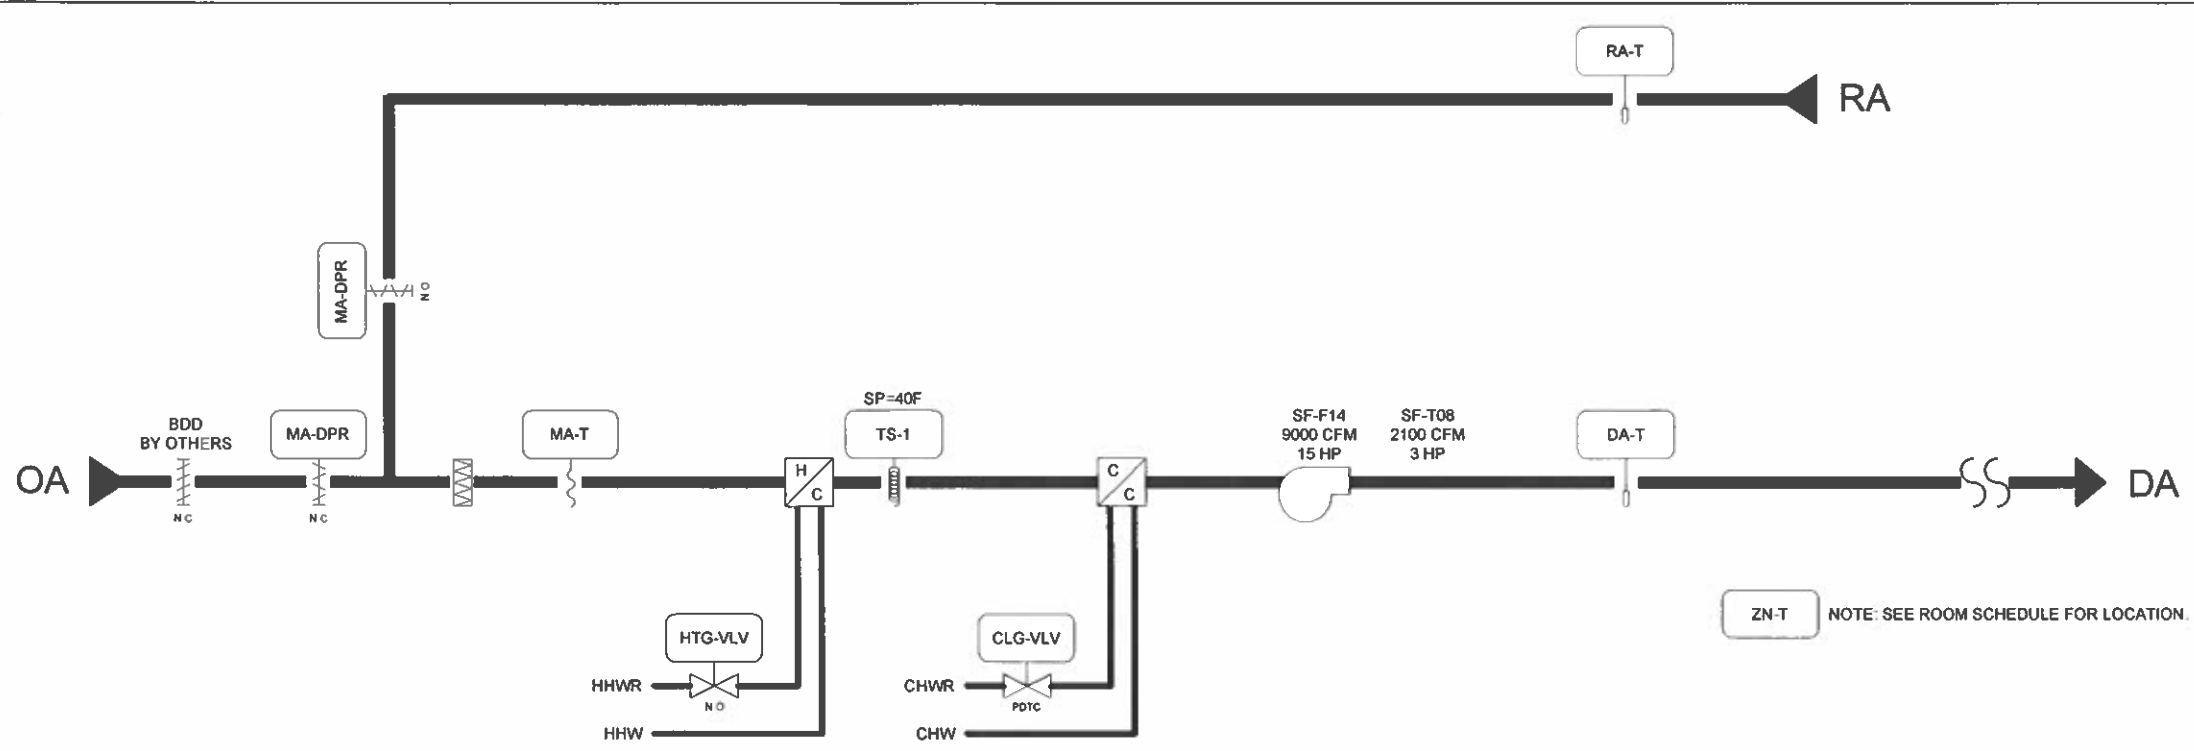

**BILL OF MATERIALS**

Designation	Qty	Part Number	Description
<b>Field Devices:</b>			
DA-T	1	TE-6311P-1	SENS,T-Ni,0.1%,8" DUCT
MA-T	1	TE-6315P-1	SENS,T-Ni,0.1%,8" AVG
MA-T, TS-1	1	TE-6001-8	CLIP F/AVG ELEM (10/PKG)
R-1	1	CVR-21C-O	RLY 2SPDT,10-30VAC/DC OR 120VAC,LED @LEC
RA-T	1	TE-6311P-1	SENS,T-Ni,0.1%,8" DUCT
SF-C,CS-1	1	H-735	SW, CURRENT, 1-135A CMND RLY SOLID @VER
TS-1	1	A70HA-1C	STAT,LL,20',EL,MAN,15/55F
X-DPR	0		SEE DAMPER SCHEDULE
X-DPR, X-VLV	0	PD-101-1	RESISTOR, 4990HM 1/2W 1%
X-VLV	0		SEE VALVE SCHEDULE
ZN-T	1	TE-6314P-1	SENS,T-Ni,0.1%,RM
<b>Panel Devices:</b>			
AHU-X	1	AS-AHU103-300	AHU TERMINATION BD/ELECTRONICS IN EWC35
HTR-x	2	EN2-12-P-040-D	PANEL HEATER, 120VAC, ELECTRO-FLEX
P-X	1	EN-EXP101-0	EXPANSION COVER AND BACKBONE
R-3-R-5	3	M-8100-3042	PANEL STANDARD,22 UNITS
	3	PD-101-35	RLY BASE,3PDT,11PIN,10A
	3	PD-109-51	RELAY PLUG-IN 3PDT 24VAC
TAG-1	1	M-8000-393	NAMEPLT,LAMICOID,3 LINE

- FROM LAST N2 DEVICE (N2) 3/18
- TO NEXT N2 DEVICE (N2) 3/18
- SF-C1\BO-1 (F14-36-BO-1) 2/18
- MA-DPR\AO-1 (F14-36-AO-1) 2/18
- HTG-VLV\AO-2 (F14-36-AO-2) 2/18
- CLG-VLV\AO-3 (F14-36-AO-3) 2/18
- MA-T\AI-2 (F14-36-AI-2) 2/18
- DA-T\AI-3 (F14-36-AI-3) 2/18
- ZN-T\AI-4 (F14-36-AI-4) 2/18
- RA-T\AI-7 (F14-36-AI-7) 2/18

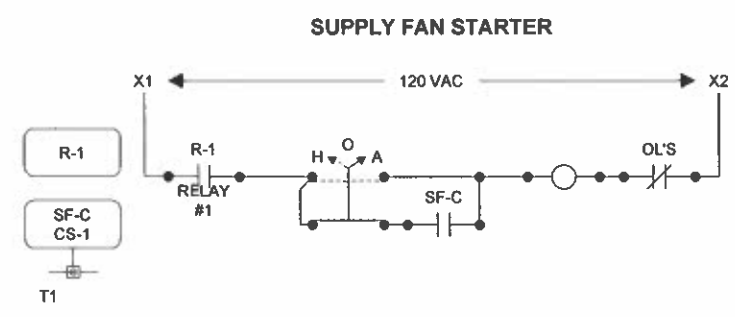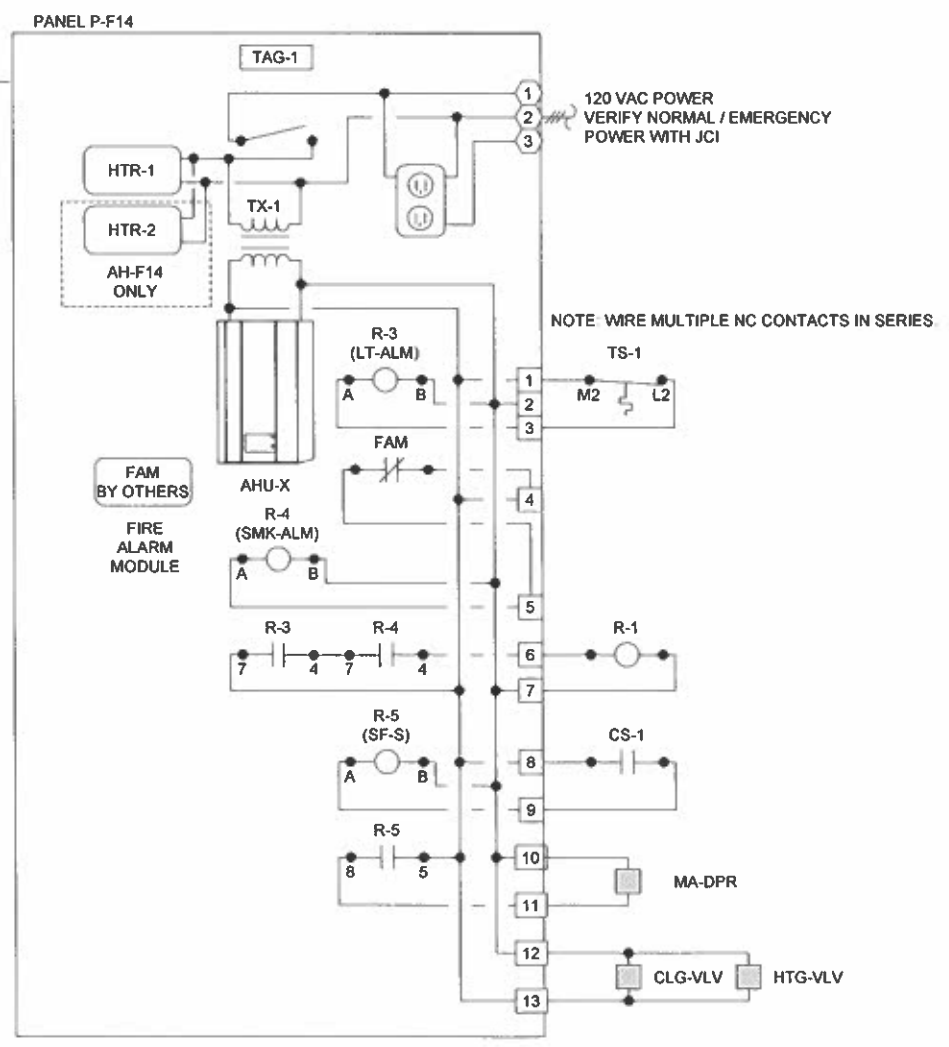

NOTE: SEE POINT SCHEDULE FOR MULTIPLEXED POINTS NOT SHOWN.

PANEL FACE TAGS:  
TAG-1: PANEL P-F14 AH-F14 JCI 9 8075-0508  
TAG-1: PANEL P-T08 AH-T08 JCI 9 8075-0508


REVISION INFORMATION		Drawing Title							
NUMBER		AH-F14 FLOW TYPICAL FOR AH-T08							
DATE		04/12/01		REFERENCE DRAWING		NO.		REVISION-LOCATION	
TIME		02:25 PM		Sales Engineer		Project Manager		Application Engineer	
FILE NAME		ahf14f.vsd		PJS		TP		KJK	
				DRAWN		DATE		APPROVE	
				BY		MLR		DATE	
				Branch Information		CONTRACT NUMBER			
				<b>JOHNSON CONTROLS</b> Systems & Services Division		Wisconsin Area Office 529 N Jackson Street Milwaukee WI 53202 Phone: 414-524-7500 Fax: 414-524-7575		<b>9 8075-0508</b> DRAWING NUMBER <b>22.1</b>	



AH-F14, AH-T08

Single-zone Constant Volume MASP Air Handling System with Economizer Cycle

1. The air handling unit is equipped with supply fan, heating coil, cooling coil, pre-filter, final filter and economizer mixing box.
2. The air handling unit supply fan will be energized through the EMCS on a scheduled basis.
3. Provide for the air handling unit, an economizer logic network controller to position the economizer dampers for maximum economy and sequenced with the heating and cooling valves.
4. Unless the economizer controller is overridden by the warm-up cycle, the controller will verify that the air handling unit is running via a fan proof of flow controller and open the outside air damper to the minimum required ventilation position.
5. When the outside air dry bulb temperature is less than outside air dry bulb setpoint, the economizer dampers will be positioned for maximum free cooling using outside air to meet the cooling demand. The mechanical equipment will only be used if the outside air cannot provide enough free cooling to meet demand.
6. Upon morning start-up of the occupied mode, mechanical cooling will be locked out, the heating coil control valve will fully open, and the outside air damper will move to the closed position, and any interlocked exhaust fans will be de-energized. When the return air temperature reaches the warm-up setpoint, the air handlers will return to normal operation. Provide all relays, solenoids and wiring required to lock out warm-up during normal occupancy hours.
7. The chilled water control valve will modulate in sequence with the heating coil control valve to maintain the discharge air temperature. The discharge air temperature setpoint will be reset based on room temperature.
8. Smoke detectors located in the supply and return ducts will on detection of smoke shut down the air handler supply fan via a hard-wire interlock with fan starters. Smoke detector status will be indicated at the EMCS.
9. Filter replacement will be scheduled based on supply fan runtime.
10. Current switches will be located on the feed to the supply fan to provide status indication (on/off). In off hours DDC controller will command the chilled water two-way control valve and outside air damper to a fully closed position, heating coil control valve to fully open position.
11. The EMCS will monitor and control all points for each air handling unit.
12. In off hours, the supply fan will be cycled intermittently at night by the zone sensor to maintain 60°F.


REVISION INFORMATION	Drawing Title								
NUMBER	SEQUENCE								
DATE	04/12/01	REFERENCE DRAWING		NO.		REVISION LOCATION		EUN	DATE
TIME	02:30 PM	Sales Engineer	PJS	Project Manager	TP	Application Engineer	KJK	BY	MLR
FILE NAME	ahf14s.vsd							DATE	
	Project Title	MILLER PARK ONE BREWERS WAY MILWAUKEE, WI 53214				Business Information Wisconsin Area Office 529 N. Jackson Street Milwaukee WI 53202 Phone: 414-524-7500 Fax: 414-524-7575		CONTRACT NUMBER	9 8075-0508
								DRAWING NUMBER	22.2




AH-L01

**Single-zone Constant Volume MASP Air Handling System with Economizer Cycle**

1. The air handling unit is equipped with supply fan, heating coil, cooling coil, pre-filter, final filter and economizer mixing box.
2. The air handling unit supply fan will be energized through the EMCS on a scheduled basis.
3. Provide for the air handling unit, an economizer logic network controller to position the economizer dampers for maximum economy and sequenced with the heating and cooling valves.
4. Unless the economizer controller is overridden by the warm-up cycle, the controller will verify that the air handling unit is running via a fan proof of flow controller and open the outside air damper to the minimum required ventilation position.
5. When the outside air dry bulb temperature is less than outside air dry bulb setpoint, the economizer dampers will be positioned for maximum free cooling using outside air to meet the cooling demand. The mechanical equipment will only be used if the outside air cannot provide enough free cooling to meet demand.
6. Upon morning start-up of the occupied mode, mechanical cooling will be locked out, the heating coil control valve will fully open, and the outside air damper will move to the closed position, and any interlocked exhaust fans will be de-energized. When the return air temperature reaches the warm-up setpoint, the air handlers will return to normal operation. Provide all relays, solenoids and wiring required to lock out warm-up during normal occupancy hours.
7. The chilled water control valve will modulate in sequence with the heating coil control valve to maintain the discharge air temperature. The discharge air temperature setpoint will be reset based on room temperature.
8. Smoke detectors located in the supply and return ducts will on detection of smoke shut down the air handler supply fan via a hard-wire interlock with fan starters. Smoke detector status will be indicated at the EMCS.
9. Filter replacement will be scheduled based on supply fan runtime.
10. Current switches will be located on the feed to the supply fan to provide status indication (on/off). In off hours DDC controller will command the chilled water two-way control valve and outside air damper to a fully closed position, heating coil control valve to fully open position.
11. The EMCS will monitor and control all points for each air handling unit.
12. In off hours, the supply fan will be cycled intermittently at night by the zone sensor to maintain 60°F.
13. Fintube control to open at OA-T < 50 deg F. Close at OA-T > 50 deg F.


REVISION INFORMATION	Drawing Title								
NUMBER	SEQUENCE		1	RECORD DRAWINGS		6/14/2001	MLR		
DATE		REFERENCE DRAWING	NO.	REVISION LOCATION	ECN	DATE	BY		
06/14/01		Sales Engineer	Project Manager	Application Engineer					
		PJS	TP	KJK					
TIME	Project Title	DRAWN		APPROVED					
04:44 PM	MILLER PARK ONE BREWERS WAY MILWAUKEE, WI 53214	BY	MLR	DATE	BY	DATE	CONTRACT NUMBER		
							9 8075-0508		
FILE NAME		Branch Information		DRAWING NUMBER					
ah01s.vsd		 Wisconsin Area Office 529 N. Jackson Street Milwaukee WI 53202 Phone: 414-524-7500 Fax: 414-524-7575		23.2					
		Systems & Services Division							

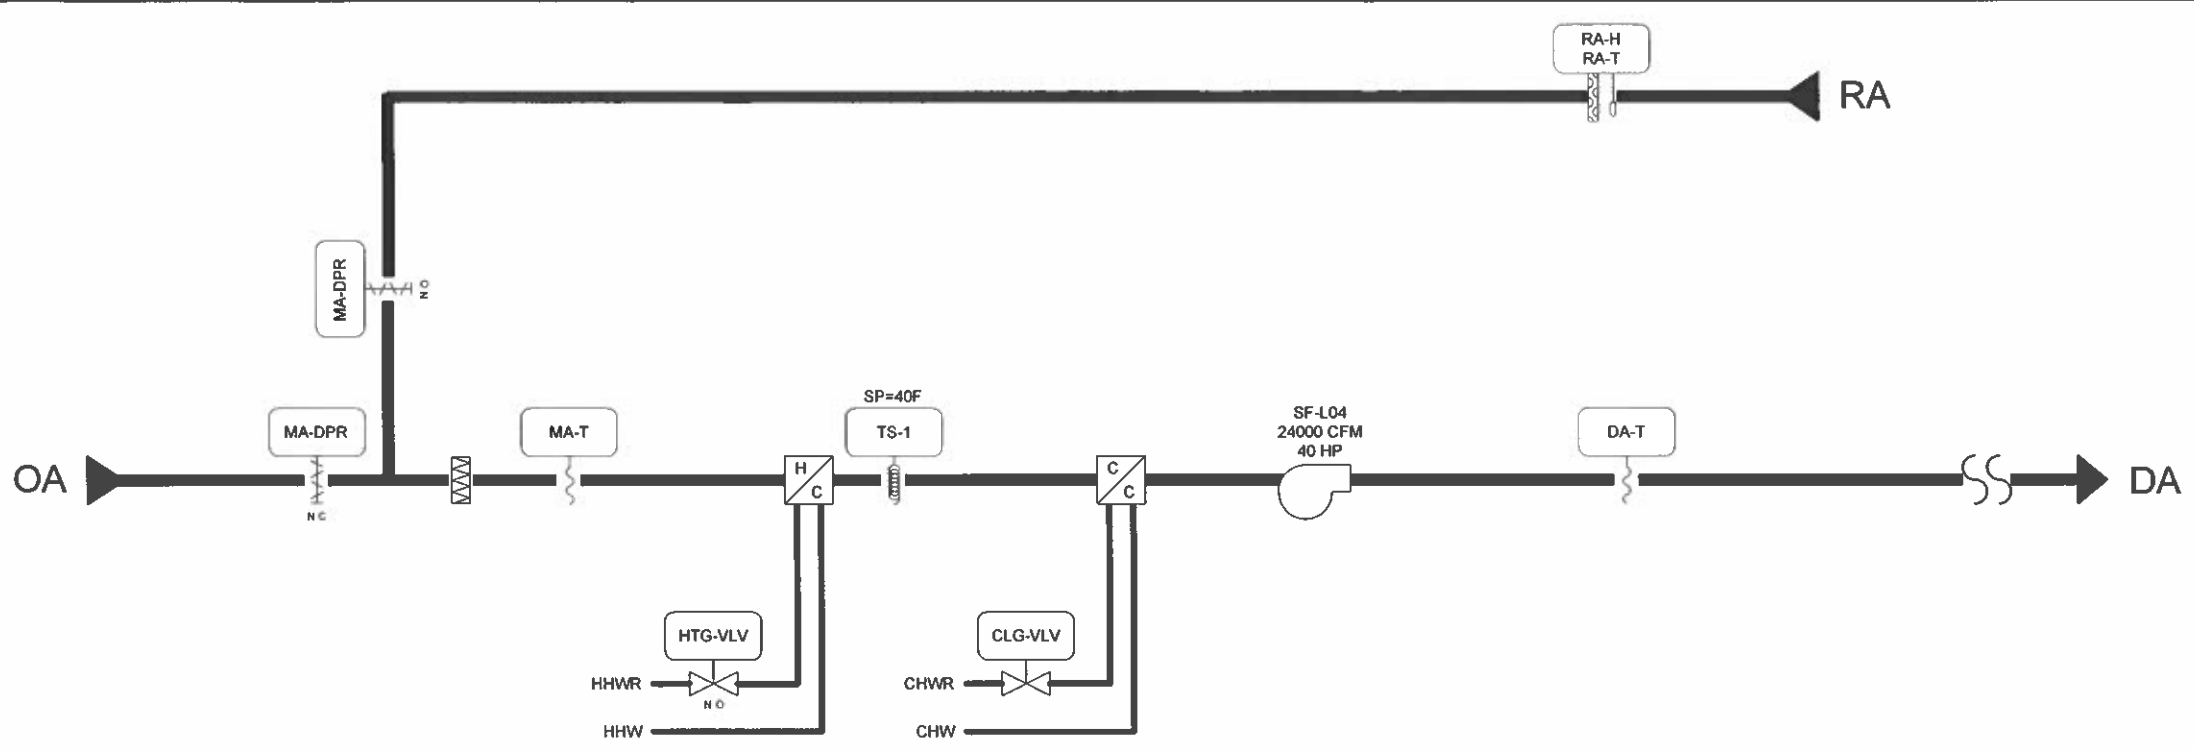


**BILL OF MATERIALS**

Designation	Qty	Part Number	Description
<b>Field Devices:</b>			
DA-T, MA-T	2	TE-6316P-1	SENS.T-NI,0.1%,17' AVG
MA-T, TS-1	1	TE-6001-8	CLIP F/AVG ELEM (10/PKG)
R-1	1	CVR-21C-O	RLY 2SPDT 10-30VAC/DC OR 120VAC,LED @LEC
RA-H, RA-T	1	HE-6310-2	XMTR,RH/T-NI,DUCT,AC/DC
SF-C,CS-1	1	H-735	SW, CURRENT, 1-135A CMND RLY SOLID @VER
TS-1	2	A70HA-1C	STAT LL,20',EL,MAN 15/55F
X-DPR	0		SEE DAMPER SCHEDULE
X-DPR, X-VLV	3	PD-101-1	RESISTOR, 499OHM 1/2W 1%
X-VLV	0		SEE VALVE SCHEDULE
<b>Panel Devices:</b>			
AHU-X	1	AS-AHU103-300	AHU TERMINATION BD/ELECTRONICS IN EWC35
HTR-1	1	EN2-12-P-040-D	PANEL HEATER, 120VAC, ELECTRO-FLEX
P-X	1	M-8100-2424	CONTROL CABINET,STD. FACE
R-3-R-5	3	PD-101-35	RLY BASE 3PDT,11PIN,10A
	3	PD-109-51	RELAY PLUG-IN 3PDT 24VAC
TAG-1	1	M-8000-393	NAMEPLT,LAMICOID,3 LINE

- FROM LAST N2 DEVICE (N2) 3/18 BLU
- TO NEXT N2 DEVICE (N2) 3/18 BLU
- SF-C \ BO-1 (04-148-BO-1) 2/18 VIO
- MA-DPR \ AO-1 (04-148-AO-1) 2/18 TAN
- HTG-VLV \ AO-2 (04-148-AO-2) 2/18 TAN
- CLG-VLV \ AO-3 (04-148-AO-3) 2/18 TAN
- MA-T \ AI-2 (04-148-AI-2) 2/18 YEL
- DA-T \ AI-3 (04-148-AI-3) 2/18 YEL
- RA-T \ AI-7 (04-148-AI-7) 2/18 YEL
- RA-H \ AI-8 (04-148-AI-8) 3/18 YEL

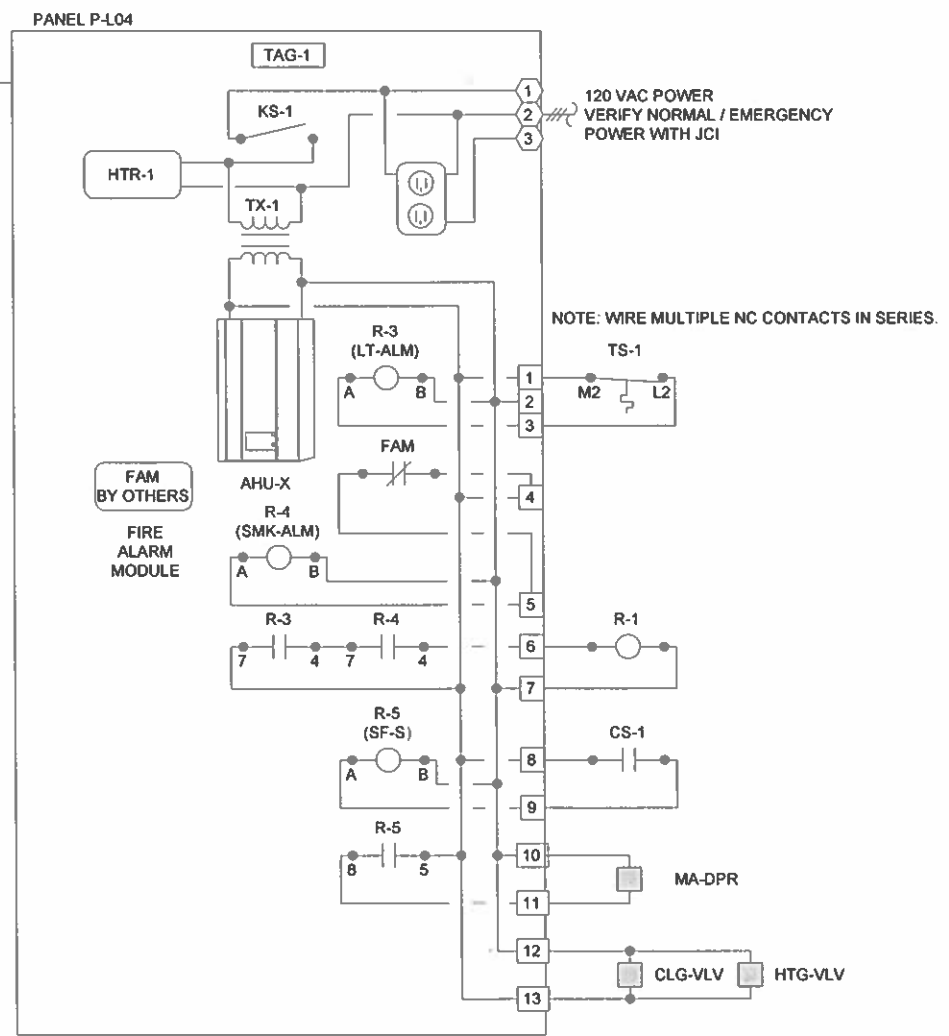

PANEL FACE TAGS:  
TAG-1: PANEL P-L04  
AH-L04  
JCI 9 8075-0508

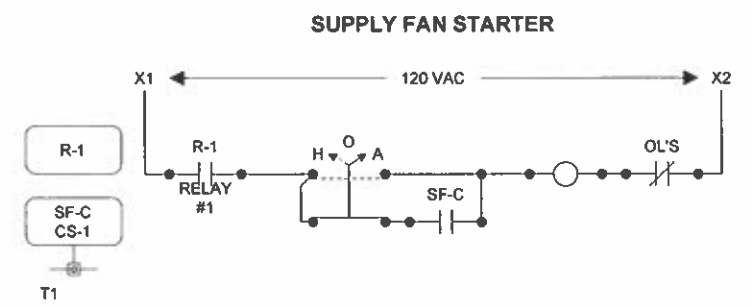


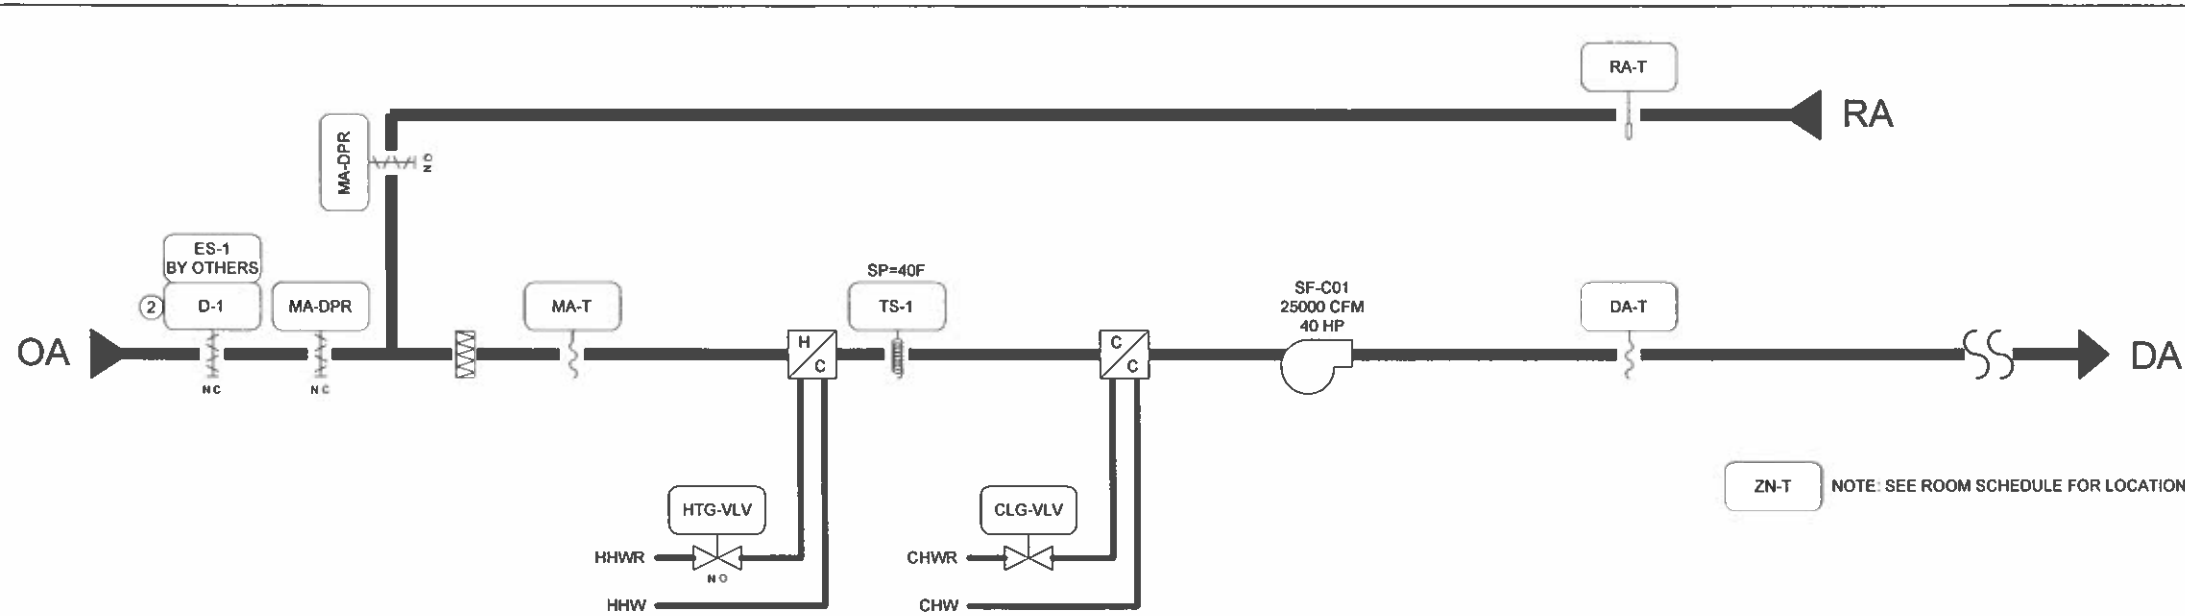
REVISION INFORMATION	Drawing Title				
	NUMBER	AH-L04 FLOW			
DATE	04/12/01				
TIME	02:53 PM				
FILE NAME	ah104f.vsd				
Project Title		MILLER PARK ONE BREWERS WAY MILWAUKEE, WI 53214		CONTRACT NUMBER <b>9 8075-0508</b>	
Sales Engineer		Project Manager		Application Engineer	
PJS		TP		KJK	
By		MLR		DATE	
Branch Information		JOHNSON CONTROLS Systems & Services Division		Wisconsin Area Office 529 N. Jackson Street Milwaukee WI 53202 Phone: 414-524-7500 Fax: 414-524-7575	
DRAWING NUMBER		<b>24.1</b>			

AH-L04

**Multi-zone Constant Volume MASP Air Handling System with Economizer Cycle**

1. The air handling unit is equipped with supply fan, heating coil, cooling coil, pre-filter, final filter and economizer mixing box.
2. The air handling unit supply fan will be energized through the EMCS on a scheduled basis.
3. Provide for the air handling unit, an economizer logic network controller to position the economizer dampers for maximum economy and sequenced with the heating and cooling valves.
4. Unless the economizer controller is overridden by the warm-up cycle, the controller will verify that the air handling unit is running via a fan proof of flow controller and open the outside air damper to the minimum required ventilation position.
5. When the outside air dry bulb temperature is less than outside air dry bulb setpoint, the economizer dampers will be positioned for maximum free cooling using outside air to meet the cooling demand. The mechanical cooling equipment will only be used if the outside air cannot provide enough free cooling to meet demand.
6. Upon morning start-up of the occupied mode, mechanical cooling will be locked out, the heating coil control valve will fully open, the outside air damper will move to the closed position, and any interlocked exhaust fans will be de-energized. When the return air temperature reaches the warm-up setpoint, the air handler will return to normal operation.
7. Each zone sensor or group of zone sensors modulate the reheat coil hot water control valve to satisfy the required room temperature. See the Reheat Coil sequence of operation.
8. The chilled and hot water control valves will modulate in sequence cycle, to maintain the discharge air temperature. The discharge air temperature setpoint will be reset based on the operation of the zone reheat coil control valves and return air humidity.
9. Smoke detectors located in the supply and return ducts will on detection of smoke shut down the air handler supply fan via a hard-wire interlock with fan starters. Smoke detector status will be indicated at the EMCS.
10. Filter replacement will be scheduled based on supply fan runtime.
11. Current switches will be located on the feed to the supply fan to provide status indication (on/off). In off hours DDC controller will command the chilled water two-way control valve and outside air damper to a fully closed position, heating coil control valve to fully open position.
12. The EMCS will monitor and control all points for each air handling unit.
13. In off hours, the supply fan will be cycled intermittently at night by the zone sensor to maintain 60°F.



REVISION INFORMATION	Drawing Title								
NUMBER	SEQUENCE								
DATE	04/12/01	REFERENCE DRAWING	NO	REVISION LOCATION	ECN	DATE	BY		
TIME	02:59 PM	Sales Engineer	Project Manager	Application Engineer	BY	MLR	DATE	BY	APPROVED
FILE NAME	ah104s.vsd	PJS	TP	KJK					
	Project Title	MILLER PARK ONE BREWERS WAY MILWAUKEE, WI 53214				Branch Information Wisconsin Area Office 529 N. Jackson Street Milwaukee WI 53202 Phone: 414-524-7500 Fax: 414-524-7575		CONTRACT NUMBER <b>9 8075-0508</b>	
								DRAWING NUMBER <b>24.2</b>	



**BILL OF MATERIALS**

Designation	Qty	Part Number	Description
<b>Field Devices:</b>			
DA-T, MA-T	2	TE-6316P-1	SENS, T-Ni, 0.1%, 17" AVG
MA-T, TS-1	1	TE-6001-8	CLIP F/AVG ELEM (10/PKG)
R-1	1	CVR-21C-O	RLY 2SPDT, 10-30VAC/DC OR 120VAC, LED @ LEC
RA-T	1	TE-6311P-1	SENS, T-Ni, 0.1%, 8" DUCT
SF-C, CS-1	1	H-735	SW, CURRENT, 1-135A CMND RLY SOLID @ VER
TS-1	2	A70HA-1C	STAT, LL 20" EL, MAN, 15/55F
X-DPR	0		SEE DAMPER SCHEDULE
X-DPR, X-VLV	3	PD-101-1	RESISTOR, 4990HM 1/2W 1%
X-VLV	0		SEE VALVE SCHEDULE
ZN-T	1	TE-6314P-1	SENS, T-Ni, 0.1%, RM
<b>Panel Devices:</b>			
AHU-X	1	AS-AHU103-300	AHU TERMINATION BD/ELECTRONICS IN EWC35
HTR-x	2	EN2-12-P-040-D	PANEL HEATER, 120VAC, ELECTRO-FLEX
P-X	2	EN-EXP101-0	EXPANSION COVER AND BACKBONE
	1	M-8100-3042	PANEL, STANDARD, 22 UNITS
R-3-R-6	4	PD-101-35	RLY BASE, 3PDT, 11PIN, 10A
	4	PD-109-51	RELAY PLUG-IN 3PDT 24VAC
TAG-1	1	M-8000-393	NAMEPLT, LAM/COID, 3 LINE
TX-x	2	PD-114-2	TRANSFORMER 100VA, 120/24

ZN-T NOTE: SEE ROOM SCHEDULE FOR LOCATION.

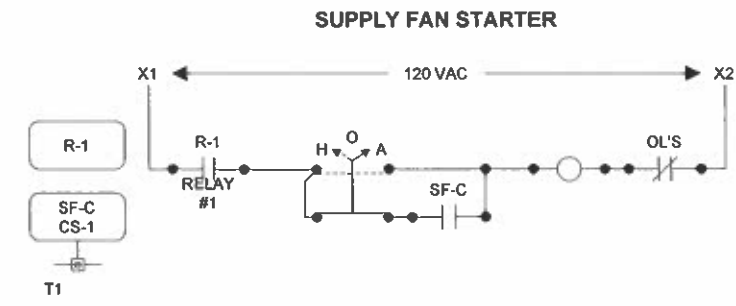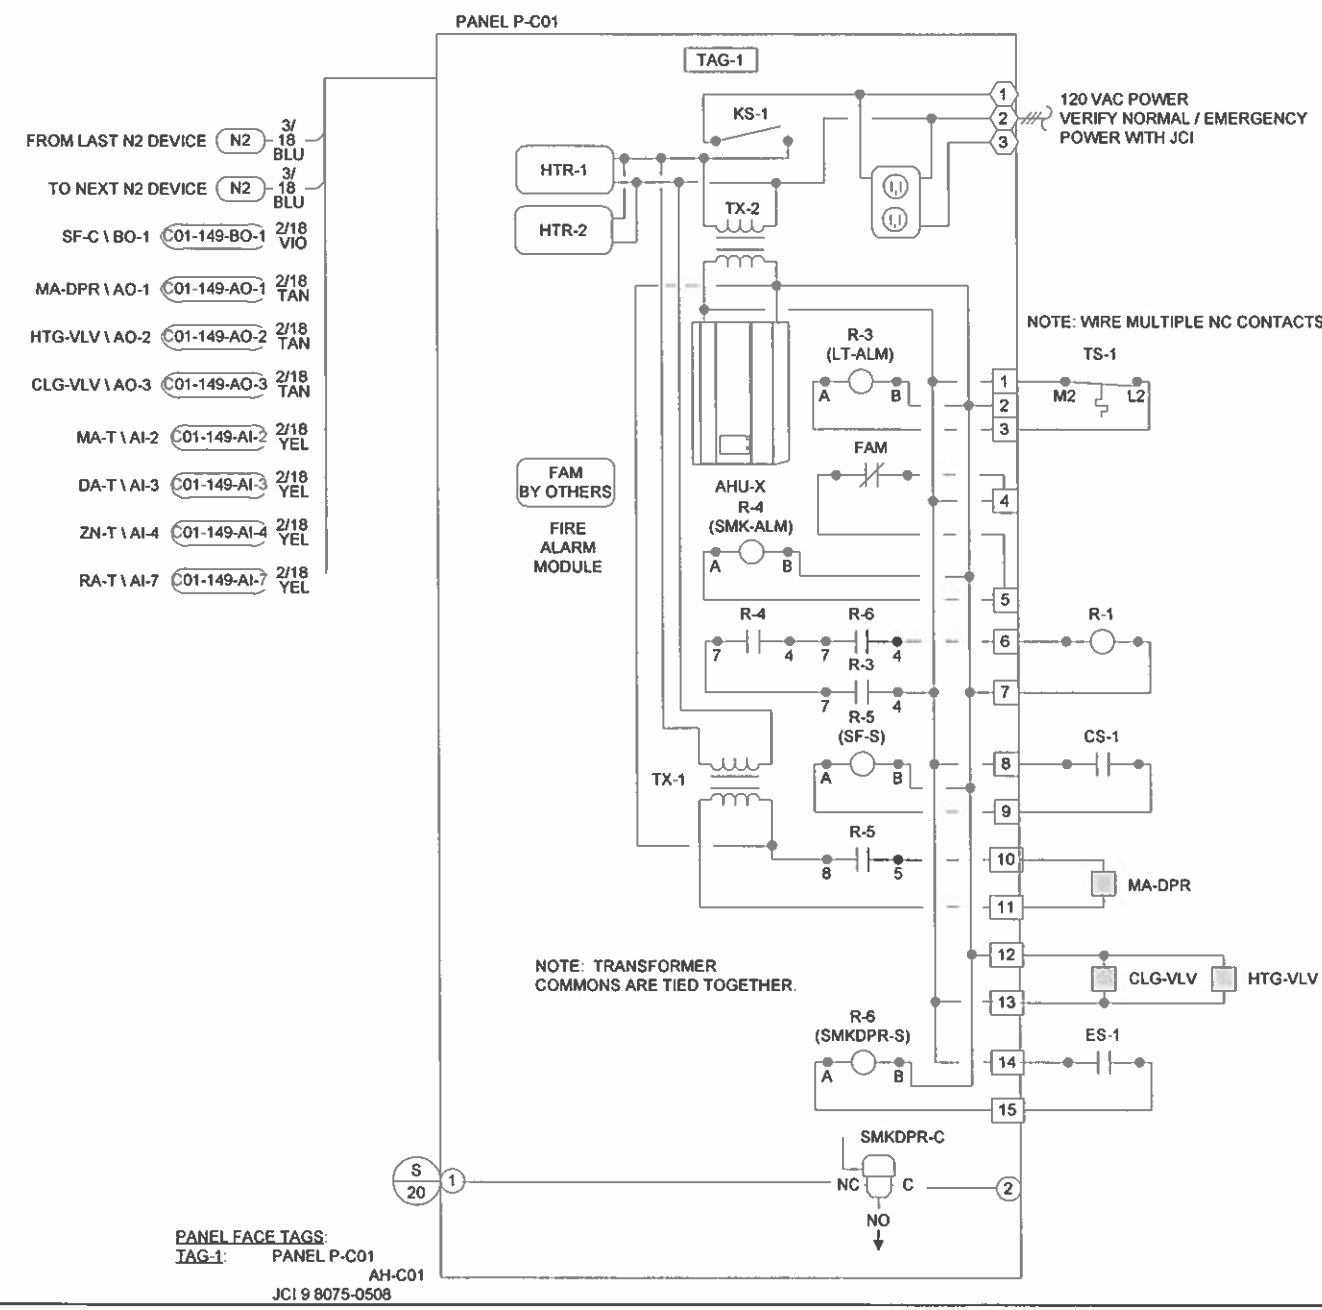


PANEL FACE TAGS:  
TAG-1: PANEL P-C01  
AH-C01  
JCI 9 8075-0508

REVISION INFORMATION	Drawing Title				
NUMBER	AH-C01 FLOW				
DATE	04/13/01	REFERENCE DRAWING	NO	REVISION-LOCATION	ECH
TIME	07:26 AM	Project Manager	Application Engineer	DATE	BY
FILE NAME	ahc01f.vsd	PJS	TP	KJK	MLR
Project Title		Branch Information		CONTRACT NUMBER	
MILLER PARK ONE BREWERS WAY MILWAUKEE, WI 53214		Wisconsin Area Office 529 N. Jackson Street Milwaukee WI 53202 Phone: 414-524-7500 Fax: 414-524-7575		9 8075-0508	
		JOHNSON CONTROLS Systems & Services Division		DRAWING NUMBER 25.1	

AH-C01

**Single-zone Constant Volume MASP Air Handling System with Economizer Cycle**

1. The air handling unit is equipped with supply fan, heating coil, cooling coil, pre-filter, final filter and economizer mixing box.
2. The air handling unit supply fan will be energized through the EMCS on a scheduled basis.
3. Provide for the air handling unit, an economizer logic network controller to position the economizer dampers for maximum economy and sequenced with the heating and cooling valves.
4. Unless the economizer controller is overridden by the warm-up cycle, the controller will verify that the air handling unit is running via a fan proof of flow controller and open the outside air damper to the minimum required ventilation position.
5. When the outside air dry bulb temperature is less than outside air dry bulb setpoint, the economizer dampers will be positioned for maximum free cooling using outside air to meet the cooling demand. The mechanical equipment will only be used if the outside air cannot provide enough free cooling to meet demand.
6. Upon morning start-up of the occupied mode, mechanical cooling will be locked out, the heating coil control valve will fully open, and the outside air damper will move to the closed position, and any interlocked exhaust fans will be de-energized. When the return air temperature reaches the warm-up setpoint, the air handlers will return to normal operation. Provide all relays, solenoids and wiring required to lock out warm-up during normal occupancy hours.
7. The chilled water control valve will modulate in sequence with the heating coil control valve to maintain the discharge air temperature. The discharge air temperature setpoint will be reset based on room temperature.
8. Smoke detectors located in the supply and return ducts will on detection of smoke shut down the air handler supply fan via a hard-wire interlock with fan starters. Smoke detector status will be indicated at the EMCS.
9. Filter replacement will be scheduled based on supply fan runtime.
10. Current switches will be located on the feed to the supply fan to provide status indication (on/off). In off hours DDC controller will command the chilled water two-way control valve and outside air damper to a fully closed position, heating coil control valve to fully open position.
11. The EMCS will monitor and control all points for each air handling unit.
12. In off hours, the supply fan will be cycled intermittently at night by the zone sensor to maintain 60°F.

REVISION INFORMATION	Drawing Title								
NUMBER	SEQUENCE								
DATE	04/13/01	REFERENCE DRAWING	NO.	REVISION LOCATION	ECN	DATE	BY		
TIME	07:29 AM	Ball's Engineer	Project Manager	Application Engineer					
FILE NAME	ahc01s.vsc	PJS	TP	KJK	BY	MLR	DATE	BY	DATE
	Project Title				Branch Indiana Wisconsin Area Office 529 N. Jackson Street Milwaukee WI 53202 Phone: 414-524-7500 Fax: 414-524-7575		CONTRACT NUMBER <b>9 8075-0508</b>		
	MILLER PARK ONE BREWERS WAY MILWAUKEE, WI 53214	Systems & Services Division					DRAWING NUMBER <b>25.2</b>		




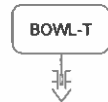
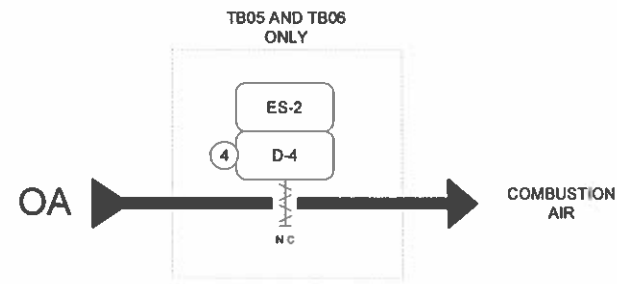


**AH-C02, AH-T07**

**Multi-zone Constant Volume MASP Air Handling System with Economizer Cycle**

1. The air handling unit is equipped with supply fan, heating coil, cooling coil, pre-filter, final filter and economizer mixing box.
2. The air handling unit supply fan will be energized through the EMCS on a scheduled basis.
3. Provide for the air handling unit, an economizer logic network controller to position the economizer dampers for maximum economy and sequenced with the heating and cooling valves.
4. Unless the economizer controller is overridden by the warm-up cycle, the controller will verify that the air handling unit is running via a fan proof of flow controller and open the outside air damper to the minimum required ventilation position.
5. When the outside air dry bulb temperature is less than outside air dry bulb setpoint, the economizer dampers will be positioned for maximum free cooling using outside air to meet the cooling demand. The mechanical cooling equipment will only be used if the outside air cannot provide enough free cooling to meet demand.
6. Upon morning start-up of the occupied mode, mechanical cooling will be locked out, the heating coil control valve will fully open, the outside air damper will move to the closed position, and any interlocked exhaust fans will be de-energized. When the return air temperature reaches the warm-up setpoint, the air handler will return to normal operation.
7. Each zone sensor or group of zone sensors modulate the reheat coil hot water control valve to satisfy the required room temperature. See the Reheat Coil sequence of operation.
8. The chilled and hot water control valves will modulate in sequence to maintain the discharge air temperature. The discharge air temperature setpoint will be reset based on the operation of the zone reheat coil control valves and return air humidity.
9. Smoke detectors located in the supply and return ducts will on detection of smoke shut down the air handler supply fan via a hard-wire interlock with fan starters. Smoke detector status will be indicated at the EMCS.
10. Filter replacement will be scheduled based on supply fan runtime.
11. Current switches will be located on the feed to the supply fan to provide status indication (on/off). In off hours DDC controller will command the chilled water two-way control valve and outside air damper to a fully closed position, heating coil control valve to fully open position.
12. The EMCS will monitor and control all points for each air handling unit.
13. In off hours, the supply fan will be cycled intermittently at night by the zone sensor to maintain 60°F.


REVISION INFORMATION	Drawing Title								
NUMBER	<b>SEQUENCE</b>								
DATE	<b>04/13/01</b>	REFERENCE DRAWING	NO.	REVISION-LOCATION	ECH	DATE	BY		
TIME	<b>07:45 AM</b>	Sales Engineer	Project Manager	Application Engineer					
FILE NAME	<b>ahc02s.vsd</b>	PJS	TP	KJK	BY	MLR	DATE	BY	DATE
	Project Title			Branch Information Wisconsin Area Office 529 N Jackson Street Milwaukee WI 53202 Phone: 414-524-7500 Fax: 414-524-7575		CONTRACT NUMBER <b>9 8075-0508</b>		DRAWING NUMBER <b>26.2</b>	
	<b>MILLER PARK ONE BREWERS WAY MILWAUKEE, WI 53214</b>	Systems & Services Division							




**BILL OF MATERIALS**

Designation	Qty	Part Number	Description
<b>AH-T01 AND AH-T02</b>			
Field Devices:			
BOWL-T	1	TE-6000-1	SENS,T-Ni,1.0%
	1	TE-6001-2	MTG,OAT SENS (CONDULET)
DA-T	1	TE-6001-8	CLIP F/AVG ELEM (10/PKG)
	1	TE-6316P-1	SENS,T-Ni,0.1%,17' AVG
R-1-3	1	CVR-21C-O	RLY 2SPDT,10-30VAC/DC OR 120VAC,LED @LEC
SF-S	1	H-735	SW, CURRENT, 1-135A CMND RLY SOLID @VER
<b>AH-TB05 AND AH-TB06</b>			
Field Devices:			
BOWL-T	1	TE-6000-1	SENS,T-Ni,1.0%
	1	TE-6001-2	MTG,OAT SENS (CONDULET)
D-x	0		SEE DAMPER SCHEDULE
DA-T	1	TE-6001-8	CLIP F/AVG ELEM (10/PKG)
	1	TE-6316P-1	SENS,T-Ni,0.1%,17' AVG
ES-1,2	1	TS-470	DAMPER POSITION SWITCH - KELE
R-1-3	1	CVR-21C-O	RLY 2SPDT,10-30VAC/DC OR 120VAC,LED @LEC
SF-S	1	H-735	SW, CURRENT, 1-135A CMND RLY SOLID @VER



**SUPPLY FAN STARTER**

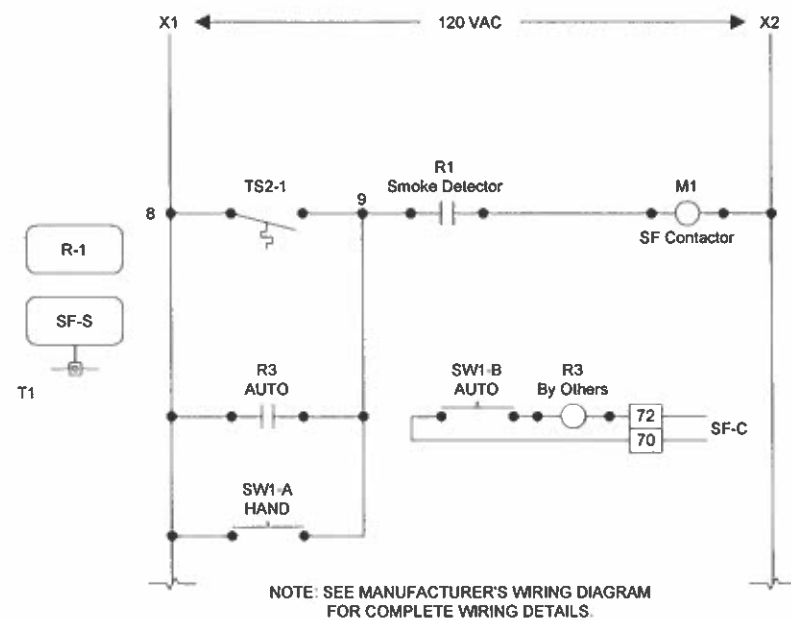

**PARTIAL GAS-FIRED HEATER WIRING**

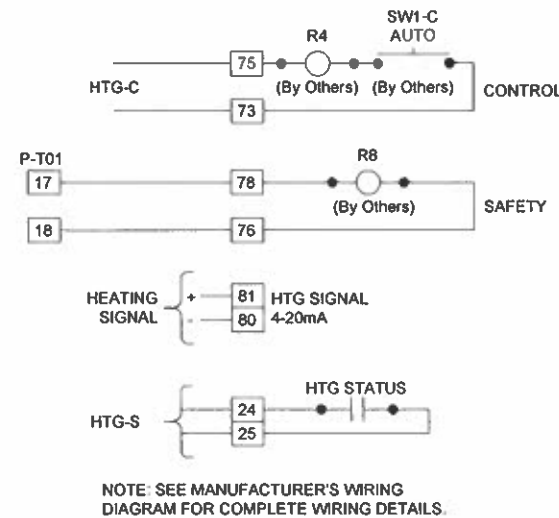


REVISION INFORMATION		Drawing Title									
NUMBER		AH-T01 FLOW TYPICAL FOR AH-T02, AH-TB05, AH-TB06									
DATE		04/13/01		REFERENCE DRAWING		NO.		REVISION-LOCATION		ECN DATE BY	
TIME		08:21 AM		Sales Engineer		Project Manager		Application Engineer		DRAWN APPROVED	
FILE NAME		aht01f.vsd		PJS		TP		KJK		BY MLR DATE	
		Project Title		MILLER PARK ONE BREWERS WAY MILWAUKEE, WI 53214		Branch Information		CONTRACT NUMBER		9 8075-0508	
				JOHNSON CONTROLS Systems & Services Division		Wisconsin Area Office 529 N Jackson Street Milwaukee WI 53202 Phone: 414-524-7500 Fax: 414-524-7575		DRAWING NUMBER		27.1	

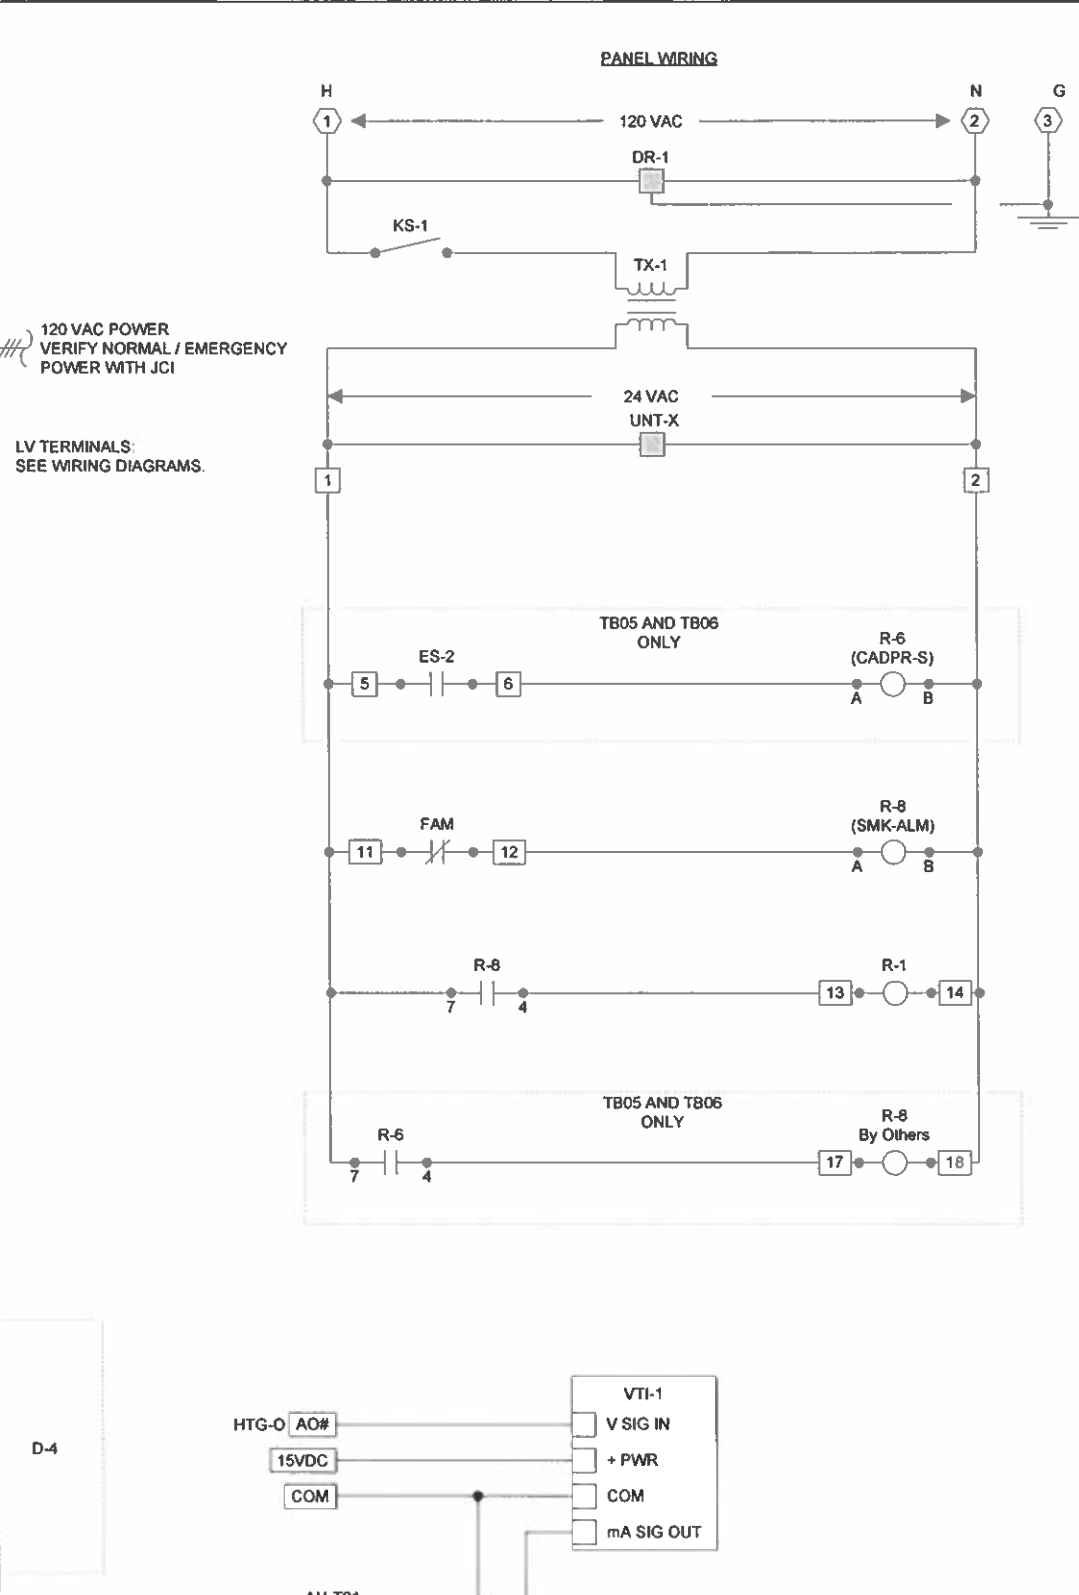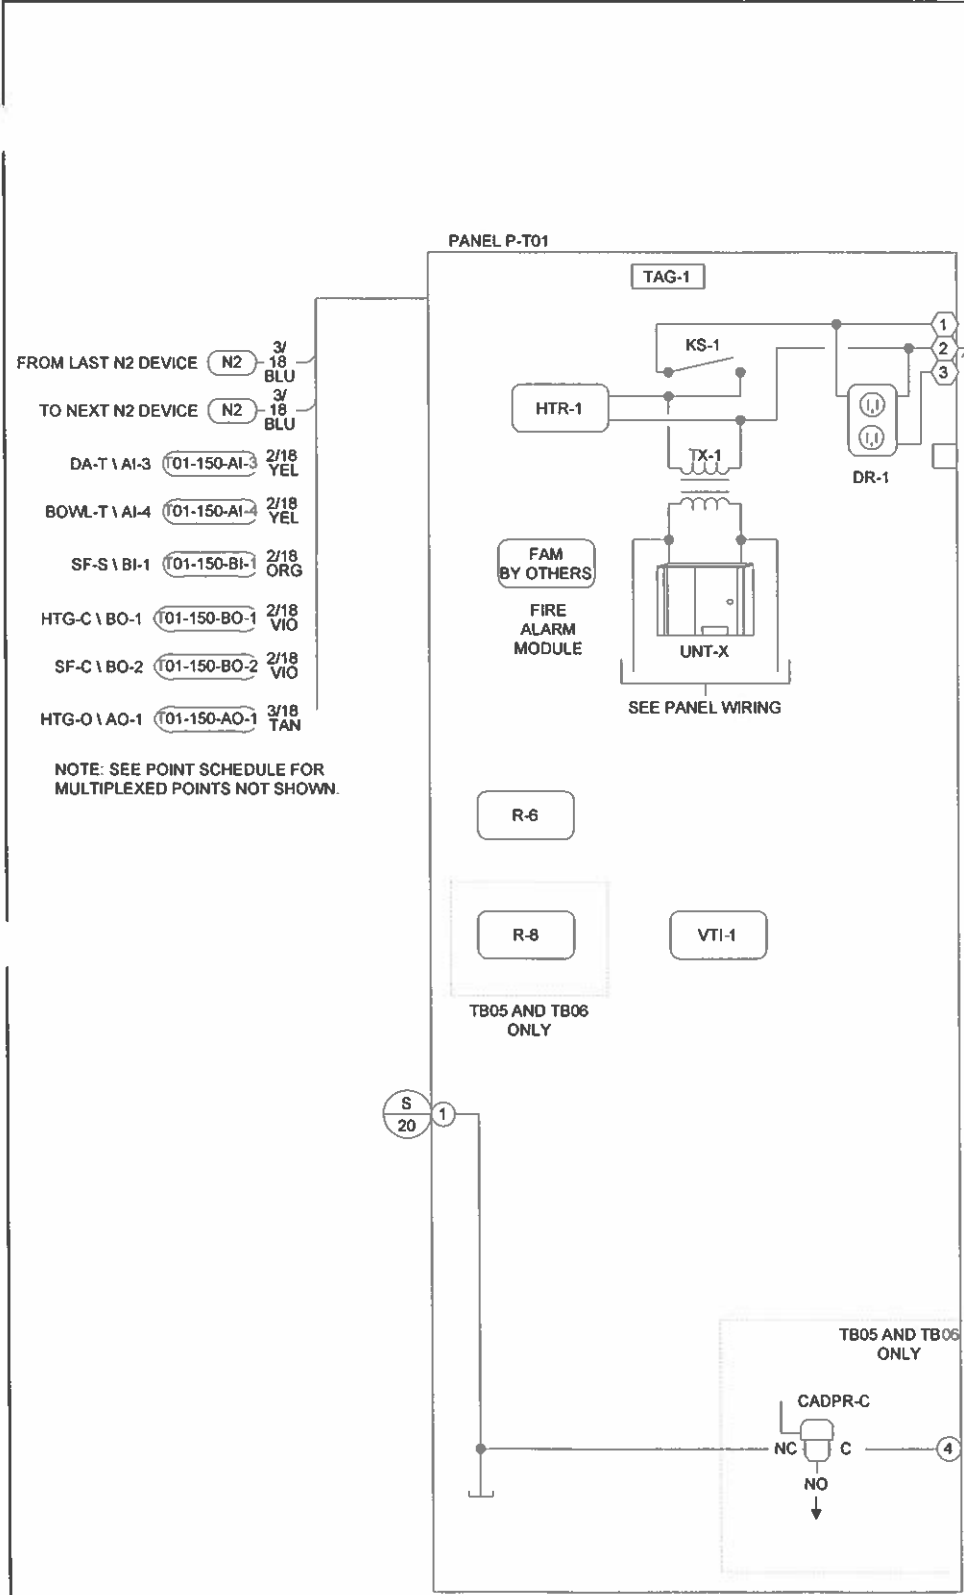

**BILL OF MATERIALS**

Designation	Qty	Part Number	Description
<b>AH-T01 AND AH-T02</b>			
Panel Devices:			
DR-1	1	PD-117-2	RECEPTACLE, DUPLEX, UL WHT
	1	PD-121-1	RECEPTACLE, DUPLEX, CVR
	1	PD-121-6	HANDY BOX 2 IN
HTR-1	1	EN2-12-P-040-D	PANEL HEATER, 120VAC, ELECTRO-FLEX
KS-1	1	PD-112-12	KNIFE SWITCH BLOCK
P-x	1	M-8100-2424	PANEL, STANDARD, 9 UNITS
R-8	1	PD-101-35	RLY BASE, 3PDT, 11PIN, 10A
	1	PD-109-51	RELAY PLUG-IN 3PDT 24VAC
TAG-1	1	M-8000-393	NAMEPLT, LAMICOID, 3 LINE
TX-x	1	PD-114-2	TRANSFORMER 100VA, 120/24
UNT-X	1	AS-UNT141-1	UNITARY CONTRLLR, 6 ISO BO W/SCREW TERM.
VTI-1	1	VTI-1	VOLTAGE/CURRENT CONVERTER 1-10V/4-20mA, KELE
<b>AH-TB05 AND AH-TB06</b>			
Panel Devices:			
DR-1	1	PD-117-2	RECEPTACLE, DUPLEX, UL WHT
	1	PD-121-1	RECEPTACLE, DUPLEX, CVR
	1	PD-121-6	HANDY BOX 2 IN
HTR-1	1	EN2-12-P-040-D	PANEL HEATER, 120VAC, ELECTRO-FLEX
KS-1	1	PD-112-12	KNIFE SWITCH BLOCK
P-x	1	M-8100-2424	PANEL, STANDARD, 9 UNITS
R-6-8	2	PD-101-35	RLY BASE, 3PDT, 11PIN, 10A
	2	PD-109-51	RELAY PLUG-IN 3PDT 24VAC
TAG-1	1	M-8000-393	NAMEPLT, LAMICOID, 3 LINE
TX-x	1	PD-114-2	TRANSFORMER 100VA, 120/24
UNT-X	1	AS-UNT141-1	UNITARY CONTRLLR, 6 ISO BO W/SCREW TERM.
VTI-1	1	VTI-1	VOLTAGE/CURRENT CONVERTER 1-10V/4-20mA, KELE
X DPR-C	1	V11HGA-100	3-W SOLENOID, W/OV, 24 VAC

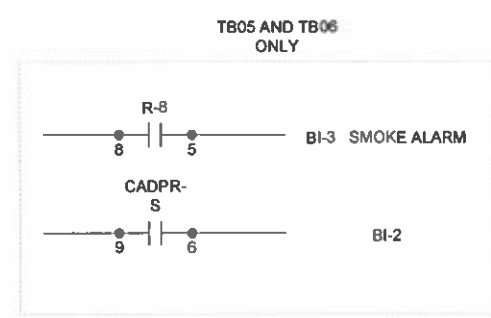


**PANEL FACE TAGS:**  
TAG-1: PANEL P-T01 AH-T01 JCI 9 8075-0508

**PANEL FACE TAGS:**  
TAG-1: PANEL P-T02 AH-T02 JCI 9 8075-0508


**PANEL FACE TAGS:**  
TAG-1: PANEL P-TB05 AH-TB05 JCI 9 8075-0508

**PANEL FACE TAGS:**  
TAG-1: PANEL P-TB06 AH-TB06 JCI 9 8075-0508

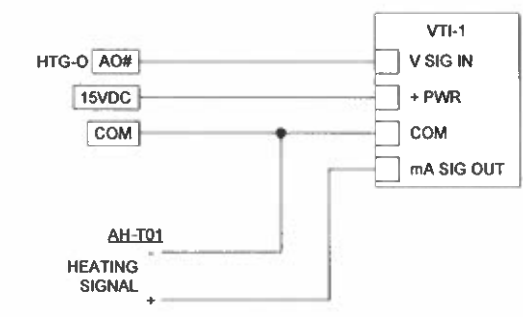

REVISION INFORMATION	Drawing Title				
NUMBER	AH-T01 PANEL TYPICAL FOR AH-T02, AH-TB05, AH-TB06				
DATE	04/13/01	REFERENCE DRAWING	NO.	REVISION LOCATION	ECN
TIME	08:50 AM	Sales Engineer	Project Manager	Application Engineer	DATE
FILE NAME	aht01p.vsd	PJS	TP	KJK	DATE
Project Title		BY MLR		APPROVED	
MILLER PARK ONE BREWERS WAY MILWAUKEE, WI 53214		DATE		DATE	
JOHNSON CONTROLS Systems & Services Division		Branch Information		CONTRACT NUMBER	
		Wisconsin Area Office 529 N Jackson Street Milwaukee WI 53202 Phone: 414-524-7500 Fax: 414-524-7575		9 8075-0508	
				DRAWING NUMBER	
				27.2	




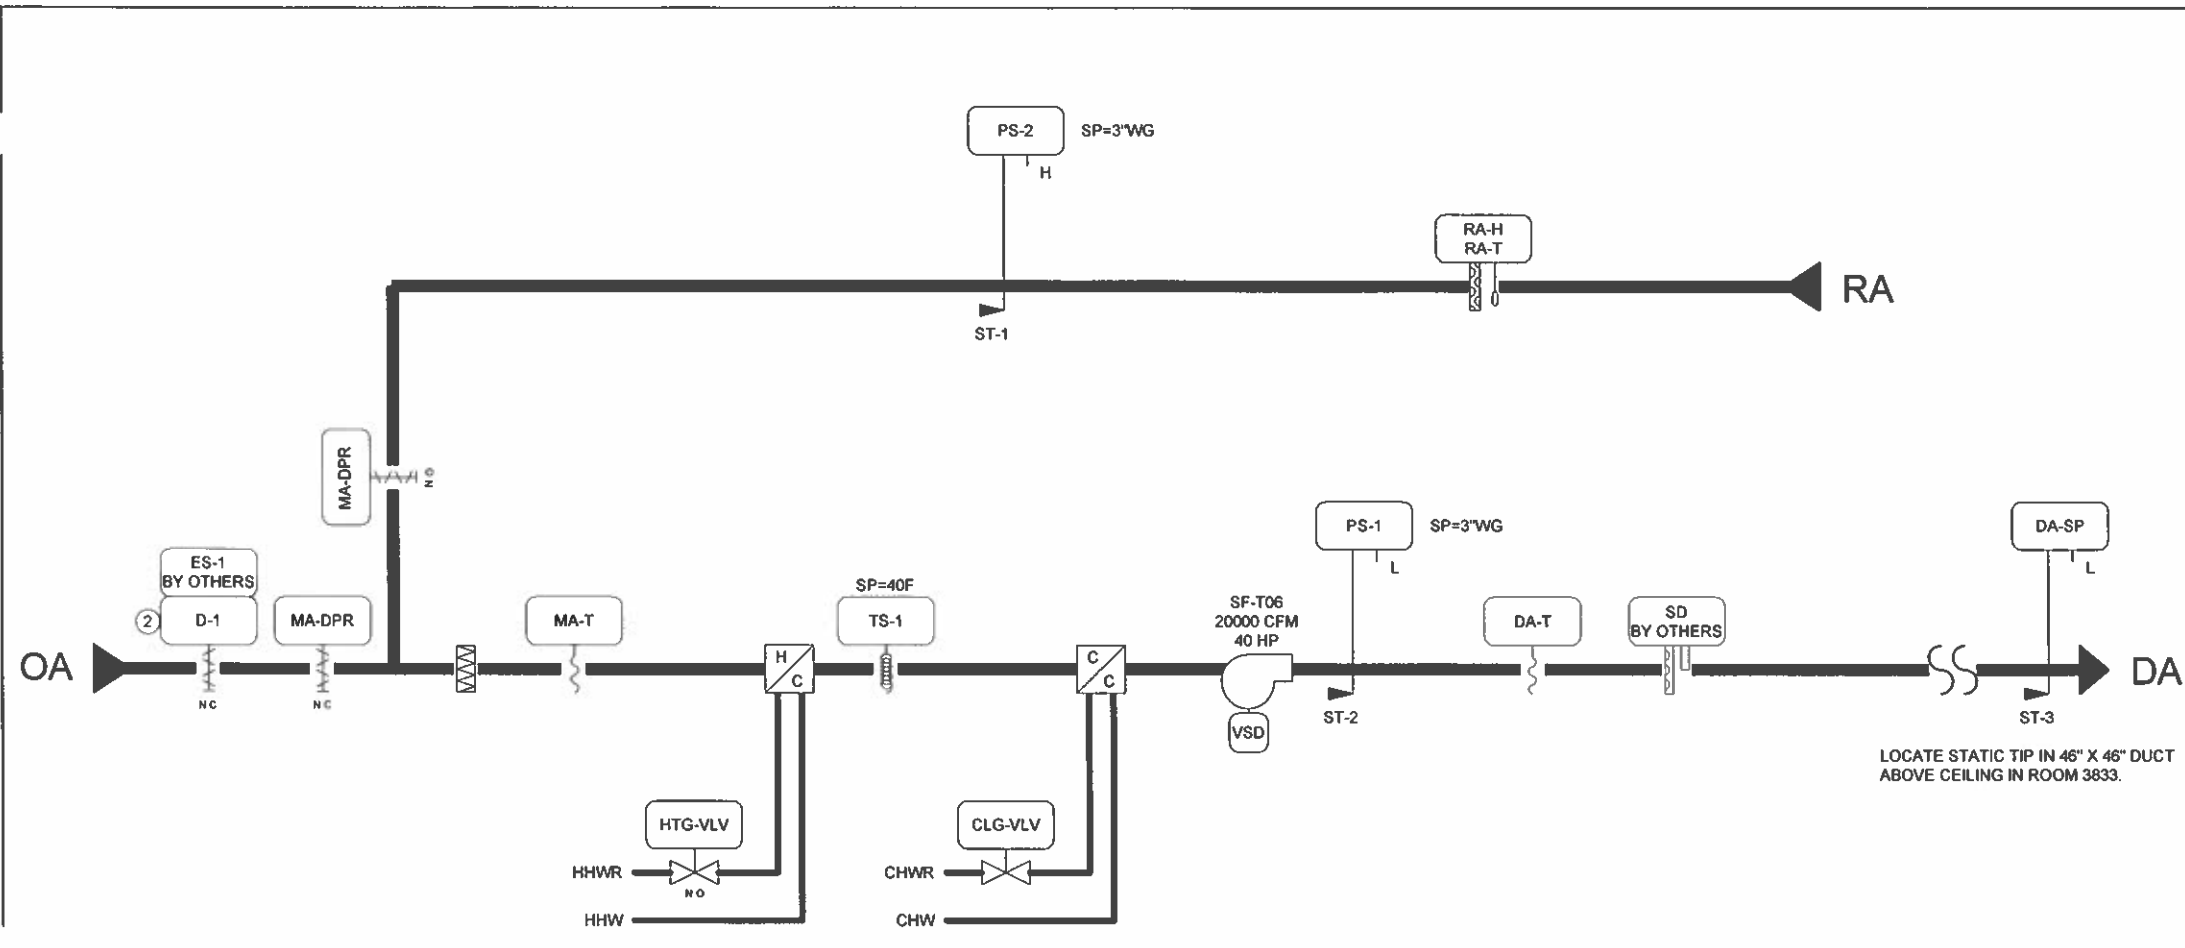

**BILL OF MATERIALS**

Designation	Qty	Part Number	Description
<b>Field Devices:</b>			
DA-SP	1	DPT-2640-26	XDUCR DP -5.0/5.0' 0-5V
DA-T, MA-T	2	TE-6316P-1	SENS,T-NI,0.1%,17' AVG
DA-T, MA-T, TS-1	1	TE-6001-8	CLIP F/AVG ELEM (10/PKG)
PS-x	2	AFS-460	SW, AIR FLOW, SPST-NC RESET 05-12" @CLE
R-1	1	CVR-21C-0	RLY 2SPDT,10-30VAC/DC OR 120VAC,LED @LEC
RA-H, RA-T	1	HE-6310-2	XMTR,RH/T-NI,DUCT,AC/DC
SF-C,CS-1	1	H-735	SW, CURRENT, 1-135A CMND RLY SOLID @VER
ST-x	3	A520-2-A-1	8" STATIC PROBE, ALUM, 1/4" TUBE @MAMAC
TS-1	2	A70HA-1C	STAT,I,LL,20' EL,MAN,15/55F
X-DPR, X-VLV,XF-O	4	PD-101-1	RESISTOR, 4990HM 1/2W 1%
X-DPR, XF-O, D-1	0	DAMPER	SEE DAMPER SCHEDULE
X-VLV	0	VALVE	SEE VALVE SCHEDULE


**SUPPLY FAN VARIABLE SPEED DRIVE**

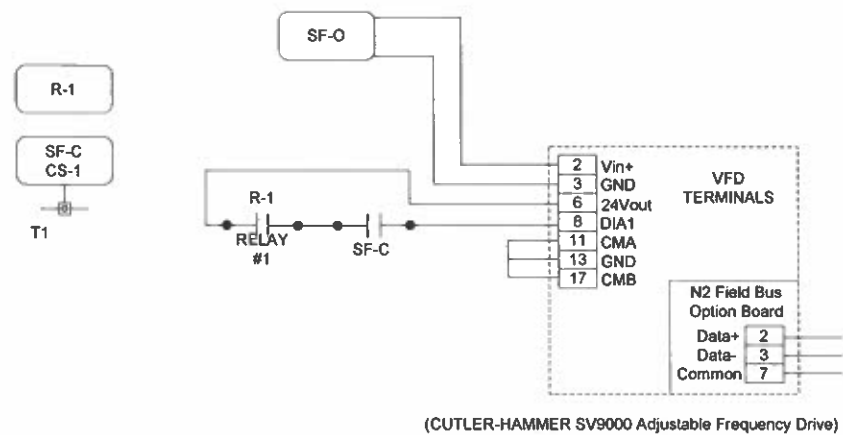

REVISION INFORMATION	Drawing Title	VFD Replaced Inlet Vanes		2003-14	2003 SRF Project	DAM
NUMBER	<b>AH-T06 FLOW</b>					
DATE	11/06/09	Project Manager	Application Engineer	DATE	BY	APPROVED
TIME	09:13 AM	PJS	TP	KJK	MLR	
FILE NAME	aht06f2.vsd	Project Title		Branch Information		CONTRACT NUMBER
		<b>MILLER PARK ONE BREWERS WAY MILWAUKEE, WI 53214</b>		<b>JOHNSON CONTROLS</b> Wisconsin Area Office 529 N. Jackson Street Milwaukee WI 53202 Phone: 414-524-7500 Fax: 414-524-7575		<b>9 8075-0508</b>
				Systems & Services Division		<b>28.1</b>

**BILL OF MATERIALS**

Designation	Qty	Part Number	Description
Panel Devices:			
AHU-X	1	AS-AHU103-300	AHU TERMINATION BD/ELECTRONICS IN EWC35
HTR-x	2	EN2-12-P-040-D	PANEL HEATER, 120VAC, ELECTRO-FLEX
P-X	1	M-8100-2430	PANEL STANDARD, 12 UNITS
R-3-R-8	6	PD-101-35	RLY BASE, 3PDT, 11PIN, 10A
	6	PD-109-51	RELAY PLUG-IN 3PDT 24VAC
SMKDPR-C	1	V11HGA-100	3-W SOLENOID, W/OV, 24 VAC
TAG-1	1	M-8000-393	NAMEPLT, LAMICOID, 3 LINE
TX-1	1	PD-114-2	TRANSFORMER 100VA, 120/24

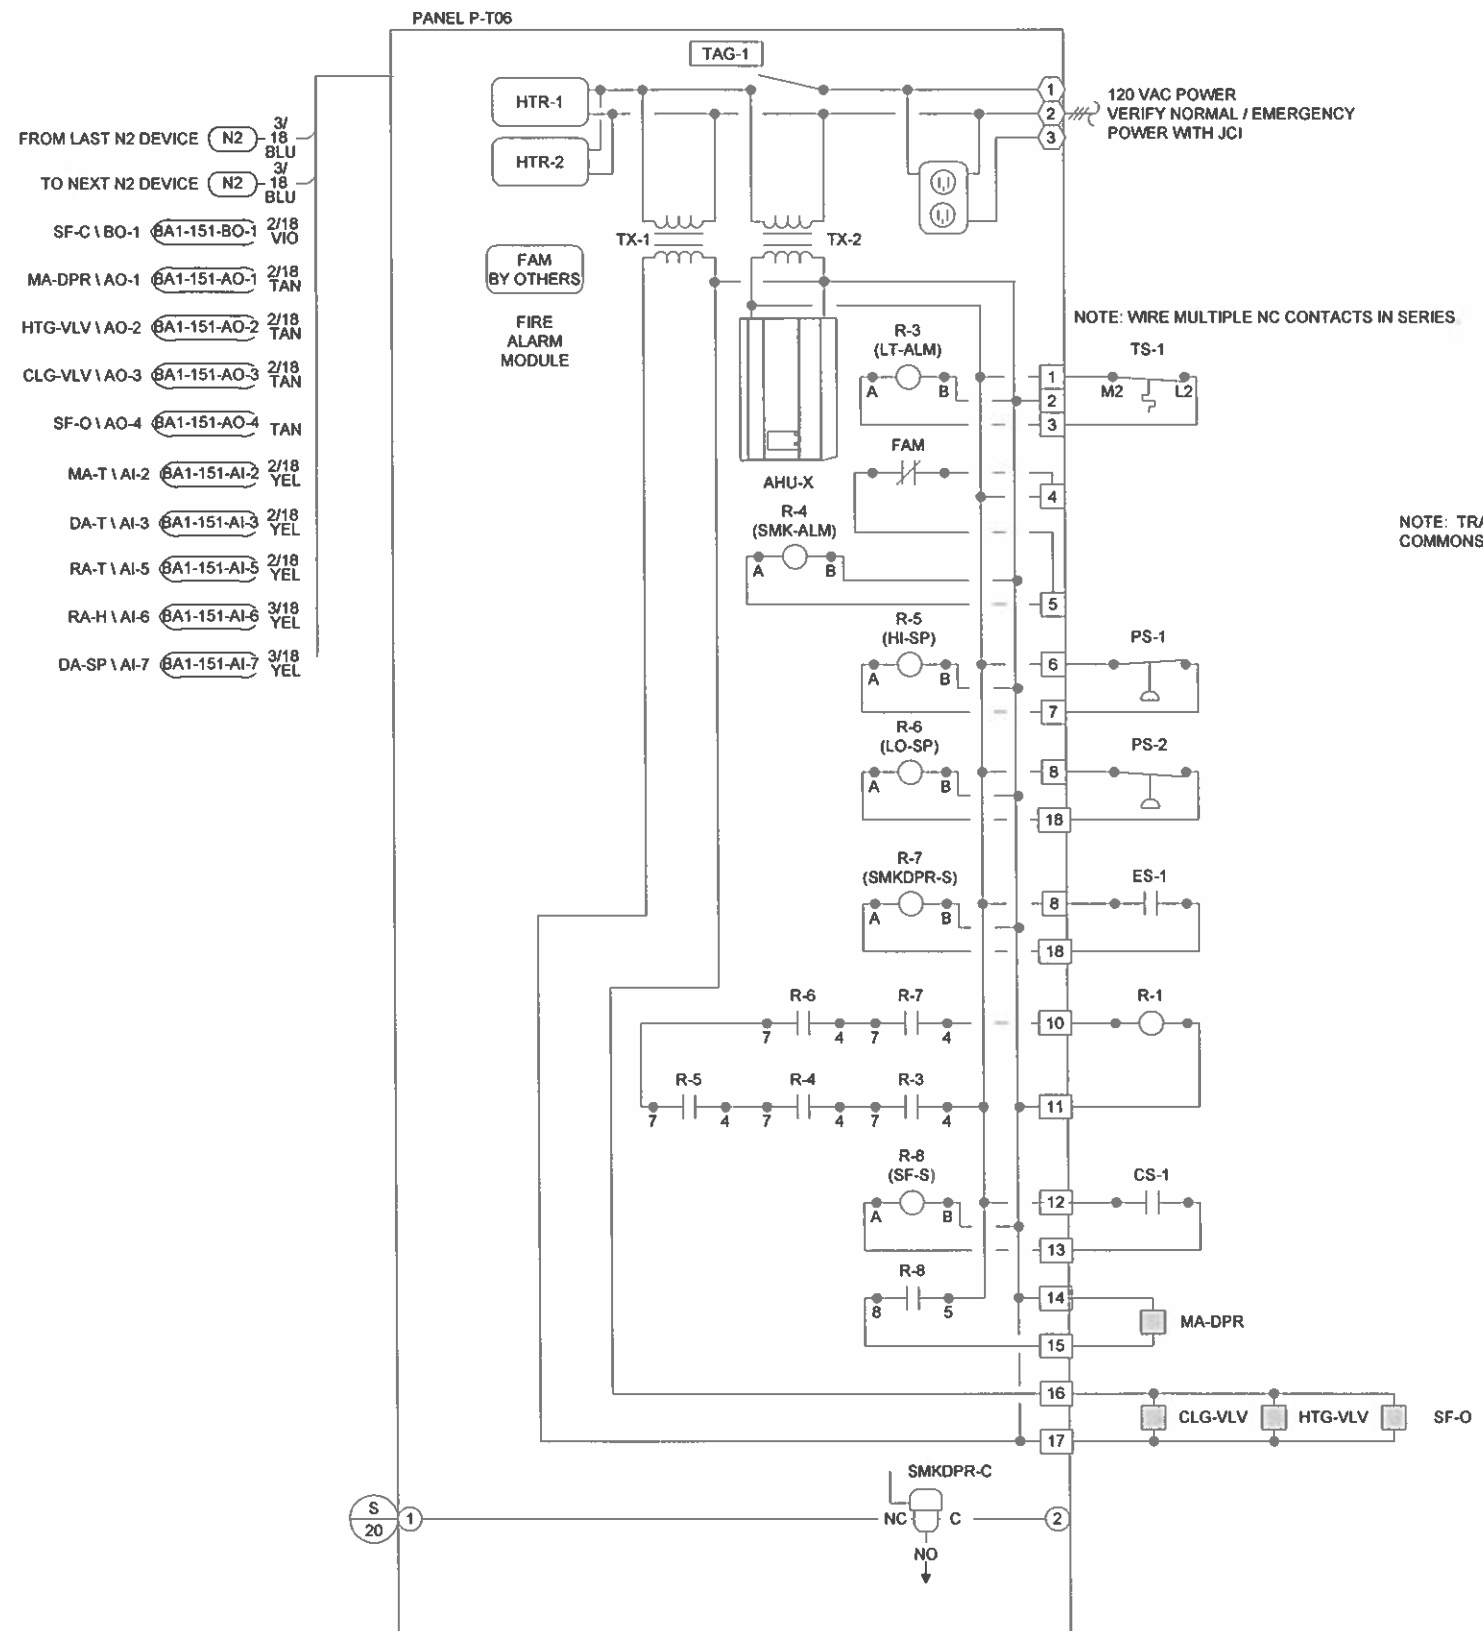


PANEL FACE TAGS:  
TAG-1 PANEL P-T06 AH-T06  
JCI 9 8075-0508

REVISION INFORMATION	Drawing Title				
NUMBER	AH-T06 PANEL				
DATE	06/14/01	NO.	REVISION-LOCATION		ECH DATE BY
TIME	04:50 PM	Project Engineer	Project Manager	Application Engineer	DATE
FILE NAME	aht06p.vsd	PJS	TP	KJK	BY MLR DATE
Project Title		Branch Information		CONTRACT NUMBER	
MILLER PARK ONE BREWERS WAY MILWAUKEE, WI 53214		JOHNSON CONTROLS Systems & Services Division		9 8075-0508	
		Wisconsin Area Office 529 N. Jackson Street Milwaukee WI 53202 Phone: 414-524-7500 Fax: 414-524-7575		DRAWING NUMBER 28.2	

AH-T06

**Multi-zone VAV MASP Air Handling System with Economizer Cycle**

1. The air handling unit is equipped with supply fan, heating coil, cooling coil, pre-filter, final filter and economizer mixing box.
2. The air handling unit supply fan will be energized through the EMCS on a scheduled basis.
3. The supply fan capacity will be modulated via inlet guide vanes based upon static pressure in the supply duct. A high pressure safety cut-out located in the air handling unit will deactivate the unit upon a static pressure of 3.0" w.c. being detected in the cabinet. Provide actuators for inlet vanes.
4. Provide on the air handling unit, an economizer logic network controller to position the economizer dampers for maximum economy and sequenced with the heating and cooling valves.
5. Unless the economizer controller is overridden by the warm-up cycle, the controller will verify that the air handling unit is running via a fan proof of flow controller and open the outside air damper to the minimum required ventilation position.
6. When the outside air dry bulb temperature is less than outside air dry bulb setpoint, the economizer dampers will be positioned for maximum free cooling using outside air to meet the cooling demand. The mechanical cooling equipment will only be used if the outside air cannot provide enough free cooling to meet demand.
7. Upon morning start-up of the occupied mode mechanical cooling will be locked out, the heating control valve will fully open, the outside air damper will remain in the closed position, all VAV boxes will be at maximum CFM though the reheat valve will remain under the control of zone sensors, all interlocked exhaust fans will be de-energized. When the return air temperature reaches the warm-up setpoint, the air handler will return to normal operation. Provide all relays, solenoids, and wiring required to lock out warm-up during normal occupancy hours.
8. Each zone sensor modulates the VAV box damper to satisfy the required room temperature. See the VAV Box sequence of operation.
9. The chilled water control valve will modulate in sequence to maintain the discharge air temperature. The discharge air temperature setpoint will be reset based on return air humidity.
10. Smoke detectors located in the supply and return ducts will on detection of smoke shut down the air handler supply fan via a hard-wire interlock with fan starter. Smoke detectors will indicate status at EMCS.
11. Filter replacement will be scheduled based on supply fan runtime.
12. Current switches will be located on the feed to the supply fan to provide status indication (on/off). In off hours DDC controller will command the chilled water two-way control valve to a fully closed position, the heating valve to the fully open position, and the outside air damper to the fully closed position.
13. The EMCS will monitor and control all points for each air handling unit.
14. If the supply air static at the supply fan raises above the high limit setpoint, the system will be shutdown. If the return air static drops below the low limit setpoint, the system will be shutdown.
15. In off hours, the supply fan will be cycled intermittently by the zone sensor to maintain 60°F.


REVISION INFORMATION	Drawing Title								
NUMBER	SEQUENCE								
DATE	04/13/01	REFERENCE DRAWING	NO.	REVISION-LOCATION	ECH	DATE	BY	DATE	BY
TIME	09:28 AM	Sales Engineer	Project Manager	Application Engineer			MLR		
FILE NAME	aht06s.vsd	PJS	TP	KJK					
	Project Title				Branch Information		CONTRACT NUMBER		
	MILLER PARK ONE BREWERS WAY MILWAUKEE, WI 53214				Wisconsin Area Office 529 N. Jackson Street Milwaukee WI 53202 Phone: 414-524-7500 Fax: 414-524-7575		9 8075-0508		
		Systems & Services Division					DRAWING NUMBER		
							28.3		





**BILL OF MATERIALS**


Designation	Qty	Part Number	Description
Panel Devices:			
HTR-1	1	EN2-12-P-040-D	PANEL HEATER, 120VAC, ELECTRO-FLEX
P-X	1	M-8100-2424	PANEL STANDARD, 9 UNITS
R-4-R-6	3	PD-101-35	RLY BASE, 3PDT, 11PIN, 10A
	3	PD-109-51	RELAY PLUG-IN 3PDT 24VAC
TAG-1	1	M-8000-393	NAMEPLT, LAMICOID, 3 LINE
UNT-X	1	AS-UNT141-1	UNT CNTRL 6AI 4BI 6BO 2AO W/O ENCL SCREW

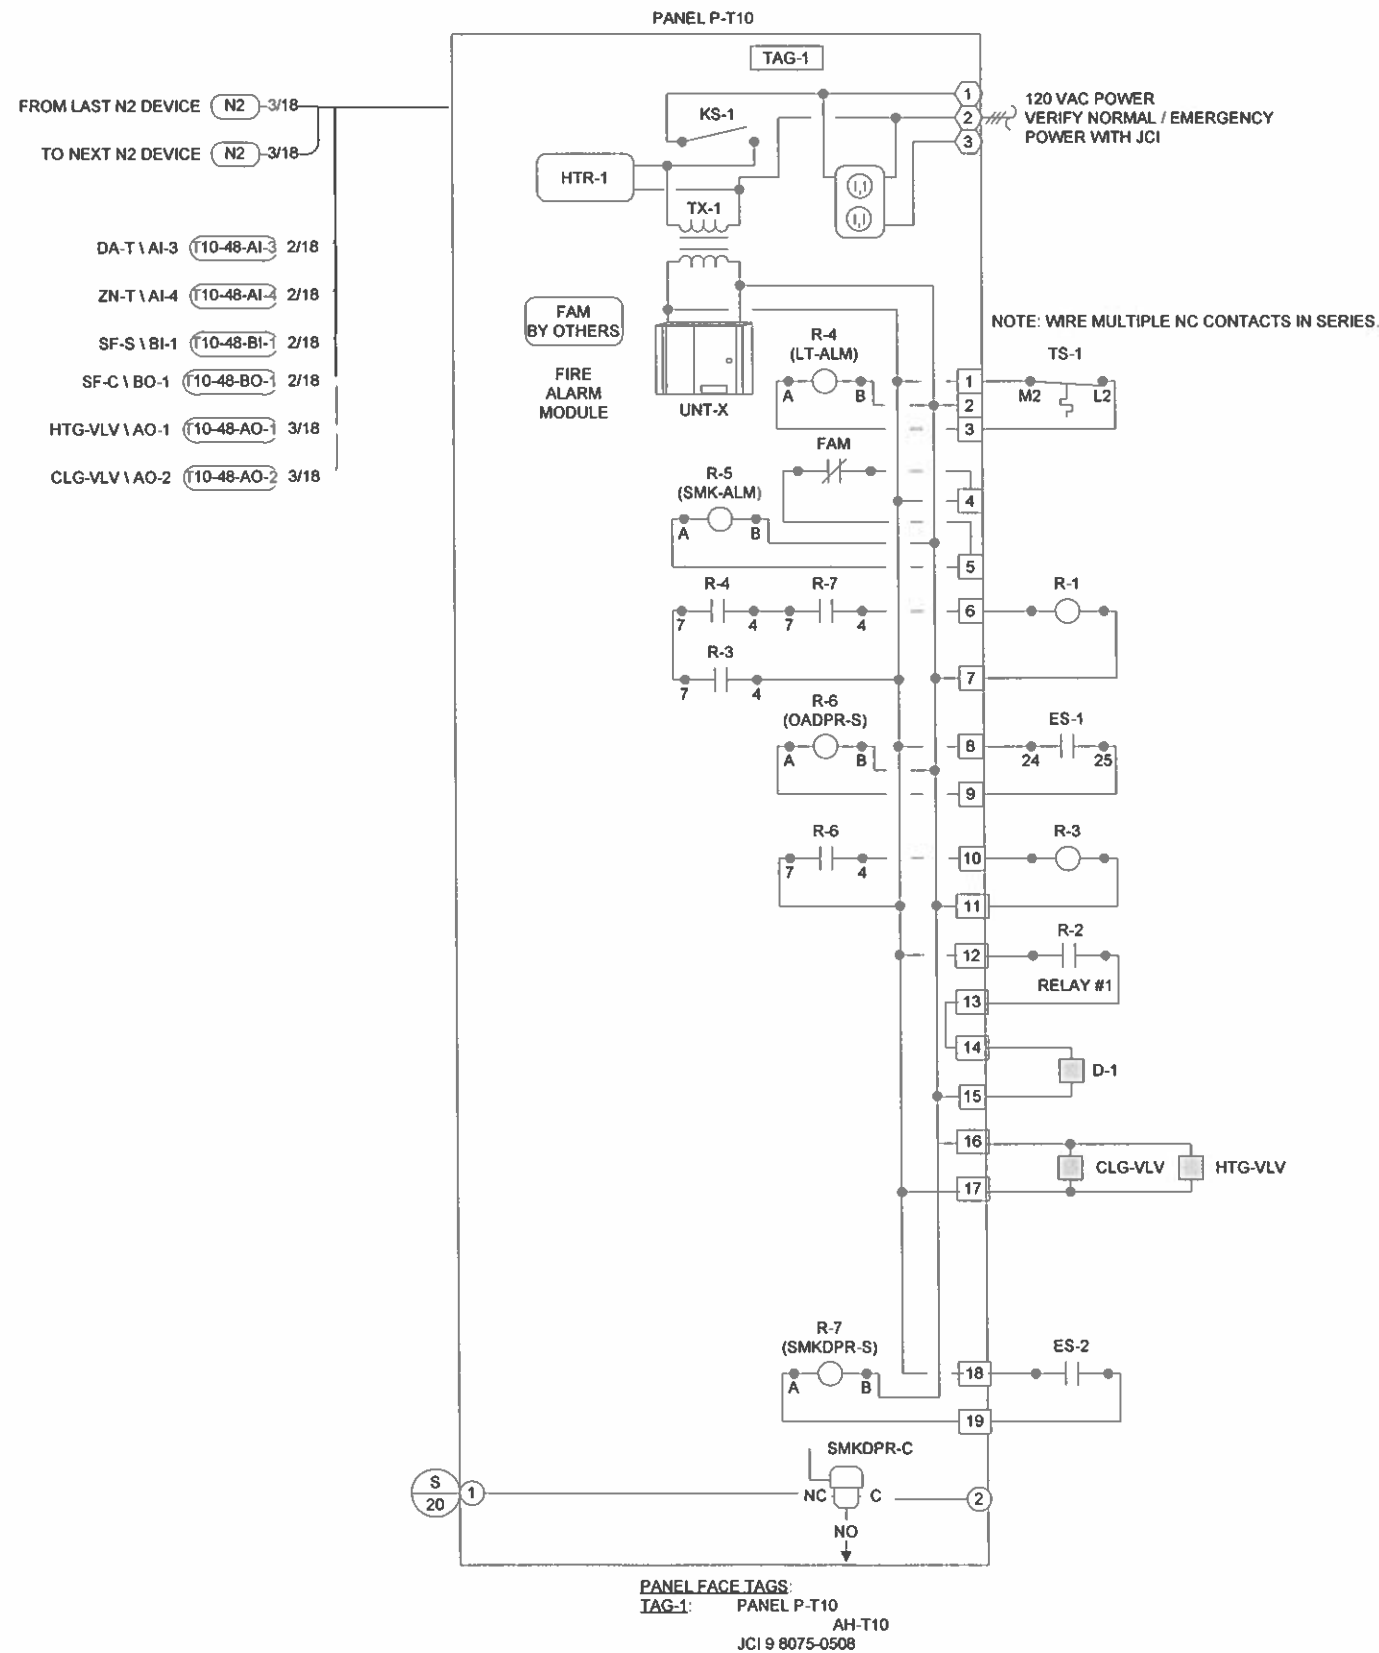

REVISION INFORMATION	Drawing Title										
	AH-T10 PANEL										
NUMBER											
DATE	04/13/01		REFERENCE DRAWING		NO		REVISION-LOCATION		E/CN DATE BY		
TIME	09:54 AM		Supt Engineer		Project Manager		Application Engineer		DRAWN APPROVED		
FILE NAME	aht10p.vsd		PJS		TP		KJK		BY MLR DATE BY DATE		
Project Title			Branch Information			CONTRACT NUMBER					
MILLER PARK ONE BREWERS WAY MILWAUKEE, WI 53214			Wisconsin Area Office 529 N. Jackson Street Milwaukee WI 53202 Phone: 414-524-7500 Fax: 414-524-7575			9 8075-0508			DRAWING NUMBER		
			JOHNSON CONTROLS Systems & Services Division						29.2		


**BILL OF MATERIALS**

Designation	Qty	Part Number	Description
<b>Field Devices:</b>			
BOWL-T	1	TE-6000-1	SENS,T-N,(1.0%)
D-x	1	TE-6001-2	MTG,OAT SENS (CONDULET)
ES-2 XDPR-S	4	TS-470	DAMPER POSITION SWITCH - KELE
MA-T	1	TE-6001-8	CLIP F/AVG ELEM (10/PKG)
MA-T, Dax-T	3	TE-6316P-1	SENS,T-N,(0.1%),17" AVG
PB-1	1		EMERGENCY STOP PUSH BUTTON
PS-1	1	AFS-460	SW, AIR FLOW, SPST-NC RESET .05-12" @CLE
R-1-2,SFSTA-C	6	CVR-21C-O	RLY 2SPDT,10-30VAC/DC OR 120VAC,LED @LEC
RA-T	1	TE-6311P-1	SENS,T-N,(0.1%),8" DUCT
SFx-C,CS-x	2	H-735	SW, CURRENT, 1-135A CMND RLY SOLID @VER
ST-x	1	A520-2-A-1	8" STATIC PROBE, ALUM, 1/4" TUBE @MAMAC

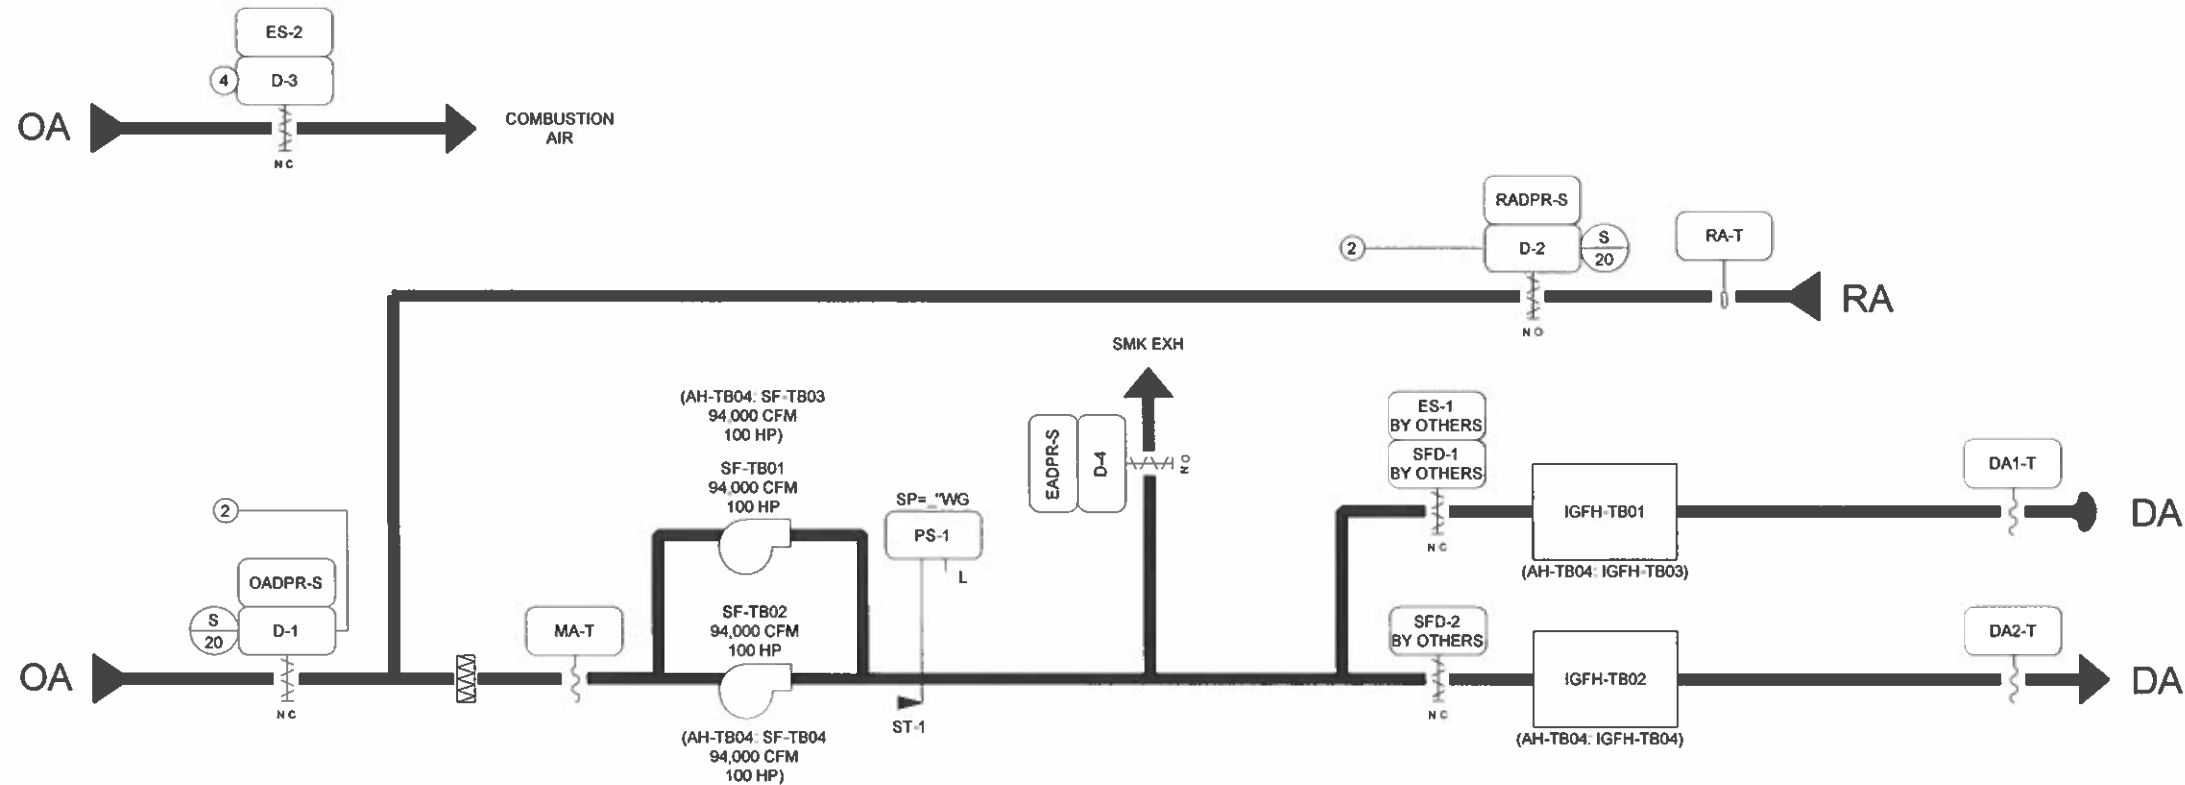


PB-1 LOCATED OUTSIDE FAN CHAMBER.

**PARTIAL GAS-FIRED HEATER WIRING**

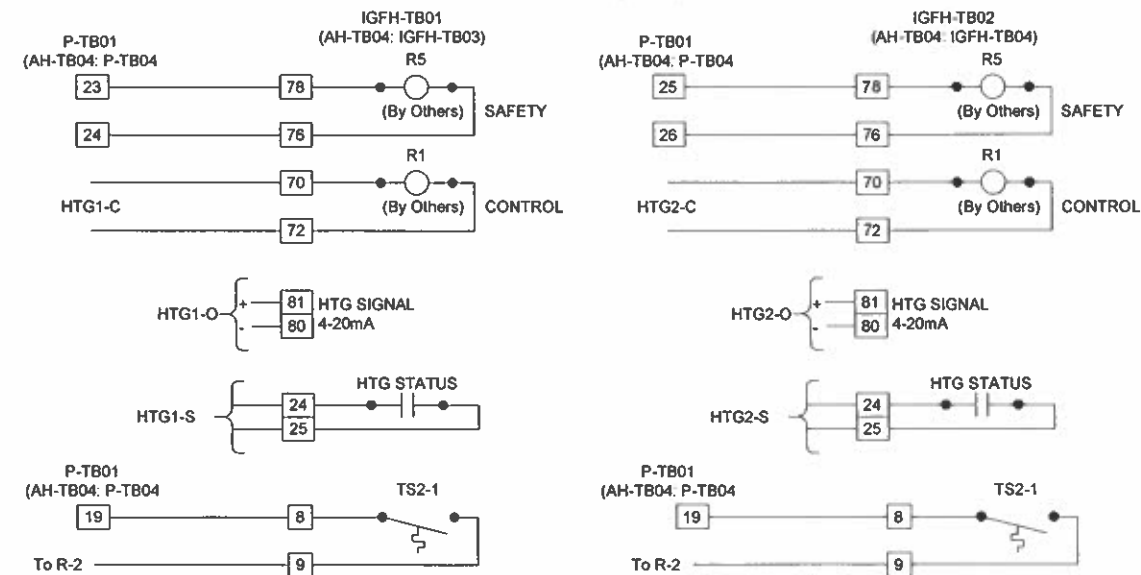


NOTE: SEE MANUFACTURER'S WIRING DIAGRAM FOR COMPLETE WIRING DETAILS.


**SUPPLY FAN SF-TB01 STARTER**

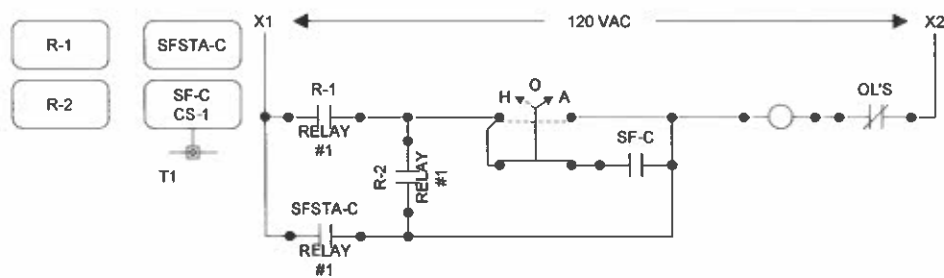

**SUPPLY FAN SF-TB02 STARTER**

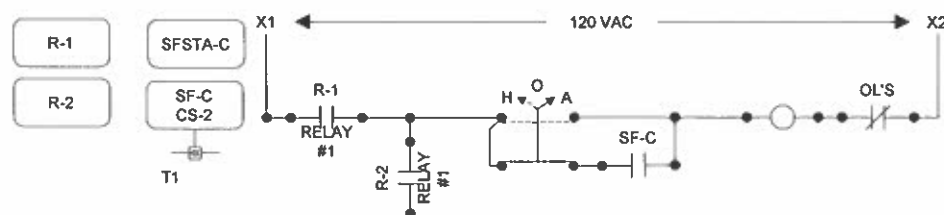

REVISION INFORMATION	Drawing Title				
NUMBER	<b>AH-TB01 FLOW TYPICAL FOR AH-TB04</b>				
DATE	06/15/01	1	RECORD DRAWINGS	6/14/2001	MLR
TIME	07:21 AM				
FILE NAME	ahtb01f.vsd				
Project Title		Branch Information		CONTRACT NUMBER	
<b>MILLER PARK ONE BREWERS WAY MILWAUKEE, WI 53214</b>		<b>JOHNSON CONTROLS</b> Wisconsin Area Office 529 N Jackson Street Milwaukee WI 53202 Phone: 414-524-7500 Fax: 414-524-7575		<b>9 8075-0508</b>	
		Systems & Services Division		<b>30.1</b>	

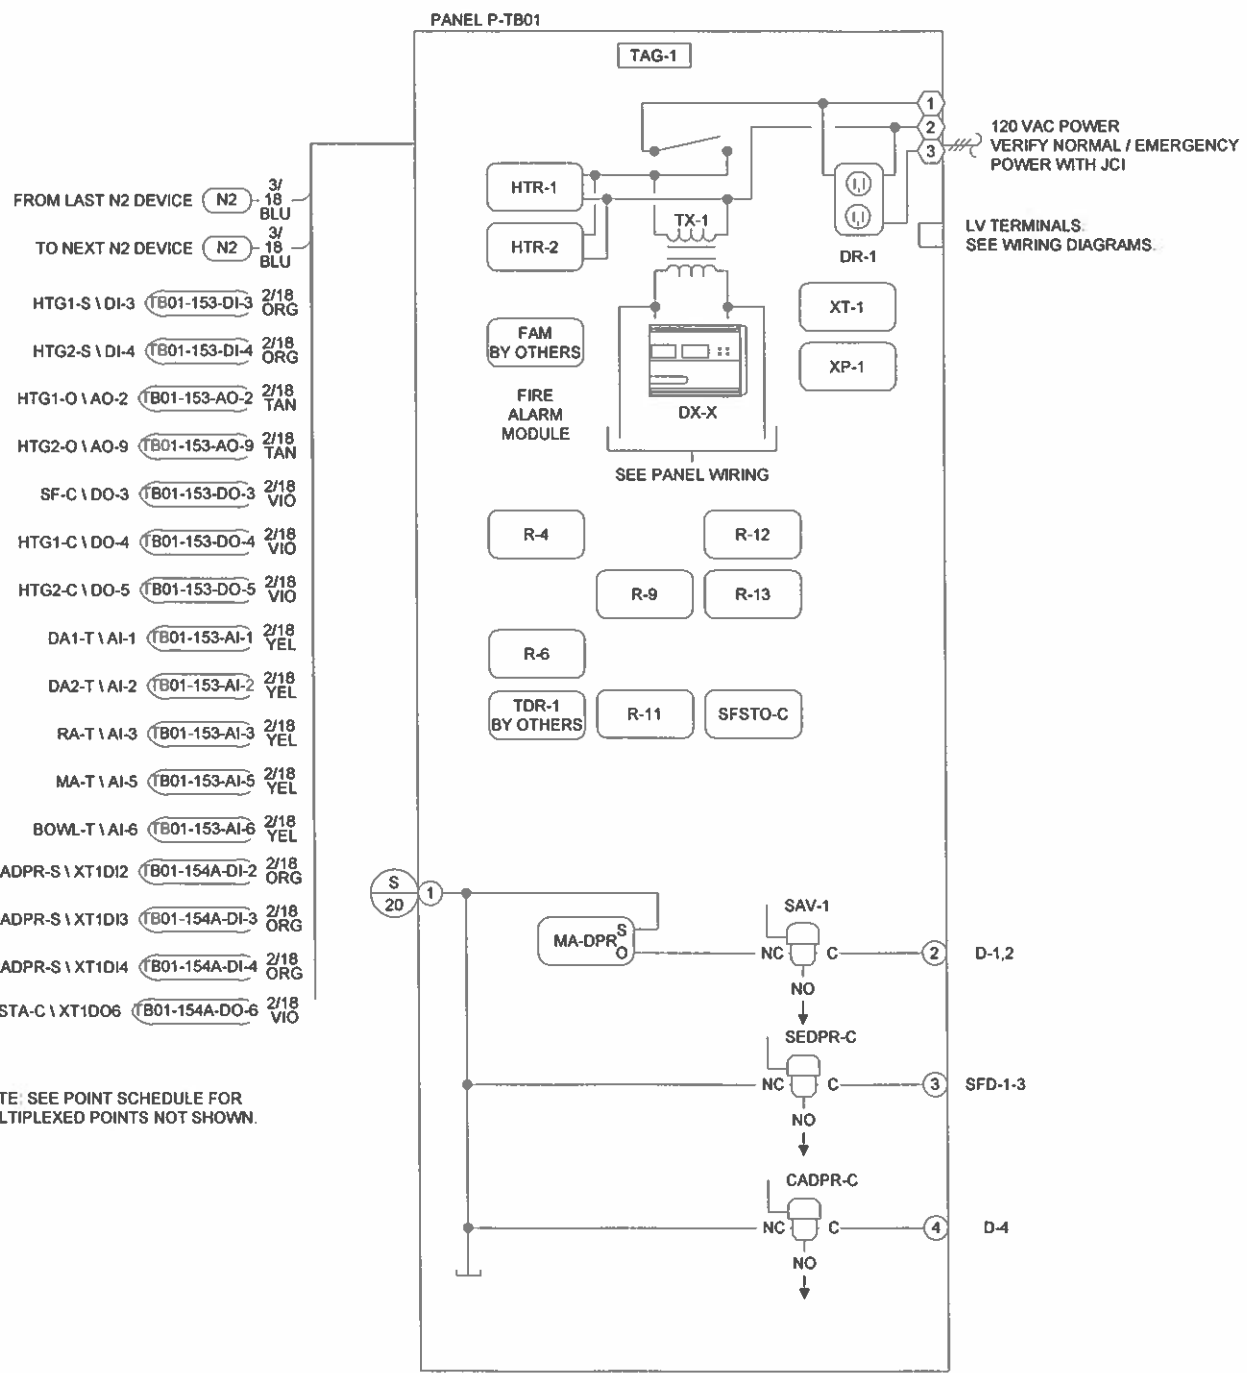


- FROM LAST N2 DEVICE (N2) 3/18 BLU
- TO NEXT N2 DEVICE (N2) 3/18 BLU
- HTG1-S \ DI-3 (TB01-153-DI-3) 2/18 ORG
- HTG2-S \ DI-4 (TB01-153-DI-4) 2/18 ORG
- HTG1-O \ AO-2 (TB01-153-AO-2) 2/18 TAN
- HTG2-O \ AO-9 (TB01-153-AO-9) 2/18 TAN
- SF-C \ DO-3 (TB01-153-DO-3) 2/18 VIO
- HTG1-C \ DO-4 (TB01-153-DO-4) 2/18 VIO
- HTG2-C \ DO-5 (TB01-153-DO-5) 2/18 VIO
- DA1-T \ AI-1 (TB01-153-AI-1) 2/18 YEL
- DA2-T \ AI-2 (TB01-153-AI-2) 2/18 YEL
- RA-T \ AI-3 (TB01-153-AI-3) 2/18 YEL
- MA-T \ AI-5 (TB01-153-AI-5) 2/18 YEL
- BOWL-T \ AI-6 (TB01-153-AI-6) 2/18 YEL
- EADPR-S \ XT1DI2 (TB01-154A-DI-2) 2/18 ORG
- OADPR-S \ XT1DI3 (TB01-154A-DI-3) 2/18 ORG
- RADPR-S \ XT1DI4 (TB01-154A-DI-4) 2/18 ORG
- SFSTA-C \ XT1DO6 (TB01-154A-DO-6) 2/18 VIO

NOTE: SEE POINT SCHEDULE FOR MULTIPLEXED POINTS NOT SHOWN.


PANEL FACE TAGS  
TAG-1: PANEL P-TB01  
AH-TB01  
JCI 9 8075-0508

PANEL FACE TAGS  
TAG-1: PANEL P-TB04  
AH-TB04  
JCI 9 8075-0508

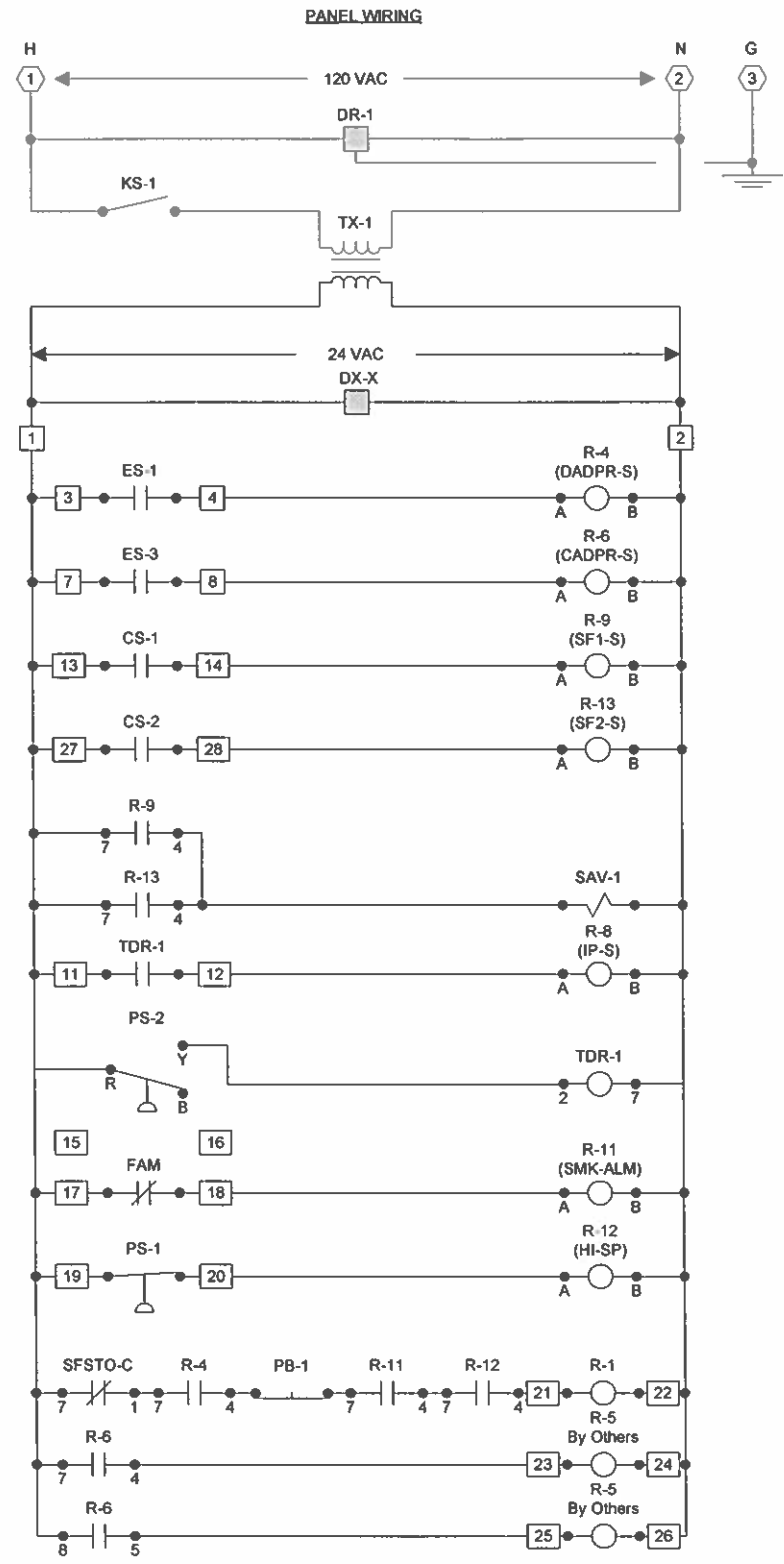

**BILL OF MATERIALS**

Designation	Qty	Part Number	Description
<b>Panel Devices:</b>			
DR-1	1	PD-117-2	RECEPTACLE DUPLEX, UL, WHT
	1	PD-121-1	RECEPTACLE DUPLEX, CVR
	1	PD-121-6	HANDY BOX 2 IN
DX-X	1	AS-LCPKEY-0	LCP SERVICE PORT ADJ KEY
	1	DX-9100-8454	DIGITAL CONTR., EXTENDED
	1	DX-9100-8990	MTG BASE (DX9100-8454)
HTR-x	2	EN2-12-P-040-D	PANEL HEATER, 120VAC, ELECTRO-FLEX
KS-1	1	PD-112-12	KNIFE SWITCH BLOCK
MA-DPR	1	EP-8000-2	XDUCR, EP, 0/10V, HI VOL
P-X	1	M-8100-2436	PANEL, STANDARD, 15 UNITS
SAV-1, XDPR-C	3	V11HGA-100	3-W SOLENOID, W/OV, 24 VAC
SFSTO-C, R-4, 6, 9-13	7	PD-101-35	RLY BASE, 3PDT, 11PIN, 10A
	7	PD-109-51	RELAY PLUG-IN 3PDT 24VAC
TAG-1	1	M-8000-393	NAMEPLT, LAMICOID 3 LINE
TX-x	1	PD-114-2	TRANSFORMER 100VA, 120/24
XP-1	1	XP-9104-8004	DX EXP MOD, 4 DI, 4 DO TRIAC
XT-1	1	XT-9100-8204	EXTENSION MODULE

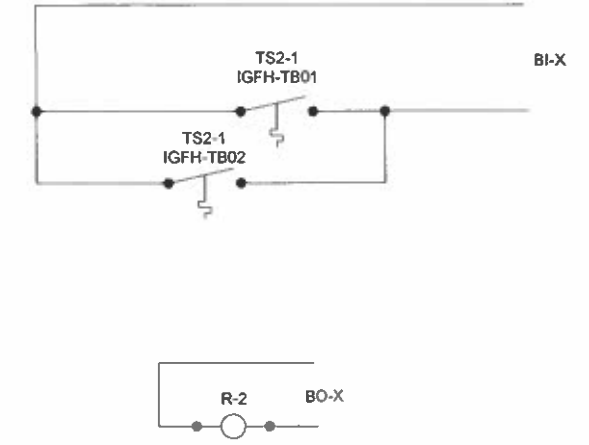


REVISION INFORMATION	Drawing Title							
NUMBER	AH-TB01 PANEL TYPICAL FOR AH-TB04		1		RECORD DRAWINGS		6/14/2001 MLR	
DATE	06/16/01		PJS		TP		KJK	
TIME	07:21 AM		Project Title		MILLER PARK ONE BREWERS WAY MILWAUKEE, WI 53214		CONTRACT NUMBER	
FILE NAME	ahtb01p.vsd		Application Engineer		KJK		9 8075-0508	
			Branch Information		Wisconsin Area Office 529 N. Jackson Street Milwaukee WI 53202 Phone 414-524-7500 Fax: 414-524-7575		DRAWING NUMBER	
			Systems & Services Division		JOHNSON CONTROLS		30.2	

AH-TB01, AH-TB04



**MASP Indirect Gas Fired Air Handling System**

1. The air handling unit is equipped with 2 supply fans, filter, 2 indirect gas-fired heaters.
2. The air handling unit supply fans will be energized through the EMCS. The air handling unit will be interlocked with the operation of the roof, being started upon the roof being closed. An override will be provided to operate the unit in ventilation mode when the roof is open.
3. Upon the call for heating the air handling unit will be set to pre-heat mode. This will mean that the high level bowl louvers will be closed and the outside air dampers will be fully closed. The fans will be energized by the EMCS. The indirect heaters will be enabled but will be prevented from firing unless the combustion air dampers are proved to be open as detected by an end switch on the actuator. The safety will be hard-wired into the burner circuits to prevent firing until the condition is met.
4. At the end of the pre-heat period, as determined by the return temperature reaching a preset limit, the unit will revert to normal operation. This will mean that the outside air damper will move to its minimum position. The indirect gas-fired burners will modulate to maintain the discharge air temperature. The discharge air temperature setpoint will be reset based on the return air temperature.
5. Upon the call for ventilation as determined by the EMCS and the outside air temperature, the outside air damper will fully open and the return air damper will fully close. The indirect gas-fired heaters will be prevented from firing, and the combustion air damper will close. At the same time the high level left and right field dampers will fully open.
6. Filter replacement will be scheduled based on supply fan runtime.
7. Current switches located on the feed to the supply fans will provide status indication (on/off).
8. The EMCS will monitor and control all points for each air handling unit.
9. End switches will be provided on dampers to provide status indication in the smoke exhaust mode. See the Smoke Exhaust System sequence of operation.
10. No flue draft fan is present.
11. No flue draft fan is present.
12. In off hours, see the Frost Protection sequence of operation.

REVISION INFORMATION	Drawing Title								
NUMBER	SEQUENCE								
DATE	04/13/01	REFERENCE DRAWING	NO.	REVISION LOCATION	E/CN	DATE	BY		
TIME	10:45 AM	Sales Engineer	Project Manager	Application Engineer					
FILE NAME	ahtb01s.vsd	PJS	TP	KJK	BY	MLR	DATE	BY	DATE
	Project Title	MILLER PARK ONE BREWERS WAY MILWAUKEE, WI 53214			 Systems & Services Division			Branch Information Wisconsin Area Office 529 N Jackson Street Milwaukee WI 53202 Phone: 414-524-7500 Fax: 414-524-7575	
								CONTRACT NUMBER	
								9 8075-0508	
								DRAWING NUMBER	
								30.3	


**BILL OF MATERIALS**

Designation	Qty	Part Number	Description
<b>Field Devices:</b>			
BOWL-T	1	TE-6000-1	SENS,T-Ni,1.0%
D-x,SFD-x	0	TE-6001-2	MTG,OAT SENS (CONDULET)
MA-T	1	TE-6001-8	CLIP F/AVG ELEM (10/PKG)
MA-T, DA-T	2	TE-6316P-1	SENS,T-Ni,0.1%,17" AVG
OA-T	1	TE-6313P-1	SENSOR,T-Ni,0.1%,3IN OAT
PS-1	1	AFS-460	SW, AIR FLOW, SPST-NC RESET .05-12" @CLE
R-1,SFSTA-C	2	CVR-21C-O	RLY 2SPDT,10-30VAC/DC OR 120VAC,LED @LEC
RA-T	1	TE-6311P-1	SENS,T-Ni,0.1%,8" DUCT
SF-S	1	H-735	SW, CURRENT, 1-135A CMND RLY SOLID @VER
ST-x	1	A520-2-A-1	8" STATIC PROBE. ALUM. 1/4" TUBE @MAMAC
X DPR-S	3	TS-470	DAMPER POSITION SWITCH - KELE

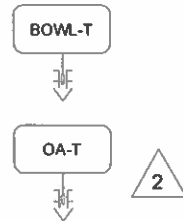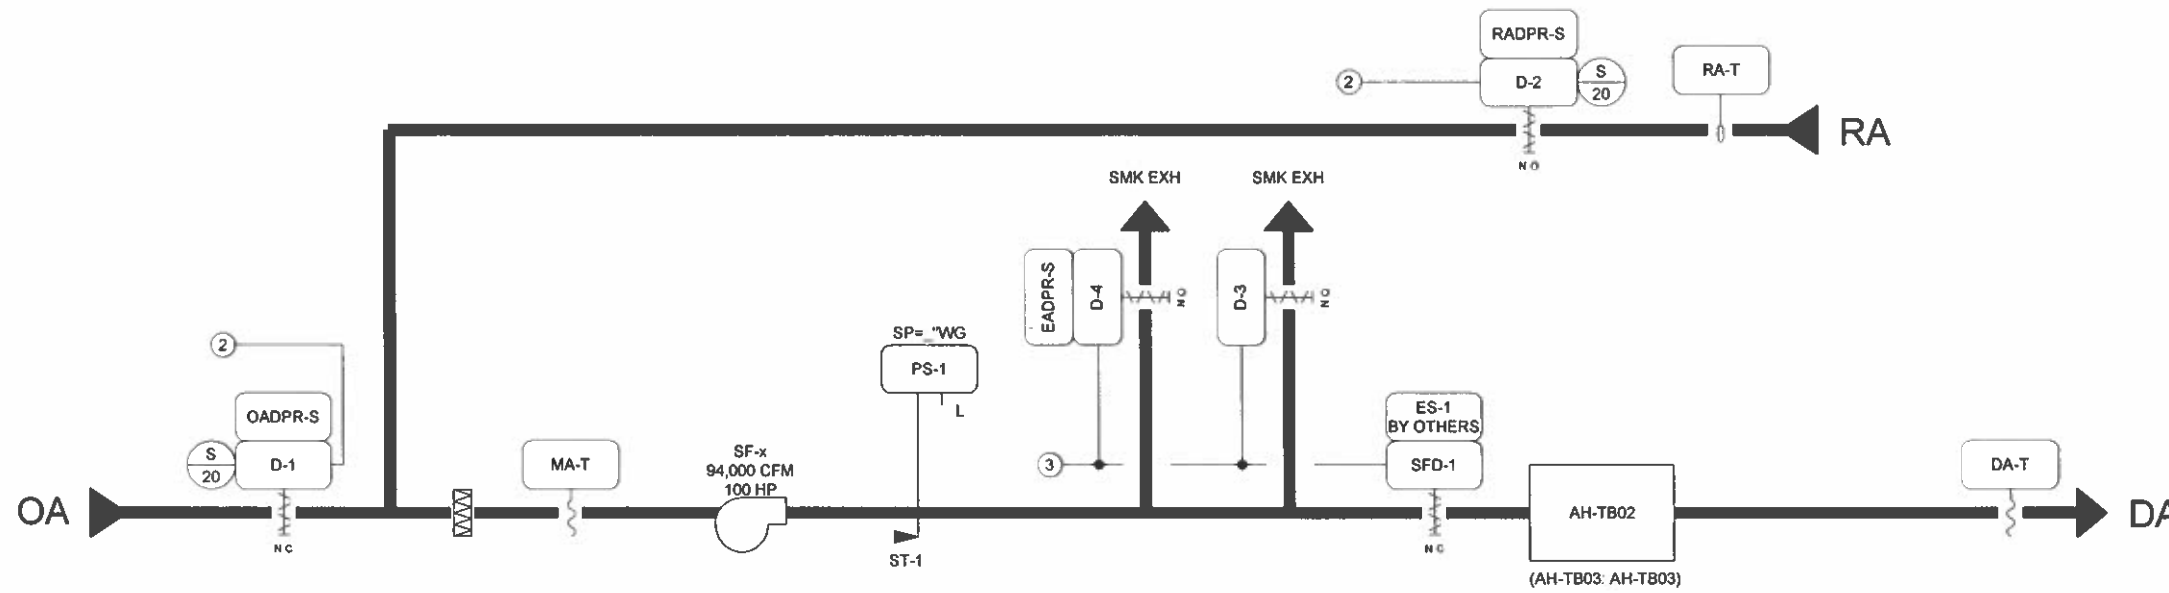


**SUPPLY FAN STARTER**

AH-TB02 (AH-TB03: AH-TB03)

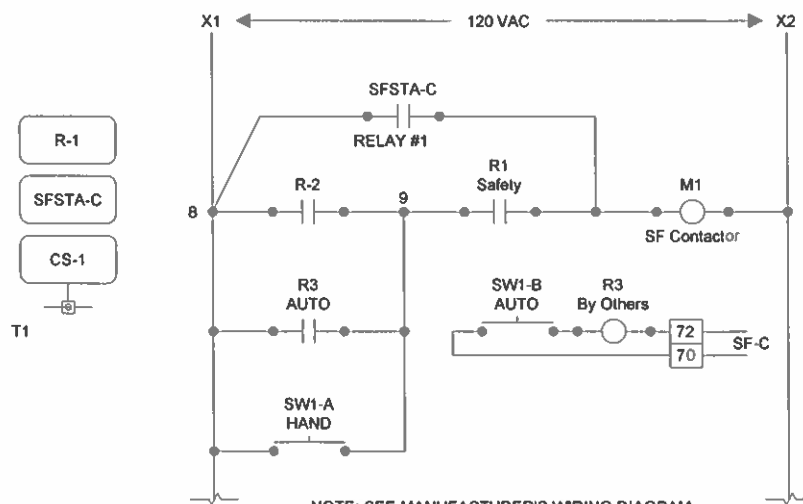



**PARTIAL GAS-FIRED HEATER WIRING**

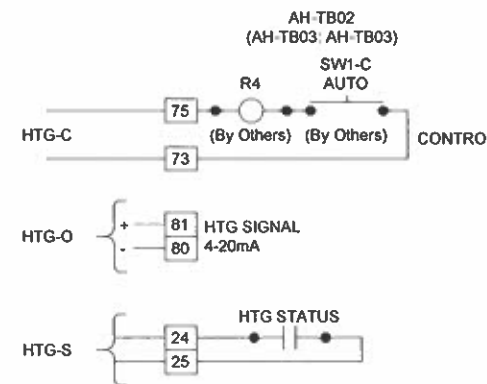

REVISION INFORMATION	Drawing Title							
	AH-TB02 FLOW TYPICAL FOR AH-TB03							
DATE	04/13/01	Project Manager	TP	Application Engineer	KJK	DATE		BY
TIME	11:05 AM	Project Title		Branch Information		CONTRACT NUMBER		
FILE NAME	ahb021.vsc	MILLER PARK ONE BREWERS WAY MILWAUKEE, WI 53214		Wisconsin Area Office 529 N Jackson Street Milwaukee WI 53202 Phone: 414-524-7500 Fax: 414-524-7575		9 8075-0508		
		JOHNSON CONTROLS Systems & Services Division				DRAWING NUMBER 31.1		

**BILL OF MATERIALS**

Designation	Qty	Part Number	Description
<b>Panel Devices:</b>			
DR-1	1	PD-117-2	RECEPTACLE, DUPLEX, UL, WHT
	1	PD-121-1	RECEPTACLE, DUPLEX, CVR
	1	PD-121-6	HANDY BOX 2 IN
DX-X	1	AS-LCPKEY-0	LCP SERVICE PORT ADJ KEY
	1	DX-9100-8454	DIGITAL CONTR. EXTENDED
	1	DX-9100-8990	MTG BASE (DX9100-8454)
HTR-x	2	EN2-12-P-040-D	PANEL HEATER, 120VAC, ELECTRO-FLEX
KS-1	1	PD-112-12	KNIFE SWITCH BLOCK
MA-DPR	1	EP-8000-2	XDUCR, EP, 0/10V, HI VOL
P-X	1	A-30H20ALP	HOFFMAN NEMA4 PANEL
	1	A-30P20	HOFFMAN NEMA4 PANEL
SAV-1, XDPR-C	2	V11HGA-100	3-W SOLENOID, W/OV, 24 VAC
SFSTO-C R-4-9-13	5	PD-101-35	RLY BASE 3PDT, 11PIN, 10A
	5	PD-109-51	RELAY PLUG-IN 3PDT 24VAC
TAG-1	1	M-8000-393	NAMEPLT, LAMICOID, 3 LINE
TX-x	1	PD-114-2	TRANSFORMER 100VA, 120/24
XP-1	1	XP-9104-8004	DX EXP MOD, 4 DI, 4DO TRIAC
XT-1	1	XT-9100-8204	EXTENSION MODULE

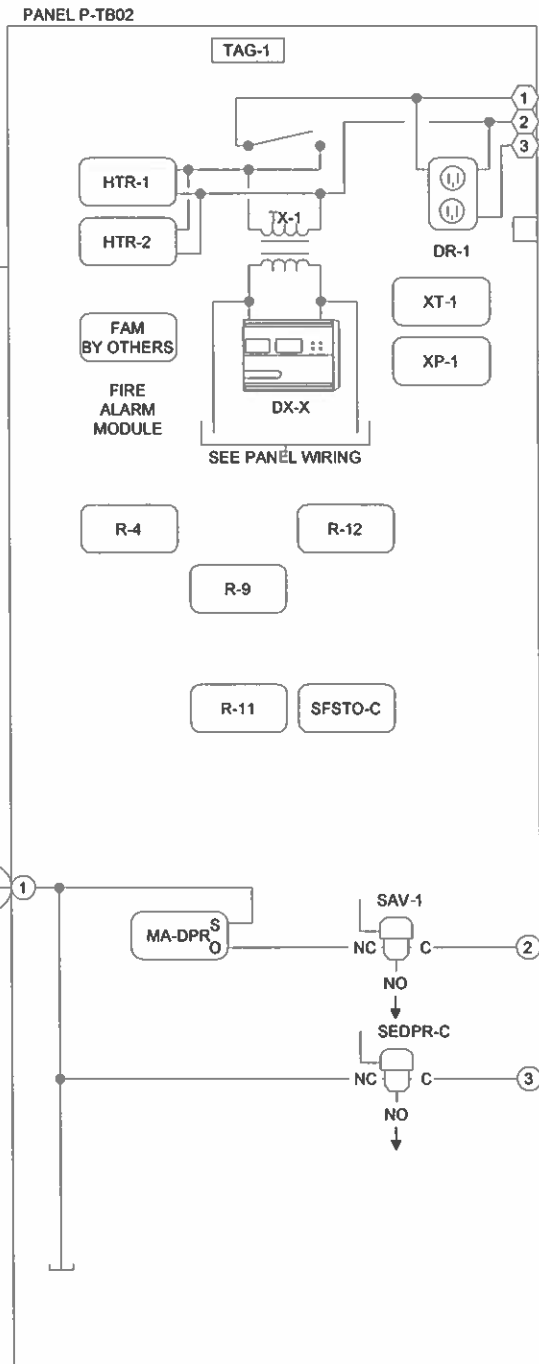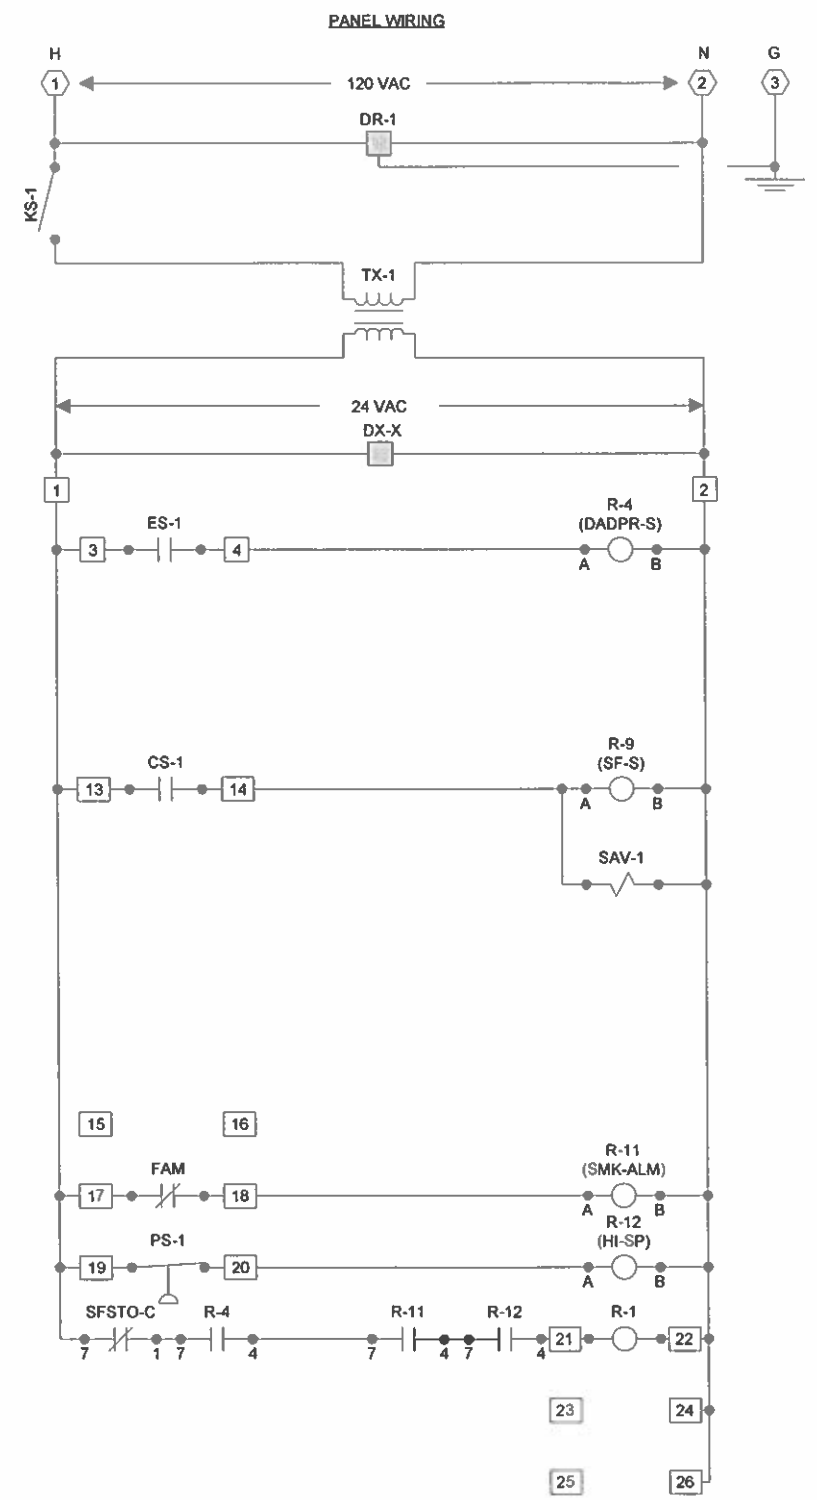

120 VAC POWER  
VERIFY NORMAL / EMERGENCY  
POWER WITH JCI

LV TERMINALS:  
SEE WIRING DIAGRAMS.

- FROM LAST N2 DEVICE (N2) 3/18 BLU
- TO NEXT N2 DEVICE (N2) 3/18 BLU
- HTG-S \ DI-2 (TB02-155-DI-2) 2/18 ORG
- HTG-O \ AO-2 (TB02-155-AO-2) 2/18 TAN
- SF-C \ DO-3 (TB02-155-DO-3) 2/18 VIO
- HTG-C \ DO-4 (TB02-155-DO-4) 2/18 VIO
- DA-T \ AI-1 (TB02-155-AI-1) 2/18 YEL
- RA-T \ AI-2 (TB02-155-AI-2) 2/18 YEL
- MA-T \ AI-3 (TB02-155-AI-3) 2/18 YEL
- BOWL-T \ AI-4 (TB02-155-AI-4) 2/18 YEL
- EADPR-S \ XT1DI2 (TB02-156A-DI-2) 2/18 ORG
- OADPR-S \ XT1DI3 (TB02-156A-DI-3) 2/18 ORG
- RADPR-S \ XT1DI4 (TB02-156A-DI-4) 2/18 ORG
- SFSTA-C \ XT1DO6 (TB02-156A-DO-6) 2/18 VIO

NOTE: SEE POINT SCHEDULE FOR MULTIPLEXED POINTS NOT SHOWN.

**PANEL FACE TAGS:**  
TAG-1: PANEL P-TB02 AH-TB02 JCI 9 8075-0508


**PANEL FACE TAGS:**  
TAG-1: PANEL P-TB03 AH-TB03 JCI 9 8075-0508

<b>REVISION INFORMATION</b> NUMBER DATE TIME FILE NAME	Drawing Title <b>AH-TB02 PANEL TYPICAL FOR AH-TB03</b>	REFERENCE DRAWING PJS TP KJK		REVISION LOCATION DRAWN DATE APPROVED		ECH DATE BY	
	04/13/01 11:14 AM ahtb02p.vsd	Project Title <b>MILLER PARK ONE BREWERS WAY MILWAUKEE, WI 53214</b>	Application Engineer KJK		BY MLR		CONTRACT NUMBER <b>9 8075-0508</b> DRAWING NUMBER <b>31.2</b>
JOHNSON CONTROLS Systems & Services Division		Branch Information Wisconsin Area Office 529 N. Jackson Street Milwaukee WI 53202 Phone: 414-524-7500 Fax: 414-524-7575					

AH-TB02, AH-TB03


**MASP Indirect Gas Fired Air Handling System**

1. The air handling unit is equipped with supply fan, filter, indirect gas-fired heater.
2. The air handling unit supply fan will be energized through the EMCS. The air handling unit will be interlocked with the operation of the roof, being started upon the roof being closed. An override will be provided to operate the unit in ventilation mode when the roof is open.
3. Upon the call for heating the air handling unit will be set to pre-heat mode. This will mean that the high level bowl louvers will be closed and the outside air dampers will be fully closed. The fan will be energized by the EMCS. The indirect heater will be enabled but will be prevented from firing unless the combustion air dampers are proved to be open as detected by an end switch on the actuator. The safety will be hard-wired into the burner circuit to prevent firing until the condition is met.
4. At the end of the pre-heat period, as determined by the return temperature reaching a preset limit, the unit will revert to normal operation. This will mean that the outside air damper will move to its minimum position. The indirect gas-fired burner will modulate to maintain the discharge air temperature. The discharge air temperature setpoint will be reset based on the return air temperature.
5. Upon the call for ventilation as determined by the EMCS and the outside air temperature, the outside air damper will fully open and the return air damper will fully close. The indirect gas-fired heater will be prevented from firing, and the combustion air damper will close. At the same time the high level left and right field dampers will fully open.
6. Filter replacement will be scheduled based on supply fan runtime.
7. Current switches located on the feed to the supply fan will provide status indication (on/off).
8. The EMCS will monitor and control all points for each air handling unit.
9. End switches will be provided on dampers to provide status indication in the smoke exhaust mode. See the Smoke Exhaust System sequence of operation.
10. No flue draft fan is present.
11. No flue draft fan is present.
12. In off hours, see the Frost Protection sequence of operation.


REVISION INFORMATION	Drawing Title								
NUMBER	SEQUENCE								
DATE		REFERENCE DRAWING	NO	REVISION-LOCATION	ECH	DATE	BY		
04/13/01		Sales Engineer	Project Manager	Application Engineer					
		PJS	TP	KJK	BY	MLR	DATE	BY	DATE
TIME	Project Title	Branch Information		CONTRACT NUMBER					
11:18 AM	MILLER PARK ONE BREWERS WAY MILWAUKEE, WI 53214			Wisconsin Area Office 529 N. Jackson Street Milwaukee WI 53202 Phone: 414-524-7500 Fax: 414-524-7575		<b>9 8075-0508</b>			
FILE NAME		Systems & Services Division		DRAWING NUMBER					
ahtb02s.vsd				<b>31.3</b>					

**BILL OF MATERIALS**

Designation	Qty	Part Number	Description
<b>Field Devices:</b>			
D-1, ES-1	0	DAMPER	SEE DAMPER SCHEDULE
DA-T	1	TE-6311P-1	SENS, T-Ni, 0.1%, 8" DUCT
R-1-R-3, COMB-AIR	4	CVR-21C-O	RLY 2SPDT, 10-30VAC/DC OR 120VAC, LED @ LEC
SF-C, SF-S	1	H-735	SW, CURRENT, 1-135A CMND RLY SOLID @ VER
TS-1	1	A70GA-1C	STAT, LL, 20FT, EL, AUT, 15/55F
	1	TE-6001-B	CLIP F/AVG ELEM (10/PKG)
X-VLV	0	VALVE	SEE VALVE SCHEDULE
ZN-T	1	TE-6314P-1	SENS, T-Ni, 0.1%, RM

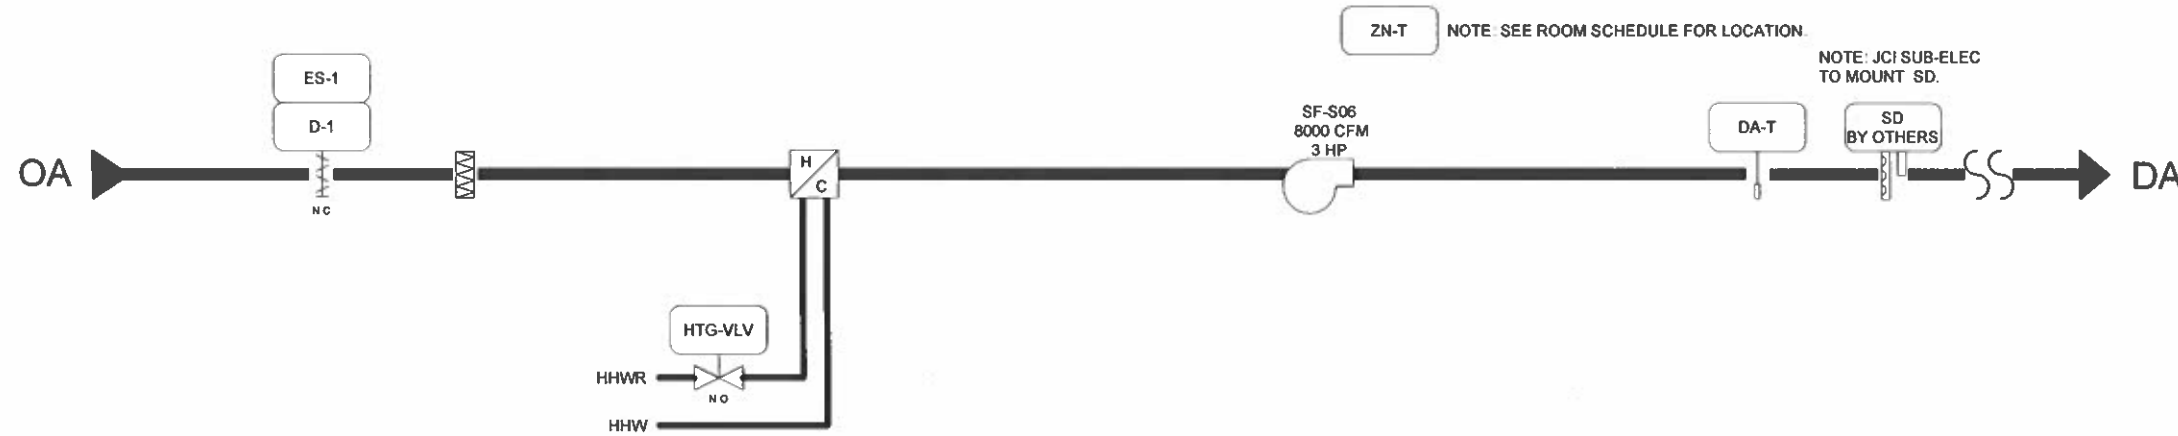

- R-1
  - R-2
  - R-3
  - COMB-AIR
  - SF-C
  - SF-S
  - T1
- BO from P-B  
(see NC-2 PS-25)

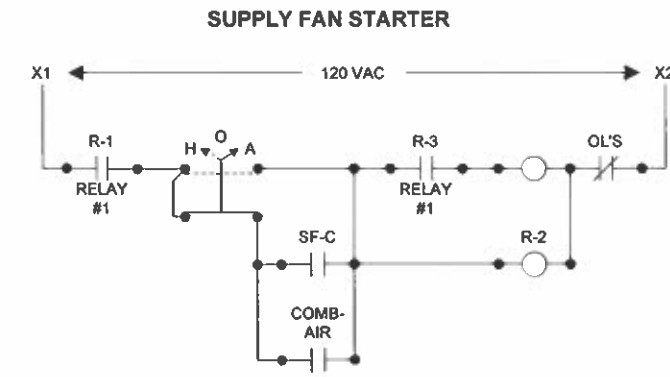

REVISION INFORMATION	Drawing Title				
NUMBER	SF-S06 FLOW				
DATE	04/13/01	NO.	REVISION-LOCATION	ECH	DATE
TIME	12:00 PM	Project Manager	Application Engineer	BY	DATE
FILE NAME	sfs06f.vsd	PJS	TP	KJK	MLR
Project Title		Branch Information		CONTRACT NUMBER	
MILLER PARK ONE BREWERS WAY MILWAUKEE, WI 53214		 Systems & Services Division		Wisconsin Area Office 529 N. Jackson Street Milwaukee WI 53202 Phone: 414-524-7500 Fax: 414-524-7575	
				9 8075-0508	
				DRAWING NUMBER	
				32.1	




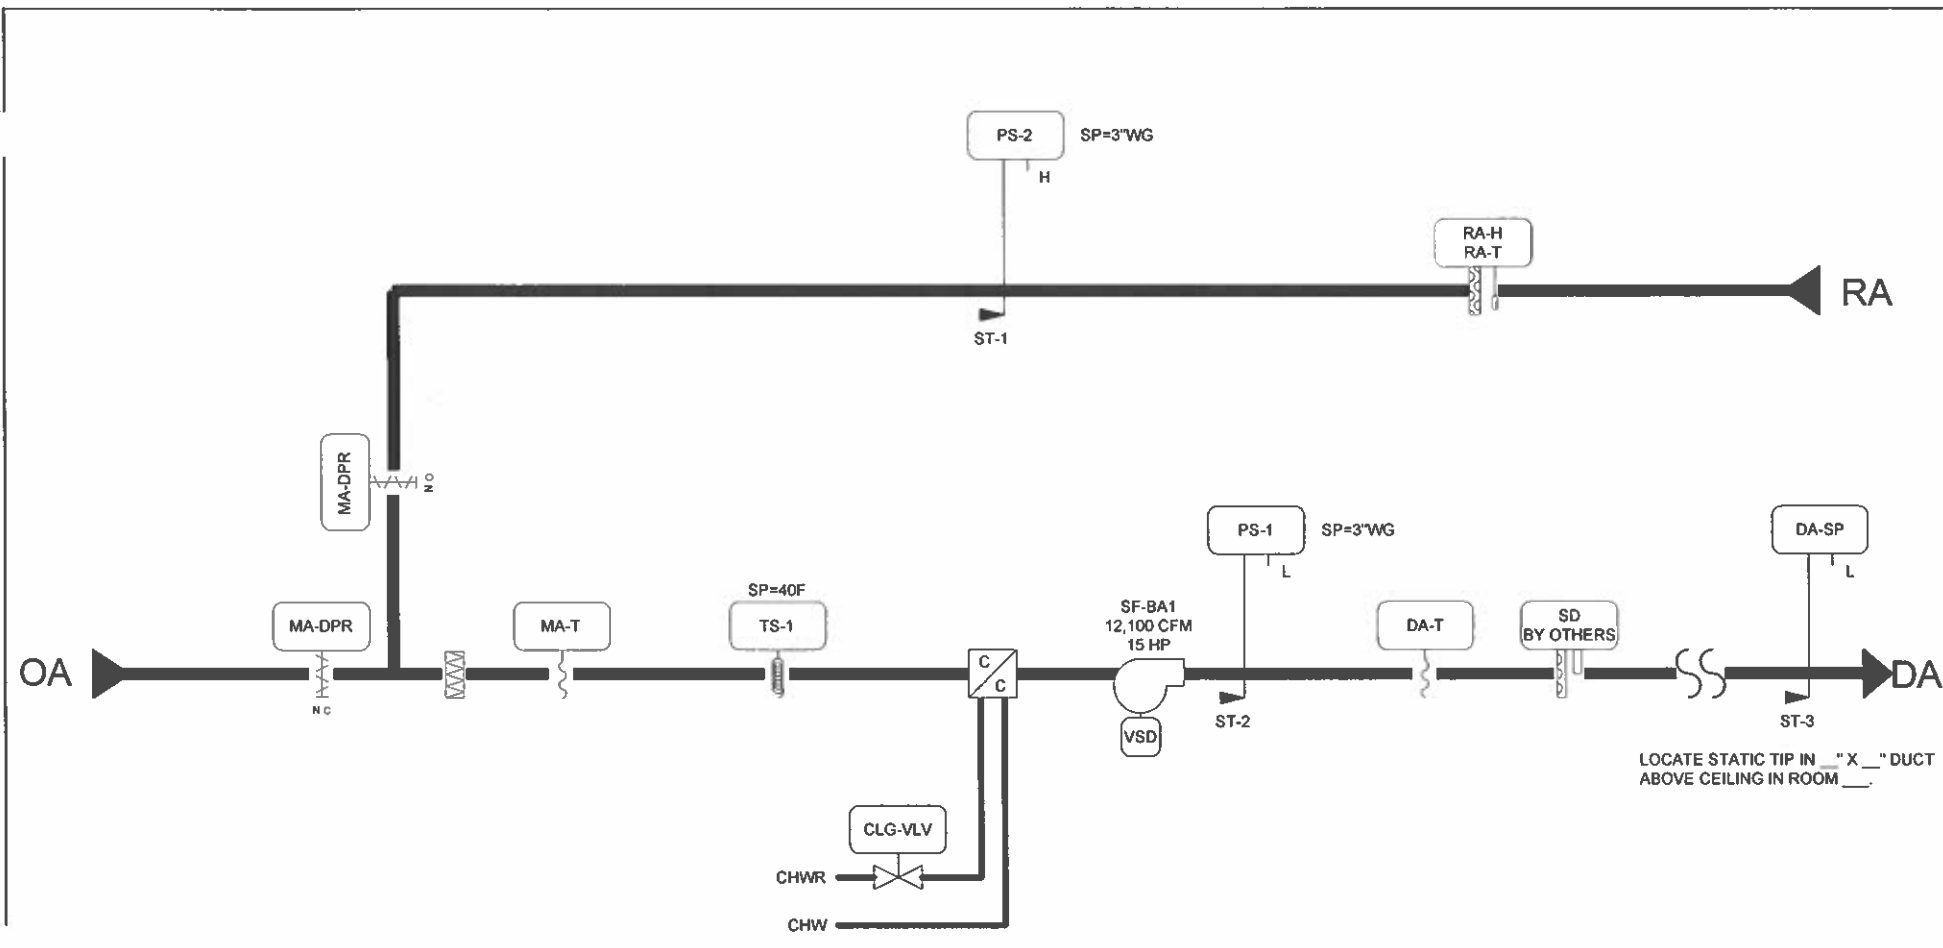


SF-S06

**Boiler Room Ventilation**

1. The supply fan will not be energized until the outside air damper is open as determined by an end switch on the actuator. The fan will continue to run until the boilers are deactivated.
2. The heating coil valve will be modulated to maintain a minimum space temperature.
3. If the fan starter switch is in the Hand position, a hard-wired solenoid will open the combustion outside air damper fully, and when the damper is fully open as proven from the end switch, the supply fan will energize. Hard-wire the damper end switch into the safety side of the fan motor starter to prevent the fan from energizing from the EMCS or the Hand position of the starter, unless the end switch is closed.
4. Current switches located on the feed to the fan will provide status indication to the EMCS.
5. The fan will be energized on a call for a boiler to operate, from a solenoid hard-wired into the four burners that will open the combustion damper. The end switch on the combustion damper will energize the fan (See Main Hot Water System sequence of operation).
6. Filter replacement will be scheduled based on supply fan runtime.
7. Monitor the combustion air damper end switch on the EMCS.


REVISION INFORMATION	Drawing Title								
NUMBER	SEQUENCE								
DATE		REFERENCE DRAWING	NO	REVISION-LOCATION	ECH	DATE	BY		
04/13/01		Sales Engineer	Project Manager	Application Engineer					
TIME	Project Title	PJS	TP	KJK	BY	MLR	DATE	BY	DATE
12:08 PM	MILLER PARK ONE BREWERS WAY MILWAUKEE, WI 53214								
FILE NAME				Branch Information Wisconsin Area Office 529 N. Jackson Street Milwaukee WI 53202 Phone: 414-524-7500 Fax: 414-524-7575		CONTRACT NUMBER <b>9 8075-0508</b>		DRAWING NUMBER <b>32.3</b>	
sfs06s.vsd									



**BILL OF MATERIALS**

Designation	Qty	Part Number	Description
Field Devices:			
DA-SP	1	DPT2640-005B	DP TRANS DIF, -5 TO 5 WC
DA-T, MA-T	2	TE-6316P-1	SENS,T-Ni,0.1%,17' AVG
DA-T, MA-T, TS-1	1	TE-6001-8	CLIP F/AVG ELEM (10/PKG)
PS-x	2	AFS-460	SW, AIR FLOW, SPST-NC RESET .05-12" @CLE
R-1	1	CVR-21C-O	RLY 2SPDT,10-30VAC/DC OR 120VAC.LED @VER
RA-H, RA-T	1	HE-6310-2	XMTR,RH/T-Ni,DUCT,AC/DC
SF-C,CS-1	1	H-735	SW, CURRENT, 1-135A CMND RLY SOLID @VER
ST-x	3	A520-2-A-1	8" STATIC PROBE, ALUM, 1/4" TUBE @MAMAC
TS-1	2	A70HA-1C	STAT,LL,20",EL,MAN 15/55F
X-DPR, X-VLV,XF-O	3	PD-101-1	RESISTOR, 4990HM 1/2W 1%
X-DPR, XF-O	0	DAMPER	SEE DAMPER SCHEDULE
X-VLV	0	VALVE	SEE VALVE SCHEDULE

**SUPPLY FAN VARIABLE SPEED DRIVE**

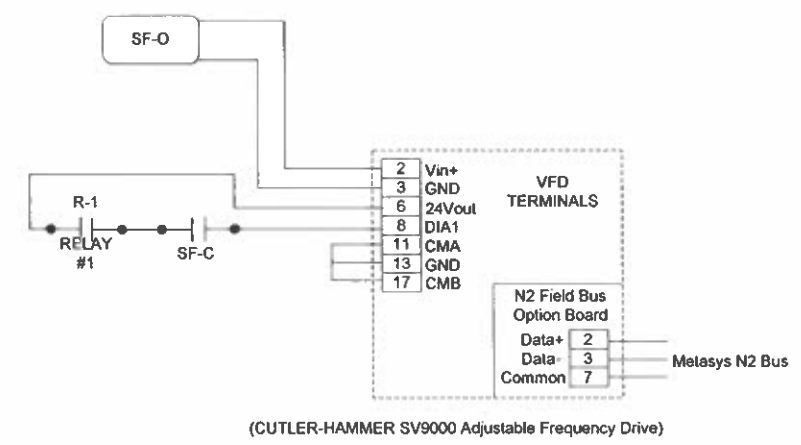


(CUTLER-HAMMER SV9000 Adjustable Frequency Drive)

REVISION INFORMATION	Drawing Title	VFD Replaced Inlet Vanes		2003-14	2003 SRF Project	DAM
NUMBER	AH-BA1 FLOW					
DATE	11/06/09	REFERENCE DRAWING	NO.		REVISION LOCATION	ECN
TIME	08:01 AM	Sales Engineer	Project Manager	Application Engineer	DATE	BY
FILE NAME	ahba1f2.vsd	PJS	TP	KJK	DATE	BY
Project Title		MILLER PARK ONE BREWERS WAY MILWAUKEE, WI 53214		Branch Information		CONTRACT NUMBER
		JOHNSON CONTROLS Systems & Services Division		Wisconsin Area Office 529 N. Jackson Street Milwaukee WI 53202 Phone: 414-524-7500 Fax: 414-524-7575		9 8075-0508
						DRAWING NUMBER
						33.1

**BILL OF MATERIALS**

Designation	Qty	Part Number	Description
Panel Devices:			
AHU-X	1	AS-AHU103-300	AHU TERMINATION BDELECTRONICS IN EWC35
P-BA1	2	EN-EXP101-0	EXPANSION COVER AND BACKBONE
R-3-R-7	5	PD-101-35	RLY BASE,3PDT,11PIN,10A
TAG-1	5	PD-109-51	RELAY PLUG-IN 3PDT 24VAC
TX-x	1	M-8000-393	NAMEPLT,LAMICOID,3 LINE
	2	PD-114-2	TRANSFORMER 100VA, 120/24

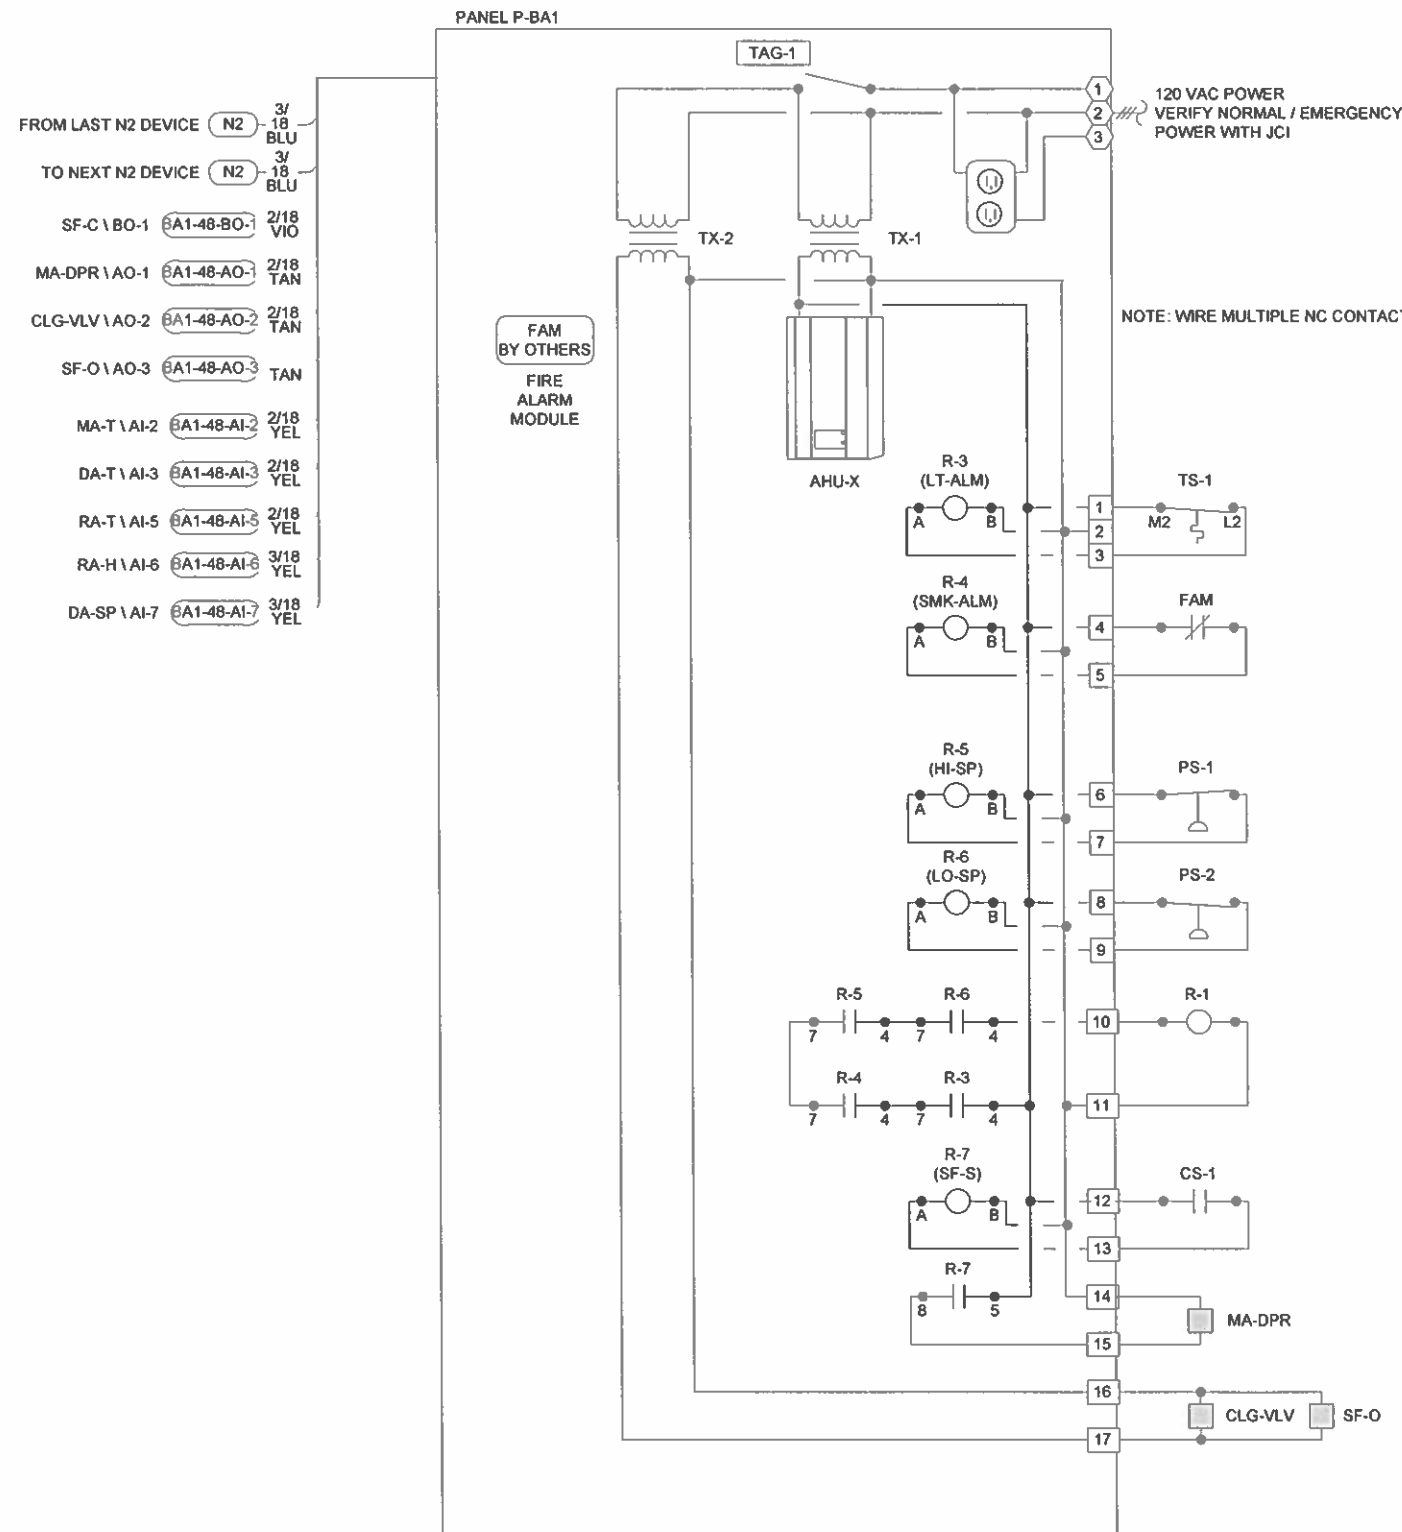

NOTE: WIRE MULTIPLE NC CONTACTS IN SERIES.

NOTE: TRANSFORMER COMMONS ARE TIED TOGETHER.

- FROM LAST N2 DEVICE (N2) 3/18 BLU
- TO NEXT N2 DEVICE (N2) 3/18 BLU
- SF-C \ BO-1 (BA1-48-BO-1) 2/18 VIO
- MA-DPR \ AO-1 (BA1-48-AO-1) 2/18 TAN
- CLG-VLV \ AO-2 (BA1-48-AO-2) 2/18 TAN
- SF-O \ AO-3 (BA1-48-AO-3) TAN
- MA-T \ AI-2 (BA1-48-AI-2) 2/18 YEL
- DA-T \ AI-3 (BA1-48-AI-3) 2/18 YEL
- RA-T \ AI-5 (BA1-48-AI-5) 2/18 YEL
- RA-H \ AI-6 (BA1-48-AI-6) 3/18 YEL
- DA-SP \ AI-7 (BA1-48-AI-7) 3/18 YEL


PANEL FACE TAGS:  
TAG-1: PANEL P-BA1  
AH-BA1  
JCI 9 8075-0508

REVISION INFORMATION	Drawing Title				
NUMBER	AH-BA1 PANEL				
DATE	04/13/01	REFERENCE DRAWING	NO.	REVISION LOCATION	ECH DATE BY
TIME	12:24 PM	Design Engineer	Project Manager	Application Engineer	DRAWN
FILE NAME	ahba1p.vsd	PJS	TP	KJK	BY MLR DATE
				Branch Information Wisconsin Area Office 529 N Jackson Street Milwaukee WI 53202 Phone: 414-524-7500 Fax: 414-524-7575	
		Systems & Services Division		CONTRACT NUMBER <b>9 8075-0508</b> DRAWING NUMBER <b>33.2</b>	



**AH-BA1**

**Multi-zone VAV MASP Air Handling System with Economizer Cycle**

1. The air handling unit is equipped with supply fan, cooling coil, pre-filter, final filter and economizer mixing box.
2. The air handling unit supply fan will be energized through the EMCS on a scheduled basis.
3. The supply fan capacity will be modulated via inlet guide vanes based upon static pressure in the supply duct. A high pressure safety cut-out located in the air handling unit will deactivate the unit upon a static pressure of 3.0" w.c. being detected in the cabinet. Provide actuators for inlet vanes.
4. Provide on the air handling unit, an economizer logic network controller to position the economizer dampers for maximum economy and sequenced with the cooling valve.
5. Unless the economizer controller is overridden by the warm-up cycle, the controller will verify that the air handling unit is running via a fan proof of flow controller and open the outside air damper to the minimum required ventilation position.
6. When the outside air dry bulb temperature is less than outside air dry bulb setpoint, the economizer dampers will be positioned for maximum free cooling using outside air to meet the cooling demand. The mechanical cooling equipment will only be used if the outside air cannot provide enough free cooling to meet demand.
7. Upon morning start-up of the occupied mode mechanical cooling will be locked out, the outside air damper will remain in the closed position, all VAV boxes will be at maximum CFM though the reheat valve will remain under the control of zone sensors, all interlocked exhaust fans will be de-energized. When the return air temperature reaches the warm-up setpoint, the air handler will return to normal operation. Provide all relays, solenoids, and wiring required to lock out warm-up during normal occupancy hours.
8. Each zone sensor modulates the VAV box damper to satisfy the required room temperature. See the VAV Box sequence of operation.
9. The chilled water control valve will modulate in sequence to maintain the discharge air temperature. The discharge air temperature setpoint will be reset based on return air humidity.
10. Smoke detectors located in the supply and return ducts will on detection of smoke shut down the air handler supply fan via a hard-wire interlock with fan starter. Smoke detectors will indicate status at EMCS.
11. Filter replacement will be scheduled based on supply fan runtime.
12. Current switches will be located on the feed to the supply fan to provide status indication (on/off). In off hours DDC controller will command the chilled water two-way control valve to a fully closed position, and the outside air damper to the fully closed position.
13. The EMCS will monitor and control all points for each air handling unit.
14. If the supply air static at the supply fan raises above the high limit setpoint, the system will be shutdown. If the return air static drops below the low limit setpoint, the system will be shutdown.
15. In off hours, the supply fan will be cycled intermittently by the zone sensor to maintain 60°F.


REVISION INFORMATION	Drawing Title								
NUMBER	<b>SEQUENCE</b>								
DATE		REFERENCE DRAWING	NO.	REVISION LOCATION	ECH	DATE	BY		
04/13/01		Sales Engineer	Project Manager	Application Engineer					
		PJS	TP	KJK	BY	MLR	DATE	BY	DATE
TIM #	Project Title	Branch Information		CONTRACT NUMBER					
12:30 PM	<b>MILLER PARK ONE BREWERS WAY MILWAUKEE, WI 53214</b>			Wisconsin Area Office 529 N. Jackson Street Milwaukee WI 53202 Phone: 414-524-7500 Fax: 414-524-7575		<b>9 8075-0508</b>			
FILE NAME	ahba1s.vsd	Systems & Services Division				DRAWING NUMBER			
						<b>33.3</b>			

- FROM LAST N2 DEVICE (N2) 3/18
- TO NEXT N2 DEVICE (N2) 3/18
- SF1-S \ DI-1 (DI-1) 2/18
- SF2-S \ DI-2 (DI-2) 2/18
- SF3-S \ DI-3 (DI-3) 2/18
- HTG1-C \ DO-3 (DO-3) 2/18
- HTG2-C \ DO-4 (DO-4) 2/18
- HTG3-C \ DO-5 (DO-5) 2/18
- CLG1-C \ DO-6 (DO-6) 2/18
- CLG2-C \ DO-7 (DO-7) 2/18
- CLG3-C \ DO-8 (DO-8) 2/18
- SF1-C \ XT1DO1 (XT1DO-1) 2/18
- SF2-C \ XT1DO2 (XT1DO-2) 2/18
- SF3-C \ XT1DO3 (XT1DO-3) 2/18
- ZN1-T \ AI-1 (AI-1) 2/18
- ZN2-T \ AI-2 (AI-2) 2/18
- ZN3-T \ AI-3 (AI-3) 2/18
- DA1-T \ AI-6 (AI-6) 2/18
- DA2-T \ AI-7 (AI-7) 2/18
- DA3-T \ AI-8 (AI-8) 2/18

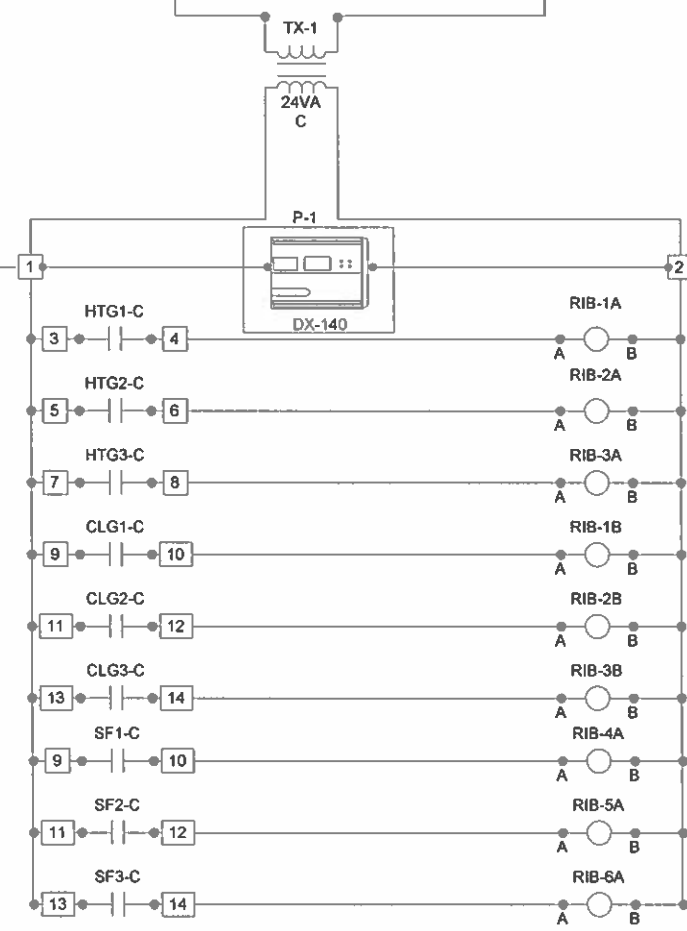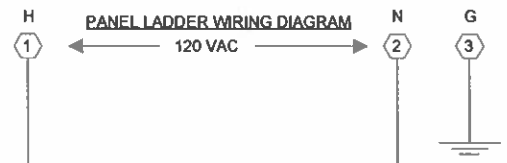


**BILL OF MATERIALS**


Designation	Qty	Part Number	Description
<b>Field Devices:</b>			
ZNx-T	3	TE-6314P-1	WALL MOUNT TEMP SENSOR
RIB x	6	CVR21C-0	RELAY-IN-A-BOX
DAx-T	3	TE-6311P-1	DUCT PROBE TEMP SENSOR
SFx-S	3	H-908	CURRENT SWITCH
<b>Panel Devices:</b>			
P-1	1	EN-EWC10-0	SINGLE UNIT

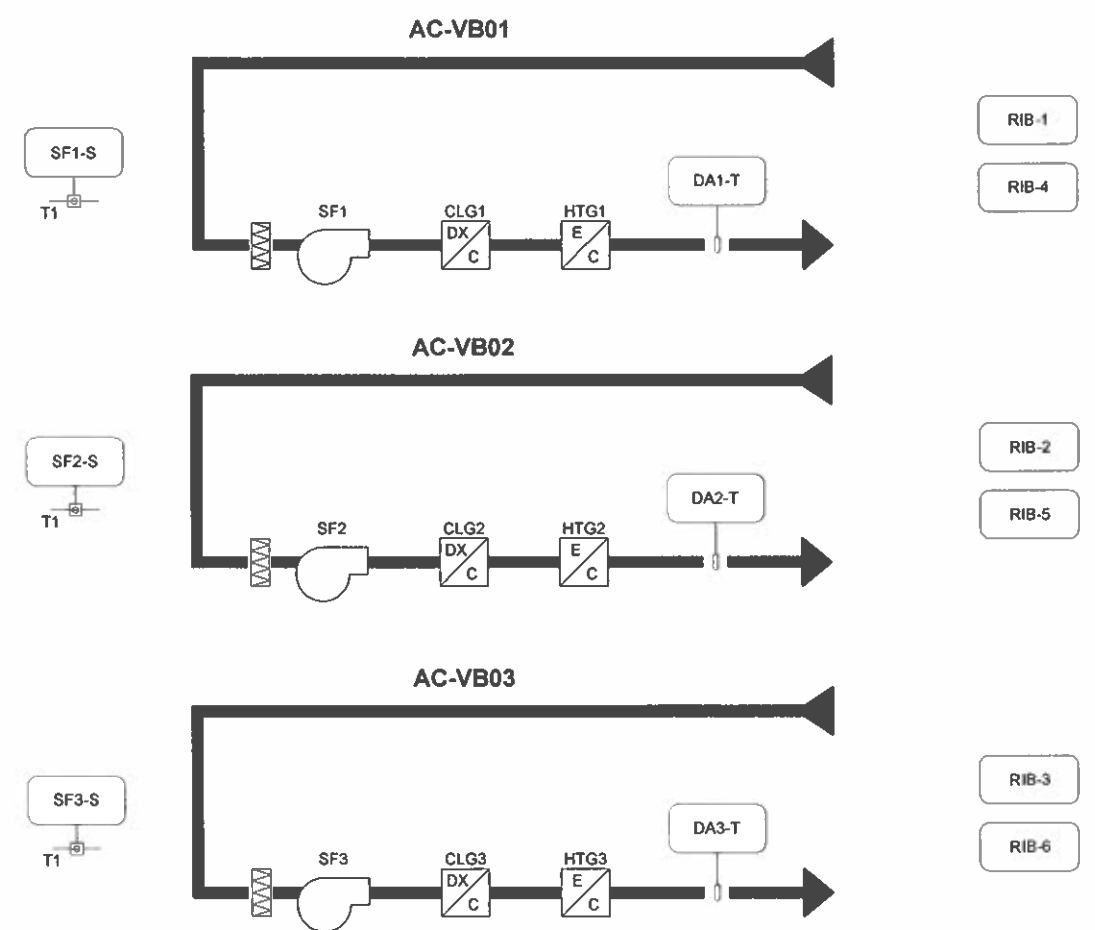


AC-VB01 WIRING

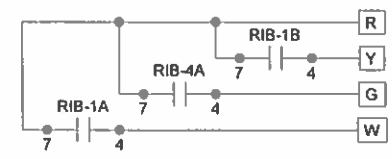

AC-VB02 WIRING

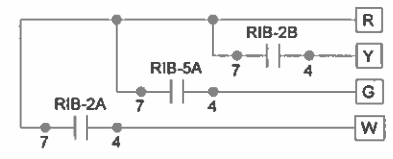


AC-VB03 WIRING

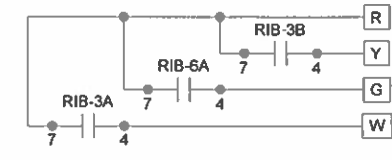

REVISION INFORMATION		Drawing Title									
NUMBER		VIDEO BOARD ROOM DETAILS									
DATE		09/03/02		Project Title		MILLER PARK ONE BREWERS WAY MILWAUKEE, WI 53214		Branch Information		CONTRACT NUMBER	
TIME		04:41 PM		FILE NAME		accv123.vsd		WISCONSIN AREA OFFICE 529 N. JACKSON STREET MILWAUKEE WI 53202 Phone: 414-524-7500 Fax: 414-524-7575		9 8075-0508	
REFERENCE DRAWING		NO		REVISION LOCATION		E/CN		DATE		BY	
Sales Engineer		Project Manager		Application Engineer		DRAWN		APPROVED			
DAM		DAM		DAM		BY MLR		DATE		BY DATE	
						JOHNSON CONTROLS		Systems & Services Division		DRAWING NUMBER	
										33.4	

AIR HANDLER I/L	START/STOP			STATUS			DISABLE			PANEL ALARM			DETAIL	COMMENT
	SYSTEM	OBJECT	PAGE #	SYSTEM	OBJECT	PAGE #	SYSTEM	OBJECT	PAGE #	SYSTEM	OBJECT	PAGE #		
NONE		DIV 18		EF	CEFS01-S	NC-11 PS-4							B	
NONE		DIV 18		EF	CEFS04-S	NC-11 PS-20							B	
NONE		DIV 18		EF	CEFS05-S	NC-11 PS-34							B	
AH-F11	EF	CEFF14-C	NC-13 PS-4	EF	CEFF14-S	NC-13 PS-4							A1	
AH-F12	EF	CEFF15-C	NC-13 PS-28	EF	CEFF15-S	NC-13 PS-28							A1	
AH-S11	EF	EFS01-C	NC-11 PS-24	EF	EFS01-S	NC-11 PS-24							A2	SEE SERVICE TUNNEL VENT
AH-S12	EF	EFS02-C	NC-11 PS-33	EF	EFS02-S	NC-11 PS-33							A2	SEE SERVICE TUNNEL VENT
AH-S11	EF	EFS03-C	NC-11 PS-26	EF	EFS03-S	NC-11 PS-26							A2	SEE SERVICE TUNNEL VENT
AH-S12	EF	EFS04-C	NC-11 PS-30	EF	EFS04-S	NC-11 PS-30							A2	SEE SERVICE TUNNEL VENT
AH-S17	EF	EFS05-C	NC-11 PS-37	EF	EFS05-S	NC-11 PS-37							F	SEE CHILLER RM VENT
C.O. ALARM	EF	EFS08-C	NC-11 PS-33	EF	EFS08-S	NC-11 PS-33				EF	EFS08-A	NC-11 PS-33	E	COM ONITOR #L
AH-S13	EF	EFS09-C	NC-11 PS-33	EF	EFS09-S	NC-11 PS-33							A2	
AH-S02,S03	EF	EFS10-C	NC-11 PS-30	EF	EFS10-S	NC-11 PS-30							A2	
AH-S02,S03	EF	EFS11-C	NC-11 PS-30	EF	EFS11-S	NC-11 PS-30							A2	
AH-S10	EF	EFS12-C	NC-11 PS-18	EF	EFS12-S	NC-11 PS-18							A2	
AH-S01,S04	EF	EFS13-C	NC-11 PS-18	EF	EFS13-S	NC-11 PS-18							A2	
AH-S02,S03		ON/OFF SWITCH		EF	EFS15-S	NC-11 PS-30	EF	EFS15-D	NC-11 PS-30	EF	EFS15-A	NC-11 PS-30	D	GREASE REM OVALEF
AH-S01,S04		ON/OFF SWITCH		EF	EFS16-S	NC-11 PS-27	EF	EFS16-D	NC-11 PS-27	EF	EFS16-A	NC-11 PS-27	D	GREASE REM OVALEF
AH-S01,S04	EF	EFS17-C	NC-11 PS-26	EF	EFS17-S	NC-11 PS-26							A2	
AH-S01,S04	EF	EFS18-C	NC-11 PS-6	EF	EFS18-S	NC-11 PS-6							A2	
AH-S02,S03	EF	EFS20-C	NC-11 PS-30	EF	EFS20-S	NC-11 PS-30							A2	
AH-S01,S04		ON/OFF SWITCH		EF	EFS21-S	NC-11 PS-24	EF	EFS21-D	NC-11 PS-24	EF	EFS21-A	NC-11 PS-24	D	GREASE REM OVALEF
AH-S05		ON/OFF SWITCH		EF	EFS22-S	NC-11 PS-24	EF	EFS22-D	NC-11 PS-24	EF	EFS22-A	NC-11 PS-24	D	GREASE REM OVALEF
AH-F13	EF	EFF01-C	NC-13 PS-5	EF	EFF01-S	NC-13 PS-5							A2	
FLFCU	EF	EFF02-C	NC-13 PS-27	EF	EFF02-S	NC-13 PS-27							A2	
FLFCU	EF	EFF03-C	NC-13 PS-25	EF	EFF03-S	NC-13 PS-25							A2	
FLFCU	EF	EFF04-C	NC-12 PS-24	EF	EFF04-S	NC-12 PS-24							A2	
FLFCU	EF	EFF05-C	NC-12 PS-24	EF	EFF05-S	NC-12 PS-24							A2	
NONE	EF	EFF07-C	NC-12 PS-32	EF	EFF07-S	NC-12 PS-32							A2	
NONE		ON/OFF SWITCH		EF	EFL03-S	NC-12 VMA-7	EF	EFL03-D	NC-12 VMA-7	EF	EFL03-A	NC-12 VMA-7	D	GREASE REM OVALEF

NOTE: SEE EXCEL SPREADSHEET FANSCH1VSD.XLS FOR SOURCE OF BITMAP.

REVISION INFORMATION	Drawing Title								
NUMBER	FAN DETAILS								
DATE	08/16/02	NO	1	RECORD DRAWINGS		4/16/2001		MLR	
TIME	10:38 AM	REFERENCE DRAWING	NO	REVISION-LOCATION		EON		DATE	
FILE NAME	fansch1-new2.vsd	Sales Engineer	PJS	Project Manager	TP	Application Engineer	KJK	DRAWN	
				BY		MLR		DATE	
				Branch Information		CONTRACT NUMBER		DATE	
						Wisconsin Area Office 529 N Jackson Street Milwaukee WI 53202 Phone: 414-524-7500 Fax: 414-524-7575		<b>9 8075-0508</b> DRAWING NUMBER <b>34.1</b>	
				Systems & Services Division					





REV	FAN	FAN LOCATION	SERVING			HP	CFM	STARTER LOCATION	AIR HANDLER I/L	START/STOP			STATUS			DISABLE			DETAIL	COMMENT	
			CL	MULT	TOILET					SYSTEM	OBJECT	PAGE #	SYSTEM	OBJECT	PAGE #	SYSTEM	OBJECT	PAGE #			
2	PRV-TB1	TB1	TERRACE BOWL ROOF	CL1	MULT	TOILET	0.5	1145	4MCC1	AH-C02	PRV	PRVTB1-C	NC-13 PS-30	PRV	PRVTB1-S	NC-13 PS-30			A2		
2	PRV-TB2	TB2	TERRACE BOWL ROOF	MULT	MULT	TOILET	3	7150	NU	AH-C01,T05,CL FCU	PRV	PRVTB2-C	NC-13 PS-30	PRV	PRVTB2-S	NC-13 PS-30			A2		
2	PRV-TB3	TB4	TERRACE BOWL ROOF	MULT	MULT	TOILET	2	4175	3MCC2	AH-C01,T05,CL FCU	PRV	PRVTB3-C	NC-13 PS-31	PRV	PRVTB3-S	NC-13 PS-31			A2		
2	PRV-TB4	TB5	TERRACE BOWL ROOF	MULT	MULT	TOILET	2	4750	2MCC2	AH-C01,T05,CL FCU	PRV	PRVTB4-C	NC-12 PS-29	PRV	PRVTB4-S	NC-12 PS-29			A2		
2	PRV-TB5	TB7	TERRACE BOWL ROOF	MULT	MULT	TOILET	3	7375	2MCC2	AH-C01,T05,CL FCU	PRV	PRVTB5-C	NC-12 PS-29	PRV	PRVTB5-S	NC-12 PS-29			A2		
2	PRV-TB6	TB8	TERRACE BOWL ROOF	CL8	MULT	TOILET	0.5	810	1MCC2	AH-T06	PRV	PRVTB6-C	NC-13 PS-30	PRV	PRVTB6-S	NC-13 PS-30			A2		
3	PRV-BG	TB8	TERRACE BOWL ROOF	TL8	5805	BEER GARDEN					5600	PRV-BG	NC12 PS30	NONE	NONE	NONE			H	CONTROLS 3 FANS	
2	UF-TB1	TB7	TERRACE BOWL ROOF	SL7	1740	FLAMMABLE STORAGE	0.5	870	2MCC2	AH-S13	UF	UFTB1-C	NC-12 PS-29	UF	UFTB1-S	NC-12 PS-29			A2		
2	UF-TB2	TB7	TERRACE BOWL ROOF	SL7	1733	PAINT SHOP	5	10000	2MCC2	AH-S13	UF	UFTB2-C	NC-12 PS-29	UF	UFTB2-S	NC-12 PS-29			A2		
2	UF-TB3	TB7	TERRACE BOWL ROOF	SL7	1785	CHEMICAL STORAGE	0.5	1075	2MCC2	AH-S13	UF	UFTB3-C	NC-12 PS-29	UF	UFTB3-S	NC-12 PS-29			A2		
2	UF-TB4	TB7	TERRACE BOWL ROOF	SL5	MULT	DARKROOM	0.5	715	2MCC2	AH-S02,S03	UF	UFTB4-C	NC-12 PS-29	UF	UFTB4-S	NC-12 PS-29			A2		
2	UF-TB5	TB6	TERRACE BOWL ROOF	SL5-8	MULT	LOCKERS	10	17145	2MCC2	AH-S02,S03	UF	UFTB5-C	NC-12 PS-29	UF	UFTB5-S	NC-12 PS-29			A2		
2	UF-TB6	TB2	TERRACE BOWL ROOF	SL1-4	MULT	LOCKERS	5	11590	3MCC2	AH-S01,S04	UF	UFTB6-C	NC-13 PS-31	UF	UFTB6-S	NC-13 PS-31			A2		
2	EF-TB01	TB1	TERRACE BOWL ROOF	FL1	2201	CONCESSION	1.5	1000	4MCC1	NONE		PB SWITCH		EF	EFTB01-S	NC-13 PS-30	EF	EFTB01-D	NC-13 PS-30	C	GREASE EF
2	EF-TB02	TB2	TERRACE BOWL ROOF	FL2	2209	PANTRY	7.5	6900	NU	NONE		PB SWITCH		EF	EFTB02-S	NC-13 PS-30	EF	EFTB02-D	NC-13 PS-30	C	GREASE EF
2	EF-TB03	TB4	TERRACE BOWL ROOF	FL4	2407	CONCESSION	5	3450	3MCC2	NONE		PB SWITCH		EF	EFTB03-S	NC-13 PS-31	EF	EFTB03-D	NC-13 PS-31	C	GREASE EF
2	EF-TB04	TB5	TERRACE BOWL ROOF	FL5	2516	CONCESSION	5	3450	2MCC2	NONE		PB SWITCH		EF	EFTB04-S	NC-12 PS-29	EF	EFTB04-D	NC-12 PS-29	C	GREASE EF
2	EF-TB05		DMT																		
2	EF-TB06	TB5	TERRACE BOWL ROOF	FL5	2511	SUITE PANTRY	3	3300	2MCC2	NONE		PB SWITCH		EF	EFTB06-S	NC-12 PS-29	EF	EFTB06-D	NC-12 PS-29	C	GREASE EF
2	EF-TB07	TB7	TERRACE BOWL ROOF	FL7	2502	PANTRY	7.5	6900	2MCC2	NONE		PB SWITCH		EF	EFTB07-S	NC-12 PS-29	EF	EFTB07-D	NC-12 PS-29	C	GREASE EF
2	EF-TB08	TB1	TERRACE BOWL ROOF	LL1	3110	CONCESSION	5	3450	4MCC1	NONE		PB SWITCH		EF	EFTB08-S	NC-13 PS-30	EF	EFTB08-D	NC-13 PS-30	C	GREASE EF
2	EF-TB09	TB4	TERRACE BOWL ROOF	LL3	3393	CONCESSION	3	3450	3MCC2	NONE		PB SWITCH		EF	EFTB09-S	NC-13 PS-31	EF	EFTB09-D	NC-13 PS-31	C	GREASE EF
2	EF-TB10	TB6	TERRACE BOWL ROOF	LL6	3601	CONCESSION	3	3450	2MCC2	NONE		PB SWITCH		EF	EFTB10-S	NC-12 PS-29	EF	EFTB10-D	NC-12 PS-29	C	GREASE EF
2	EF-TB11	TB7	TERRACE BOWL ROOF	LL7	3712	CONCESSION	5	3450	1MCC2	NONE		PB SWITCH		EF	EFTB11-S	NC-12 PS-30	EF	EFTB11-D	NC-12 PS-30	C	GREASE EF
2	EF-TB12	TB1	TERRACE BOWL ROOF	FL1	2101	BREW PUB	5	4800	4MCC1	AH-F13	EF	EFTB12-C	NC-13 PS-30	EF	EFTB12-S	NC-13 PS-30	EF	EFTB12-D	NC-13 PS-30	A2	GREASE EF
2	EF-TB13	TB8	TERRACE BOWL ROOF	FL8	2803	CONCESSION	1.5	1000	1MCC2	NONE		PB SWITCH		EF	EFTB13-S	NC-12 PS-30	EF	EFTB13-D	NC-12 PS-30	C	GREASE EF
2	EF-TB14	TB1	TERRACE BOWL ROOF	CL1	4103	STADIUM CLUB KITCHEN	10	11200	4MCC1	AH-T10	EF	EFTB14-C	NC-13 PS-30	EF	EFTB14-S	NC-13 PS-30			A2	GREASE EF	
2	EF-TB15		DMT																		
2	EF-TB16	TB2	TERRACE BOWL ROOF	CL2	4202	CLUB GRILL	3	3450	NU	AH-C01,T05	EF	EFTB16-C	NC-13 PS-30	EF	EFTB16-S	NC-13 PS-30			A2	GREASE EF	
2	EF-TB17	TB2	TERRACE BOWL ROOF	CL2	4215	PANTRY	3	3300	NU	AH-C01,T05	EF	EFTB17-C	NC-13 PS-30	EF	EFTB17-S	NC-13 PS-30			A2	GREASE EF	
2	EF-TB18	TB4	TERRACE BOWL ROOF	?	?	?	3	3450	3MCC2	AH-C01,T05	EF	EFTB18-C	NC-13 PS-31	EF	EFTB18-S	NC-13 PS-31			A2	GREASE EF	
2	EF-TB19	TB5	TERRACE BOWL ROOF	CL5	4508	CLUB GRILL	3	3450	2MCC2	AH-C01,T05	EF	EFTB19-C	NC-12 PS-29	EF	EFTB19-S	NC-12 PS-29			A2	GREASE EF	
2	EF-TB20	TB5	TERRACE BOWL ROOF	CL5	4522	SUITE KITCHEN	0.5	1500	2MCC2	AH-C01,T05	EF	EFTB20-C	NC-12 PS-29	EF	EFTB20-S	NC-12 PS-29			A2	GREASE EF	
2	EF-TB21	TB5	TERRACE BOWL ROOF	CL5	4522	SUITE KITCHEN	7.5	7000	2MCC2	AH-C01,T05	EF	EFTB21-C	NC-12 PS-29	EF	EFTB21-S	NC-12 PS-29			A2	GREASE EF	
2	EF-TB22	TB7	TERRACE BOWL ROOF	CL7	4718	CONCESSION	3	3450	1MCC2	AH-C01,T05	EF	EFTB22-C	NC-12 PS-30	EF	EFTB22-S	NC-12 PS-30			A2	GREASE EF	
2	EF-TB23	TB7	TERRACE BOWL ROOF	CL7	4716	PANTRY	3	3300	1MCC2	AH-C01,T05	EF	EFTB23-C	NC-12 PS-30	EF	EFTB23-S	NC-12 PS-30			A2	GREASE EF	
2	EF-TB24	TB1	TERRACE BOWL ROOF	TC1	5103	CONCESSION	3	3450	4MCC1	NONE		PB SWITCH		EF	EFTB24-S	NC-13 PS-30	EF	EFTB24-D	NC-13 PS-30	C	GREASE EF
2	EF-TB25	TB1	TERRACE BOWL ROOF	TC1	5108	PANTRY	3	3450	4MCC1	NONE		PB SWITCH		EF	EFTB25-S	NC-13 PS-30	EF	EFTB25-D	NC-13 PS-30	C	GREASE EF
2	EF-TB26	TB2	TERRACE BOWL ROOF	TC2	5203	CONCESSION	3	3450	NU	NONE		PB SWITCH		EF	EFTB26-S	NC-13 PS-30	EF	EFTB26-D	NC-13 PS-30	C	GREASE EF
2	EF-TB27	TB2	TERRACE BOWL ROOF	TC2	5209	CONCESSION	3	3450	3MCC2	NONE		PB SWITCH		EF	EFTB27-S	NC-13 PS-31	EF	EFTB27-D	NC-13 PS-31	C	GREASE EF
2	EF-TB28	TB4	TERRACE BOWL ROOF	TC4	5413	CONCESSION	3	3450	3MCC2	NONE		PB SWITCH		EF	EFTB28-S	NC-13 PS-31	EF	EFTB28-D	NC-13 PS-31	C	GREASE EF
2	EF-TB29	TB4	TERRACE BOWL ROOF	TC4	5414	CONCESSION	3	3450	3MCC2	NONE		PB SWITCH		EF	EFTB29-S	NC-13 PS-31	EF	EFTB29-D	NC-13 PS-31	C	GREASE EF
2	EF-TB30	TB5	TERRACE BOWL ROOF	TC5	5514	CONCESSION	3	3450	2MCC2	NONE		PB SWITCH		EF	EFTB30-S	NC-12 PS-29	EF	EFTB30-D	NC-12 PS-29	C	GREASE EF
2	EF-TB31	TB7	TERRACE BOWL ROOF	TC7	5603	CONCESSION	3	3450	2MCC2	NONE		PB SWITCH		EF	EFTB31-S	NC-12 PS-29	EF	EFTB31-D	NC-12 PS-29	C	GREASE EF
2	EF-TB32	TB7	TERRACE BOWL ROOF	TC7	5705	CONCESSION	3	3450	1MCC2	NONE		PB SWITCH		EF	EFTB32-S	NC-12 PS-30	EF	EFTB32-D	NC-12 PS-30	C	GREASE EF
2	EF-TB33	TB8	TERRACE BOWL ROOF	TC8	5807	CONCESSION	3	3450	1MCC2	NONE		PB SWITCH		EF	EFTB33-S	NC-12 PS-30	EF	EFTB33-D	NC-12 PS-30	C	GREASE EF
2	EF-TB34	TB1	TERRACE BOWL ROOF	CL1	4138	STADIUM CLUB KITCHEN	3	7200	NONE	NONE		PB SWITCH		EF	EFTB34-S	NC-13 PS-30	EF	EFTB34-D	NC-13 PS-30	G	GREASE EF
2	EF-TB35	TB1	TERRACE BOWL ROOF	CL1	4138	STADIUM CLUB KITCHEN	1	2565	NONE	NONE		PB SWITCH		EF	EFTB35-S	NC-13 PS-30	EF	EFTB35-D	NC-13 PS-30	G	DISHWASHER EF

NOTE: SEE EXCEL SPREADSHEET FANSCH2VSD.XLS FOR SOURCE OF BITMAP.

REVISION INFORMATION	Drawing Title								
NUMBER	FAN DETAILS								
DATE	08/16/02	Project Title	MILLER PARK ONE BREWERS WAY MILWAUKEE, WI 53214		Branch Information		Wisconsin Area Office 529 N. Jackson Street Milwaukee WI 53202 Phone: 414-524-7500 Fax: 414-524-7575		CONTRACT NUMBER <b>9 8075-0508</b>
TIME	10:07 AM	Application Engineer	KJK		DRAWN		APPROVED		DRAWING NUMBER <b>34.2</b>
FILE NAME	fansch2.vsd	Sales Engineer	PJS	Project Manager	TP	DATE	DATE	DATE	
		JOHNSON CONTROLS		Systems & Services Division					

**BILL OF MATERIALS**


Designation	Qty	Part Number	Description
Field Devices:			
EFx-Ca, EFx-Sa	1	RIBX24S8A	FD SPST, W/HOA, 24V COIL, 3/4 HP
EFx-Cb, EFx-Sb	1	H-735	SW, CURRENT, 1-135A CMND RLY SOLID @VER

**DETAIL A**  
TYPICAL OF 42




**DETAIL A1**

EXHAUST FAN STARTER WIRING  
TYPICAL OF 2

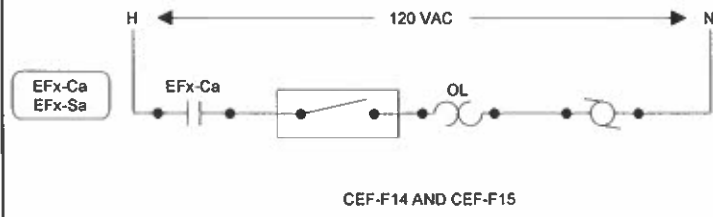

**DETAIL A2**

EXHAUST FAN STARTER WIRING  
TYPICAL OF 40

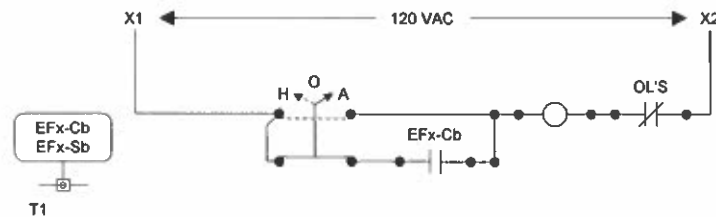


**BILL OF MATERIALS**

Designation	Qty	Part Number	Description
Field Devices:			
EFx-S	1	H-908	SW, CURRENT, 1-135A ADJ, SPLIT @VER

**DETAIL B**  
TYPICAL OF 3



EXHAUST FAN STARTER WIRING

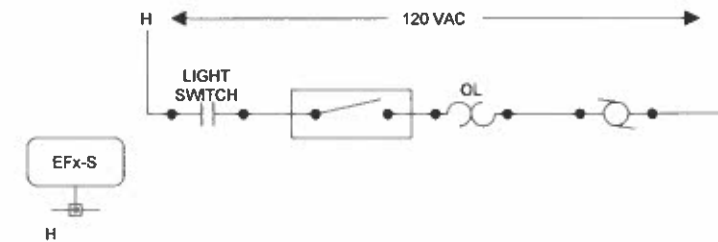

**Toilet Exhaust Fans**

1. CEF-S01, S04, and S05 will be interlocked by Division 16 to run whenever their respective light switch is turned on. The EMCS will monitor the status (on/off) of each fan through a current switch located on the feed to the motor.

**Schedule Controlled Exhaust Fans**

1. The EMCS will energize each exhaust fan through a predetermined schedule. The fans associated with the air handlers will operate in unison with air handling units serving the same areas as indicated in the air handling interlock schedule.
2. The EMCS will monitor the status (on/off) of each fan through a current switch located on the feed to the motor. A separate start/stop will be provided for each exhaust fan also.

REVISION INFORMATION	Drawing Title				
NUMBER	FAN DETAILS				
DATE	04/13/01	REFERENCE DRAWING	NO.	REVISION-LOCATION	ECN
TIME	01:31 PM	Sales Engineer	Project Manager	Application Engineer	DATE
FILE NAME	fandatab.vsd	PJS	TP	KJK	BY MLR
Project Title		DRAWN		APPROVED	
MILLER PARK ONE BREWERS WAY MILWAUKEE, WI 53214		BY MLR		DATE	
JOHNSON CONTROLS Systems & Services Division		Branch Information		CONTRACT NUMBER	
		Wisconsin Area Office 529 N. Jackson Street Milwaukee WI 53202 Phone: 414-524-7500 Fax: 414-524-7575		9 8075-0508	
				DRAWING NUMBER	
				34.3	


**BILL OF MATERIALS**

Designation	Qty	Part Number	Description
<b>Field Devices:</b>			
EFx-S, EFx-D	1	H-735	SW,CURRENT,1-135A,CMND RLY,SOLID
TX-1	1	Y63T31-0	XFMR,120-208-240/24,50VA,FT-PLT [Y63SLB]
<b>Panel Devices:</b>			
L-1	1	PD-103-7	LED,GRN,24V,SNAP FIT
MS-1, 2	2	PD-105-1	MOM PSH BUTTN,1NO/1NC,BLK
	1	PLATE	2-GANG,BLANK,SS PLATE
R-1	1	PD-101-35	RLY,BASE,3PDT,11PIN,10A,IDEC #SR3B-05
	1	PD-109-51	RLY,PLUG-IN,3PDT,24VAC,P&B KUP14A25-24

**DETAIL C**  
TYPICAL OF 20



**EXHAUST FAN STARTER WIRING**

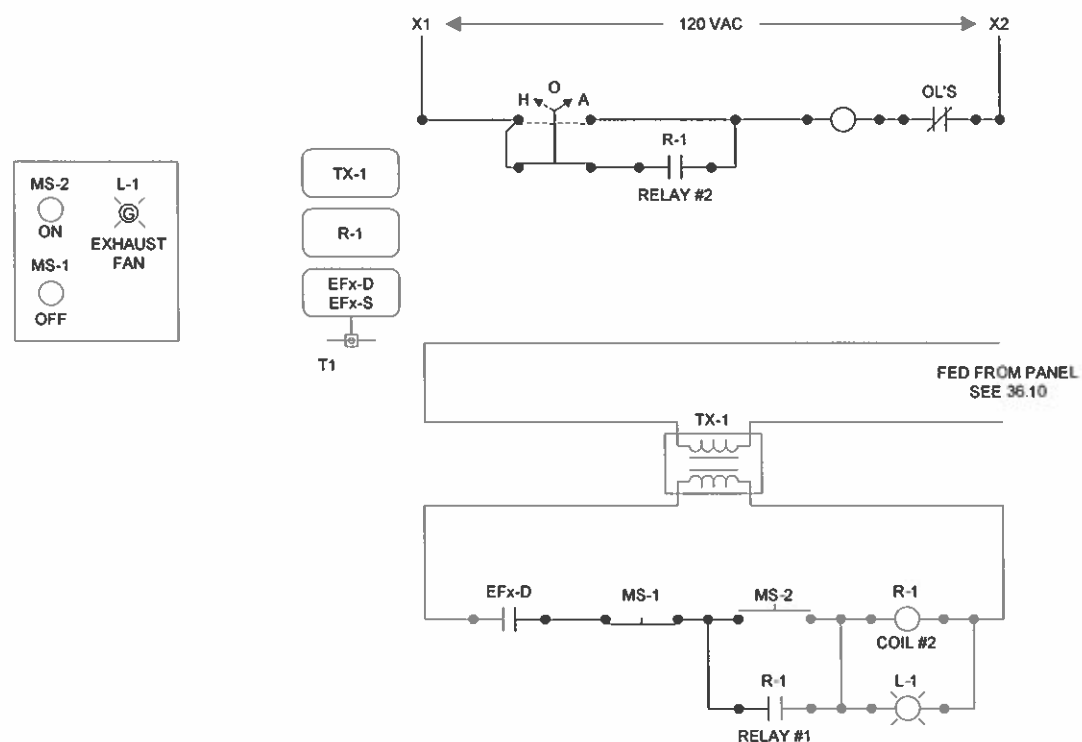

**Food Service Grease Exhaust Fans (Non-Fan Interlocked)**


- For each fan, provide a local on-off pushbutton switch with a green indicating light in the food service area being served. When the "on" button is depressed, the green light will illuminate and the associated exhaust fan will energize. When the "off" button is pressed, the green light will turn off and the associated exhaust fan will de-energize. An EMCS point for each individual exhaust fan will energize for 5 seconds to unlatch the start push button signal to automatically de-energize the associated exhaust fan and turn off the green light based on the EMCS schedule. The only way to start the exhaust fan is via the "on" button, while the "off" button or the EMCS can stop the exhaust fan. Provide monitoring status of fan operation from the EMCS.

**BILL OF MATERIALS**

Designation	Qty	Part Number	Description
<b>Field Devices:</b>			
EFx-S	1	H-908	SW,CURRENT,1-135A,ADJ,SPLIT @VER

**DETAIL D**  
TYPICAL OF 5


Unit	Number of Filter Boxes
EF-S15	1
EF-S16	1
EF-S21	2
EF-S22	7
EF-L03	2

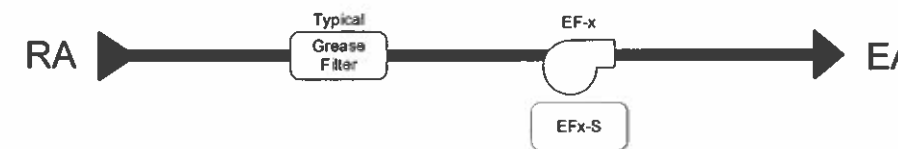

Fan Control Panel Terminals						
Unit	Room	EFx-C		EFx-A		
		a	b	x	y	
EF-S15	1525	40	41	12	8	CR2
EF-S16	1310	40	41	12	8	CR2
EF-S21	1129	50	51	12	8	CR2A & CR2B *
EF-S22	1211	22	23	12	8	CR2
EF-L03	3818	50	51	12	8	CR2A & CR2B *

\* NOTE: Wire contacts 12/8 on CR2A and CR2B in parallel.

**PARTIAL CONTROL PANEL WIRING**

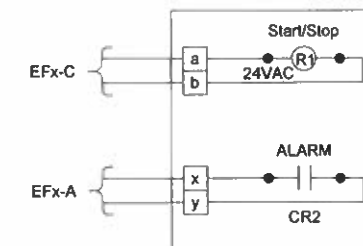

NOTE: SEE MANUFACTURER'S WIRING DIAGRAM FOR COMPLETE WIRING DETAILS.

**Grease Fan/Filter System Wiring**

Exhaust Fan	Control Panel	Fan Cabinet	Filter Box
EF-15 EF-16	2	2	2
	5	5	
	3		3
	6		6
	7		7
	8		8
	9		9
EF-S21 EF-S22 EF-L03	10		10
	21		21
	31		31
	2	2	
	3	3	3x
	5	5	
	21	21	
	31	31	
	6x		6x
	7x		7x
8x		8x	
9x		9x	
10x		10x	

**Grease Removal Fan and Filter System**


- For each fan unit install and wire a local control panel provided by others, where shown on the drawings, furnished by the unit manufacturer. Division 16 will provide 120 VAC wiring to the local control panel and to the filter box on each grease removal filter section.
- The manufacturer's control panel includes the following features:  
Power on and system on lights  
Hand-Off-Auto keyswitch  
Odor control cycle on-off-cycle switch  
Odor control on light  
Audible alarm and reset  
Filter monitor lights
- Provide 24 volt wiring from each filter box to the local control panel.
- Provide 24 volt wiring from the control panel to the fan cabinet.
- Wire the start-stop relay in the local control panel, furnished by the unit manufacturer, to the start-stop control signal from the EMCS. Provide monitoring status of fan operation and alarm status from the EMCS.
- When the exhaust fan is energized, its associated interlocked make-up air handling unit will be energized (See the air handling unit interlock schedule).

<b>REVISION INFORMATION</b>		Drawing Title									
NUMBER		FAN DETAILS									
DATE		08/16/02		REFERENCE DRAWING		NO.		REVISION-LOCATION		ECH DATE BY	
TIME		10:12 AM		Sales Engineer		Project Manager		Application Engineer		DRAWN APPROVED	
FILE NAME		fandctcd.vsd		PJS		TP		KJK		BY MLR DATE	
				Project Title		Branch Information		CONTRACT NUMBER		DRAWING NUMBER	
				MILLER PARK ONE BREWERS WAY MILWAUKEE, WI 53214		Wisconsin Area Office 529 N. Jackson Street Milwaukee WI 53202 Phone: 414-524-7500 Fax: 414-524-7575		9 8075-0508		34.4	
				JOHNSON CONTROLS Systems & Services Division							


**BILL OF MATERIALS**

Designation	Qty	Part Number	Description
Field Devices:			
EFx-C, EFx-S	1	H-735	SW, CURRENT, 1-135A CMND RLY SOLID @VER
R-1	2	CVR-21C-O	RLY 2SPDT, 10-30VAC/DC OR 120VAC, LED @LEC
TX-1	1	Y63T31-O	XFMR, 120-208-240/24, 50VA, FT-PLT [Y63SLB]


**DETAIL E**  
TYPICAL OF 1

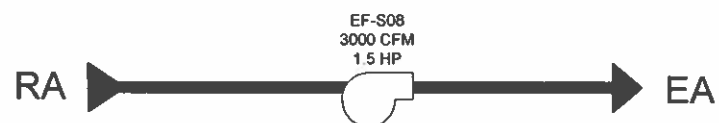

**EXHAUST FAN STARTER WIRING**

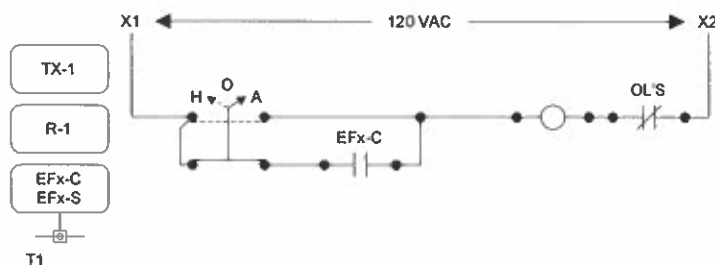

**PARTIAL CO WIRING**

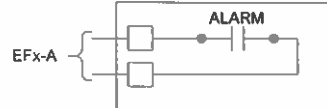


Exhaust Fan EF-S08

- The fan will automatically turn on whenever there are high levels of carbon monoxide in the space. Provide monitoring status of fan operation from the EMCS.


**BILL OF MATERIALS**

Designation	Qty	Part Number	Description
Field Devices:			
EFx-C, EFx-S	1	H-735	SW, CURRENT, 1-135A CMND RLY SOLID @VER

**DETAIL F**  
TYPICAL OF 1

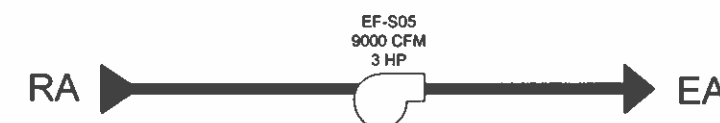

**EXHAUST FAN STARTER WIRING**

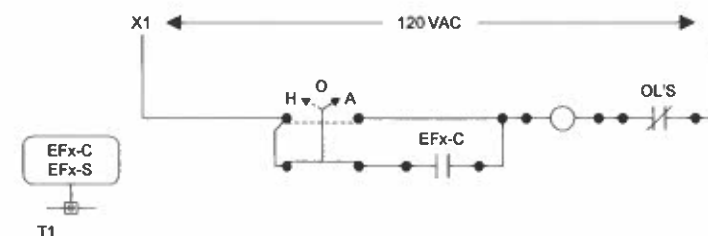

Exhaust Fan EF-S05

- See Chiller Room Ventilation sequence of operation.

REVISION INFORMATION	Drawing Title								
	NUMBER	FAN DETAILS	1		RECORD DRAWING		6/14/2001		MLR
DATE	06/15/01	REFERENCE DRAWING	NO		REVISION LOCATION		ECH	DATE	BY
TIME	07:32 AM	Sales Engineer	PJS	Project Manager	TP	Application Engineer	KJK	BY	MLR
FILE NAME	fandetef.vsd	Project Title		Branch Information		DRAWN		APPROVED	DATE
		MILLER PARK ONE BREWERS WAY MILWAUKEE, WI 53214		 Systems & Services Division		Wisconsin Area Office 529 N. Jackson Street Milwaukee WI 53202 Phone 414-524-7500 Fax: 414-524-7575		CONTRACT NUMBER <b>9 8075-0508</b> DRAWING NUMBER <b>34.5</b>	


**BILL OF MATERIALS**

Designation	Qty	Part Number	Description
Field Devices:			
EFx-S, EFx-D	1	H-908	SW,CURRENT 2 5-135A,ADJ,SPLIT
TX-1	1	Y63T31-0	XFMR, 120-208-240/24,50VA,FT-PLT [Y63SLB]
Panel Devices:			
L-1	1	PD-103-7	LED,GRN,24V,SNAP FIT
MS-1, 2	2	PD-105-1	MOM PSH BUTTN,1NO/1NC,BLK
	1	PLATE	2-GANG BLANK SS PLATE
R-1	1	PD-101-35	RLY BASE,3PDT,11PIN,10A,IDEC #SR3B-05
	1	PD-109-51	RLY,PLUG-IN,3PDT,24VAC,P&B KUP14A25-24

**DETAIL G**  
TYPICAL OF 2



**EXHAUST FAN STARTER WIRING**

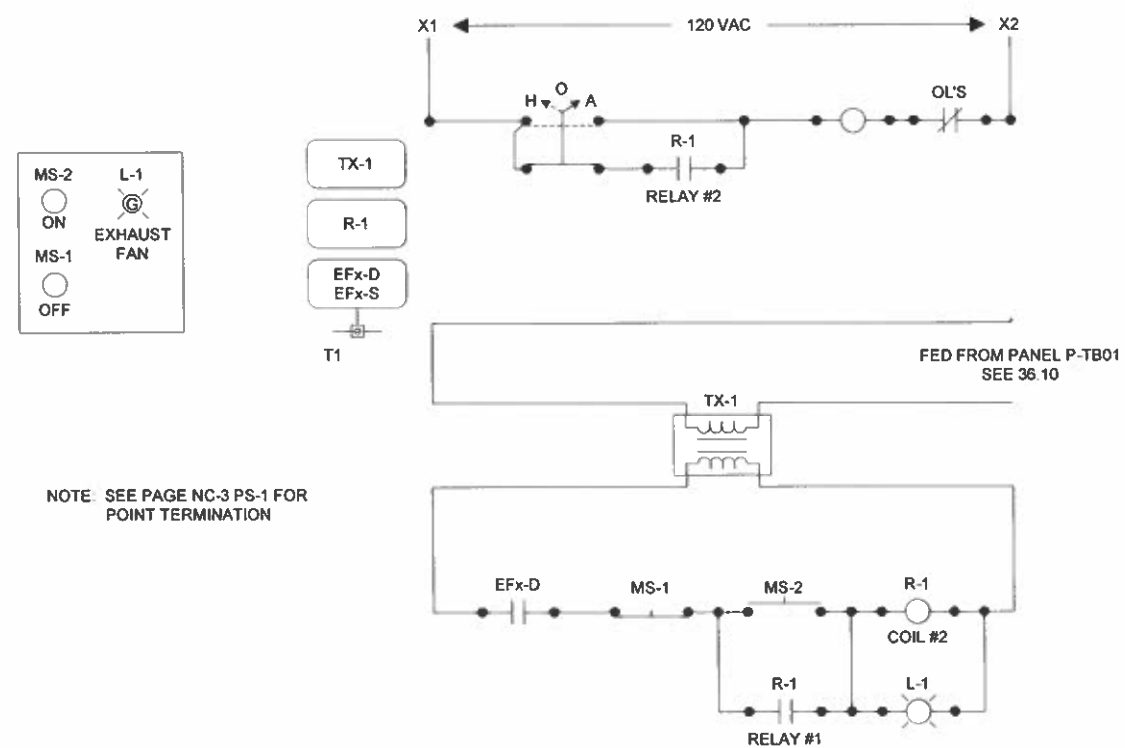

NOTE: SEE PAGE NC-3 PS-1 FOR POINT TERMINATION

**Food Service Exhaust Fans (Non-Fan Interlocked)**

- For each fan, provide a local on-off pushbutton switch with a green indicating light in the food service area being served. When the "on" button is depressed, the green light will illuminate and the associated exhaust fan will energize. When the "off" button is pressed, the green light will turn off and the associated exhaust fan will de-energize. An EMCS point for each individual exhaust fan will energize for 5 seconds to unlatch the start push button signal to automatically de-energize the associated exhaust fan and turn off the green light based on the EMCS schedule. The only way to start the exhaust fan is via the "on" button, while the "off" button or the EMCS can stop the exhaust fan. Provide monitoring status of fan operation from the EMCS.

**BILL OF MATERIALS**

Designation	Qty	Part Number	Description
Panel Devices:			
R-1	1	PD-101-35	RLY BASE,3PDT,11PIN,10A,IDEC #SR3B-05
	1	PD-109-51	RLY,PLUG-IN,3PDT,24VAC,P&B KUP14A25-24

**DETAIL H**  
TYPICAL OF 1



**EXHAUST FAN STARTER WIRING**




NOTE: SEE PAGE NC-12 PS-30 FOR POINT TERMINATION

REVISION INFORMATION	Drawing Title				
NUMBER	FAN DETAILS				
DATE	08/16/02	REFERENCE DRAWING	NO	REVISION-LOCATION	ECN DATE BY
TIME	10:08 AM	Sales Engineer	PJS	Project Manager	TP
FILE NAME	fandetg.vsc	Application Engineer	KJK	BY	MLR DATE
Project Title		Branch Information		CONTRACT NUMBER	
MILLER PARK ONE BREWERS WAY MILWAUKEE, WI 53214		<b>JOHNSON CONTROLS</b> Systems & Services Division		Wisconsin Area Office 529 N. Jackson Street Milwaukee WI 53202 Phone: 414-524-7500 Fax: 414-524-7575	
				9 8075-0508	
				DRAWING NUMBER	
				34.6	

**BILL OF MATERIALS**

Designation	Qty	Part Number	Description
<b>Field Devices:</b>			
C-VLV-X	0	VALVE	SEE ROOM SCHEDULE
HTG-O	1	AAR	ANALOG ADJUSTABLE RELAY
MOA-DPR	0	DAMPER	SEE DAMPER SCHEDULE
SF-C, SF-S	1	H-735	SW, CURRENT, 1-135A CMND RLY SOLID @VER
TX-1	1	Y63T31-0	XFMR, 120/24, 50VA, PLATE
VAV-X	1	AS-ENC100-0	GENER ASC ENC, 6.8X7.3X6.9
	1	AS-VAV141-1	VAV CONTROLLER 6 BO & 2 AO SCREW TERM.
ZN-T	1	TE-6411S-2010	MSTAT, NI, W-C, SUR, TB, TH
DA-T	1	TE-6311P-1	DUCT MOUNT TEMP SENSOR

**DETAIL B**  
TYPICAL OF 81

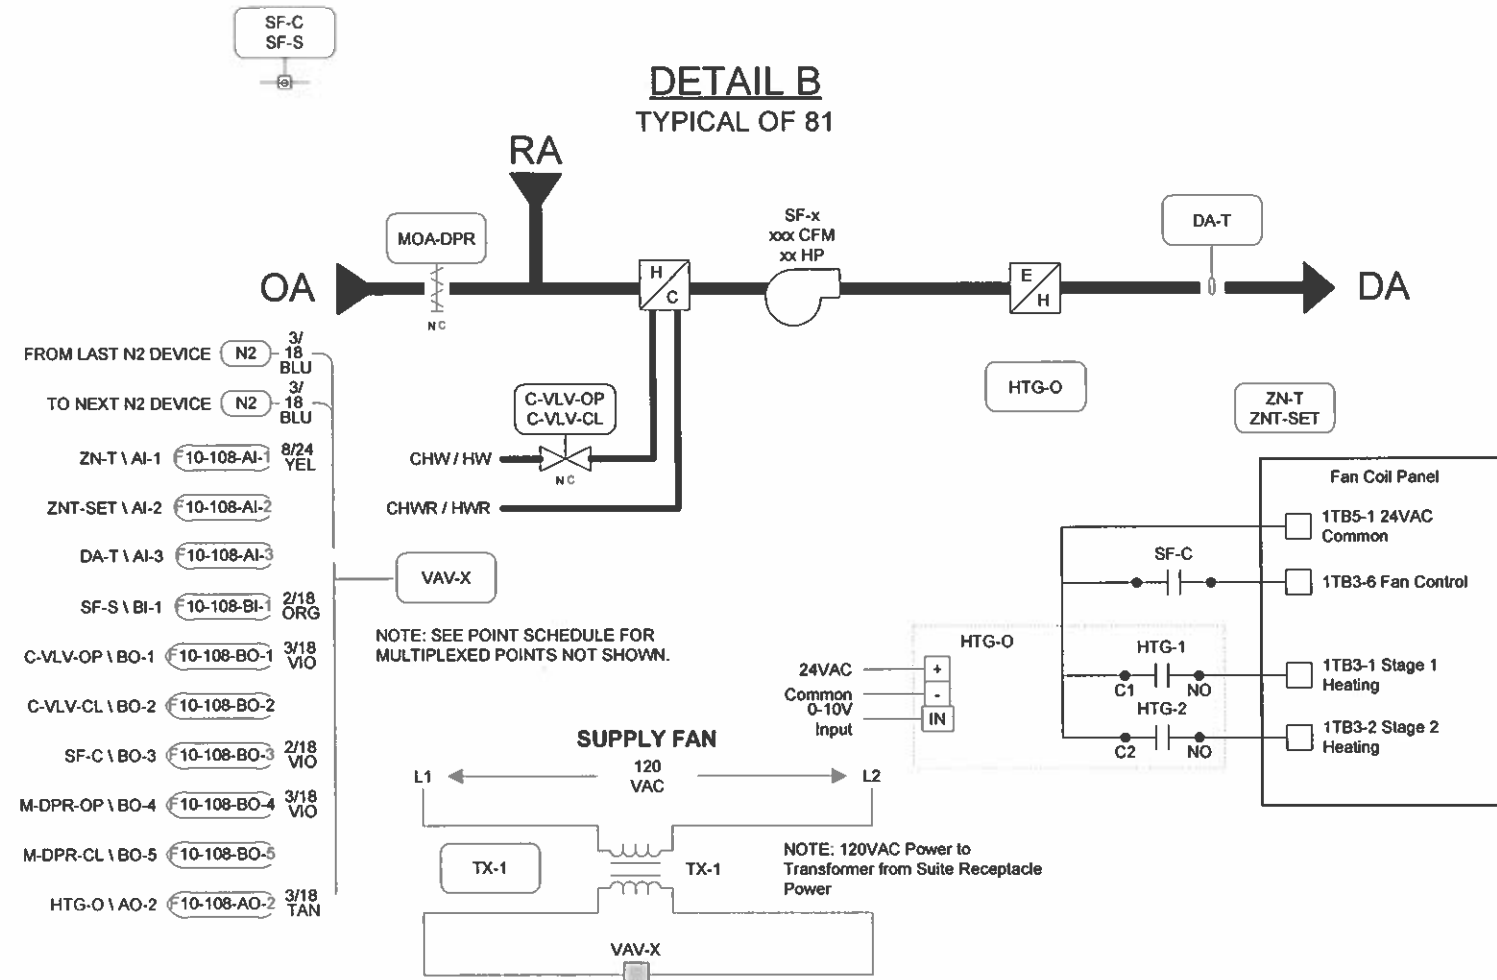

**Fan Coils - Sequence of Operation:**

*Occupied Operation (Summer):*



The supply fan will start based on a command from the Metasys system. When the fan status is "On", the outside air damper opens and the heating and cooling cycles are allowed to operate. If the room temperature is higher than its occupied setpoint, the cooling/heating valve will open to cool the room down until the room temperature is at its setpoint. If the room temperature is lower than its setpoint, the valve will close and the electric heat stages on. At this point, Metasys will control the air temperature leaving the fan coil such that the electric heat will produce no more than a 120° discharge temperature. As room warms up, the discharge temperature gradually decreases until the room temperature is at its setpoint.

*Occupied Operation (Winter):*

The supply fan will start based on a command from the Metasys system. When the fan status is "On", the outside air damper opens and the heating cycle is allowed to operate. If the room temperature is higher than its occupied setpoint, the cooling/heating valve will close to cool the room down until the room temperature is at its setpoint. If the room temperature is lower than its setpoint, the cooling/heating valve will be allowed to open to a maximum of 20% open. At this point, Metasys will control the air temperature leaving the fan coil such that the cooling/heating valve will produce no more than a 120° discharge temperature. As room warms up, the discharge temperature gradually decreases until the room temperature is at its setpoint. The electric heat stages are locked out during winter operation.

REVISION INFORMATION	Drawing Title	ROOM SCHEDULE DETAIL B - FAN COILS		RECORD DRAWINGS		8/14/2001	MLR
	NUMBER	1		REVISION-LOCATION		ECN	DATE
DATE	08/16/02	Sales Engineer	PJS	Project Manager	TP	Application Engineer	KJK
TIME	10:08 AM	Project Title		Branch Information		CONTRACT NUMBER	
FILE NAME	rsdet-b.vsc	MILLER PARK ONE BREWERS WAY MILWAUKEE, WI 53214		Wisconsin Area Office 529 N. Jackson Street Milwaukee WI 53202 Phone: 414-524-7500 Fax: 414-524-7575		9 8075-0508	
		JOHNSON CONTROLS Systems & Services Division		DRAWING NUMBER		35.1B	

**DETAIL C**  
Typical of 21

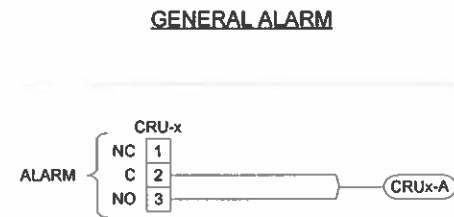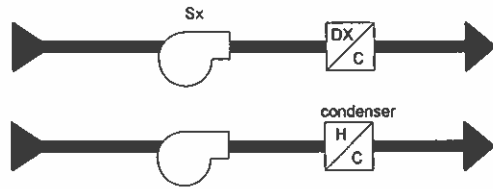


Rev.	MECHANICAL SYSTEM	LOCATION	SYSTEM	OBJECT	PAGE #
3	CRU-S01	S-7	CRU-ALM	CRUS01-A	NC-11 PS-13
3	CRU-S02	S-8	CRU-ALM	CRUS02-A	NC-11 PS-20
3	CRU-S04	S-1	CRU-ALM	CRUS04-A	NC-11 PS-5
3	CRU-S05	S-1	CRU-ALM	CRUS05-A	NC-11 PS-19
3	CRU-S06	S-4	CRU-ALM	CRUS06-A	NC-11 PS-25
3	CRU-S07	S-5	CRU-ALM	CRUS07-A	NC-11 PS-28
3	CRU-S08	S-8	CRU-ALM	CRUS08-A	NC-11 PS-33
3	CRU-L01	L-8	CRU-ALM	CRUL01-A	NOTE 1
3	CRU-L02	L-8	CRU-ALM	CRUL02-A	NOTE 1
3	CRU-L03	L-5	CRU-ALM	CRUL03-A	NC-12 PS-9
3	CRU-L04	L-4	CRU-ALM	CRUL04-A	NC-12 PS-28
3	CRU-L05	L-7	CRU-ALM	CRUL05-A	NC-12 PS-17
3	CRU-L06	L-1	CRU-ALM	CRUL06-A	NC-13 PS-7
3	CRU-L07	L-2	CRU-ALM	CRUL07-A	NC-13 PS-23
3	CRU-L08	L-4	CRU-ALM	CRUL08-A	NC-12 PS-28
3	CRU-L09	L-4	CRU-ALM	CRUL09-A	NC-12 PS-28
3	CRU-L10	L-4	CRU-ALM	CRUL10-A	NC-12 PS-28
3	CRU-T01	TC-2	CRU-ALM	CRUT01-A	NC-13 PS-23
3	CRU-T02	TC-7	CRU-ALM	CRUT02-A	NC-12 PS-16
3	CRU-T03	TC-5	CRU-ALM	CRUT03-A	NC-12 PS-29
3	CRU-T04	TC-5	CRU-ALM	CRUT04-A	NC-12 PS-9

NOTE 1: MUX POINTS TO VAVA307 DI-1 & DI-2 RESPECTIVELY.

**COMMUNICATION ROOM UNIT WIRING**

NOTE: SEE MANUFACTURER'S WIRING DIAGRAM FOR COMPLETE WIRING DETAILS.

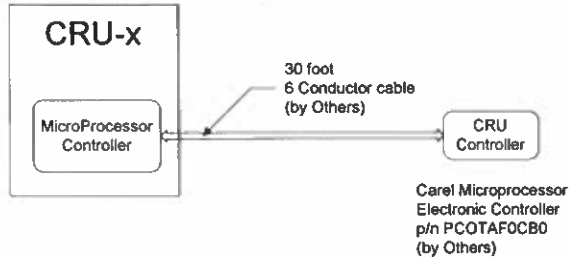


**Communication Room Units (General Alarm)**

The systems will operate via their own on-board controllers; the EMCS will monitor alarm signals only. In addition, install remote controls and provide all field control wiring from unit panels to remote controls furnished by the unit manufacturer.

**BILL OF MATERIALS**

Designation	Qty	Part Number	Description
Field Devices:			
ACSx-T	1	TE-6314P-1	SENS,T-Ni,0.1% RM
TC-1	1	A350AA-3C	CTRL,SPDT,-30-130F,W/SENS
	1	BKT287-1R	35MM DIN RAIL - 12" LONG
	1	EN-EWC10-0	SINGLE UNIT
	1	PLT344-1R	DIN RAIL END PLT (2/PKG)
	2	S350AA-1C	SEQ,SPDT,F/A350,1/30F
	1	Y65A21-0	XFMR,120/24,40VA,PLATE [Y65AA]

**DETAIL D**  
Typical of 5

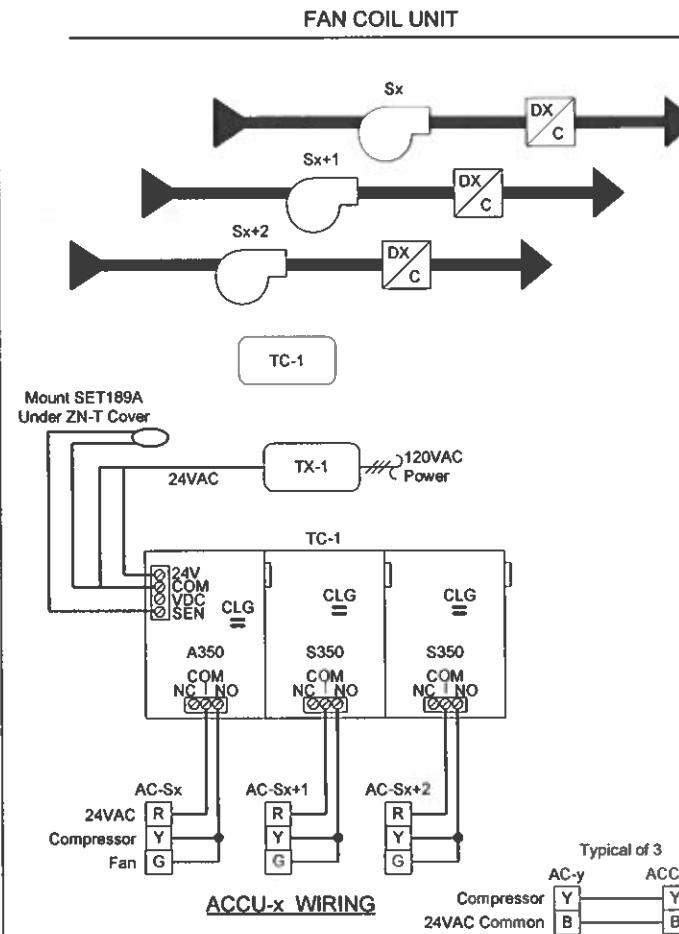

NOTE: SEE MANUFACTURER'S WIRING DIAGRAM FOR COMPLETE WIRING DETAILS.

**Direct Expansion Fan Coil Units and Condensing Units**

- For each room being conditioned by three fan coil units, provide a 24 volt three stage room thermostat which will energize the fan coil units in stages to maintain setpoint. Provide interlock wiring to energize the associated condensing units on a call for cooling.
- Monitor the space temperature, for each room served, through the EMCS.

**ROOM TEMPERATURE**

Rev.	MECHANICAL SYSTEM	LOCATION	SYSTEM	OBJECT	PAGE #
3	AC-S01, -S02, -S03	SL1	AC-TEMP	ACSO1-T	NC-11 PS-5
3	AC-S04, -S05, -S06	SL6	AC-TEMP	ACSO4-T	NC-11 PS-28
3	AC-S07, -S08, -S09	SL8	AC-TEMP	ACSO7-T	NC-11 PS-33
3	AC-S10, -S11, -S12	SL8	AC-TEMP	ACS10-T	NC-11 PS-36
3	AC-S15, -S16, -S17	SL3	AC-TEMP	ACS15-T	NC-11 PS-7

**A350**  
SETPOINT=81F  
DIFFERENTIAL=1

**S350**  
DIFFERENTIAL= 2  
OFFSET=1


**S350**  
DIFFERENTIAL=2  
OFFSET=3

REVISION INFORMATION	Drawing Title	REFERENCE DRAWING				DRAWN		APPROVED	
NUMBER	<b>ROOM SCHEDULE DETAILS</b>	NO.	NO.	NO.	NO.	DATE	DATE	DATE	DATE
DATE	08/16/02	DATE	DATE	DATE	DATE	DATE	DATE	DATE	DATE
TIME	10:07 AM	DATE	DATE	DATE	DATE	DATE	DATE	DATE	DATE
FILE NAME	rsdetcd.vsc	DATE	DATE	DATE	DATE	DATE	DATE	DATE	DATE
	Project Title	Branch Information		CONTRACT NUMBER					
	<b>MILLER PARK ONE BREWERS WAY MILWAUKEE, WI 53214</b>	Wisconsin Area Office 529 N. Jackson Street Milwaukee WI 53202 Phone: 414-524-7500 Fax: 414-524-7575		<b>9 8075-0508</b>					
		<b>JOHNSON CONTROLS</b> Systems & Services Division		<b>35.2</b>					


**BILL OF MATERIALS**

Designation	Qty	Part Number	Description
Field Devices:			
DA-T	1	TE-6311P-1	SENS,T-Ni,0.1%,8" DUCT
R-1-R-3	3	CVR-21C-O	RLY 2SPDT,10-30VAC/DC OR 120VAC.LED @LEC
SF-C,SF-S	1	H-735	SW, CURRENT, 1-135A CMND RLY SOLID @VER
TS-1	2	A70HA-1C	STAT,LL,20',EL,MAN,15/55F
	1	TE-6001-8	CLIP F/AVG ELEM (10/PKG)
X-VLV	0	VALVE	SEE VALVE SCHEDULE
ZN-T	1	TE-6314P-1	SENS,T-Ni,0.1%,RM

ZN-T NOTE: SEE ROOM SCHEDULE FOR LOCATION.

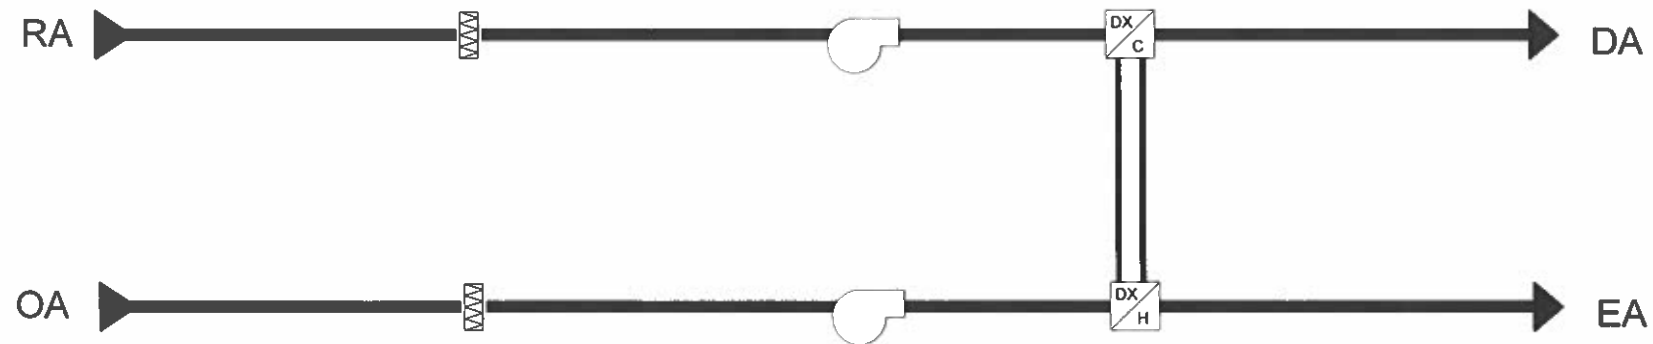

**SUPPLY FAN STARTER**

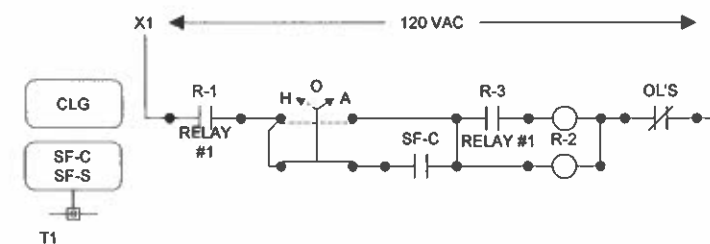


REVISION INFORMATION NUMBER DATE 08/16/01 TIME 04:02 PM FILE NAME CRUS03F.vsd	Drawing Title										
	CRU-S03 FLOW										
	Project Title	MILLER PARK ONE BREWERS WAY MILWAUKEE, WI 53214				JOHNSON CONTROLS Systems & Services Division		Wisconsin Area Office 529 N. Jackson Street Milwaukee WI 53202 Phone: 414-524-7500 Fax: 414-524-7575		CONTRACT NUMBER <b>9 8075-0508</b> DRAWING NUMBER <b>35.2A</b>	



**BILL OF MATERIALS**

Designation	Qty	Part Number	Description
Field Devices:			
TS-1	1	T25A-1C	STAT,RM,2CKT,HT/CL,ADJ
ZN-T	1	TE-5314P-1	SENS,T-Ni,0.1%,RM
TS-2	1	T26S-18C	STAT,RM,H/C,ADJ,40/90F


**DETAIL E**  
TYPICAL OF 7

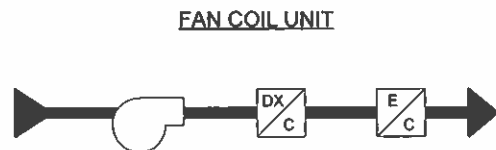


**ROOM TEMPERATURE**




**TS-1 WIRING**

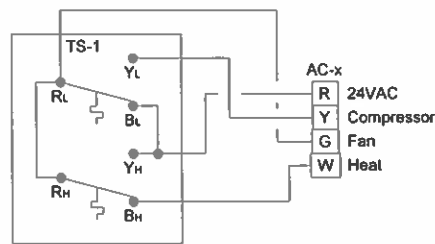

**TS-2 WIRING**

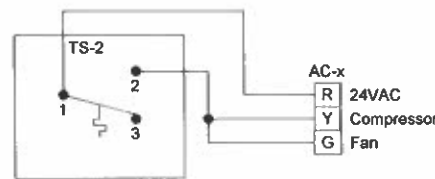

**ACCU-x WIRING**

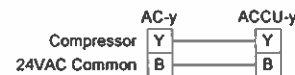

NOTE: SEE MANUFACTURER'S WIRING DIAGRAM FOR COMPLETE WIRING DETAILS.

NOTE: AC-S14 IS COOLING ONLY

**Direct Expansion Fan Coil Units and Condensing Units**



- For each room being conditioned by one fan coil unit, provide a 24 volt single stage room thermostat which will energize the fan coil unit to maintain setpoint. Provide interlock wiring to energize the condensing unit on a call for cooling.
- For each room being conditioned by one fan coil unit with built-in electric heating coil, provide a 24 volt single stage heating/cooling room thermostat with automatic change over which will energize the fan coil unit to maintain setpoint. On a call for heat, the electric heating coil will be energized. Provide interlock wiring to energize the condensing unit on a call for cooling.
- Monitor the space temperature, for each room served, through the EMCS.

Rev.	MECHANICAL SYSTEM	LOCATION	SYSTEM	OBJECT	PAGE#
2	AC-S14	S-9	AC-TEMP	ACS14-T	NC-11 PS-36
2	AC-TC01	TC-1	AC-TEMP	ACTC01-T	NC-13 PS-10
2	AC-TB01	TB-1	AC-TEMP	ACTB01-T	NC-13 PS-13
2	AC-TB02	TB-1	AC-TEMP	ACTB02-T	NC-13 PS-13
2	AC-TB03	TB-4	AC-TEMP	ACTB03-T	NC-12 PS-34
2	AC-TB04	TB-5	AC-TEMP	ACTB04-T	NC-12 PS-11
2	AC-TB05	TB-8	AC-TEMP	ACTB05-T	NC-12 PS-10


**BILL OF MATERIALS**

Designation	Qty	Part Number	Description
Field Devices:			
TS-1	1	T25A-1C	STAT,RM,2CKT,HT/CL,ADJ
Panel Devices:			
P-1	1	EN-EWC10-0	SINGLE UNIT
R-x	3	PD-101-35	RLY BASE,3PDT,11PIN,10A
	3	PD-109-51	RELAY PLUG-IN 3PDT 24VAC


**DETAIL F**  
TYPICAL OF 2

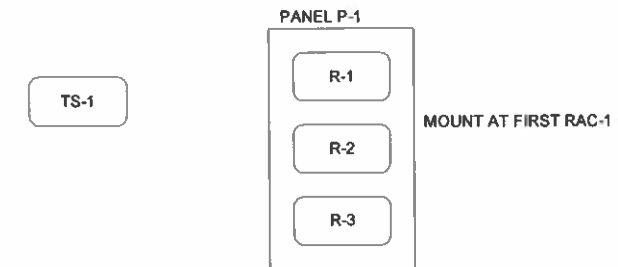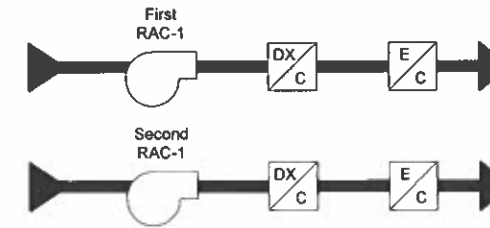

**FIRST RAC-1 WIRING**

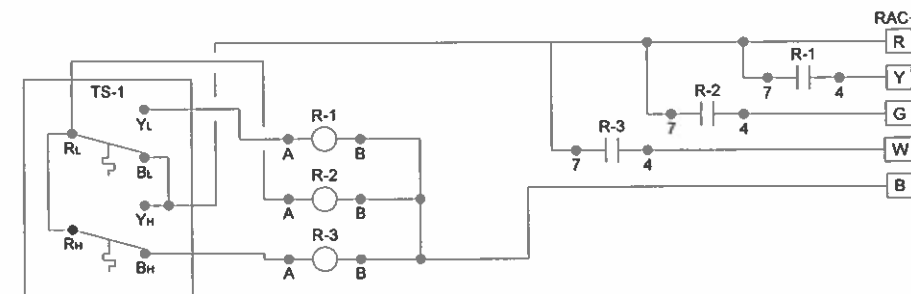

**SECOND RAC-1 WIRING**

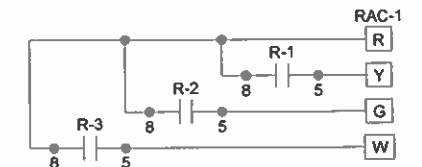

**Room Air Conditioners**

- For each room served by room air conditioners, provide and wire a 24 volt wall mounted heating/cooling thermostat to control the heating and cooling functions of multiple room air conditioners.

REVISION INFORMATION	Drawing Title	REFERENCE DRAWING		REVISION LOCATION		EIN	DATE	BY
NUMBER	<b>ROOM SCHEDULE DETAILS</b>							
DATE		Sales Engineer	Project Manager	Application Engineer	BY	MLR	DATE	APPROVED
TIME		PJS	TP	KJK				
FILE NAME	Project Title	Branch Information		CONTRACT NUMBER		DRAWING NUMBER		
rsddef.vsd	<b>MILLER PARK ONE BREWERS WAY MILWAUKEE, WI 53214</b>	<b>JOHNSON CONTROLS</b> Systems & Services Division Wisconsin Area Office 529 N. Jackson Street Milwaukee WI 53202 Phone: 414-524-7500 Fax: 414-524-7575		<b>9 8075-0508</b>		<b>35.3</b>		

**DETAIL G**  
TYPICAL OF 64

VAV Power Panel P-VAVx Termination Schedule						
Rev	Panel	Transformer	Floor Served	24 VAC Terminals	Serves VAV	
					NC- N2 Addresses	VAV-x
2	P-VAV1	TX-1	SL2,3	1,2	NC-11 106-111	S01 - S06
2		TX-2	SL1,2	3,4	NC-11 112-117	S07 - S12
2		TX-3	SL1	5,6	NC-11 118-123	S13 - S18
2	P-VAV2	TX-1	FL8	1,2	NC-12 1-4, 50	A201 - A204
2		TX-2	FL8	3,4	NC-12 41-43	A205 - A207
2	P-VAV3	TX-1	LL8	1,2	NC-12 5-10	A300 - A305
2		TX-2	LL8	3,4	NC-12 11-16	A306 - A311
2		TX-3	LL8	5,6	NC-12 17-18, 44-45	A312 - A315
2	P-VAV4	TX-1	CL8	1,2	NC-12 19-24	A400 - A405
2		TX-2	CL8	3,4	NC-12 25-30	A406 - A411
2		TX-3	CL8	5,6	NC-12 31-36	A412 - A417
2		TX-4	CL8	7,8	NC-12 37-38, 46-47, 49	A418 - A422

**BILL OF MATERIALS**

Designation	Qty	Part Number	Description
Field Devices:			
BXHTG-X,RAD-X	0	VALVE	SEE ROOM SCHEDULE
VMA-X	1	AP-VMA1420-0	VAV MODULAR ASSY - CLG W/ REHEAT
ZN-T	1	TE-6314P-1	SENS,T-NI,0.1%RM

**BILL OF MATERIALS P-VAV1**

Designation	Qty	Part Number	Description
Panel Devices:			
DR-1	1	PD-117-2	RECEPTACLE,DUPLX,UL,WHT
	1	PD-121-1	RECEPTACLE,DUPLX,CVR
	1	PD-121-6	HANDY BOX 2 IN
KS-1	1	PD-112-12	KNIFE SWITCH BLOCK
P-VAV1	1	M-8100-1824	PANEL,STANDARD,7 UNITS
TAG-1	1	M-8000-393	NAMEPLT,LAMICOID,3 LINE
TX-x	3	PD-114-2	TRANSFORMER 100VA, 120/24

**BILL OF MATERIALS P-VAV2**


Designation	Qty	Part Number	Description
Panel Devices:			
DR-1	1	PD-117-2	RECEPTACLE,DUPLX,UL,WHT
	1	PD-121-1	RECEPTACLE,DUPLX,CVR
	1	PD-121-6	HANDY BOX 2 IN
KS-1	1	PD-112-12	KNIFE SWITCH BLOCK
P-VAV2	1	M-8100-1824	PANEL,STANDARD,7 UNITS
TAG-1	1	M-8000-393	NAMEPLT,LAMICOID,3 LINE
TX-x	2	PD-114-2	TRANSFORMER 100VA, 120/24

**BILL OF MATERIALS P-VAV3**

Designation	Qty	Part Number	Description
Panel Devices:			
DR-1	1	PD-117-2	RECEPTACLE,DUPLX,UL,WHT
	1	PD-121-1	RECEPTACLE,DUPLX,CVR
	1	PD-121-6	HANDY BOX 2 IN
KS-1	1	PD-112-12	KNIFE SWITCH BLOCK
P-VAV3	1	M-8100-1824	PANEL,STANDARD,7 UNITS
TAG-1	1	M-8000-393	NAMEPLT,LAMICOID,3 LINE
TX-x	3	PD-114-2	TRANSFORMER 100VA, 120/24

**BILL OF MATERIALS P-VAV4**



Designation	Qty	Part Number	Description
Panel Devices:			
DR-1	1	PD-117-2	RECEPTACLE,DUPLX,UL,WHT
	1	PD-121-1	RECEPTACLE,DUPLX,CVR
	1	PD-121-6	HANDY BOX 2 IN
KS-1	1	PD-112-12	KNIFE SWITCH BLOCK
P-VAV4	1	M-8100-1824	PANEL,STANDARD,7 UNITS
TAG-1	1	M-8000-393	NAMEPLT,LAMICOID,3 LINE
TX-x	4	PD-114-2	TRANSFORMER 100VA, 120/24

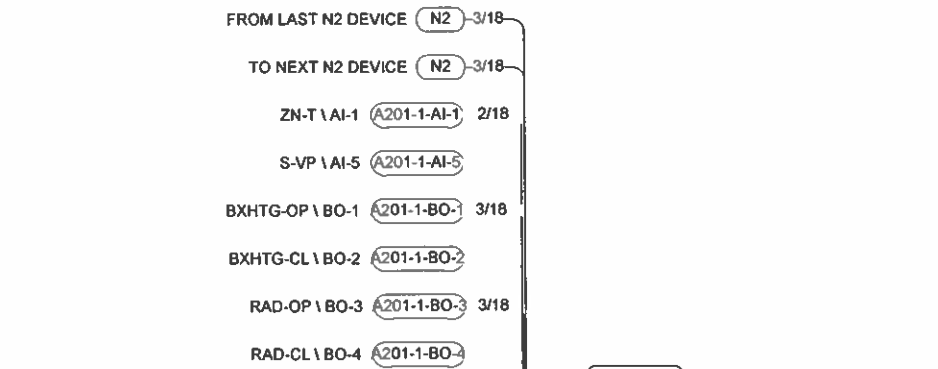

NOTE: SEE POINT SCHEDULE FOR MULTIPLEXED POINTS NOT SHOWN.


POWER OBTAINED FROM CENTRAL TRANSFORMER PANEL. MAXIMUM (6) VMA CONTROLLERS PER 100 VA TRANSFORMER.

NOTE: SEE ROOM SCHEDULE FOR QUANTITY.

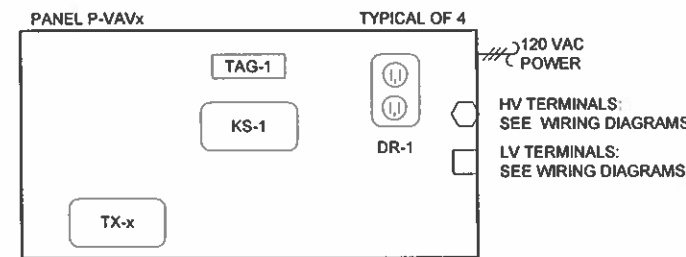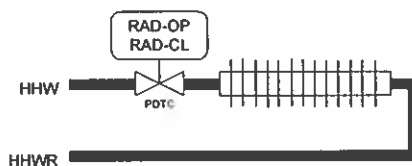

PANEL FACE TAGS:	PANEL FACE TAGS:
TAG-1: PANEL P-VAV1	TAG-1: PANEL P-VAV2
VAV POWER JCI 9 8075-0508	VAV POWER JCI 9 8075-0508
TAG-1: PANEL P-VAV3	TAG-1: PANEL P-VAV4
VAV POWER JCI 9 8075-0508	VAV POWER JCI 9 8075-0508

**PANEL P-VAVx LADDER WIRING DIAGRAM**

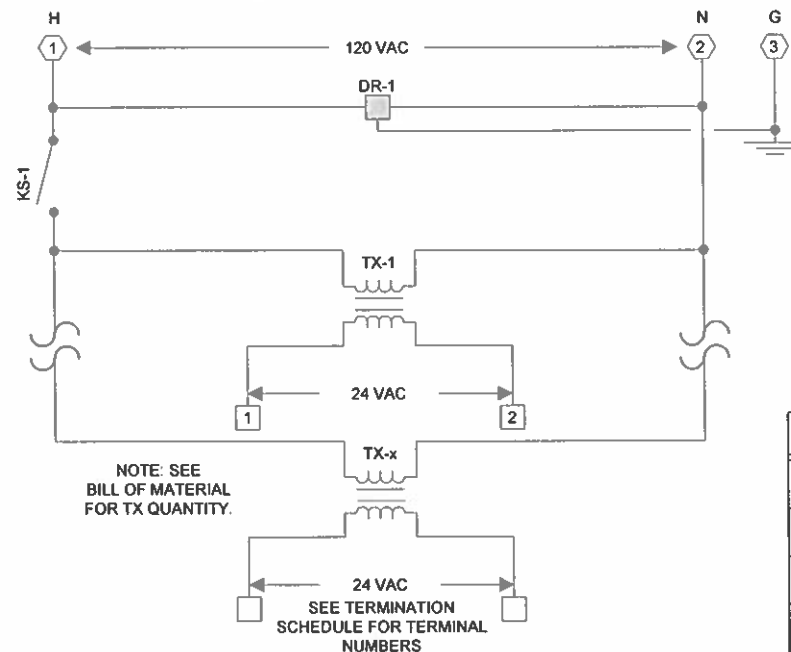

NOTE: SEE BILL OF MATERIAL FOR TX QUANTITY.

**VAV Boxes With REHEAT**

- I. Box manufacturer will ship box to Temperature Control Supplier. Furnish and install direct digital controller (including the damper actuator) on box and turn box over to Heating Contractor for installation.
- II. Control Valve: Two-way modulating, normally open.
- III. Rise in space temperature above setpoint:
  - A. Box Actuator: Modulate to maximum open position.
  - B. Reheat Coil Valve: Fully closed.
- IV. Drop in space temperature below setpoint:
  - A. First Step:
    1. Box Actuator: Modulate to minimum open position.
    2. Reheat Coil Valve: Fully closed.
  - B. Second Step: Modulate reheat coil valve to fully open while the box damper remains at minimum position
  - C. Third Step: Modulate the box damper toward maximum position while the reheat coil valve remains fully open.



REVISION INFORMATION	Drawing Title	REVISION INFORMATION			
NUMBER	ROOM SCHEDULE DETAILS	NO	REVISION-LOCATION	DATE	BY
DATE		1	RECORD DRAWINGS	6/14/2001	MLR
DATE	Project Title	REFERENCE DRAWING			
06/15/01		MILLER PARK ONE BREWERS WAY MILWAUKEE, WI 53214	NO	DATE	BY
TIME	MILLER PARK ONE BREWERS WAY MILWAUKEE, WI 53214	Sales Engineer	Project Manager	Application Engineer	DATE
08:58 AM		PJS	TP	KJK	DATE
FILE NAME	JOHNSON CONTROLS Systems & Services Division	Branch Information			
radetg.vsd		Wisconsin Area Office 529 N. Jackson Street Milwaukee WI 53202 Phone: 414-524-7500 Fax: 414-524-7575			
		CONTRACT NUMBER			
		9 8075-0508			
		DRAWING NUMBER			
		35.4			

**DETAIL H**  
TYPICAL OF 88


- FROM LAST N2 DEVICE (N2) 3/18
- TO NEXT N2 DEVICE (N2) 3/18
- ZN-T 1 AI-1 (Y-1-AI-1) 2/18
- RH-OP 1 BO-5 (Y-1-BO-5) 3/18
- RH-CL 1 BO-6 (Y-1-BO-6)

NOTE: SEE POINT SCHEDULE FOR MULTIPLEXED POINTS NOT SHOWN.


TYPICAL OF 4 PER EACH UNIT CONTROLLER

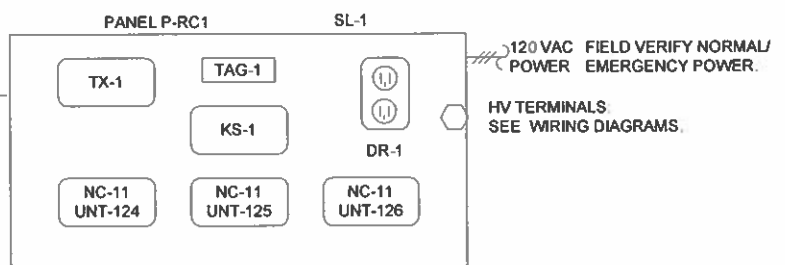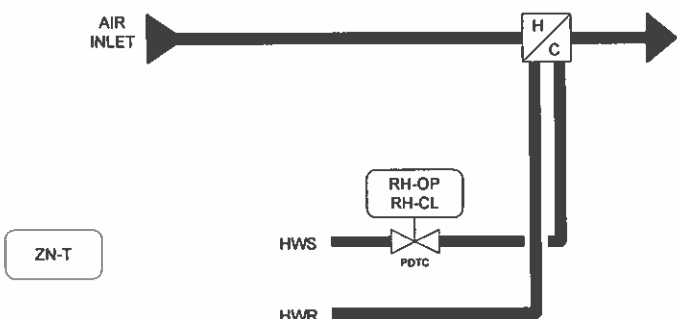

PANEL FACE TAGS:  
TAG-1: PANEL P-RC1  
REHEAT COILS  
JCI 9 8075-0508

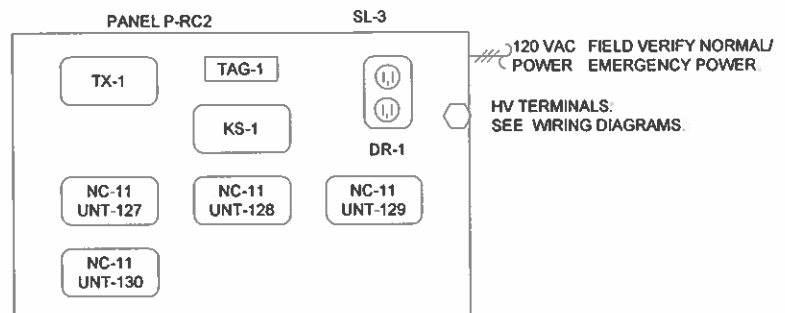

PANEL FACE TAGS:  
TAG-1: PANEL P-RC2  
REHEAT COILS  
JCI 9 8075-0508

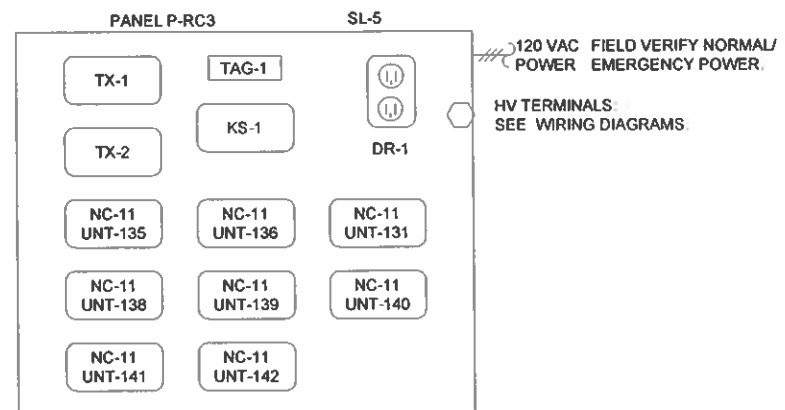

PANEL FACE TAGS:  
TAG-1: PANEL P-RC3  
REHEAT COILS  
JCI 9 8075-0508

**BILL OF MATERIALS**

Designation	Qty	Part Number	Description
Field Devices:			
RH-X	0	VALVE	SEE ROOM SCHEDULE
ZN-T	1	TE-6314P-1	SENS.T-NI,0.1%,RM

**BILL OF MATERIALS**

Designation	Qty	Part Number	Description
Panel Devices:			
DR-1	1	PD-117-2	RECEPTACLE,DUPLEX,UL,WHT
	1	PD-121-1	RECEPTACLE,DUPLEX,CVR
	1	PD-121-6	HANDY BOX 2 IN
KS-1	1	PD-112-12	KNIFE SWITCH BLOCK
P-RC1	1	M-8100-2436	PANEL,STANDARD,15 UNITS
TAG-1	1	M-8000-393	NAMEPLT,LAMICOID,3 LINE
TX-1	1	PD-114-2	TRANSFORMER 100VA, 120/24
UNT-x	3	AS-UNT140-1	CNTRLR,DIG,UNT,6AI,4BI,8BO,SCREW

**BILL OF MATERIALS**

Designation	Qty	Part Number	Description
Panel Devices:			
DR-1	1	PD-117-2	RECEPTACLE,DUPLEX,UL,WHT
	1	PD-121-1	RECEPTACLE,DUPLEX,CVR
	1	PD-121-6	HANDY BOX 2 IN
KS-1	1	PD-112-12	KNIFE SWITCH BLOCK
P-RC2	1	M-8100-2436	PANEL,STANDARD,15 UNITS
TAG-1	1	M-8000-393	NAMEPLT,LAMICOID,3 LINE
TX-1	1	PD-114-2	TRANSFORMER 100VA, 120/24
UNT-x	4	AS-UNT140-1	CNTRLR,DIG,UNT,6AI,4BI,8BO,SCREW

**BILL OF MATERIALS**

Designation	Qty	Part Number	Description
Panel Devices:			
DR-1	1	PD-117-2	RECEPTACLE,DUPLEX,UL,WHT
	1	PD-121-1	RECEPTACLE,DUPLEX,CVR
	1	PD-121-6	HANDY BOX 2 IN
KS-1	1	PD-112-12	KNIFE SWITCH BLOCK
P-RC3	1	M-8100-2436	PANEL,STANDARD,15 UNITS
TAG-1	1	M-8000-393	NAMEPLT,LAMICOID,3 LINE
TX-x	2	PD-114-2	TRANSFORMER 100VA, 120/24
UNT-x	8	AS-UNT140-1	CNTRLR,DIG,UNT,6AI,4BI,8BO,SCREW





**Reheat Coils**

- I. Control Valve: Two-way modulating, normally open.
- II. Rise in space temperature above setpoint:
  - A. Reheat Coil Valve fully closed.
- III. Drop in space temperature below setpoint:
  - A. Modulate reheat coil valve to fully open.

SEE PAGE 35 6 FOR REMAINING PANELS AND WIRING DIAGRAM

REVISION INFORMATION	Drawing Title						
	NUMBER	ROOM SCHEDULE DETAILS					
DATE	11/06/09	REFERENCE DRAWING	NO.	REVISION-LOCATION	EIN	DATE	BY
TIME	09:22 AM	Sales Engineer	Project Manager	Application Engineer	BY	MLR	DATE
FILE NAME	rsdeth1.vsd	PJS	TP	KJK	BY	MLR	DATE
Project Title		Branch Information		CONTRACT NUMBER			
MILLER PARK ONE BREWERS WAY MILWAUKEE, WI 53214		Wisconsin Area Office 529 N. Jackson Street Milwaukee WI 53202 Phone: 414-524-7500 Fax: 414-524-7575		9 8075-0508		DRAWING NUMBER	
		JOHNSON CONTROLS Systems & Services Division				35.5	

## DETAIL H CONTINUED

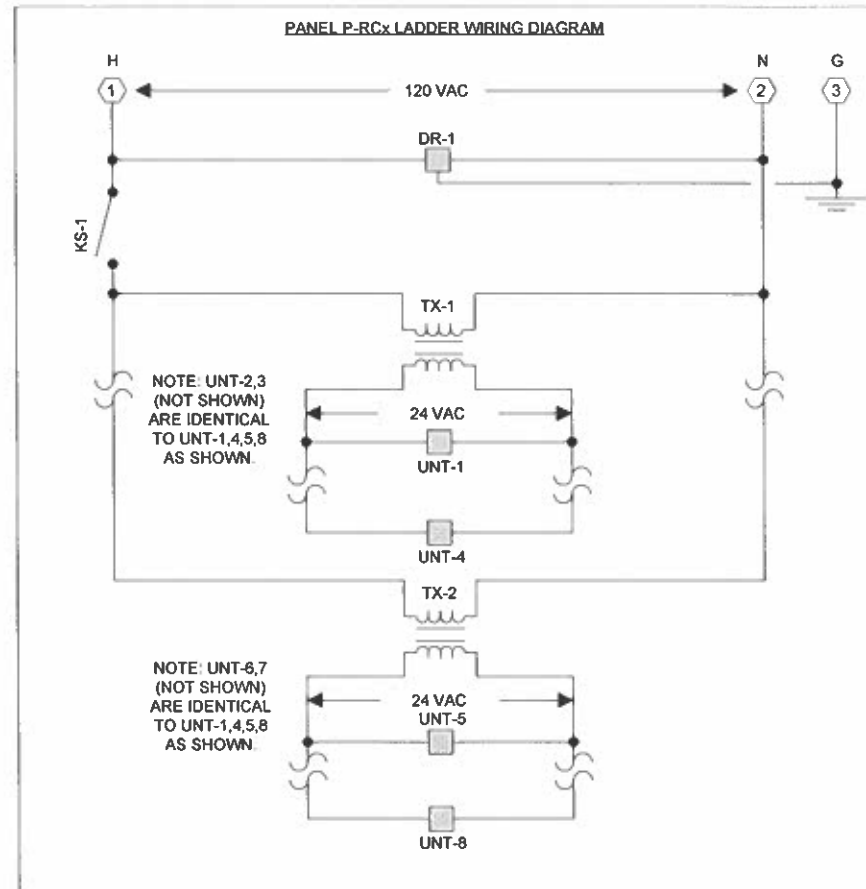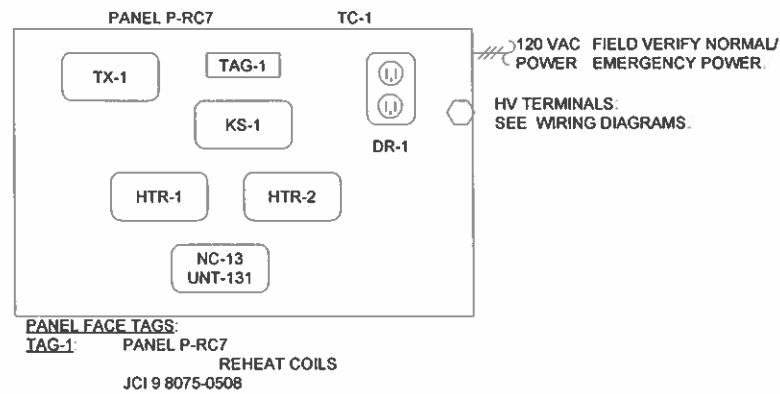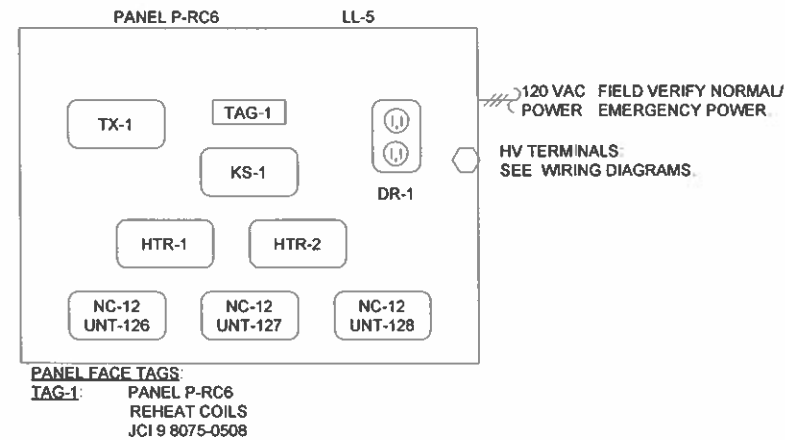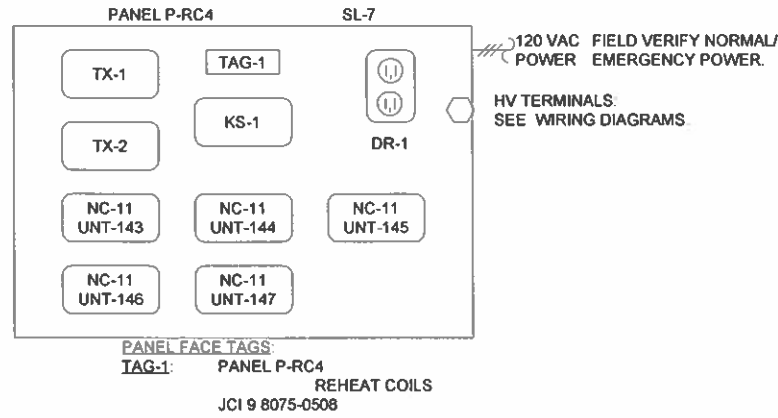

### BILL OF MATERIALS

Designation	Qty	Part Number	Description
Panel Devices:			
DR-1	1	PD-117-2	RECEPTACLE,DUPLEX,UL,WHT
	1	PD-121-1	RECEPTACLE,DUPLEX,CVR
	1	PD-121-6	HANDY BOX 2 IN
KS-1	1	PD-112-12	KNIFE SWITCH BLOCK
P-RC4	1	M-8100-2436	PANEL,STANDARD,15 UNITS
TAG-1	1	M-8000-393	NAMEPLT,LAMICOID,3 LINE
TX-x	2	PD-114-2	TRANSFORMER 100VA, 120/24
UNT-x	5	AS-UNT140-1	CNTRLR,DIG,UNT,6AI,4BI,8BO,SCREW

### BILL OF MATERIALS


Designation	Qty	Part Number	Description
Panel Devices:			
DR-1	1	PD-117-2	RECEPTACLE,DUPLEX,UL,WHT
	1	PD-121-1	RECEPTACLE,DUPLEX,CVR
	1	PD-121-6	HANDY BOX 2 IN
HTR-x	2	EN2-12-P-040-D	PANEL HEATER, 120VAC, ELECTRO-FLEX
KS-1	1	PD-112-12	KNIFE SWITCH BLOCK
P-RC6	1	M-8100-2436	PANEL,STANDARD,15 UNITS
TAG-1	1	M-8000-393	NAMEPLT,LAMICOID,3 LINE
TX-1	1	PD-114-2	TRANSFORMER 100VA, 120/24
UNT-x	3	AS-UNT140-1	CNTRLR,DIG,UNT,6AI,4BI,8BO,SCREW

### BILL OF MATERIALS



Designation	Qty	Part Number	Description
Panel Devices:			
DR-1	1	PD-117-2	RECEPTACLE,DUPLEX,UL,WHT
	1	PD-121-1	RECEPTACLE,DUPLEX,CVR
	1	PD-121-6	HANDY BOX 2 IN
HTR-x	2	EN2-12-P-040-D	PANEL HEATER, 120VAC, ELECTRO-FLEX
KS-1	1	PD-112-12	KNIFE SWITCH BLOCK
P-RC7	1	M-8100-2436	PANEL,STANDARD,15 UNITS
TAG-1	1	M-8000-393	NAMEPLT,LAMICOID,3 LINE
TX-1	1	PD-114-2	TRANSFORMER 100VA, 120/24
UNT-x	1	AS-UNT140-1	CNTRLR,DIG,UNT,6AI,4BI,8BO,SCREW

REVISION INFORMATION	Drawing Title		NO		REVISION LOCATION		ETC	DATE	BY
NUMBER	<b>ROOM SCHEDULE DETAILS</b>								
DATE	11/06/09	Project Manager	Application Engineer	DRAWN		APPROVED			
TIME	09:23 AM	PJS	TP	KJK	MLR	DATE		BY	
FILE NAME	rsdeth2.vsc	Project Title		Branch Information		CONTRACT NUMBER			
		MILLER PARK ONE BREWERS WAY MILWAUKEE, WI 53214		<b>JOHNSON CONTROLS</b> Systems & Services Division		Wisconsin Area Office 529 N. Jackson Street Milwaukee WI 53202 Phone: 414-524-7500 Fax: 414-524-7575		<b>9 8075-0508</b> DRAWING NUMBER <b>35.6</b>	

PANEL P-RC8 LADDER WIRING DIAGRAM

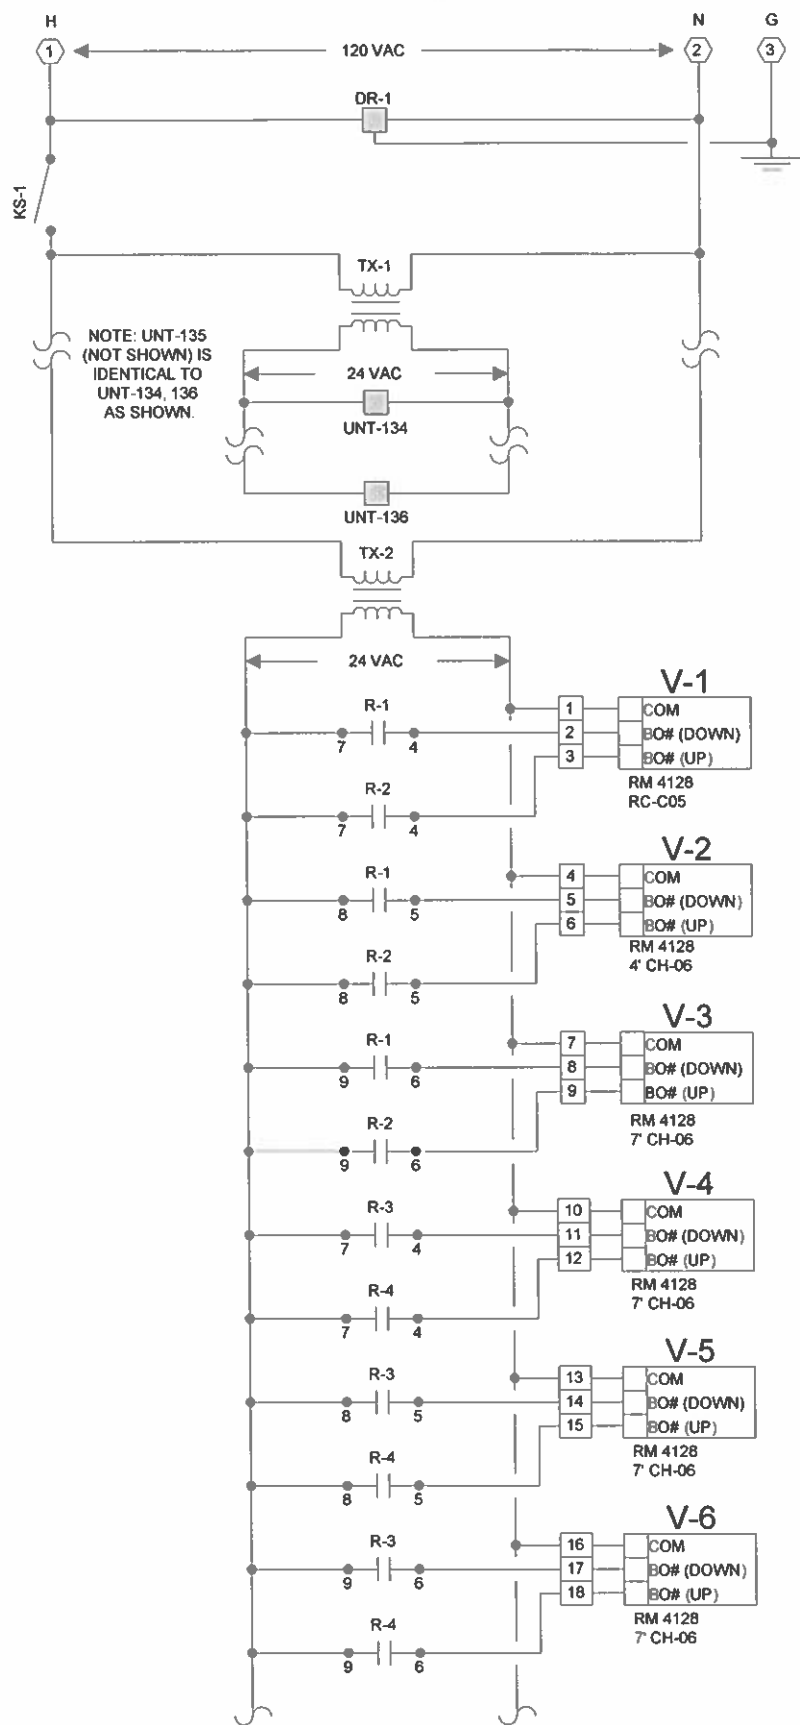

DETAIL I, J  
CONTINUED

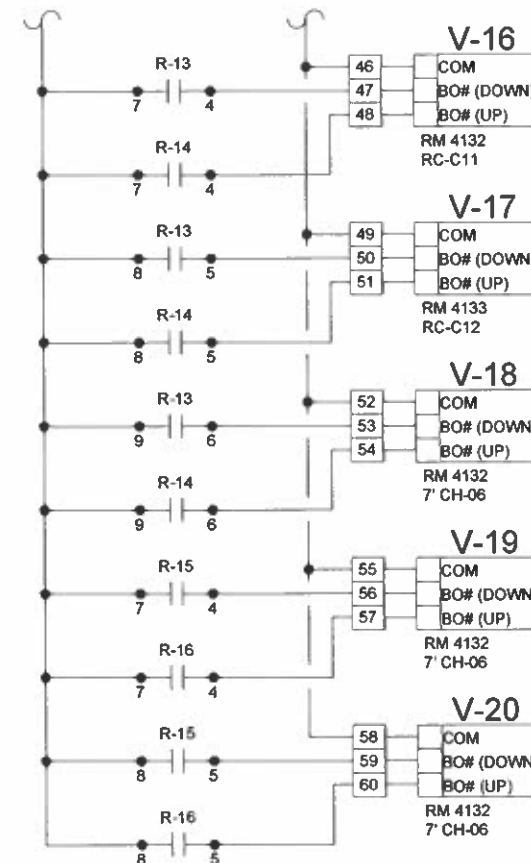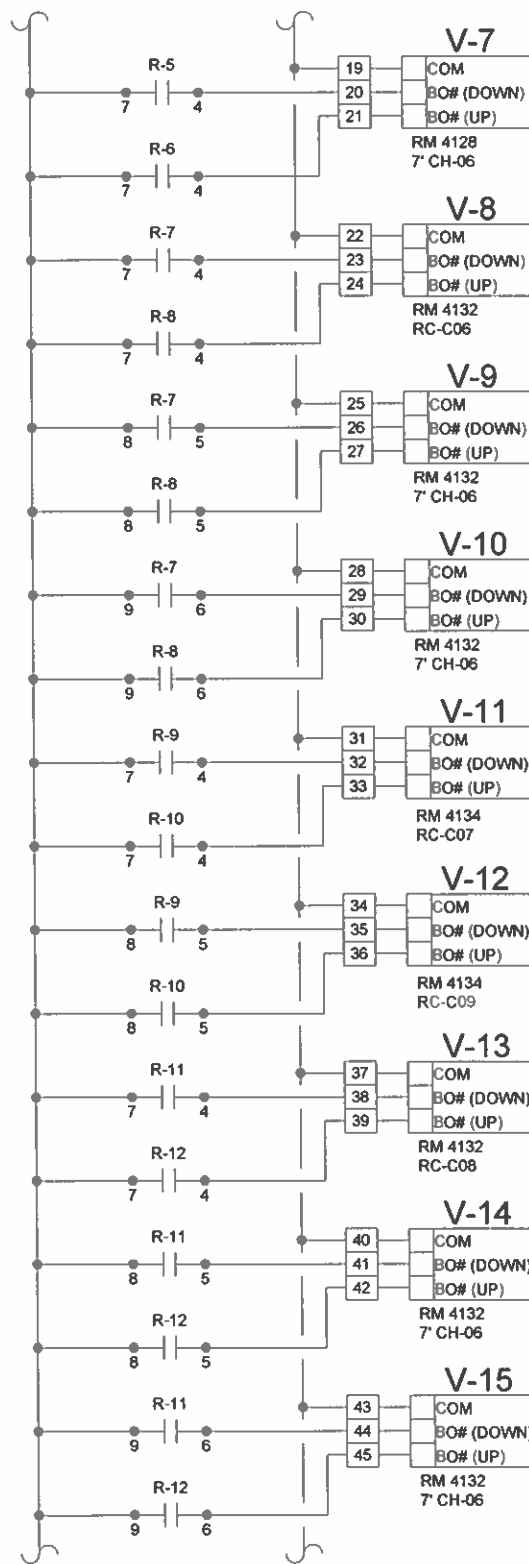


REVISION INFORMATION	Drawing Title										
	NUMBER	ROOM SCHEDULE DETAILS .300 CLUB RESTAURANT									
DATE	04/16/01	REFERENCE DRAWING		NO.	REVISION-LOCATION		ECH	DATE	BY		
TIME	08:58 AM	Sales Engineer	Project Manager	Application Engineer	DRAWN		APPROVED		CONTRACT NUMBER		
FILE NAME	rsdelij2.vsc	PJS	TP	KJK	BY	MLR	DATE	BY	DATE	9 8075-0508	
		Project Title			Branch Information			DRAWING NUMBER			
		MILLER PARK ONE BREWERS WAY MILWAUKEE, WI 53214			<b>JOHNSON CONTROLS</b> Systems & Services Division			Wisconsin Area Office 529 N. Jackson Street Milwaukee WI 53202 Phone: 414-524-7500 Fax: 414-524-7575			
								35.8			

**DETAIL I, J**  
CONTINUED

FROM LAST N2 DEVICE (N2) 3/18 BLU  
 TO NEXT N2 DEVICE (N2) 3/18 BLU  
 ZN-T \ AI-1 (RC3-135-AI-1) 2/18 YEL  
 RH-OP \ BO-1 (RC3-135-BO-1) 3/18 VIO  
 RH-CL \ BO-2 (RC-3-135-BO-2)

TYPICAL OF 4 PER UNT-135, 136,  
AND 3 PER UNT-137

NOTE: SEE POINT SCHEDULE FOR  
MULTIPLXED POINTS NOT SHOWN.

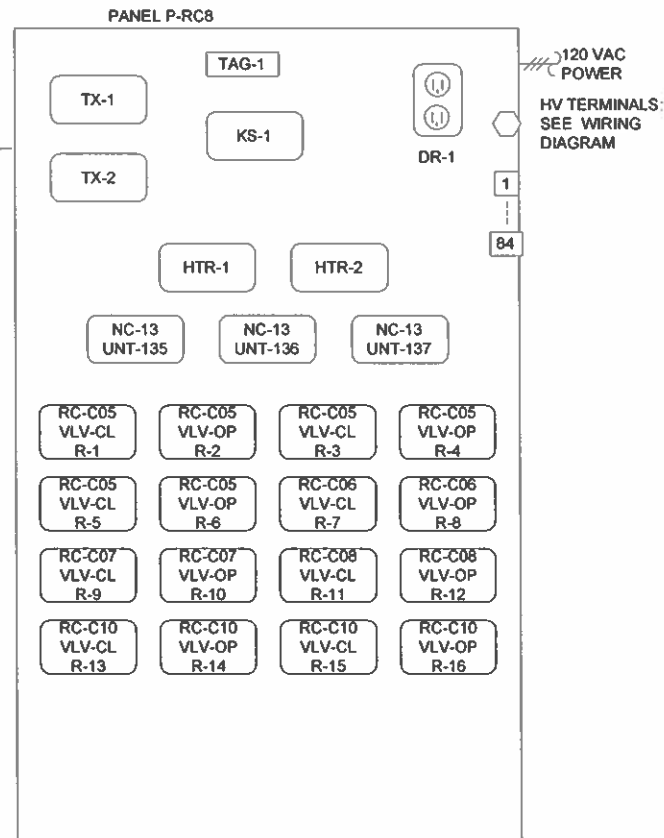

PANEL FACE TAGS:  
 TAG-1: PANEL P-RC8  
 REHEAT COILS  
 JC19 8075-0508

**BILL OF MATERIALS**

Designation	Qty	Part Number	Description
Panel Devices:			
DR-1	1	PD-117-2	RECEPTACLE, DUPLEX, UL WHT
	1	PD-121-1	RECEPTACLE, DUPLEX, CVR
	1	PD-121-6	HANDY BOX 2 IN
HTR-x	2	EN2-12-P-040-D	PANEL HEATER, 120VAC, ELECTRO-FLEX
KS-1	1	PD-112-12	KNIFE SWITCH BLOCK
P-RC8	1	M-8100-3042	PANEL, STANDARD 22 UNITS
RC-Cx VLVx-OP, RC-Cx VLVx-CL	16	PD-101-35	RLY BASE, 3PDT, 11PIN, 10A, IDEC #SR3B-05
	16	PD-109-51	RLY, PLUG-IN, 3PDT, 24VAC, P&B KUP14A25-24
TAG-1	1	M-8000-393	NAMEPLT, LAMICOID, 3 LINE
TX-x	2	PD-114-2	TRANSFORMER 100VA, 120/24
UNT-x	3	AS-UNT140-1	CNTRLR, DIG, UNT, 6AI, 4BI, 8BO, SCREW

REVISION INFORMATION	Drawing Title				
	ROOM SCHEDULE DETAILS .300 CLUB RESTAURANT				
NUMBER					
DATE	04/16/01	REFERENCE DRAWING	NO	REVISION LOCATION	ECN
TIME	09:03 AM	Sales Engineer	Project Manager	Application Engineer	DATE
FILE NAME	redetlj3.vsc	PJS	TP	KJK	BY MLR DATE
	Project Title	MILLER PARK ONE BREWERS WAY MILWAUKEE, WI 53214			APPROVED
					CONTRACT NUMBER
		Wisconsin Area Office 529 N. Jackson Street Milwaukee WI 53202 Phone: 414-524-7500 Fax: 414-524-7575			9 8075-0508
		Systems & Services Division			DRAWING NUMBER
					35.9


**DETAIL A**  
TYPICAL OF 14

SEE AH-F01-6, AHT01.2, AH-TB01-6

Frost Protection

1. Not used per Brewers Operations / HKS.

**DETAIL B**  
TYPICAL OF 15

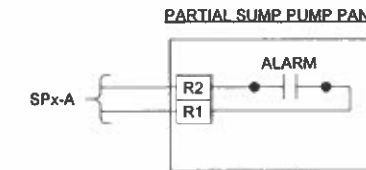

NOTE: SEE MANUFACTURER'S WIRING DIAGRAM FOR COMPLETE WIRING DETAILS

Rev.	MECHANICAL SYSTEM	LOCATION	SYSTEM	OBJECT	PAGE #
2	SP-1	SL0	SP-ALM	SP1-A	NC-11 PS-5
2	SP-2	SL1	SP-ALM	SP2-A	NC-11 PS-5
2	SP-3	SL1	SP-ALM	SP3-A	NC-11 PS-24
2	SP-4	SL1	SP-ALM	SP4-A	NC-11 PS-24
2	SP-5	SL2	SP-ALM	SP5-A	NC-11 PS-8
2	SP-6	SL3	SP-ALM	SP6-A	NC-11 PS-25
2	SP-7	SL3	SP-ALM	SP7-A	NC-11 PS-25
2	SP-8	SL4	SP-ALM	SP8-A	NC-11 PS-1
2	SP-9	SL5	SP-ALM	SP9-A	NC-11 PS-17
2	SP-10	SL6	SP-ALM	SP10-A	NC-11 PS-16
2	SP-11	SL6	SP-ALM	SP11-A	NC-11 PS-16
2	SP-12	SL6	SP-ALM	SP12-A	NC-11 PS-3
2	SP-13	SL8	SP-ALM	SP13-A	NC-11 PS-33
2	SP-14	SL8	SP-ALM	SP14-A	NC-11 PS-20
2	SP-15	SL9	SP-ALM	SP15-A	NC-11 PS-14

Plumbing Equipment: The EMCS will monitor the following items of plumbing equipment:


1. Sump Pumps (15 General panel alarms)

REVISION INFORMATION	Drawing Title								
NUMBER	MISCELLANEOUS DETAILS		1	RECORD DRAWINGS		6/14/2001	MLR		
DATE		REFERENCE DRAWING	NO	REVISION/LOCATION	ECN	DATE	BY		
06/15/01		Sales Engineer	PJS	Project Manager	TP	Application Engineer	KJK	DATE	APPROVED
TIME	Project Title			BY	MLR	DATE			
07:55 AM	MILLER PARK ONE BREWERS WAY MILWAUKEE, WI 53214								
FILE NAME		Branch Information		CONTRACT NUMBER		DRAWING NUMBER			
msdetab.vsd		JOHNSON CONTROLS Systems & Services Division		Wisconsin Area Office 529 N Jackson Street Milwaukee WI 53202 Phone: 414-524-7500 Fax: 414-524-7575		9 8075-0508		36.1	

**DETAIL C**  
TYPICAL OF 1

**BILL OF MATERIALS**

Designation	Qty	Part Number	Description
<b>Field Devices:</b>			
D-x	0	DAMPER	SEE DAMPER SCHEDULE
<b>Panel Devices:</b>			
DR-1	1	PD-117-2	RECEPTACLE, DUPLEX, UL, WHT
	1	PD-121-1	RECEPTACLE, DUPLEX, CVR
	1	PD-121-6	HANDY BOX 2 IN
FP-1	1	M-8100-3648	PANEL, STANDARD 31 UNITS
KS-1	1	PD-112-12	KNIFE SWITCH BLOCK
L-TST	1	PD-105-2	MOM PSH BUTTN, 1NO/1NC, RED
LMP-x	58	PD-102-2	LAMP, 28V, 5KHRS, 28PSB
	58	PD-103-33	LENS, RED, F7-55 SOCKET
	58	PD-103-55	P/L BODY ONLY, UL, 13/16"
SW-x	1	PD-106-2	TOGL SW, 3 POS, SPDT
TX-1,2	2	PD-114-2	TRANSFORMER, 100VA, 120/24
XPB-x	4	XPB-821-5	N2 EXPN MOD, 8BI
XPT-x	8	XPT-861-5	N2 EXPN MOD, 8BO, TRIAC
XTM-x	6	XTM-105-5	N2 EXT'N MOD, COMM IF

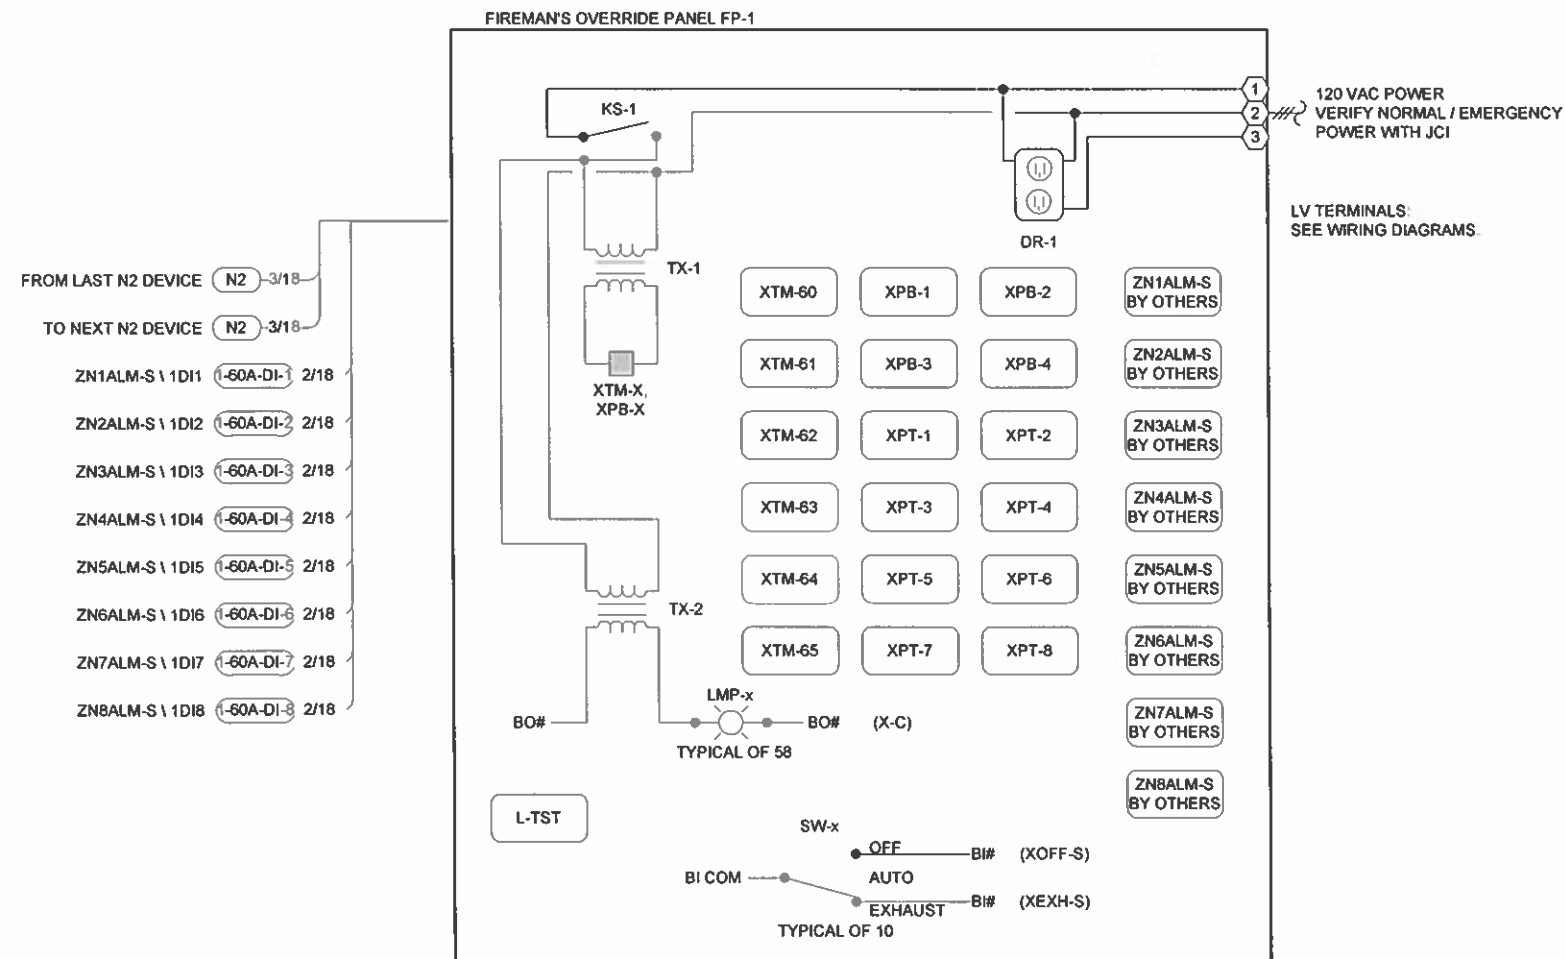

NOTE: AUTO = NORMAL OPERATION OF FANS.  
OFF / EXHAUST ARE TO BE USED BY FIRE DEPARTMENT ONLY.


**Smoke Exhaust System**

- The building is provided with eight (8) distinct smoke exhaust systems, which are provided in the following areas:
  - System A Field and Loge Concourse Left Field
  - System B Field and Loge Concourse Left Center Field
  - System C Field and Loge Concourse Right Center Field
  - System D Field and Loge Concourse Right Field
  - System E Terrace Concourse Left Field
  - System F Terrace Concourse Left Center Field
  - System G Terrace Concourse Right Center Field
  - System H Terrace Concourse Right Field
- Provide a fireman's override panel. Upon the actuation of the automatic sprinkler system and/or smoke detection by the fire alarm system, the smoke control systems will operate automatically. Others will mount the eight fire alarm control modules next to the temperature controls fireman's control panel.
- The motorized exhaust damper on the indirect gas fired air handling units supply fan discharge will open and the supply (combination fire/smoke damper) and outside air dampers will fully close. The return air damper will fully open. Provide required end switches and safety devices to protect the ductwork from over pressurizing.
- The fan will then be energized. All other equipment not connected with the smoke system or fire protection systems that are connected to the EMCS, which will include but not be limited to, the air handling unit supply and return fans, exhaust fans, chillers, pumps and boilers will simultaneously be de-energized via the regular EMCS start/stop relay. Associated smoke/fire dampers serving all other air handling units will automatically close. Smoke exhaust fans will be capable of being manually overridden at the fireman's control panel. Provide an "OFF-AUTO-EXHAUST" switch for each zone. Show supply fan status and individual damper status's (OA, EA, RA, SA, smoke zone damper end switches) for each damper associated with the indirect gas fired air handlers on the panel also with an indicating lamp. Monitor the override switches on the EMCS. Provide relays off the EMCS that will override the HAND position in the OFF mode and a relay to override the safety circuits in the EXHAUST mode for the bowl air handling units (See the Indirect Gas Fired Air Handling Systems sequence of operation).

REVISION INFORMATION	Drawing Title	REFERENCE DRAWING				REVISION LOCATION		ECN	DATE	BY
NUMBER	MISCELLANEOUS DETAILS									
DATE		Sales Engineer	Project Manager	Application Engineer	DRAWN		APPROVED			
04/16/01		PJS	TP	KJK	BY	MLR	DATE	BY	DATE	
TIME	Project Title	Branch Information				CONTRACT NUMBER				
09:24 AM	MILLER PARK ONE BREWERS WAY MILWAUKEE, WI 53214	JOHNSON CONTROLS Systems & Services Division				Wisconsin Area Office 529 N. Jackson Street Milwaukee WI 53202 Phone: 414-524-7500 Fax: 414-524-7575		9 8075-0508		
FILE NAME	msdetc1.vsd					DRAWING NUMBER		36.2		



FP-1 PANEL FACE

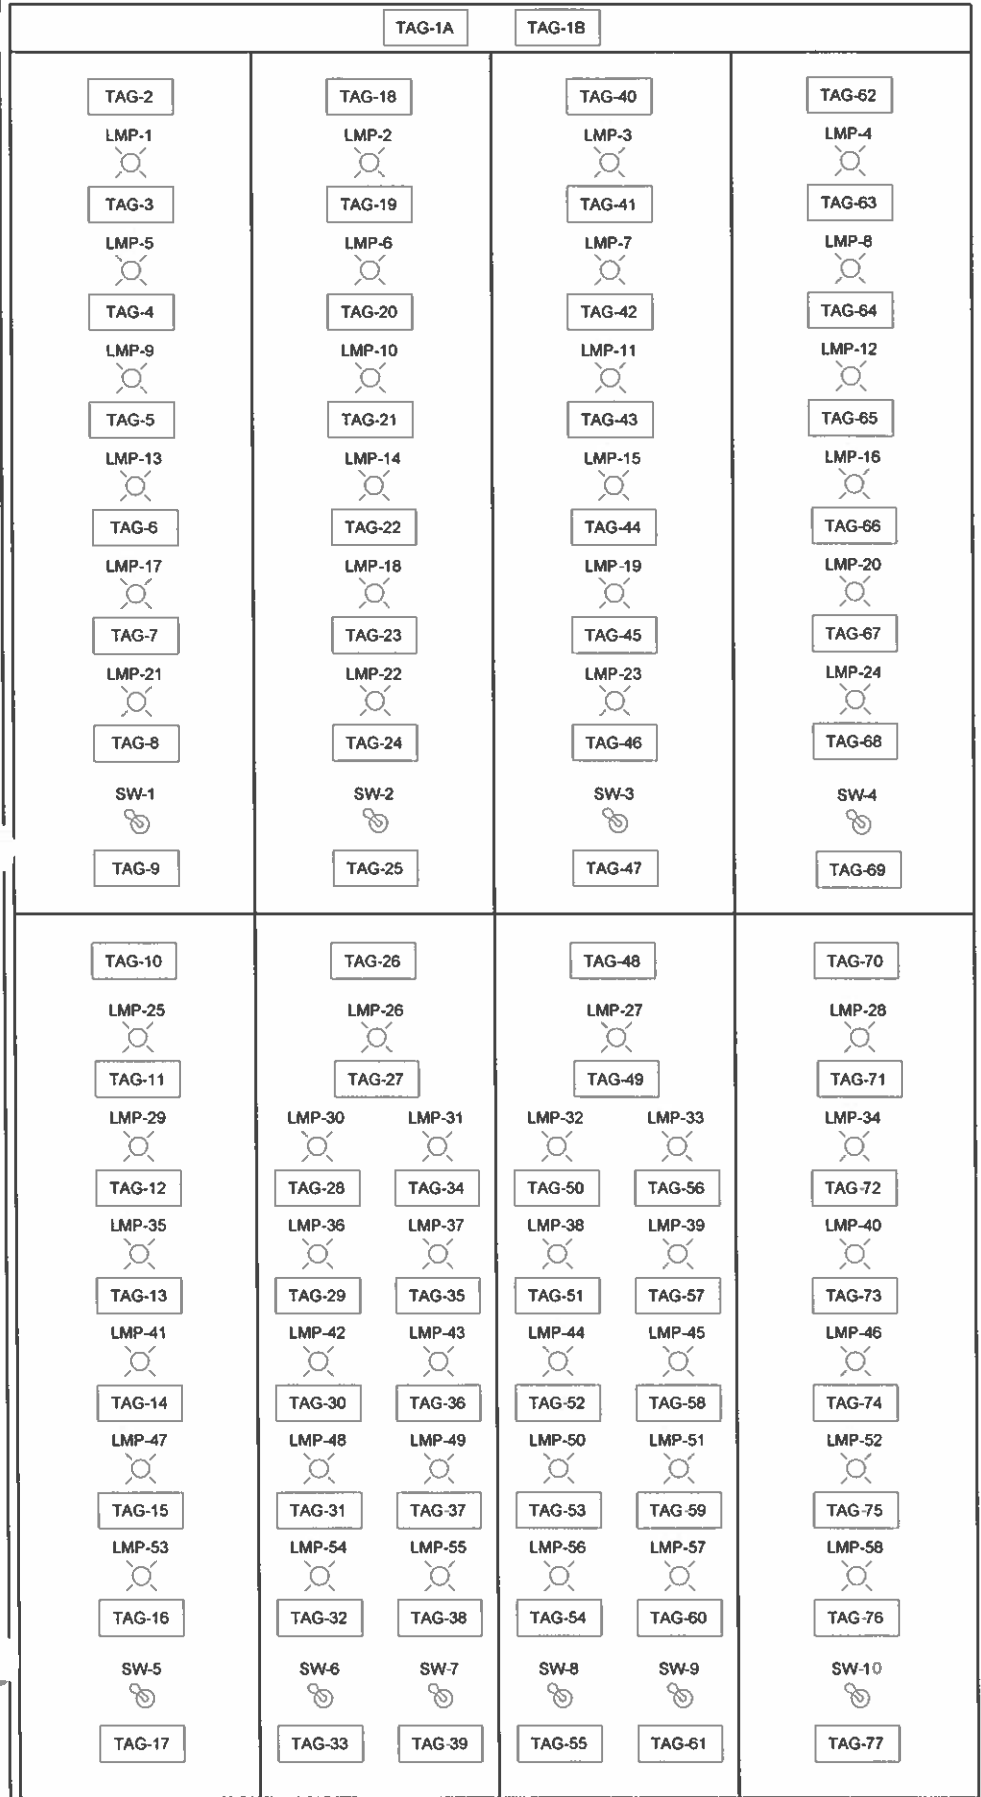

POTEAU NOTES:  
 - SECTION OFF PANEL FACE AS SHOWN  
 - USE REDUCED SIZE TAGS AS REQUIRED

**DETAIL C  
 CONTINUED**

PANEL FACE TAGS:  
 TAG-1A: PANEL FP-1  
 FIREMAN OVERRIDE  
 JCI 9 8075-0508

TAG-1B: LIGHT ON IS DAMPER POSITION  
 SHOWN DURING AUTO-SMOKE /  
 EXHAUST MODES


TAG-2: TERRACE CONCOURSE LEVEL LEFT FIELD AH-TB04	TAG-18: TERRACE CONCOURSE LEVEL LEFT CENTER FIELD AH-TB03	TAG-40: TERRACE CONCOURSE LEVEL RIGHT CENTER FIELD AH-TB02	TAG-62: TERRACE CONCOURSE LEVEL RIGHT FIELD AH-TB01
TAG-3: ZONE ALARM STATUS	TAG-19: ZONE ALARM STATUS	TAG-41: ZONE ALARM STATUS	TAG-63: ZONE ALARM STATUS
TAG-4: SUPPLY FAN STATUS	TAG-20: SUPPLY FAN STATUS	TAG-42: SUPPLY FAN STATUS	TAG-64: SUPPLY FAN STATUS
TAG-5: OUTDOOR DAMPER CLOSED	TAG-21: OUTDOOR DAMPER CLOSED	TAG-43: OUTDOOR DAMPER CLOSED	TAG-65: OUTDOOR DAMPER CLOSED
TAG-6: SUPPLY DAMPER CLOSED	TAG-22: SUPPLY DAMPER CLOSED	TAG-44: SUPPLY DAMPER CLOSED	TAG-66: SUPPLY DAMPER CLOSED
TAG-7: RETURN DAMPER OPEN	TAG-23: RETURN DAMPER OPEN	TAG-45: RETURN DAMPER OPEN	TAG-67: RETURN DAMPER OPEN
TAG-8: EXHAUST DAMPER OPEN	TAG-24: EXHAUST DAMPER OPEN	TAG-46: EXHAUST DAMPER OPEN	TAG-68: EXHAUST DAMPER OPEN
TAG-9: OFF-AUTO-EXHAUST	TAG-25: OFF-AUTO-EXHAUST	TAG-47: OFF-AUTO-EXHAUST	TAG-69: OFF-AUTO-EXHAUST
TAG-10: FIELD AND LOGE LEVEL LEFT FIELD AH-F06	TAG-28: FIELD AND LOGE LEVEL LEFT CENTER FIELD AH-F05 AH-F04	TAG-48: FIELD AND LOGE LEVEL RIGHT CENTER FIELD AH-F03 AH-F02	TAG-70: FIELD AND LOGE LEVEL RIGHT FIELD AH-F01
TAG-11: ZONE ALARM STATUS	TAG-27: ZONE ALARM STATUS	TAG-49: ZONE ALARM STATUS	TAG-71: ZONE ALARM STATUS
TAG-12: SUPPLY FAN STATUS	TAG-28: SUPPLY FAN STATUS	TAG-50: SUPPLY FAN STATUS	TAG-72: SUPPLY FAN STATUS
TAG-13: OUTDOOR DAMPER CLOSED	TAG-29: OUTDOOR DAMPER CLOSED	TAG-51: OUTDOOR DAMPER CLOSED	TAG-73: OUTDOOR DAMPER CLOSED
TAG-14: SUPPLY DAMPER CLOSED	TAG-30: SUPPLY DAMPER CLOSED	TAG-52: SUPPLY DAMPER CLOSED	TAG-74: SUPPLY DAMPER CLOSED
TAG-15: RETURN DAMPER OPEN	TAG-31: RETURN DAMPER OPEN	TAG-53: RETURN DAMPER OPEN	TAG-75: RETURN DAMPER OPEN
TAG-16: EXHAUST DAMPER OPEN	TAG-32: EXHAUST DAMPER OPEN	TAG-54: EXHAUST DAMPER OPEN	TAG-76: EXHAUST DAMPER OPEN
TAG-17: OFF-AUTO-EXHAUST	TAG-33: OFF-AUTO-EXHAUST	TAG-55: OFF-AUTO-EXHAUST	TAG-77: OFF-AUTO-EXHAUST
	TAG-34: SUPPLY FAN STATUS	TAG-56: SUPPLY FAN STATUS	
	TAG-35: OUTDOOR DAMPER CLOSED	TAG-57: OUTDOOR DAMPER CLOSED	
	TAG-36: SUPPLY DAMPER CLOSED	TAG-58: SUPPLY DAMPER CLOSED	
	TAG-37: RETURN DAMPER OPEN	TAG-59: RETURN DAMPER OPEN	
	TAG-38: EXHAUST DAMPER OPEN	TAG-60: EXHAUST DAMPER OPEN	
	TAG-39: OFF-AUTO-EXHAUST	TAG-61: OFF-AUTO-EXHAUST	

**BILL OF MATERIALS**

Designation	Qty	Part Number	Description
Panel Devices: TAG-x	68	M-8000-391	NAMEPLT,LAMICOID,1 LINE
	11	M-8000-393	NAMEPLT,LAMICOID,3 LINE

REVISION INFORMATION	Drawing Title				
NUMBER	MISCELLANEOUS DETAILS				
DATE	07/17/01	REFERENCE DRAWING	NO	REVISION LOCATION	ECN
TIME	07:20 AM	Sales Engineer	Project Manager	Application Engineer	DATE
FILE NAME	msdetc2.vst	PJS	TP	KJK	BY MLR DATE
	Project Title	MILLER PARK ONE BREWERS WAY MILWAUKEE, WI 53214			Branch Information
					Wisconsin Area Office 529 N. Jackson Street Milwaukee WI 53202 Phone: 414-524-7500 Fax: 414-524-7575
					CONTRACT NUMBER
					9 8075-0508
					DRAWING NUMBER
					36.3

**DETAIL D**  
TYPICAL OF 7

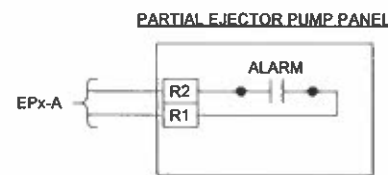

NOTE: SEE MANUFACTURER'S WIRING DIAGRAM FOR COMPLETE WIRING DETAILS.

Rev.	MECHANICAL SYSTEM	LOCATION	SYSTEM	OBJECT	PAGE #
2	EP-1	SL1	EP-ALM	EP1-A	NC-11 PS-24
2	EP-2	SL2	EP-ALM	EP2-A	NC-11 PS-24
2	EP-3	SL3	EP-ALM	EP3-A	NC-11 PS-25
2	EP-4	SL4	EP-ALM	EP4-A	NC-11 PS-2
2	EP-5	SL6	EP-ALM	EP5-A	NC-11 PS-31
2	EP-6	SL7	EP-ALM	EP6-A	NC-11 PS-31
2	EP-7	SL9	EP-ALM	EP7-A	NC-11 PS-34


Plumbing Equipment: The EMCS will monitor the following items of plumbing equipment:

1. Sewage Ejector Pumps (7 General panel alarms)

**DETAIL E**


**ELECTRIC METER 1**

(1 CONTACT CLOSURE = 0.48 KILLOWATTS)

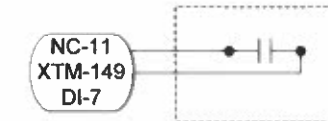


**ELECTRIC METER 2**

(1 CONTACT CLOSURE = 0.48 KILLOWATTS)

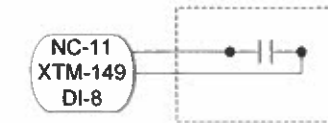


**GAS METER**

(1 CONTACT CLOSURE = 1000 CUBIC FEET)

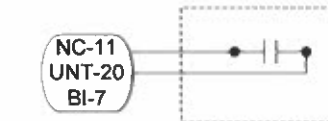


**WATER METER - CW MAKEUP**

(1 CONTACT CLOSURE = 100 GALLONS)

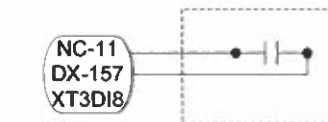


**WATER METER - CW BLOWDOWN**

(1 CONTACT CLOSURE = 10 GALLONS)

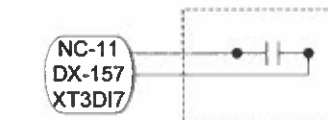

REVISION INFORMATION	Drawing Title	NO.		REVISION-LOCATION		DATE	BY
NUMBER	MISCELLANEOUS DETAILS	1		RECORD DRAWINGS		4/16/2001	MLR
DATE	08/16/02	Sales Engineer	Project Manager	Application Engineer	APPROVED		
TIME	10:06 AM	PJS	TP	KJK	BY	MLR	DATE
FILE NAME	msdetde.vsd	Project Title		SEARCH INFORMATION		CONTRACT NUMBER	
	MILLER PARK ONE BREWERS WAY MILWAUKEE, WI 53214	JOHNSON CONTROLS		Wisconsin Area Office 529 N. Jackson Street Milwaukee WI 53202 Phone: 414-524-7500 Fax: 414-524-7575		9 8075-0508	
		Systems & Services Division				DRAWING NUMBER 36.4	

**DETAIL F**  
TYPICAL OF 2

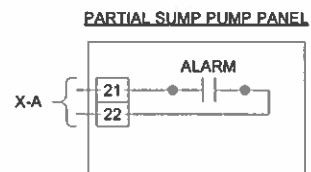


NOTE: SEE MANUFACTURER'S WIRING DIAGRAM FOR COMPLETE WIRING DETAILS.

Rev.	MECHANICAL SYSTEM	LOCATION	SYSTEM	OBJECT	PAGE #
1	FIELD DRAINAGE SUMP PUMP 1 & 2	SECTOR 1	MISC	LEFT-A	NC-11 PS-5
1	FIELD DRAINAGE SUMP PUMP 3 & 4	SECTOR 8	MISC	RIGHT-A	NC-11 PS-33

Plumbing Equipment: The EMCS will monitor the following items of plumbing equipment:

- Sump Pump for Field Drainage (General panel alarm).

**DETAIL G**  
TYPICAL OF 2

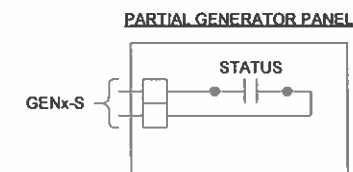

NOTE: SEE MANUFACTURER'S WIRING DIAGRAM FOR COMPLETE WIRING DETAILS.

Rev.	MECHANICAL SYSTEM	LOCATION	SYSTEM	OBJECT	PAGE #
1	GEN-1	SECTOR 8	GEN	GEN1-S	NC-11 PS-21
1	GEN-2	SECTOR 2	GEN	GEN2-S	NC-11 PS-21

General: The EMCS will monitor the following items of equipment:

- Standby Emergency Generator (On/Off status)

REVISION INFORMATION		Drawing Title									
NUMBER		MISCELLANEOUS DETAILS									
DATE		04/16/01		REFERENCE DRAWING		NO.		REVISION LOCATION		ECN DATE BY	
TIME		09:33 AM		Sales Engineer		Project Manager		Application Engineer		DRAWN APPROVED	
FILE NAME		msdetfg.vsd		PJS		TP		KJK		BY MLR DATE	
TIME		09:33 AM		Project Title		MILLER PARK ONE BREWERS WAY MILWAUKEE, WI 53214				Branch Information	
								Wisconsin Area Office 529 N. Jackson Street Milwaukee WI 53202 Phone: 414-524-7500 Fax: 414-524-7575		CONTRACT NUMBER <b>9 8075-0508</b>	
										DRAWING NUMBER <b>36.5</b>	


**BILL OF MATERIALS**

Designation	Qty	Part Number	Description
Field Devices:			
HBDPRx-C	4	CVR-21C-0	RLY 2SPDT,10-30VAC/DC OR 120VAC,LED @LEC
P-HBDx	4	BZ-1000-11	UTILITY ENCLOSURE
R-1	4	PD-109-30	RELAY 4PDT 25A 115V

**DETAIL H**

**PARTIAL CONTROL ROOF PANEL**

Typical of 1

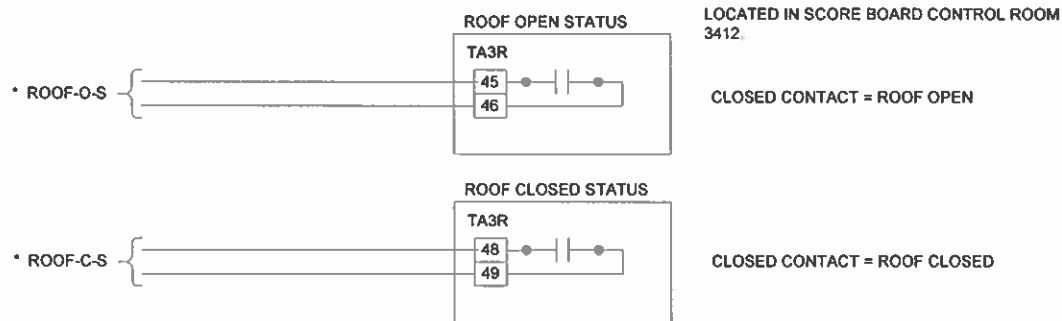


NOTE: SEE MANUFACTURER'S WIRING DIAGRAM FOR COMPLETE WIRING DETAILS.

\* PANEL P-RC6, ROOM 3505, PAGE NC-12 PS-28

**HIGH BOWL DAMPER CONTROL**

Typical of 4

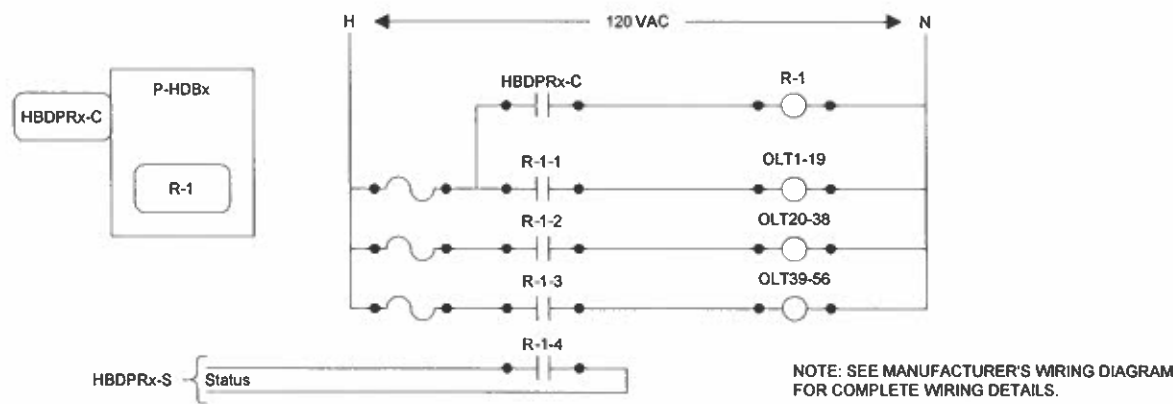


**DETAIL I**

TYPICAL OF 1

**PARTIAL ROOF SNOW MELT PANEL**

LOCATED IN SCOREBOARD CONTROL ROOM 3412

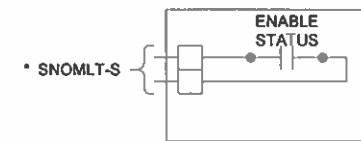

NOTE: SEE MANUFACTURER'S WIRING DIAGRAM FOR COMPLETE WIRING DETAILS.

\* PANEL P-RC6, ROOM 3505, PAGE NC-12 PS-28

**NOTE:**  
The Snow Melt Panels will be installed at -  
Outfield Gutter area of 4R & 4L  
Outfield Catwalk for 3R, 2R, 1, 2L & 3L  
Home Plate Gutter area of 4R & 4L  
Pivot Catwalk

General: The EMCS will monitor the following items of equipment:

1. Roof Snow Melt (on/off enable status)


General: The EMCS will monitor the following items of equipment:

1. Roof Mechanism (open/close status)
2. High Bowl dampers (open/close command, open/close status).

Rev.	MECHANICAL		ELECTRIC PANEL		SYSTEM	OBJECT	PAGE#	PANEL
	SYSTEM	LOCATION	PANEL #	LOCATION				
2	ROOF	TC5	n/a	n/a	MISC	ROOF-O-S	NC-12 PS-28	P-RC6
2	ROOF	TC5	n/a	n/a	MISC	ROOF-C-S	NC-12 PS-28	P-RC6
2	DAMPER	TB-1	L4T1	Access 5150	MISC	HBDPR1-C	NC-13 PS-30	P-TB1
2	DAMPER	TB-1	L4T1	Access 5150	MISC	HBDPR1-S	NC-13 PS-30	P-TB1
2	DAMPER	TC-4	L3TC1	Electric 5403	MISC	HBDPR2-C	NC-13 PS-31	P-TB4
2	DAMPER	TC-4	L3TC1	Electric 5403	MISC	HBDPR2-S	NC-13 PS-31	P-TB4
2	DAMPER	TC-5	L2TC1	Electric 5506	MISC	HBDPR3-C	NC-12 PS-29	P-TB5
2	DAMPER	TC-5	L2TC1	Electric 5506	MISC	HBDPR3-S	NC-12 PS-29	P-TB5
2	DAMPER	TB-8	L1T1	Mech 5850	MISC	HBDPR4-C	NC-12 PS-30	P-TB8
2	DAMPER	TB-8	L1T1	Mech 5850	MISC	HBDPR4-S	NC-12 PS-30	P-TB8

REVISION INFORMATION	Drawing Title				
NUMBER	MISCELLANEOUS DETAILS				
DATE	04/16/01	REFERENCE DRAWING	NO.	REVISION-LOCATION	ECH DATE BY
TIME	09:43 AM	Sales Engineer	Project Manager	Application Engineer	DRAWN
FILE NAME	msdethl.vsd	PJS	TP	KJK	BY MLR DATE
	Project Title	MILLER PARK ONE BREWERS WAY MILWAUKEE, WI 53214		Branch Information	CONTRACT NUMBER
		JOHNSON CONTROLS Systems & Services Division		Wisconsin Area Office 529 N. Jackson Street Milwaukee WI 53202 Phone: 414-524-7500 Fax: 414-524-7575	9 8075-0508
					DRAWING NUMBER
					36.6

**DETAIL J**  
TYPICAL OF 1

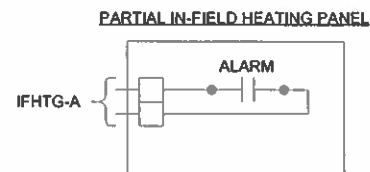

NOTE: SEE MANUFACTURER'S WIRING DIAGRAM FOR COMPLETE WIRING DETAILS.

Rev.	MECHANICAL SYSTEM	LOCATION	SYSTEM	OBJECT	PAGE #
2	IN-FIELD HEATING		MISC	IFHTG-A	NC- PS-


General: The EMCS will monitor the following items of equipment:

- In-Field Heating System (General panel alarm).

**BILL OF MATERIALS**

Designation	Qty	Part Number	Description
Field Devices:			
AC-1	1	AD-010-3C4	AD-010-3C4 COMPR-DUPLEX
AC1-LP	1	P61AA-6C	PUMP & AIR COMP SWITCH
AD-1	1	A-4412-1	DRYER, 12CFM WAIR SYS 115
CMI-1	1	CMI	COLOR MOISTURE INDICATOR - HANKSON
DD-1	1	HMD-20-2	DESICCANT DRYER - HANKISON
PI-X	2	G-2010-302	GAGE, 2.5IN 0-100PSIG FLUSH
PRV-x	14	A-4000-138	PRV 3/8", W/BKT, GAGE POP
V-X	3	5x713	DYNAQUIP VMH2 A9 1/9 BRASS 8TU VALVE - GRAINGER

**DETAIL K**  
TYPICAL OF 1

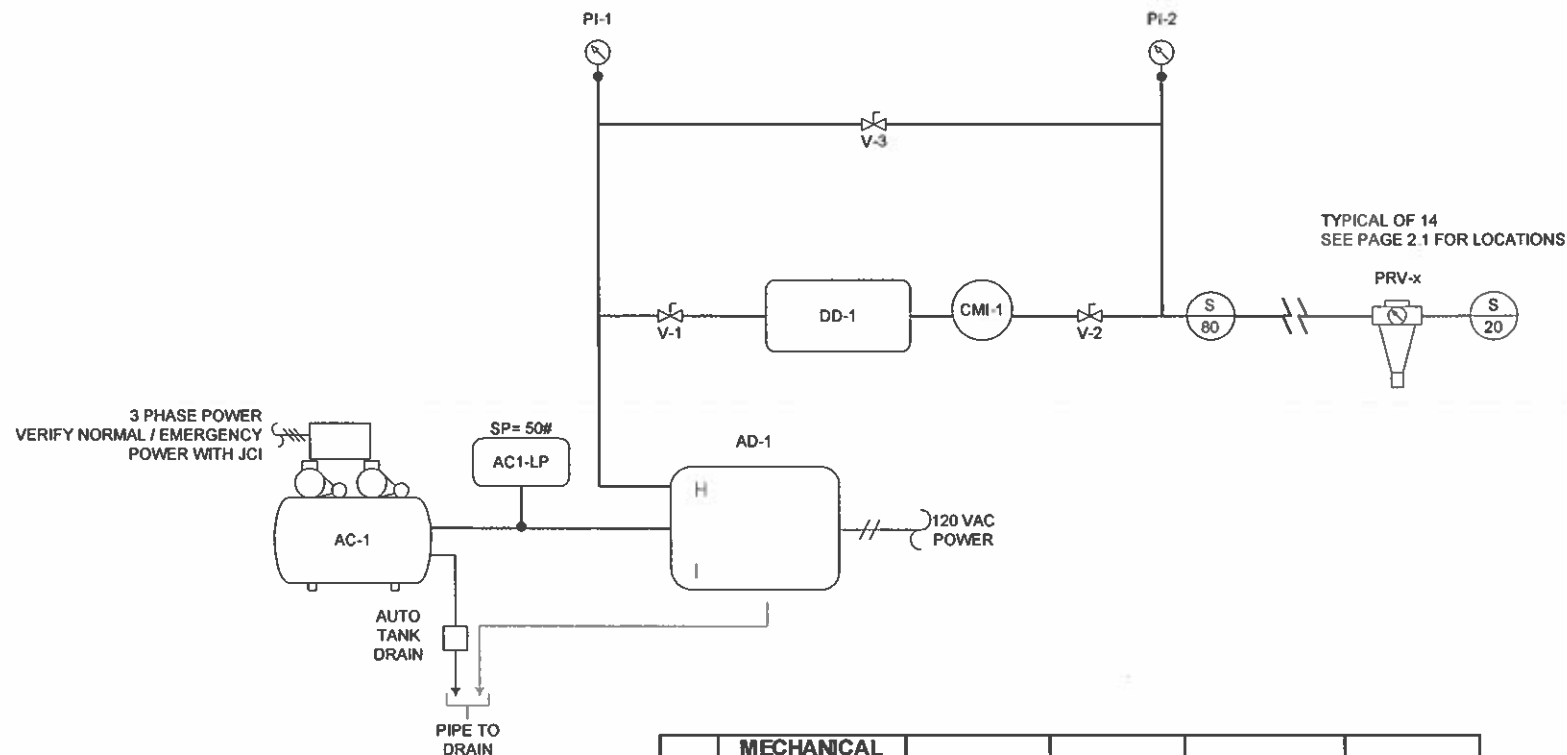

Rev.	MECHANICAL SYSTEM	LOCATION	SYSTEM	OBJECT	PAGE #
2	AC-1	SL1	MISC	AC1-LP	NC-11 PS-5

General: The EMCS will monitor the following items of equipment:

- Temperature Control Air Compressor (Low tank pressure)

REVISION INFORMATION	Drawing Title								
NUMBER	MISCELLANEOUS DETAILS								
DATE	04/16/01	REFERENCE DRAWING	NO.	REVISION-LOCATION	ECN	DATE	BY		
TIME	09:47 AM	Sales Engineer	PJS	Project Manager	TP	Application Engineer	KJK	BY	MLR
FILE NAME	msdetjk.vsd	Project Title		MILLER PARK ONE BREWERS WAY MILWAUKEE, WI 53214		Branch Information		CONTRACT NUMBER	
		JOHNSON CONTROLS		Systems & Services Division		Wisconsin Area Office 529 N. Jackson Street Milwaukee WI 53202 Phone: 414-524-7500 Fax: 414-524-7575		9 8075-0508	
								DRAWING NUMBER	
								36.7	


**BILL OF MATERIALS**

Designation	Qty	Part Number	Description
Field Devices: UHx-D	1	CVR-21C-0	RLY 2SPDT,10-30VAC/DC OR 120VAC,LED @LEC

**DETAIL L**  
TYPICAL OF 71



UHx-D

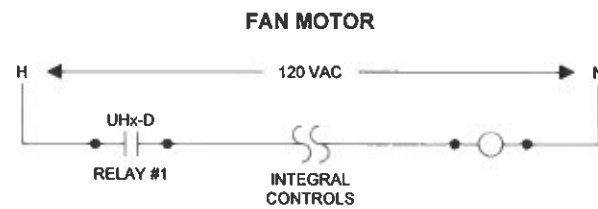

Rev.	MECHANICAL SYSTEM	LOCATION	SYSTEM	OBJECT	PAGE #
1	CUH-2	LL5	UH	UH3508-D	NC-12 PS-28
1	CUH-2	LL5	UH	UH3509-D	NC-12 PS-28
1	CUH-2	CL1	UH	UH4102-D	NC-13 PS-8
1	CUH-2	CL1	UH	UH4104-D	NC-13 PS-8
1	CUH-1	CL1	UH	UH4107-D	NC-13 PS-8
1	CUH-1	CL1	UH	UH4109-D	NC-13 PS-8
1	CUH-2	CL2	UH	UH4213-D	NC-13 PS-20
1	CUH-2	CL2	UH	UH4214-D	NC-13 PS-21
1	CUH-2	CL5	UH	UH4511-D	NC-12 PS-21
1	CUH-2	CL5	UH	UH4512-D	NC-12 PS-21
1	CUH-2	CL7	UH	UH4712-D	NC-12 PS-15
1	CUH-2	CL7	UH	UH4713-D	NC-12 PS-15
1	UH-2	TC1	UH	UH5105-D	NC-13 PS-24
1	UH-2	TC1	UH	UH5106-D	NC-12 PS-19
1	UH-3	TC1	UH	UH5107-D	NC-13 PS-23
1	UH-3	TC2	UH	UH5205-D	NC-13 PS-22
1	UH-3	TC2	UH	UH5206-D	NC-13 PS-22
1	UH-3	TC3	UH	UH5301-D	NC-13 PS-19
1	UH-3	TC4	UH	UH5302-D	NC-13 PS-18
1	UH-3	TC4	UH	UH5407-D	NC-13 PS-17
1	UH-3	TC4	UH	UH5409-D	NC-13 PS-16
1	UH-3	TC5	UH	UH5501-D	NC-12 PS-23
1	UH-3	TC5	UH	UH5504-D	NC-12 PS-21
1	UH-3	TC5	UH	UH5601-D	NC-12 PS-19
1	UH-3	TC6	UH	UH5602-D	NC-12 PS-18

Rev.	MECHANICAL SYSTEM	LOCATION	SYSTEM	OBJECT	PAGE #
1	UH-3	TC7	UH	UH5703-D	NC-12 PS-16
1	UH-3	TC7	UH	UH5704-D	NC-12 PS-16
1	UH-3	TC7	UH	UH5801-D	NC-12 PS-14
1	UH-3	TC8	UH	UH5802-D	NC-12 PS-13
1	UH-3	TC8	UH	UH5802-D	NC-12 PS-13
1	UH-4	FL2	UH	UH2204-D	NC-13 PS-6
1	UH-4	FL2	UH	UH2205-D	NC-13 PS-6
1	UH-5	FL2	UH	UH2307-D	NC-13 PS-2
1	UH-4	FL3	UH	UH2309-D	NC-13 PS-2
1	UH-5	FL4	UH	UH2410-D	NC-13 PS-27
1	UH-5	FL4	UH	UH2413-D	NC-13 PS-25
1	UH-5	FL5	UH	UH2519-D	NC-12 PS-26
1	UH-5	FL5	UH	UH2520-D	NC-12 PS-25
1	UH-5	FL6	UH	UH2606-D	NC-12 PS-23
1	UH-4	FL6	UH	UH2608-D	NC-12 PS-24
1	UH-5	FL7	UH	UH2704-D	NC-12 PS-1
1	UH-5	FL7	UH	UH2706-D	NC-12 PS-1
1	UH-3	FL8	UH	UH2812-D	NC-12 PS-32
1	UH-3	FL8	UH	UH2814-D	NC-12 PS-32
1	UH-3	LL1	UH	UH3102-D	NC-13 PS-7
1	UH-4	LL1	UH	UH3103-D	NC-13 PS-7
1	UH-4	LL1	UH	UH3113-D	NC-13 PS-8
1	UH-4	LL2	UH	UH3114-D	NC-13 PS-8
1	UH-5	LL2	UH	UH3204-D	NC-13 PS-23
1	UH-4	LL2	UH	UH3209-D	NC-13 PS-22
1	UH-4	LL3	UH	UH3301-D	NC-13 PS-21
1	UH-4	LL4	UH	UH3403-D	NC-13 PS-21
1	UH-4	LL5	UH	UH3512-D	NC-12 PS-5
1	UH-4	LL6	UH	UH3603-D	NC-12 PS-5
1	UH-4	LL7	UH	UH3705-D	NC-12 PS-17
1	UH-5	LL7	UH	UH3710-D	NC-12 PS-15
1	UH-5	LL8	UH	UH3801-D	NC-12 PS-1
1	UH-5	LL8	UH	UH3802-D	NC-12 PS-1
1	UH-3	LL8	UH	UH3815-D	
1	UH-3	LL8	UH	UH3814-D	
1	CUH-2	CL-4	UH	UH4412-D	NC-13 PS-18
1	CUH-3	CL-4	UH	UH4413-D	NC-13 PS-18

MUX TO VAVA302 NC-12, VMA-7 B04  
MUX TO VAVA302 NC-12, VMA-7 B03

**Electric Heating Systems**



- Provide one on-off control signal from the EMCS to all of the electric unit heaters and cabinet heaters serving the concourse toilet rooms. Provide a dry set of contacts for each heater to override the heater's integral controls and automatically turn off the heaters. No other electric heating equipment will be part of this sequence.

REVISION INFORMATION	Drawing Title				
NUMBER	MISCELLANEOUS DETAILS				
DATE	04/16/01	REFERENCE DRAWING	NO	REVISION LOCATION	ECH DATE BY
TIME	09:54 AM	Sales Engineer	Project Manager	Application Engineer	DATE
FILE NAME	msdetl.vsd	PJS	TP	KJK	DATE
Project Title		Branch Information		CONTRACT NUMBER	
MILLER PARK ONE BREWERS WAY MILWAUKEE, WI 53214		Wisconsin Area Office 529 N. Jackson Street Milwaukee WI 53202 Phone: 414-524-7500 Fax: 414-524-7575		9 8075-0508	
		JOHNSON CONTROLS Systems & Services Division		DRAWING NUMBER 36.8	

**BILL OF MATERIALS**

Designation	Qty	Part Number	Description
Field Devices:			
ENC-1	1	A-6R64	ENCLOSURE NEMA 3R - HOFFMAN
TIMER	1	90240	MANUAL TIMER 0-4HR - KELE

**DETAIL M**  
TYPICAL OF 4

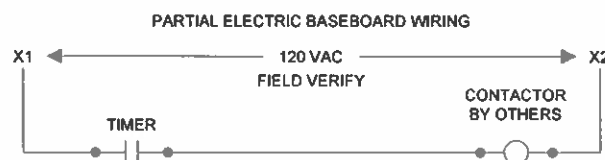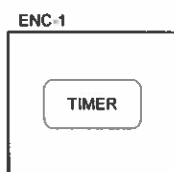

NOTE: SEE MANUFACTURER'S WIRING DIAGRAM FOR COMPLETE WIRING DETAILS.

**Electric Heating Systems**

- For each bulpen and dugout, provide a wall mounted NEMA 3R rated electronic timer and NEMA 3R rated contactor to manually control the electric baseboard units. Timer will be adjustable from 0 to 4 hours. Division 16 will wire the electric baseboard through the contactor. No interface with the EMCS is required.

**BILL OF MATERIALS**

Designation	Qty	Part Number	Description
Field Devices:			
1	3	VA-201T-Q1	METHANE SENSOR - VULCAIN
	1	VA201C	CENTRAL PANEL - VULCAIN
2	4	VA-201T-Q1	METHANE SENSOR - VULCAIN
	1	VA201C	CENTRAL PANEL - VULCAIN
3	14	VA-201T-Q2	CO SENSOR - VULCAIN
	1	VA201C	CENTRAL PANEL - VULCAIN

**DETAIL N**  
TYPICAL OF 1





**PARTIAL GAS DETECTION PANELS**

NOTE: SEE MANUFACTURER'S WIRING DIAGRAM FOR COMPLETE WIRING DETAILS.

SENSOR	LOCATION
S-8	SL7, Mech Rm 1727
S-12	SL5, Remote Studio Rm 1534
S-14	SL4, Electrical Rm 1401

L-1	SL8, Service Tunnel
L-2	SL6, Service Tunnel
L-3	SL3, Service Tunnel
L-4	SL1, Service Tunnel

CO-1	SL8, Service Tunnel	J3
CO-2	SL8, Service Tunnel	
CO-3	SL7, Service Tunnel	
CO-4	SL7, Service Tunnel	
CO-5	SL6, Service Tunnel	J4
CO-6	SL5, Service Tunnel	
CO-7	SL5, Service Tunnel	
CO-8	SL4, Service Tunnel	
CO-9	SL4, Service Tunnel	
CO-10	SL3, Service Tunnel	
CO-11	SL2, Service Tunnel	
CO-12	SL2, Service Tunnel	
CO-13	SL1, Service Tunnel	
CO-14	SL1, Service Tunnel	

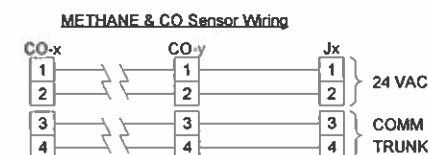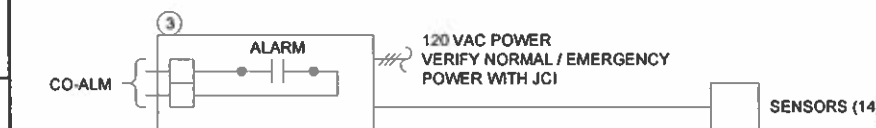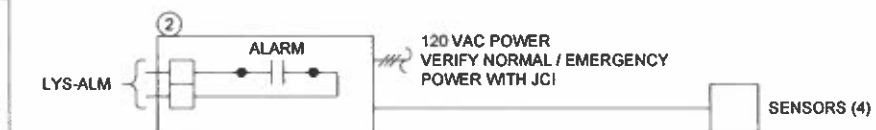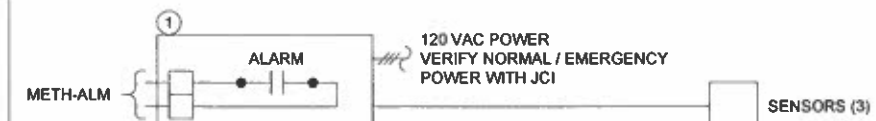


Rev.	MECHANICAL SYSTEM	LOCATION	SYSTEM	OBJECT	PAGE #
2	METHANE DETECTION	SL5	GAS	METH-ALM	NC-11 PS-28
2	METHANE DETECTION	SL5	GAS	LYS-ALM	NC-11 PS-28
2	METHANE DETECTION	SL5	GAS	CO-ALM	NC-11 PS-28

**Methane Detection System Interface**


- Provide two remote annunciation interfaces with the owners methane gas detection systems. The first interface is for the lysimeter system. Whenever the lysimeter system detects methane, the EMCS will sound an alarm. The second interface is for the methane air monitoring gas detection system. When methane is detected in the space, the EMCS will sound an alarm and index all HVAC systems on the service level and field level to the occupied mode of operation.

REVISION INFORMATION NUMBER DATE 11/08/09 TIME 09:22 AM FILE NAME msdetmn (Ver5).vsd	Drawing Title <b>MISCELLANEOUS DETAILS</b>		REFERENCE DRAWING NO. DATE BY		EGN DATE BY
	Project Title <b>MILLER PARK ONE BREWERS WAY MILWAUKEE, WI 53214</b>		DRAWN PJS TP KJK DATE		APPROVED DATE
Branch Information <b>JOHNSON CONTROLS</b> Systems & Services Division			Wisconsin Area Office 529 N. Jackson Street Milwaukee WI 53202 Phone: 414-524-7500 Fax: 414-524-7575		CONTRACT NUMBER <b>9 8075-0508</b> DRAWING NUMBER <b>36.9</b>


**DETAIL O**  
TYPICAL OF 1

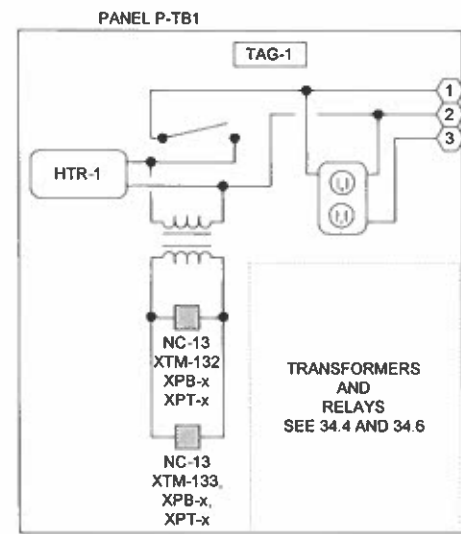


**PANEL FACE TAGS:**  
TAG-1: PANEL P-TB1  
MULTI-PLEXED  
POINTS  
JCI 9 8075-0508

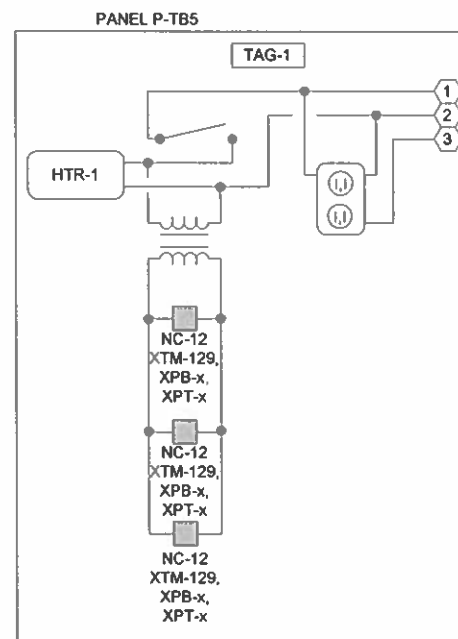


**PANEL FACE TAGS:**  
TAG-1: PANEL P-TB5  
MULTI-PLEXED  
POINTS  
JCI 9 8075-0508

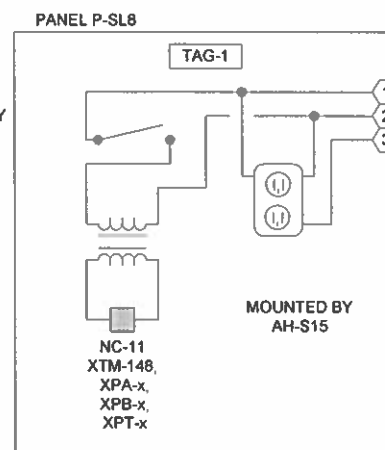


**PANEL FACE TAGS:**  
TAG-1: PANEL P-SL8  
MULTI-PLEXED  
POINTS  
JCI 9 8075-0508

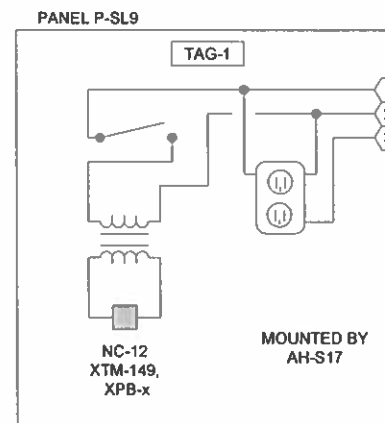

**PANEL FACE TAGS:**  
TAG-1: PANEL P-SL9  
MULTI-PLEXED  
POINTS  
JCI 9 8075-0508

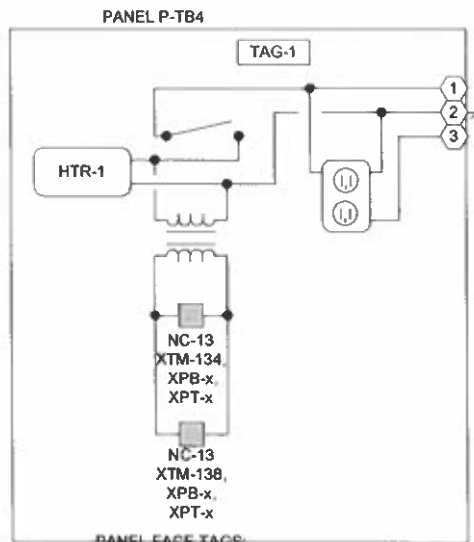

**PANEL FACE TAGS:**  
TAG-1: PANEL P-TB4  
MULTI-PLEXED  
POINTS  
JCI 9 8075-0508

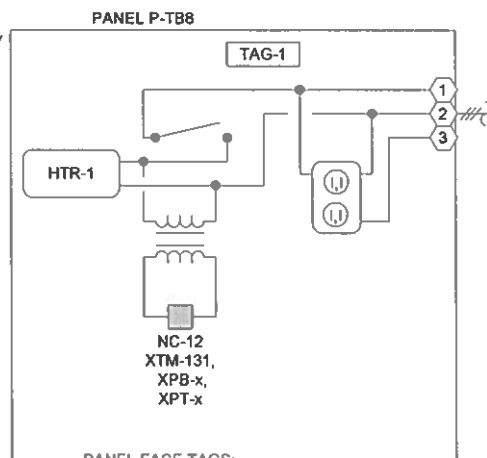

**PANEL FACE TAGS:**  
TAG-1: PANEL P-TB8  
MULTI-PLEXED  
POINTS  
JCI 9 8075-0508

**BILL OF MATERIALS**

Designation	Qty	Part Number	Description
<b>Panel Devices:</b>			
HTR-1	1	EN2-12-P-040-D	PANEL HEATER, 120VAC, ELECTRO-FLEX
P-TB1	1	M-8100-2424	PANEL STANDARD, 9 UNITS
TAG-1	1	M-8000-393	NAMEPLT, LAMICOID, 3 LINE
XPB-x	2	XPB-821-5	N2 EXPN MOD, 8BI
XPT-x	2	XPT-861-5	N2 EXPN MOD, 8BO, TRIAC
XTM-x	2	BKT287-1R	35MM DIN RAIL - 12" LONG
	2	PLT344-1R	DIN RAIL END PLT (2/PKG)
	2	XTM-105-5	N2 EXT'N MOD, COMM I/F

**BILL OF MATERIALS**

Designation	Qty	Part Number	Description
<b>Panel Devices:</b>			
HTR-1	1	EN2-12-P-040-D	PANEL HEATER, 120VAC, ELECTRO-FLEX
P-TB4	1	M-8100-2424	PANEL STANDARD, 9 UNITS
TAG-1	1	M-8000-393	NAMEPLT, LAMICOID, 3 LINE
XPB-x	2	XPB-821-5	N2 EXPN MOD, 8BI
XPT-x	2	XPT-861-5	N2 EXPN MOD, 8BO, TRIAC
XTM-x	2	BKT287-1R	35MM DIN RAIL - 12" LONG
	2	PLT344-1R	DIN RAIL END PLT (2/PKG)
	2	XTM-105-5	N2 EXT'N MOD, COMM I/F

**BILL OF MATERIALS**

Designation	Qty	Part Number	Description
<b>Panel Devices:</b>			
HTR-1	1	EN2-12-P-040-D	PANEL HEATER, 120VAC, ELECTRO-FLEX
P-TB5	1	M-8100-2424	PANEL STANDARD, 9 UNITS
TAG-1	1	M-8000-393	NAMEPLT, LAMICOID, 3 LINE
XPB-x	3	XPB-821-5	N2 EXPN MOD, 8BI
XPT-x	3	XPT-861-5	N2 EXPN MOD, 8BO, TRIAC
XTM-x	3	BKT287-1R	35MM DIN RAIL - 12" LONG
	3	PLT344-1R	DIN RAIL END PLT (2/PKG)
	3	XTM-105-5	N2 EXT'N MOD, COMM I/F

**BILL OF MATERIALS**

Designation	Qty	Part Number	Description
<b>Panel Devices:</b>			
HTR-1	1	EN2-12-P-040-D	PANEL HEATER, 120VAC, ELECTRO-FLEX
P-TB8	1	M-8100-2424	PANEL STANDARD, 9 UNITS
TAG-1	1	M-8000-393	NAMEPLT, LAMICOID, 3 LINE
XPB-x	1	XPB-821-5	N2 EXPN MOD, 8BI
XPT-x	1	XPT-861-5	N2 EXPN MOD, 8BO, TRIAC
XTM-x	1	BKT287-1R	35MM DIN RAIL - 12" LONG
	1	PLT344-1R	DIN RAIL END PLT (2/PKG)
	1	XTM-105-5	N2 EXT'N MOD, COMM I/F

**BILL OF MATERIALS**

Designation	Qty	Part Number	Description
<b>Panel Devices:</b>			
P-SL8	1	EN-EWC15-0	SINGLE ENCLOSURE WITH 50VA POWER
TAG-1	1	M-8000-393	NAMEPLT, LAMICOID, 3 LINE
XPA-x	1	XPA-821-5	CNTRLR, N2 EXPN MOD, 5A1, 2AO
XPB-x	1	XPB-821-5	N2 EXPN MOD, 8BI
XPT-x	1	XPT-861-5	CNTRLR, N2 EXPN MOD, 8BO, TRIAC
XTM-x	1	BKT287-1R	35MM DIN RAIL - 12" LONG
	1	PLT344-1R	DIN RAIL END PLT (2/PKG)
	1	XTM-105-5	N2 EXT'N MOD, COMM I/F

**BILL OF MATERIALS**

Designation	Qty	Part Number	Description
<b>Panel Devices:</b>			
P-SL9	1	EN-EWC15-0	SINGLE ENCLOSURE WITH 50VA POWER
	1	EN-EXP101-0	EXPANSION COVER AND BACKBONE
TAG-1	1	M-8000-393	NAMEPLT, LAMICOID, 3 LINE
XPB-x	1	XPB-821-5	N2 EXPN MOD, 8BI
XTM-x	1	BKT287-1R	35MM DIN RAIL - 12" LONG
	1	PLT344-1R	DIN RAIL END PLT (2/PKG)
	1	XTM-105-5	N2 EXT'N MOD, COMM I/F


<b>REVISION INFORMATION</b> NUMBER DATE TIME FILE NAME	Drawing Title							
	MISCELLANEOUS DETAILS							
	04/16/01							
	10:08 AM							
msdeto.vsd		Project Title		REFERENCE DRAWING		NO		
		MILLER PARK ONE BREWERS WAY MILWAUKEE, WI 53214		Sales Engineer		Application Engineer		
				PJS		KJK		
				TP		MLR		
				DATE		DATE		
				APPROVED		APPROVED		
				BY		BY		
				DATE		DATE		
				CONTRACT NUMBER		CONTRACT NUMBER		
				9 8075-0508		9 8075-0508		
				DRAWING NUMBER		DRAWING NUMBER		
				36.10		36.10		
				JOHNSON CONTROLS Systems & Services Division		Wisconsin Area Office 529 N. Jackson Street Milwaukee WI 53202 Phone: 414-524-7500 Fax: 414-524-7575		



**BILL OF MATERIALS**

Designation	Qty	Part Number	Description
Panel Devices:			
UNT-x	1	AS-UNT141-101	CNTRLR,UNT.6AI.4BI.6BO,2AO,SCR,ENCL,50V
	1	AS-EXP101-1	EXPANSION COVER AND BACKBONE


**DETAIL P**  
TYPICAL OF 6

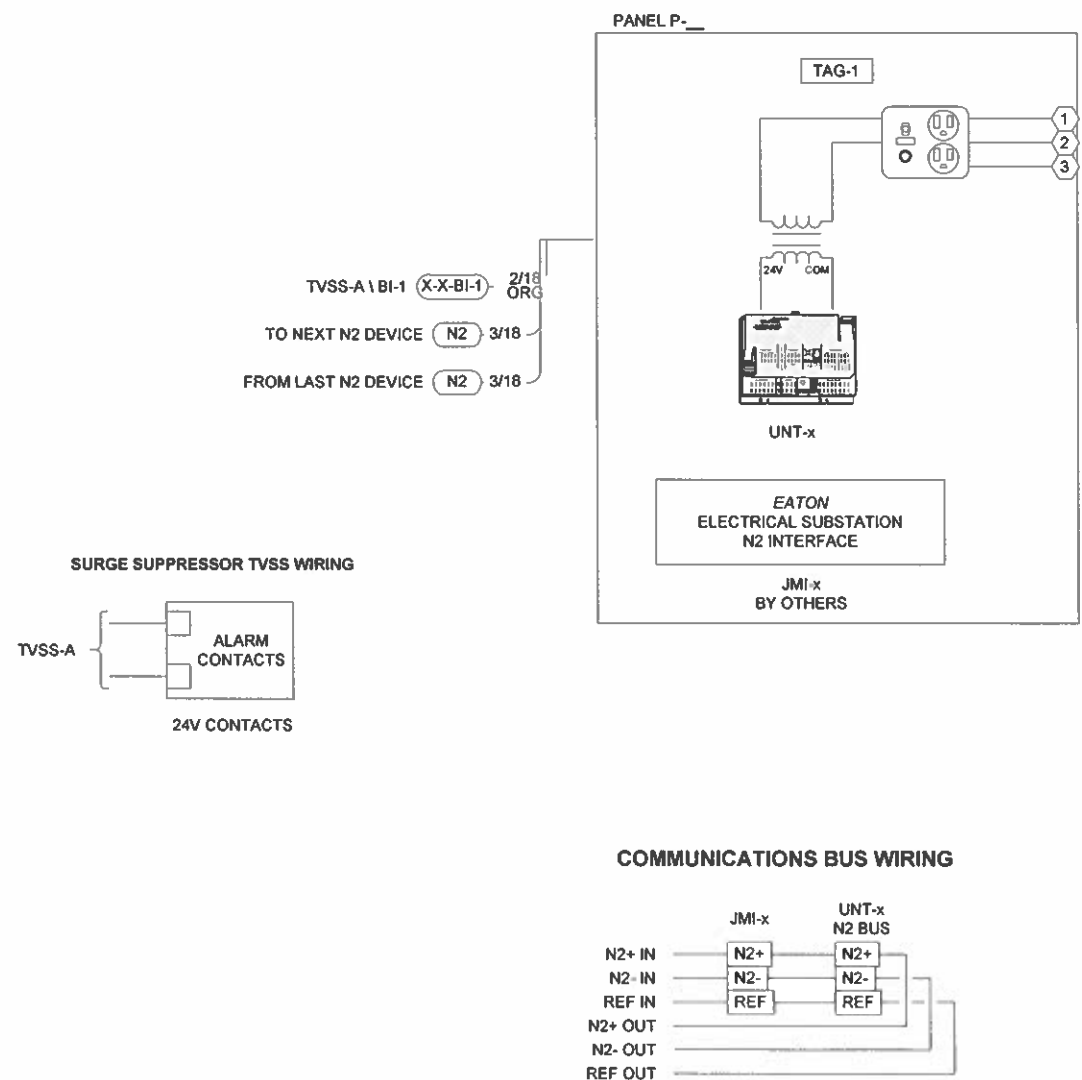

**BILL OF MATERIALS**

Designation	Qty	Part Number	Description
Panel Devices:			
XP-1	1	XPB-821-5	CNTRLR,N2 EXPN MOD,8BI
XTM-70	1	XTM-105-5	CNTRLR,N2 EXTENSION MOD,COMM I/F

**DETAIL Q**  
TYPICAL OF 1

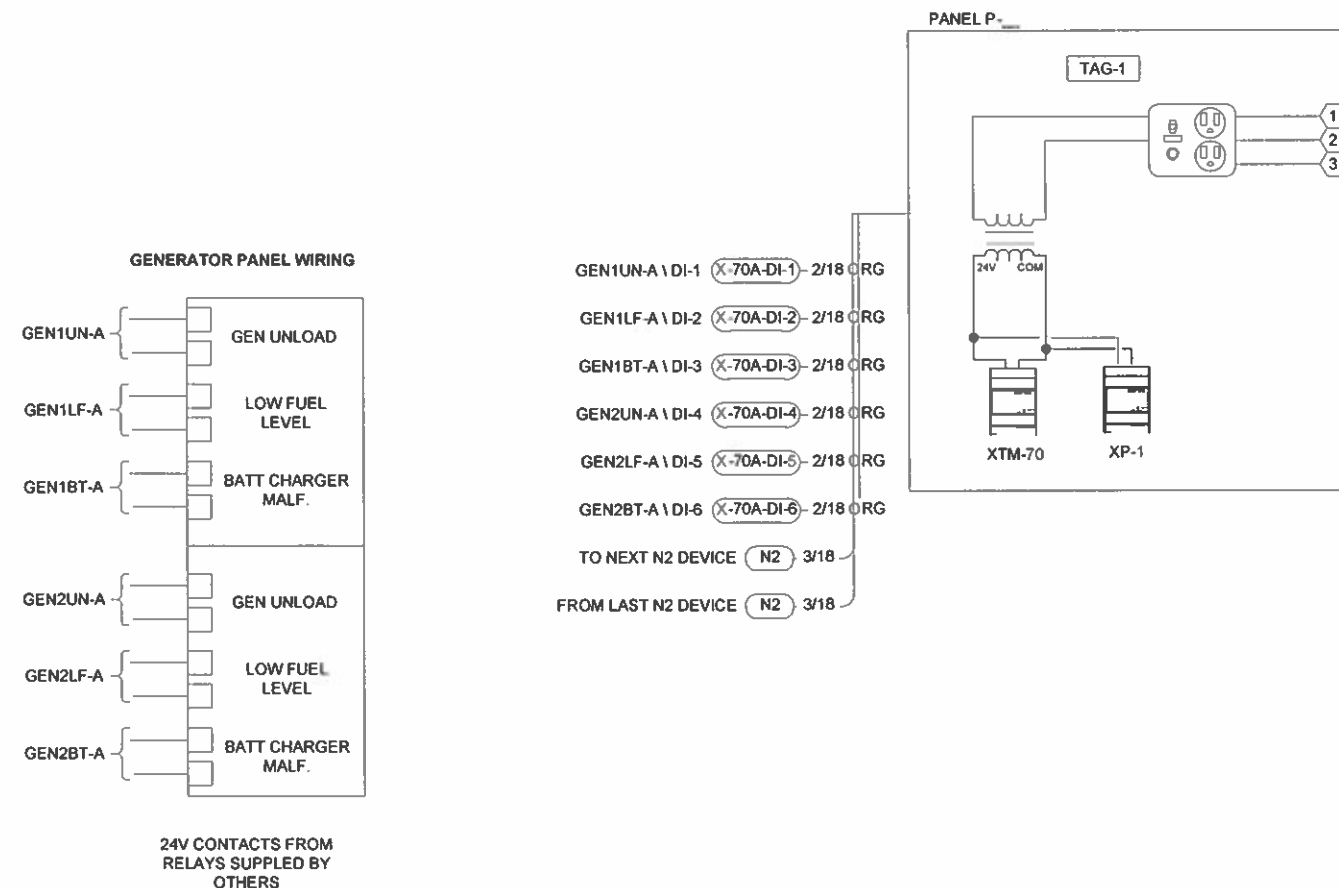


REVISION INFORMATION	Drawing Title				
NUMBER	MISCELLANEOUS DETAILS				
DATE	08/26/04	1	JCI CONTRACT 4933-0011	8/26/2004	MLR
TIME	09:13 AM	REFERENCE DRAWING		REVISION-LOCATION	
FILE NAME	msdetpq.vsd	Sales Engineer	Project Manager	Application Engineer	DATE
		PJS	TP	KJK	DATE
	Project Title	Branch Information		CONTRACT NUMBER	
	MILLER PARK ONE BREWERS WAY MILWAUKEE, WI 53214	Wisconsin Area Office 529 N. Jackson Street Milwaukee WI 53202 Phone: 414-524-7500 Fax: 414-524-7575		9 8075-0508	
		JOHNSON CONTROLS Systems & Services Division		DRAWING NUMBER 36.11	

## DETAIL R TYPICAL OF 1

### BILL OF MATERIALS

Designation	Qty	Part Number	Description
Panel Devices:			
MIG-x	1	MS-MIG3120-0	METASYS INTEGRATOR, 300 SERIES, 2-PORT
P-x	1	EN-EWC25-0	DUAL ENCLOSURE WITH 50VA POWER

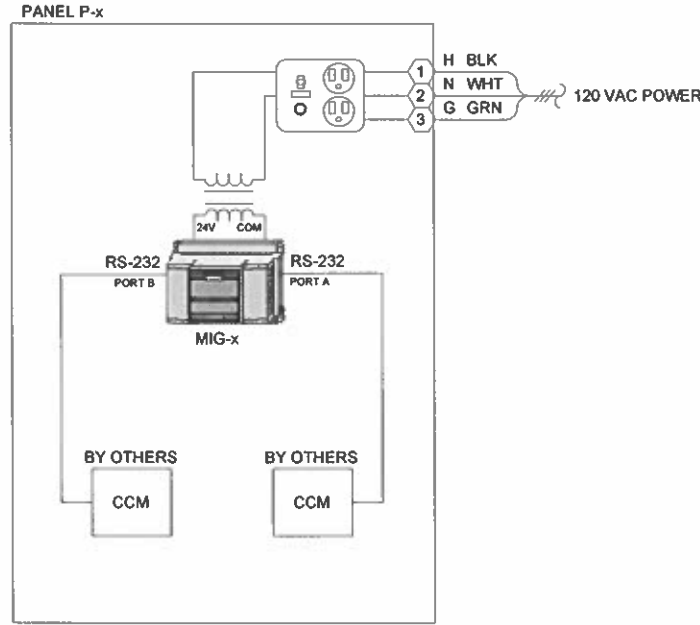


NOTE: USE VENDOR COMMUNICATION TABLES CATCCMNP.VCT AND CAT\_GEN.VCT. SEE POINT MAPPING LIST.  
 NOTE: COMMUNICATION RATE IS 9600 BAUD, 8 DATA BITS, NO PARITY, 1 STOP BIT.  
 NOTE: TIMEOUT VALVE IS 1000ms. POLL DELAY IS 100ms  
 NOTE: VENDOR ADDRESS FOR EACH GENERATOR SET = 1.

### COMMUNICATIONS BUS WIRING



### METASYS INTEGRATOR TO CATERPILLAR CCM

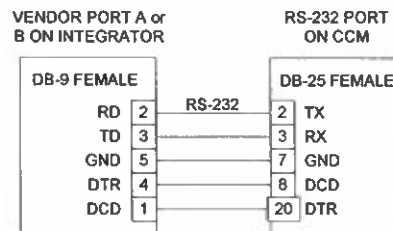

NOTE: MAXIMUM LENGTH OF RS-232 SHOULD NOT EXCEED 50 FEET.  
 NOTE: SEE MANUFACTURER'S WIRING DIAGRAM FOR COMPLETE WIRING DETAILS.

### EMCP II POINT MAPPING LIST

NPT <sup>1</sup>	NPA <sup>2</sup>	Unit	Description
<b>Fault Log: Code</b>			
AI	1	Code	Failure Mode Identifier Code (FMI) for Component ID (CID) at ADF 1 <sup>3</sup>
AI	2	Code	Failure Mode Identifier for Component ID at ADF 2
AI	3	Code	Failure Mode Identifier for Component ID at ADF 3
AI	4	Code	Failure Mode Identifier for Component ID at ADF 4
AI	5	Code	Failure Mode Identifier for Component ID at ADF 5
AI	6	Code	Failure Mode Identifier for Component ID at ADF 6
AI	7	Code	Failure Mode Identifier for Component ID at ADF 7
AI	8	Code	Failure Mode Identifier for Component ID at ADF 8
AI	9	Code	Failure Mode Identifier for Component ID at ADF 9
AI	10	Code	Failure Mode Identifier for Component ID at ADF 10
AI	11	RPM	Generator Set Engine RPM <sup>4</sup>
AI	12	DegF	Engine Coolant Temperature <sup>4</sup>
AI	13	DegC	Engine Coolant Temperature <sup>4</sup>
AI	14	kPa	Engine Oil Pressure <sup>4</sup>
AI	15	psi	Engine Oil Pressure <sup>4</sup>
AI	16	Hours	Generator Set Hourmeter (if=85536, =0)
AI	17	Volt	System Battery Voltage
AI	18	Hz	Generator Frequency
AI	19	Volt	Generator Line-Line Voltage for Selected Phase <sup>4</sup>
AI	20	Amperes	Generator Line Current for Selected Phase <sup>4</sup>

1 Network Point Type  
 2 Network Point Address  
 3 If both the component ID and component failure mode identifier equal zero, there is no logged fault (AI 1-10, ADF 1-10).  
 4 The point will be unreliable if a fault condition is reported.

Continued on next page . . .

### CCM POINT MAPPING LIST

NPT <sup>1</sup>	NPA <sup>2</sup>	Unit	Description
BI	1		RS232C Link Message Fault Exists 0-nor 1-alm
BI	2		Miscellaneous Cat Data Link Fault 0-nor 1-alm
BI	3		Invalid Cat Data Message Fault 0-nor 1-alm
BI	4		Internal Buffer Overflow 0-nor 1-alm
BI	5		RS232C Short Circuit Fault 0-nor 1-alm
BI	6		Memory Backup Battery is Weak 0-nor 1-alm
BI	7		MSX Message Error 0-nor 1-alm
BI	8		Setpoint (EEPROM) 0-nor 1-alm
BO <sup>3</sup>	1		Reset CCM Inactive Faults 0-N/A 1-rst

1 Network Point Type  
 2 Network Point Address  
 3 Do not map these points to Companion BO points or Metasys system CS objects. If you map these points to Metasys system BO points, make sure the Auto Restore option in the BO object's Definition or Focus window is disabled.

NPT <sup>1</sup> (Cont.)	NPA <sup>2</sup>	Unit	Description
BI	1		Fault Log: Status Fault Status for Component ID (CID) at ADF 1 0-ina, 1-act
BI	2		Fault Status for Component ID (CID) at ADF 2 0-ina, 1-act
BI	3		Fault Status for Component ID (CID) at ADF 3 0-ina, 1-act
BI	4		Fault Status for Component ID (CID) at ADF 4 0-ina, 1-act
BI	5		Fault Status for Component ID (CID) at ADF 5 0-ina, 1-act
BI	6		Fault Status for Component ID (CID) at ADF 6 0-ina, 1-act
BI	7		Fault Status for Component ID (CID) at ADF 7 0-ina, 1-act
BI	8		Fault Status for Component ID (CID) at ADF 8 0-ina, 1-act
BI	9		Fault Status for Component ID (CID) at ADF 9 0-ina, 1-act
BI	10		Fault Status for Component ID (CID) at ADF 10 0-ina, 1-act
BI	11		GSC Active Fault in Fault Log 0-ina, 1-act
BI	12		Remote Start Status <sup>5</sup> 0-off, 1-on
BI	13		GSC High Coolant Temperature <sup>5</sup> 0-nor, 1-alm
BI	14		GSC Low Coolant Temperature 0-nor, 1-alm
BI	15		GSC Low Oil Pressure 0-nor, 1-alm
BI	16		GSC Engine Control Switch 'Not in Auto' 0-nor, 1-alm
BI	17		GSC Overspeed Shutdown Status 0-nor, 1-alm
BI	18		GSC Overcrank Shutdown Status 0-nor, 1-alm
BI	19		GSC Low Oil Pressure Shutdown Status 0-nor, 1-alm
BI	20		GSC High Coolant Temp Shutdown Status 0-nor, 1-alm
BI	21		GSC Spare Shutdown Status 0-nor, 1-alm
BI	22		GSC Emergency Stop Shutdown Status 0-nor, 1-alm
BI	23		GSC Coolant Loss Shutdown Status 0-nor, 1-alm
BI	24		GSC Diagnostic Code Shutdown Status 0-nor, 1-alm
BI	25		GSC Spare Fault Alarm 1 0-nor, 1-alm
BI	26		GSC Spare Fault Alarm 2 0-nor, 1-alm
BI	27		GSC Spare Fault Alarm 3 0-nor, 1-alm
BI	28		GSC Spare Fault Shutdown 1 0-nor, 1-alm
BI	29		GSC Spare Fault Shutdown 2 0-nor, 1-alm
BI	30		GSC Spare Fault Shutdown 3 0-nor, 1-alm
BI	31		Air Shutoff GSC Relay 0-off, 1-on
BI	32		Fuel Control GSC Relay 0-off, 1-on
BI	33		Crank Terminate GSC Relay 0-off, 1-on

1 Network Point Type  
 2 Network Point Address  
 3 The point will be unreliable if a fault condition is reported.  
 4 The points BI 13-38 will be unreliable if the point is undefined or unavailable.  
 5 Do not use BO 2 and 3 for status. Use BI 35 and 38 (BO points for command only).


Continued on next page . . .

NPT <sup>1</sup> (Cont.)	NPA <sup>2</sup>	Unit	Description
BI	34		Starter Motor GSC Relay 0-off, 1-on
BI	35		Generator Set Fault GSC Relay 0-off, 1-on
BI	36		Run GSC Relay 0-off, 1-on
BI	37		Program Spare GSC Relay 0-off, 1-on
BI	38		Electronic Governor GSC Relay 0-off, 1-on
BO	1		Remote Start/Stop 0-stop, 1-start
BO <sup>7</sup>	2		Generator Set Fault GSC Relay 0-off, 1-on
BO <sup>7</sup>	3		Electronic Governor GSC Relay 0-off, 1-on
BO	4		Remote Emergency Stop <sup>8</sup> 0-off, 1-on
BO	5		Cooldown Override <sup>8</sup> 0-cont, 1-abort
BO <sup>9</sup>	6		Reset all Faults in Fault Log 0-N/A 1-reset
<b>Fault Log: Component ID</b>			
ADF	1	Code	Component ID (CID) with Fault at AI 1 <sup>3</sup>
ADF	2	Code	Component ID (CID) with Fault at AI 2
ADF	3	Code	Component ID (CID) with Fault at AI 3
ADF	4	Code	Component ID (CID) with Fault at AI 4
ADF	5	Code	Component ID (CID) with Fault at AI 5
ADF	6	Code	Component ID (CID) with Fault at AI 6
ADF	7	Code	Component ID (CID) with Fault at AI 7
ADF	8	Code	Component ID (CID) with Fault at AI 8
ADF	9	Code	Component ID (CID) with Fault at AI 9
ADF	10	Code	Component ID (CID) with Fault at AI 10
ADF	11	Sec	GSC Cycle Crank Time Setpoint
ADF	12	Sec	Total GSC Cycle Crank Time Setpoint
ADF	13	RPM	GSC Crank Terminate Speed Setpoint
ADF	14	RPM	Engine Overspeed Setpoint
ADF	15	RPM	Engine Oil Step Speed Setpoint
ADF	16	kPa	Low Engine Oil Pressure at Rated Speed Setpoint
ADF	17	kPa	Low Engine Oil Pressure at Idle Speed Setpoint
ADF	18	RPM	Generator Set Ring Gear Teeth Setpoint
ADI	1	Min	GSC Cooldown Timer Setpoint
ADI	2	Code	Engine Control Switch Position <sup>4</sup> 0-off/reset, 2-start, 3-stop, 4-auto, 128-169-fault identifiers
AO	1		Select Phase (0=A, 1=B, 2=C)

1 Network Point Type  
 2 Network Point Address  
 3 If both the component ID and component fault code equal zero, there is no logged fault (AI 1-10, ADF 1-10).  
 4 The point will be unreliable if a fault condition is reported.  
 5 Do not map these points to Companion BO points or Metasys CS objects. If you map these points to Metasys BO points, make sure the Auto Restore option in the object's Definition or Focus window is disabled.  
 6 Do not use BO 2 and 3 for status. Use BI 35 and 38 (BO points for command only).  
 7 Do not use BO 2 and 3 for status. Use BI 35 and 38 (BO points for command only).  
 8 Do not use BO 2 and 3 for status. Use BI 35 and 38 (BO points for command only).

REVISION INFORMATION	Drawing Title				
NUMBER	MISCELLANEOUS DETAILS	1	JCI CONTRACT 4933-0011	8/26/2004	MLR
DATE	08/26/04	REFERENCE DRAWING NO. REVISION LOCATION ECU DATE BY			
TIME	09:45 AM	Sales Engineer	Project Manager	Application Engineer	DRAWN APPROVED
FREE NAME	msdetr.vad	PJS	TP	KJK	DATE DATE
Project Title		Wisconsin Area Office		CONTRACT NUMBER	
MILLER PARK ONE BREWERS WAY MILWAUKEE, WI 53214		529 N. Jackson Street Milwaukee WI 53202 Phone: 414-524-7500 Fax: 414-524-7575		9 8075-0508	
		JOHNSON CONTROLS Systems & Services Division		DRAWING NUMBER	
				36.12	


DETAIL A

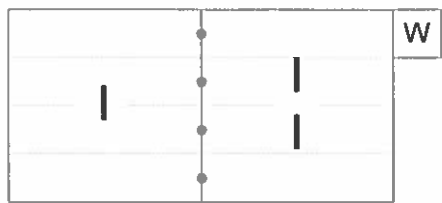


DETAIL B




DETAIL C

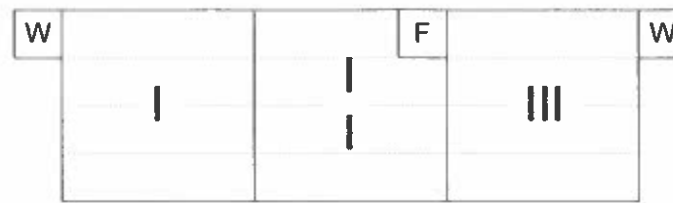


DETAIL E

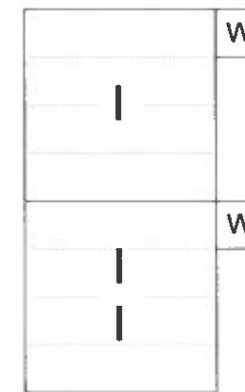


DETAIL H

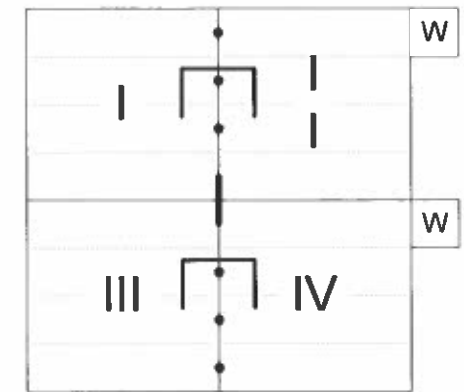


DETAIL I

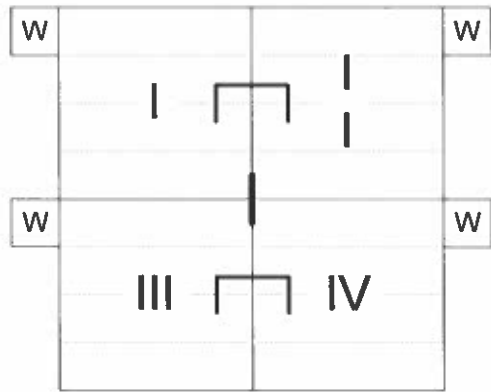


DETAIL J

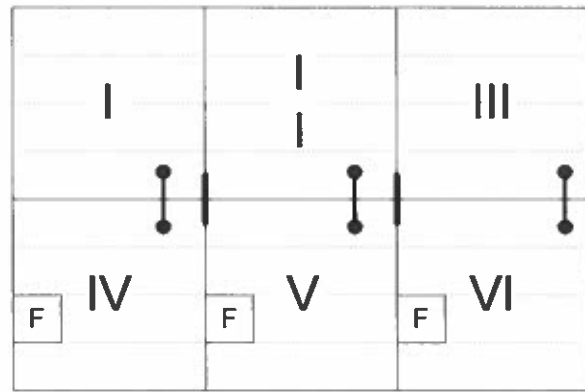

DETAIL K

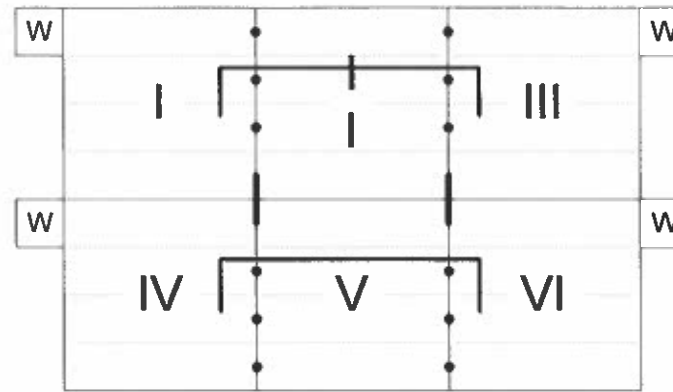


DETAIL L

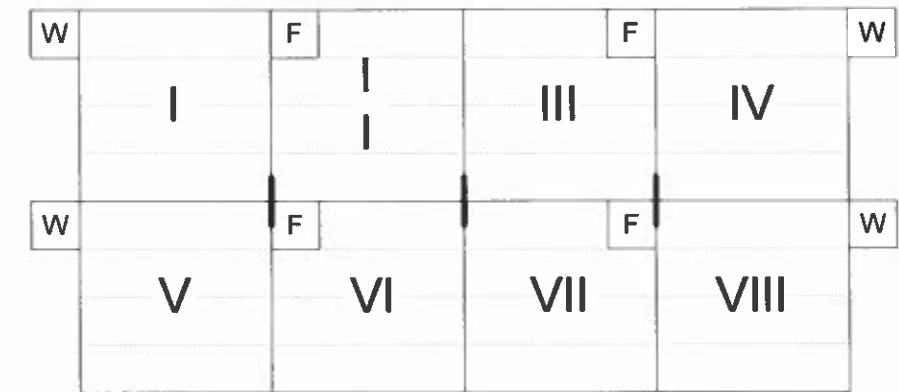


DETAIL M





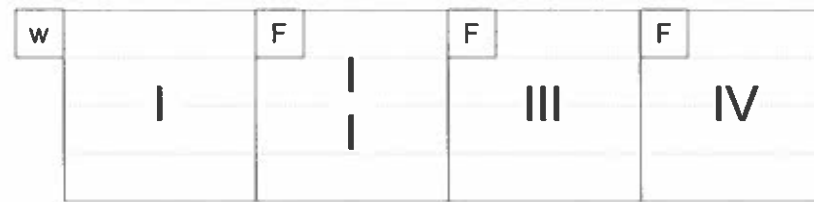

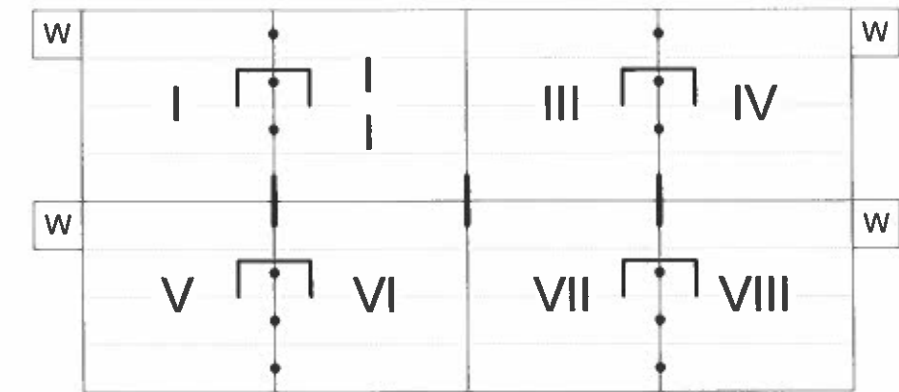


DETAIL O



DETAIL N



LEGEND

-  DMPR-KC205 - Two-panel Jackshaft
-  DMPR-KC206 - Three-panel Jackshaft
-  DMPR-KC100 - Vertical Blade-to-Blade Linkage
-  DMPR-KC200 - Support Bar (1) <= Four Blades (2) >= Four Blades
-  DMPR-KC202 - Pin-To-Pin Coupling  
Install a coupler on every pin.
-  WALL Mounted Actuator
-  FRAME Mounted Actuator

NOTE:


The **W** and **F** symbols are shown only to indicate the type of mounting for actuators. See product literature for preferred driving blades. See Damper Schedule for quantities of actuators required.

REVISION INFORMATION		Drawing Title									
NUMBER		DAMPER SCHEDULE DETAILS									
DATE		04/16/01		REFERENCE DRAWING		NO		REVISION LOCATION		ECH DATE BY	
TIME		10:54 AM		Sales Engineer		Project Manager		Application Engineer		DRAWN APPROVED	
FILE NAME		dprdet.vsd		Project Title		MILLER PARK ONE BREWERS WAY MILWAUKEE, WI 53214		Branch Information		CONTRACT NUMBER	
				PJS		TP		KJK		9 8075-0508	
				BY		MLR		DATE		DATE	
				Systems & Services Division		Wisconsin Area Office 529 N. Jackson Street Milwaukee WI 53202 Phone: 414-524-7500 Fax: 414-524-7575				D1	

**DETAIL A**

**PRESSURE TAP**


FOR WATER APPLICATIONS

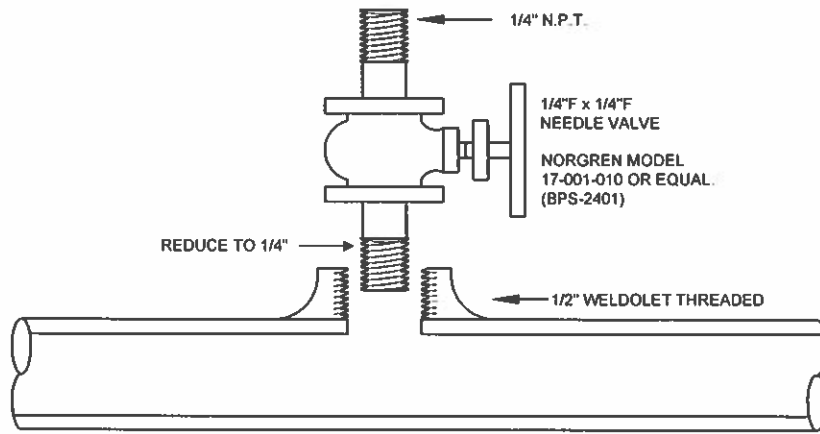

**DETAIL B**


**PRESSURE TAP**

FOR STEAM APPLICATIONS

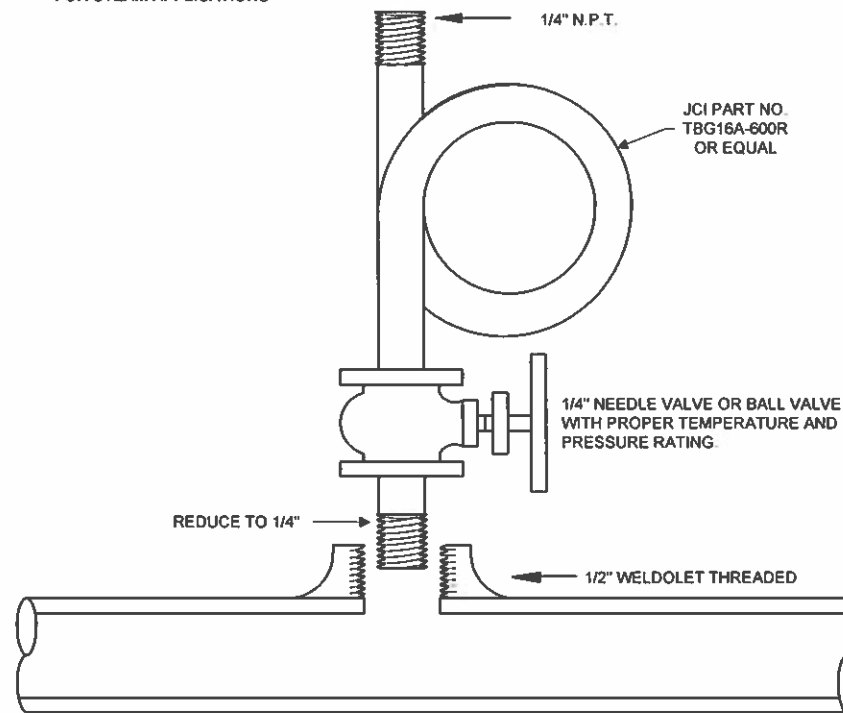


**DETAIL C**

**WZ-1000-5**

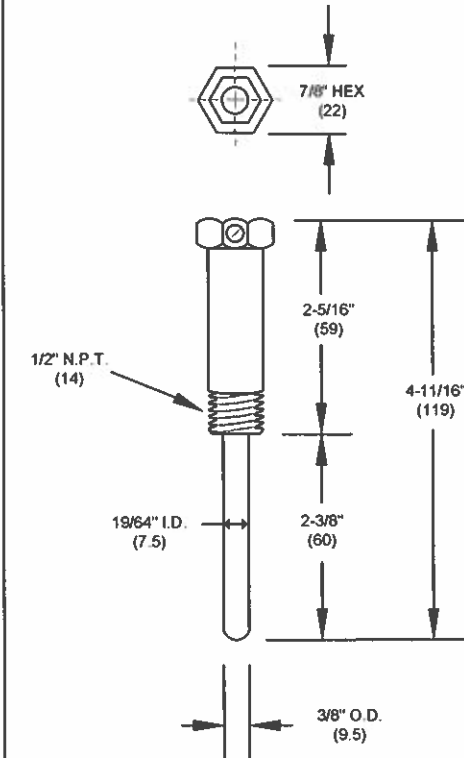


**DETAIL D**

**T-800-1605**

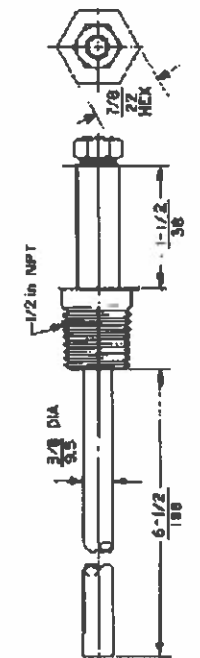


**DETAIL E**

**DIFFERENTIAL PRESSURE**

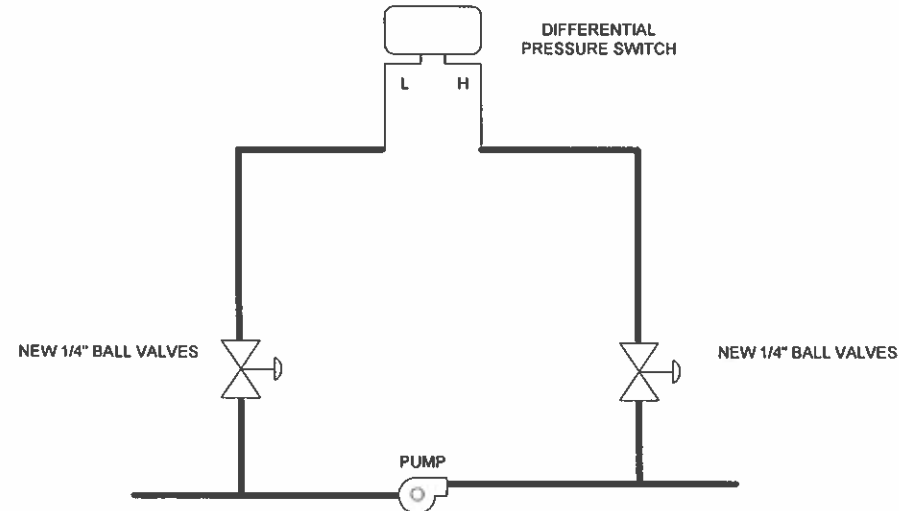


**DETAIL F**

**DIFFERENTIAL PRESSURE**

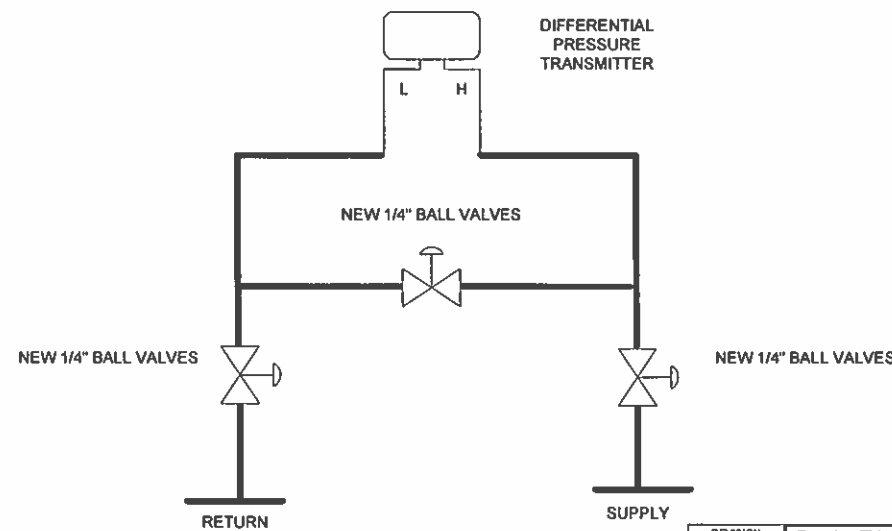

**DETAIL G**

**FLOW SWITCH**

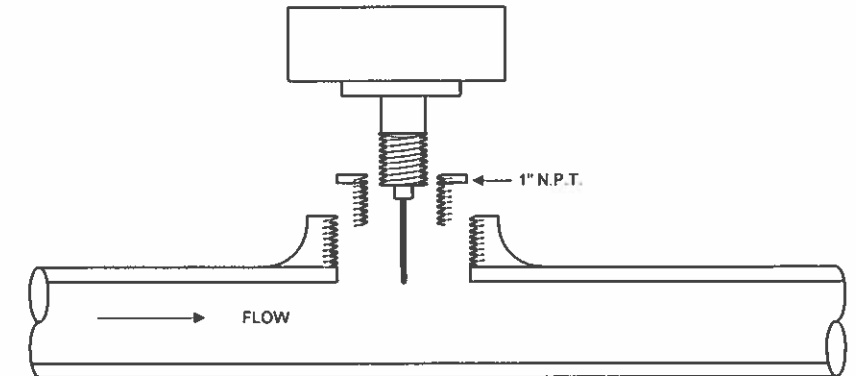

<b>REVISION INFORMATION</b> NUMBER DATE 04/16/01 TIME 10:58 AM FILE NAME welltapdet.d		Drawing Title <b>WELL/TAP/METER SCHEDULE DETAILS</b> Project Title <b>MILLER PARK ONE BREWERS WAY MILWAUKEE, WI 53214</b>		<table border="1"> <tr> <th>NO.</th> <th>REVISION-LOCATION</th> <th>ECH</th> <th>DATE</th> <th>BY</th> </tr> <tr> <td> </td> <td> </td> <td> </td> <td> </td> <td> </td> </tr> </table>		NO.	REVISION-LOCATION	ECH	DATE	BY						<table border="1"> <tr> <th>DATE</th> <th>BY</th> <th>APPROVED</th> </tr> <tr> <td> </td> <td> </td> <td> </td> </tr> </table>		DATE	BY	APPROVED				Branch Information <b>JOHNSON CONTROLS</b> Wisconsin Area Office 529 N. Jackson Street Milwaukee WI 53202 Phone: 414-524-7500 Fax: 414-524-7575		CONTRACT NUMBER <b>9 8075-0508</b> DRAWING NUMBER <b>D2</b>	
NO.	REVISION-LOCATION	ECH	DATE	BY																							
DATE	BY	APPROVED																									